

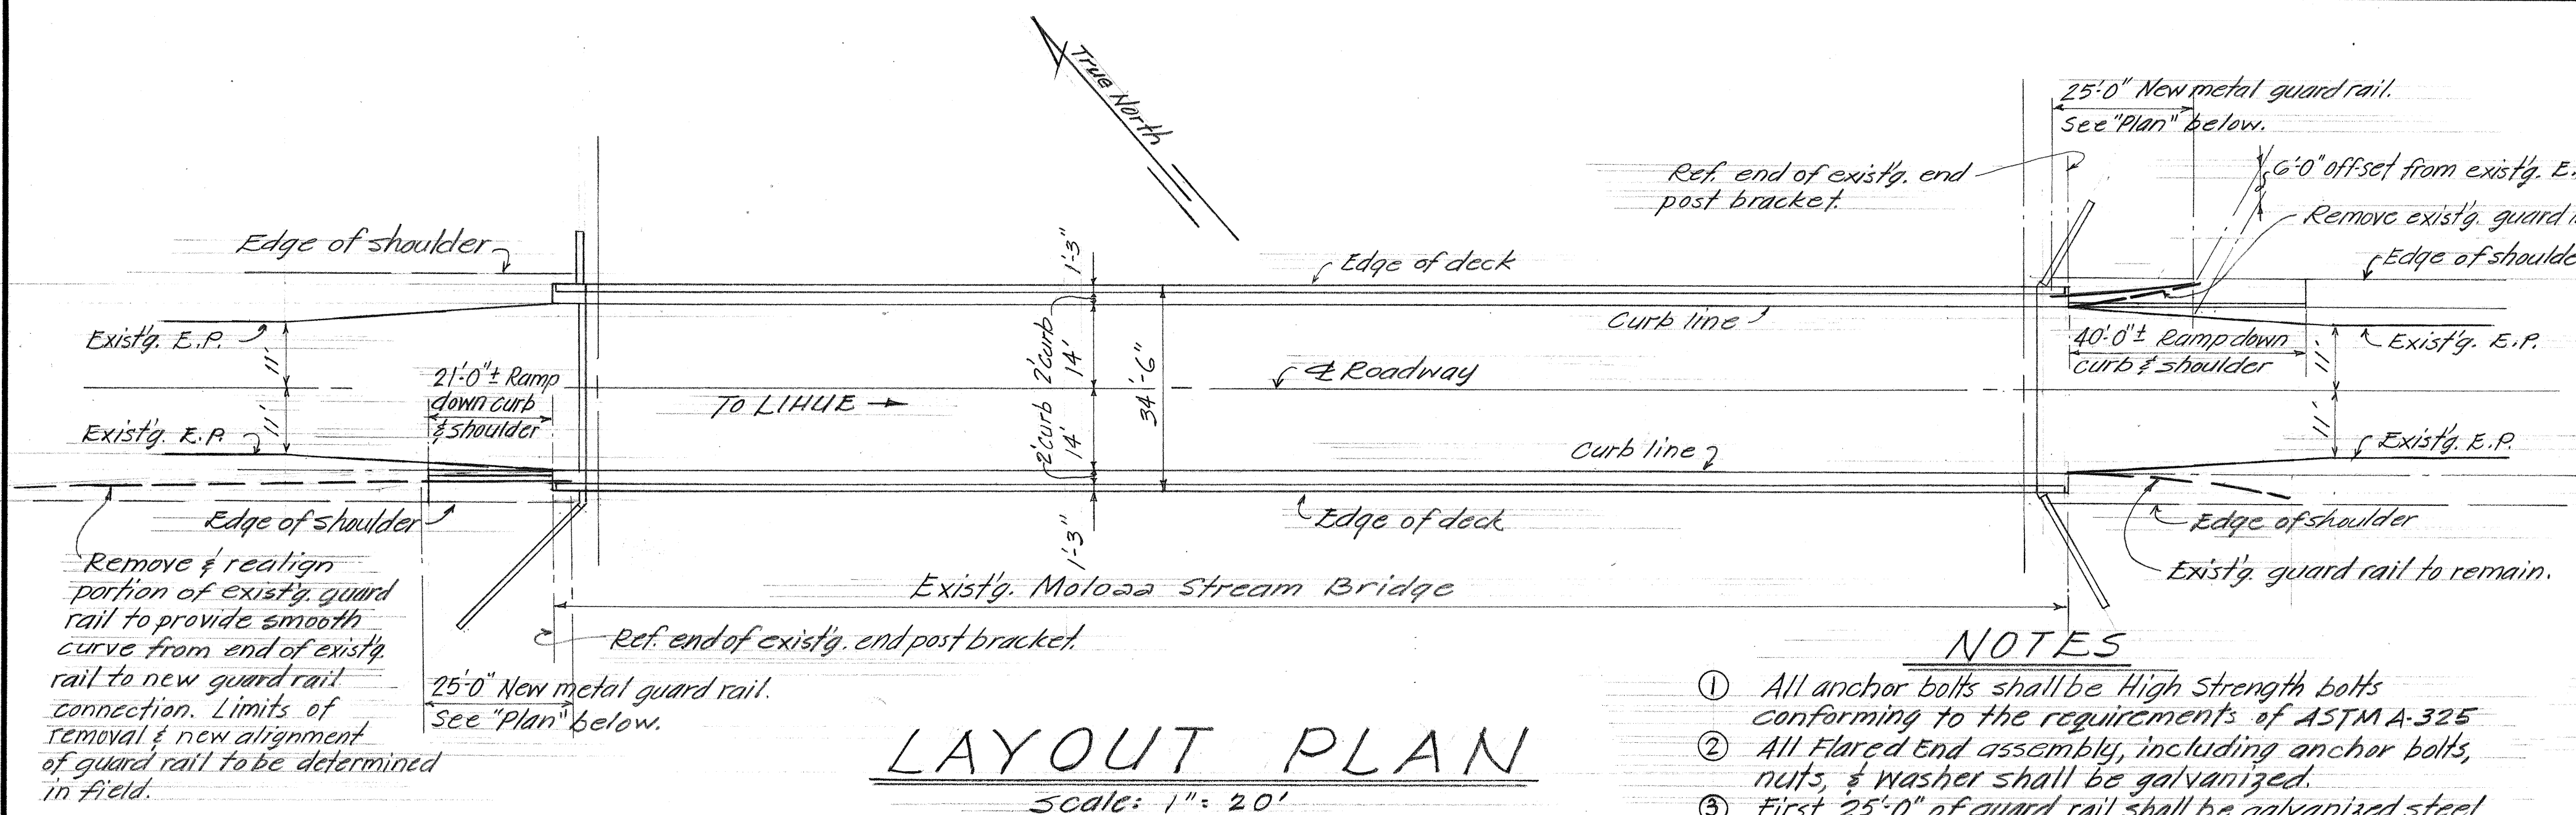
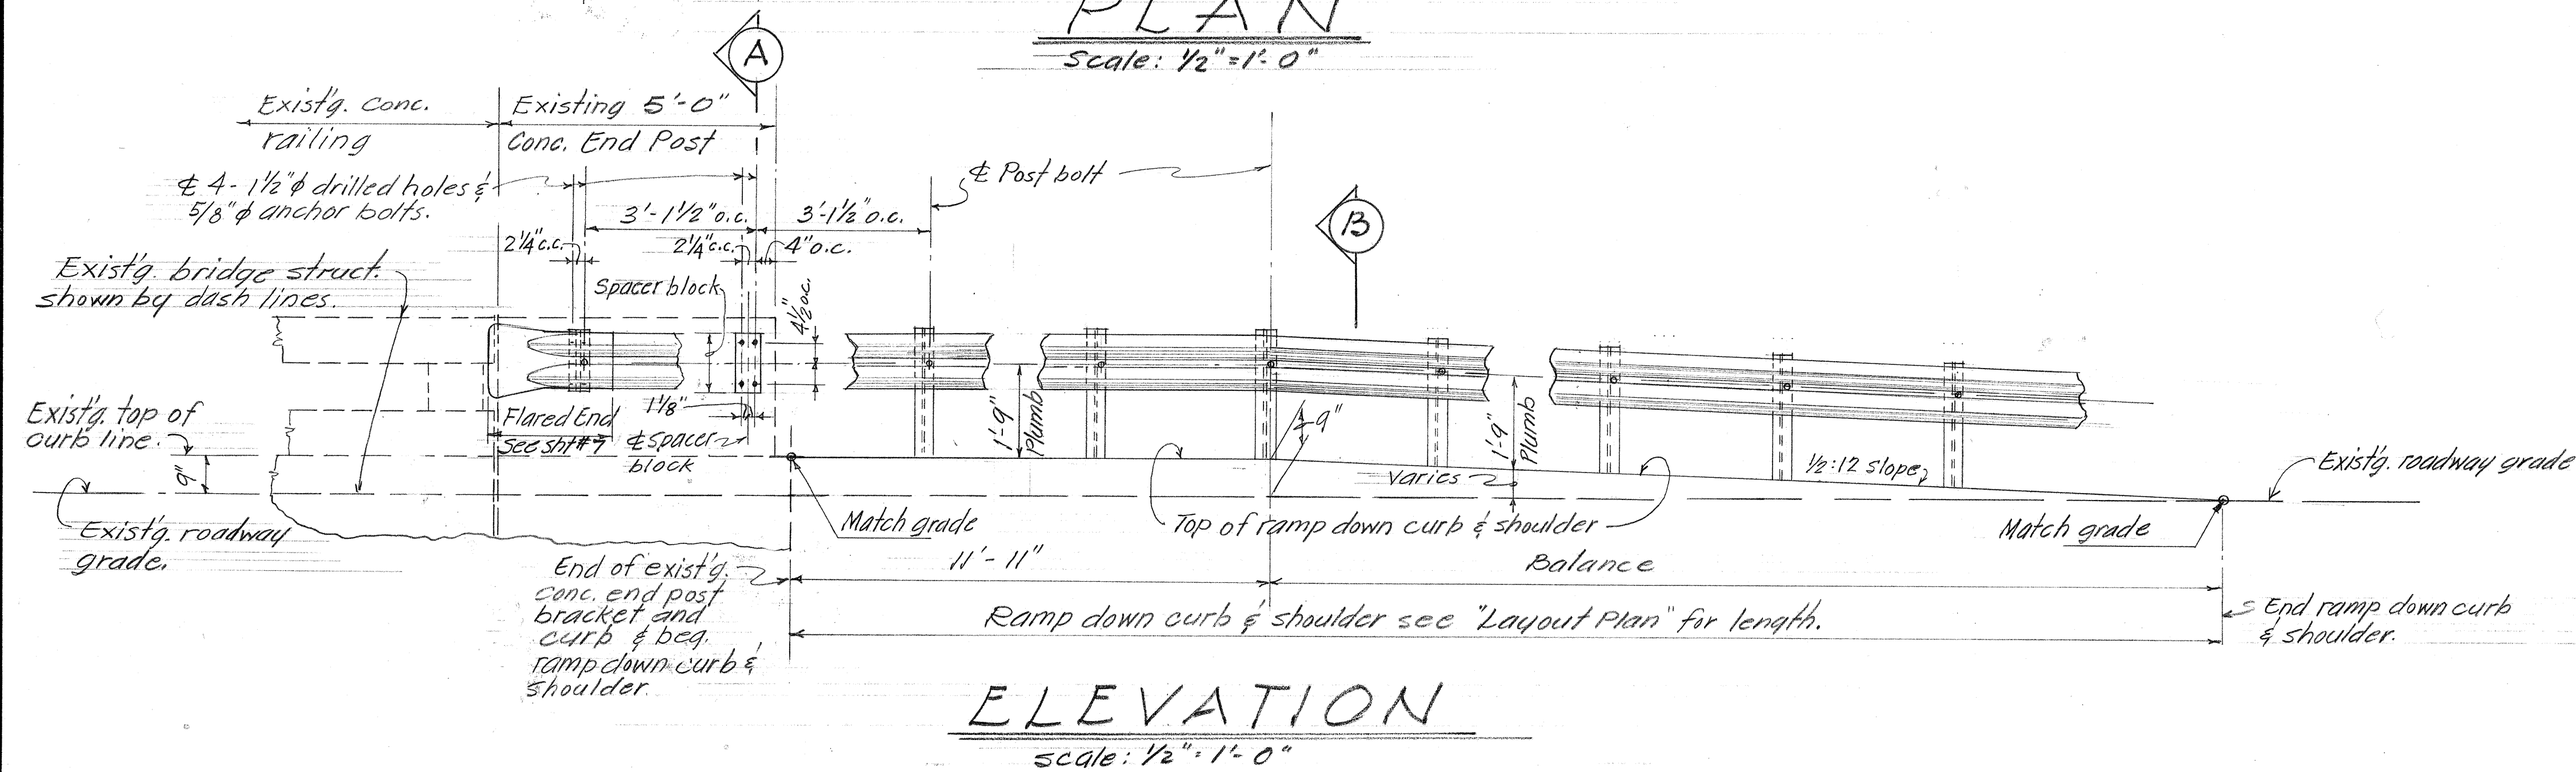
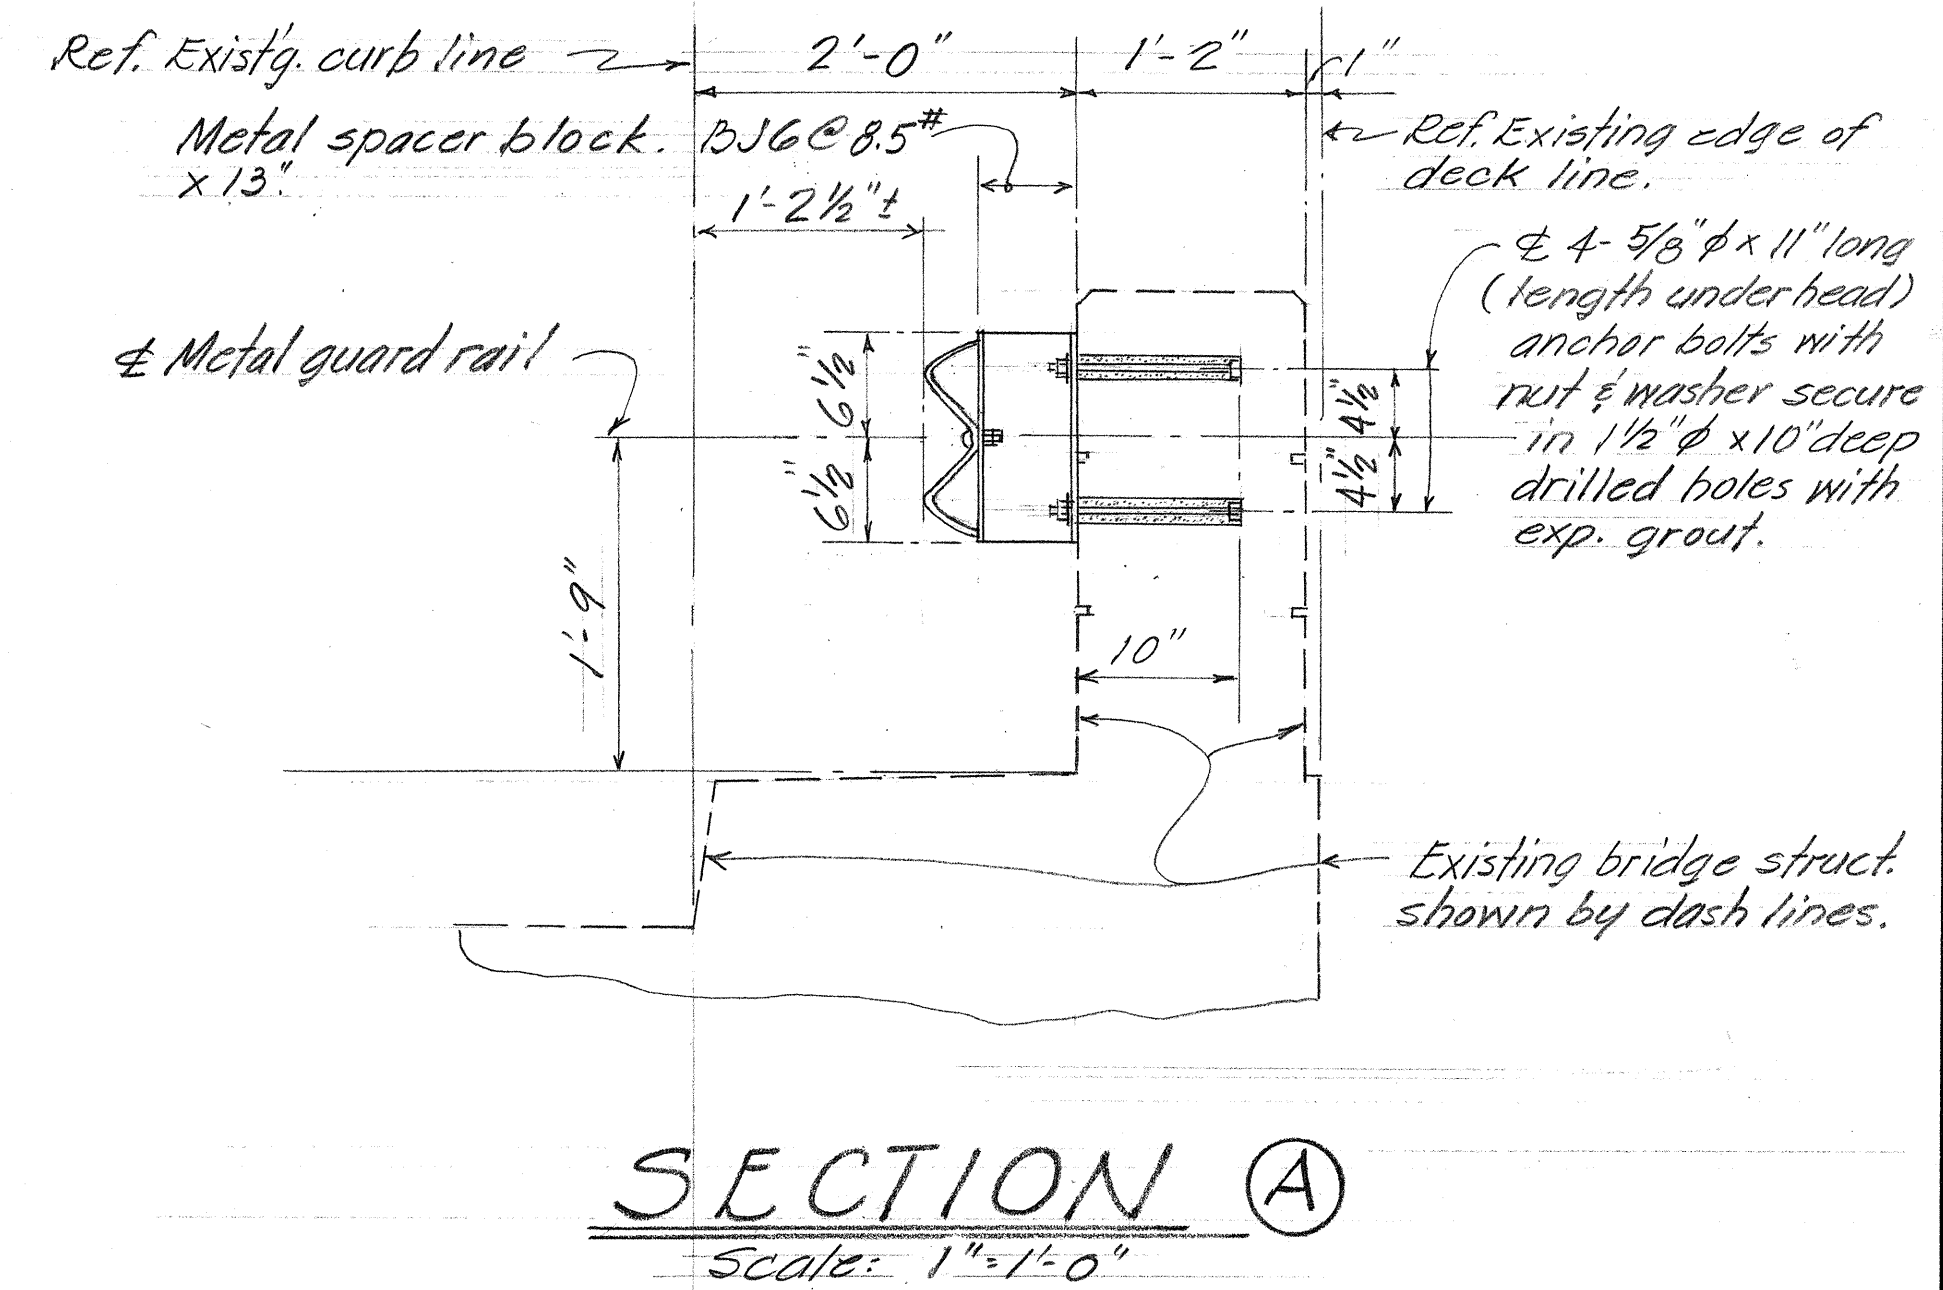


FED. ROAD DIST. NO.	STATE	PROJ. NO.	FISCAL YEAR	SHEET NO.	TOTAL SHEETS
HAWAII	HAW.	56C-01-73	1973	5	12

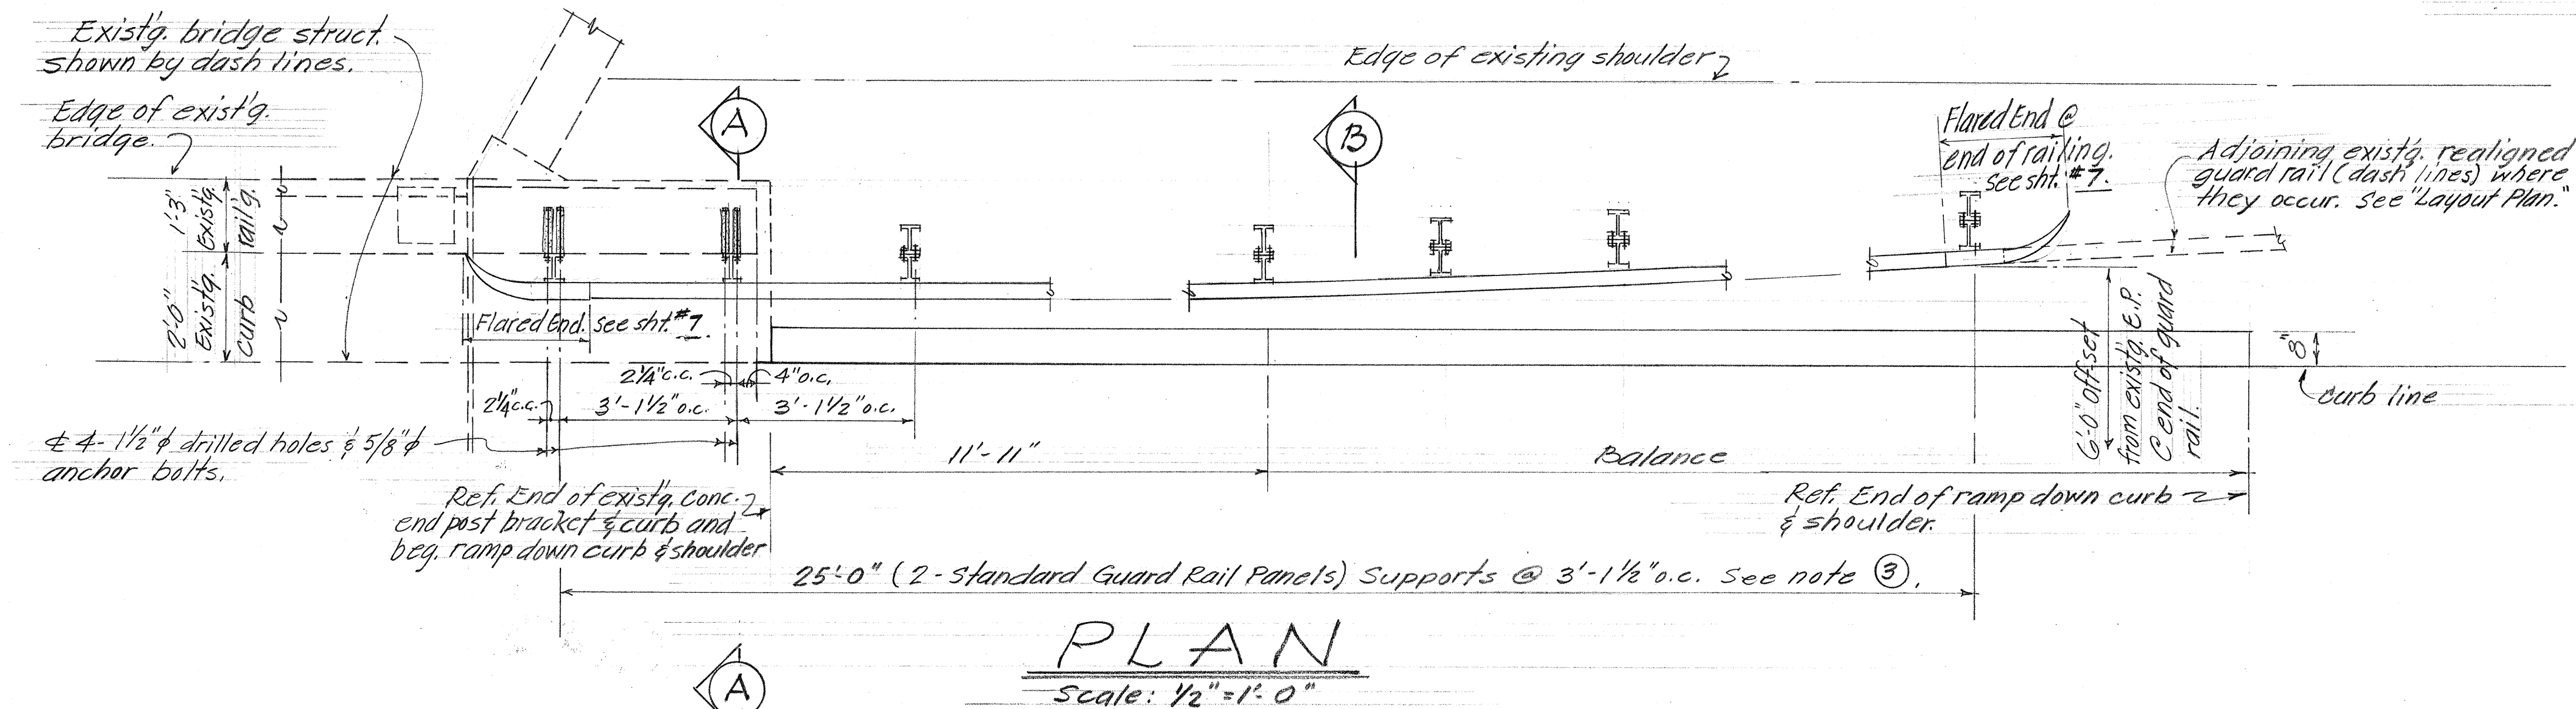

- NOTES**
- 1 All anchor bolts shall be High Strength bolts conforming to the requirements of ASTM A-325.
 - 2 All Flared end assembly, including anchor bolts, nuts, & washer shall be galvanized.
 - 3 First 25'-0" of guard rail shall be galvanized steel.
 - 4 Anchor bolt length given under bolt head.
 - 5 Pneumatic drills will not be permitted for the drill holes.

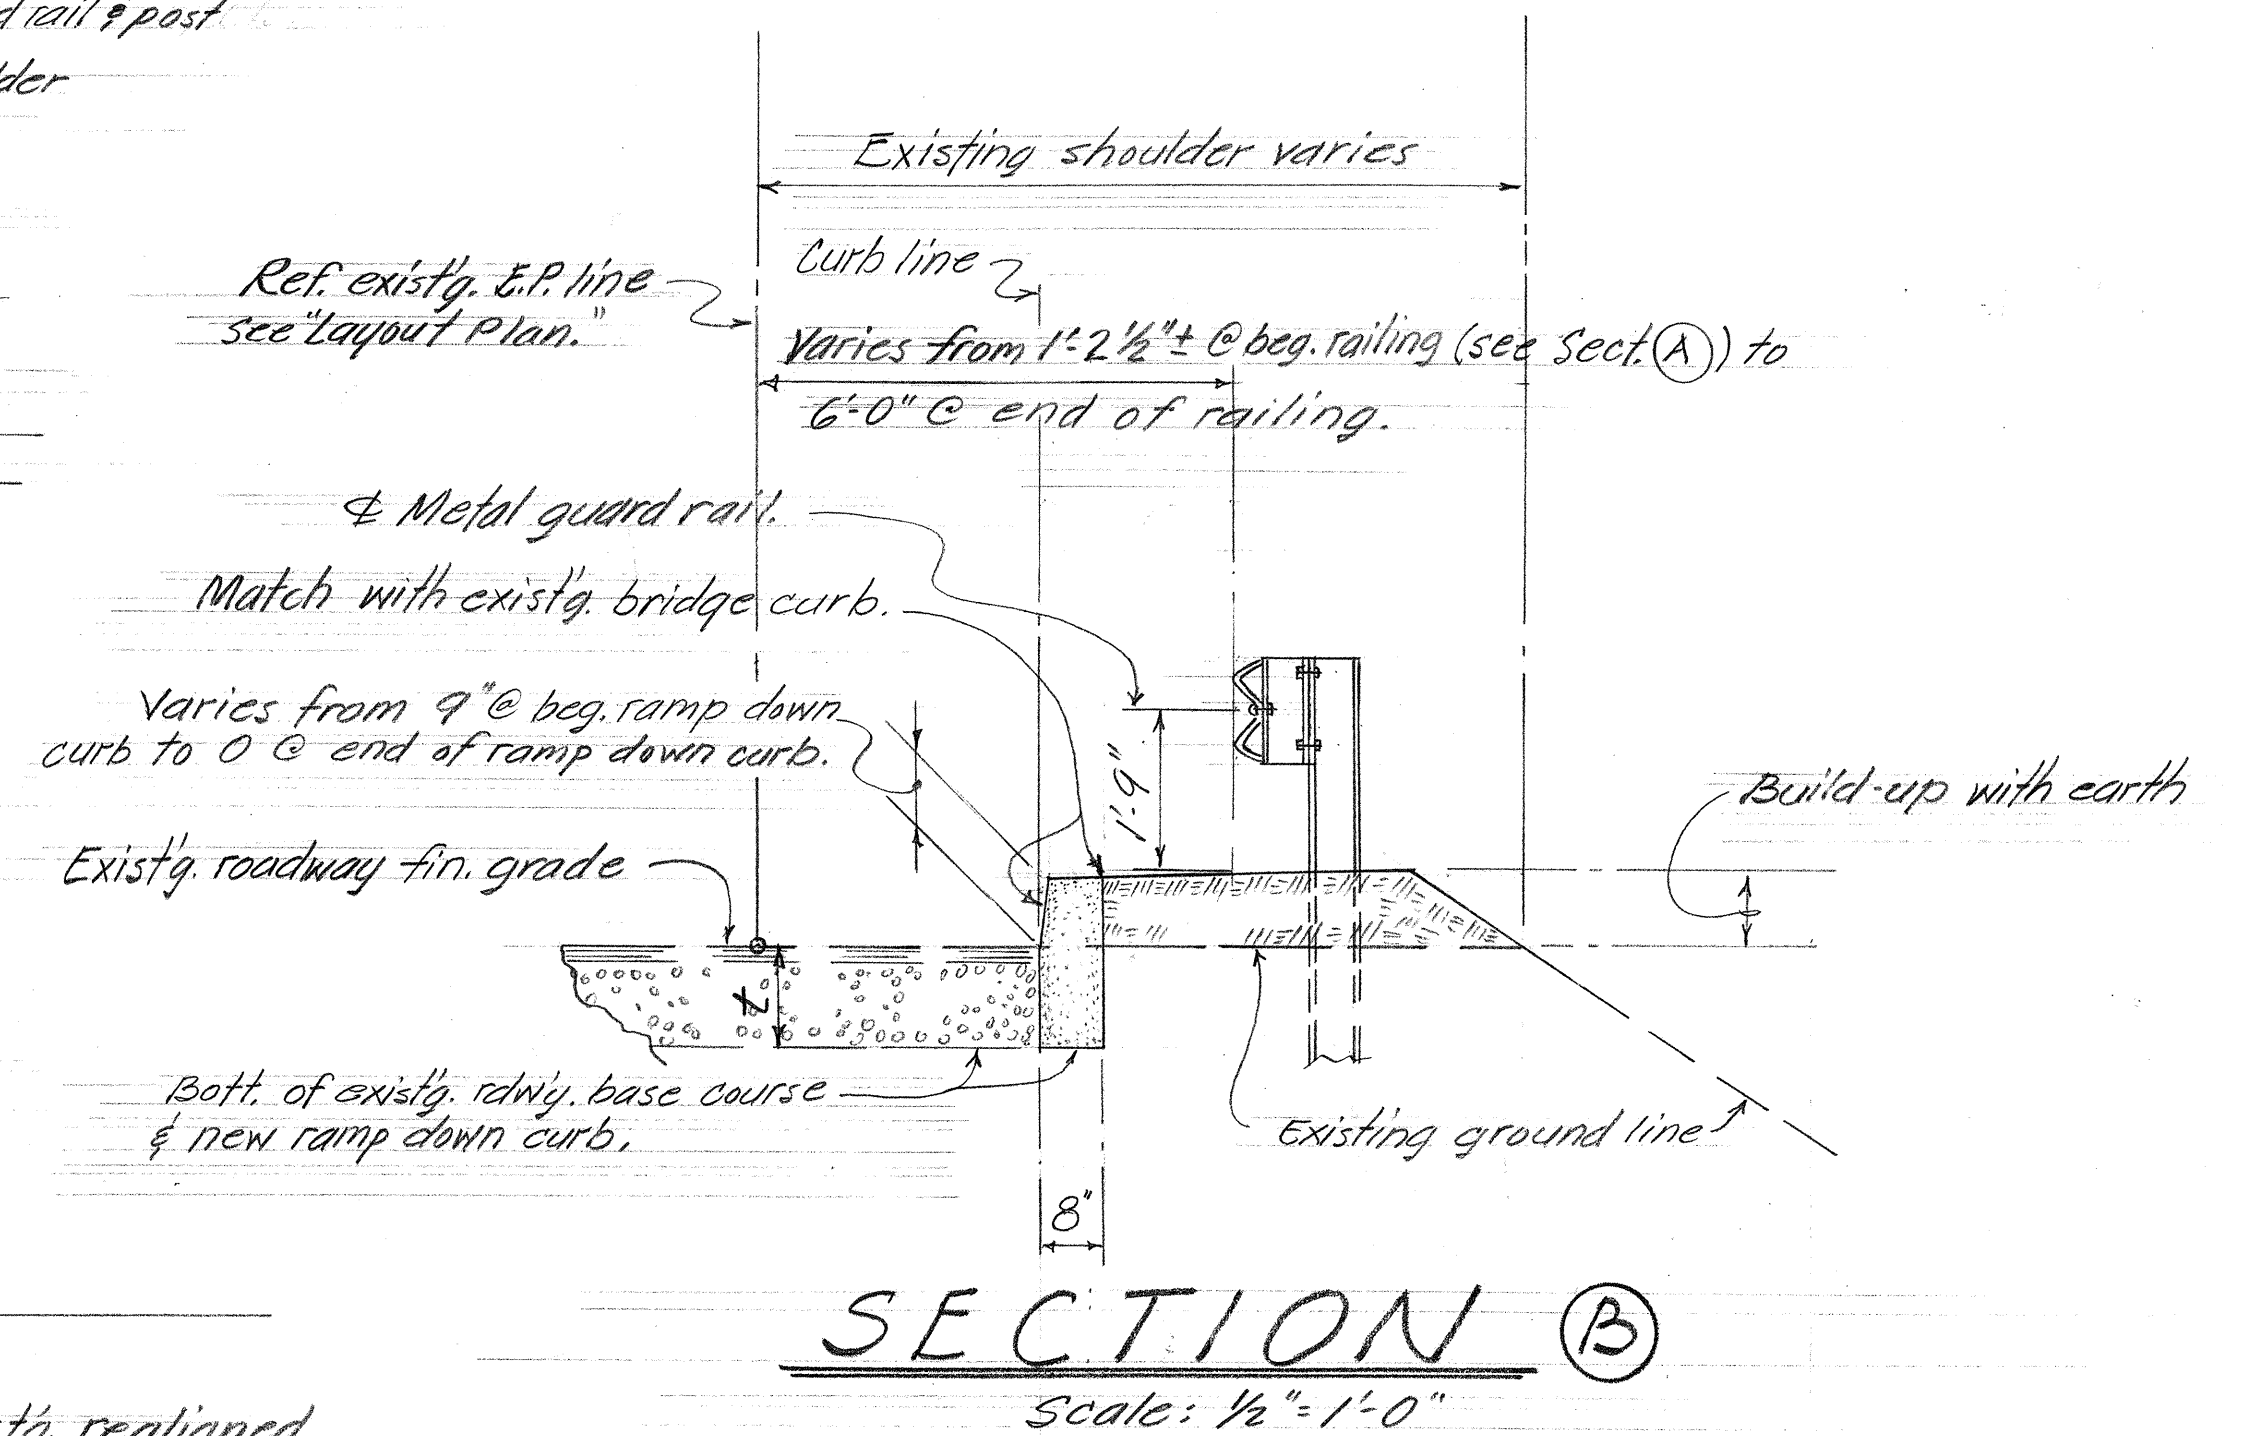

STATE OF HAWAII
DEPARTMENT OF TRANSPORTATION
HIGHWAYS DIVISION
SAFETY IMPROVEMENTS
AT
MOLOAA STREAM BRIDGE
KAUAI BELT ROAD
Proj. No 56C-01-73 DATE: July, 1973
SHEET No. 1 OF 1 SHEETS