


DIST. NO.	STATE	PROJ. NO.	FISCAL YEAR	SHEET NO.	TOTAL SHEETS
HAWAII	HAW.	50C-01-73	1973	2	12

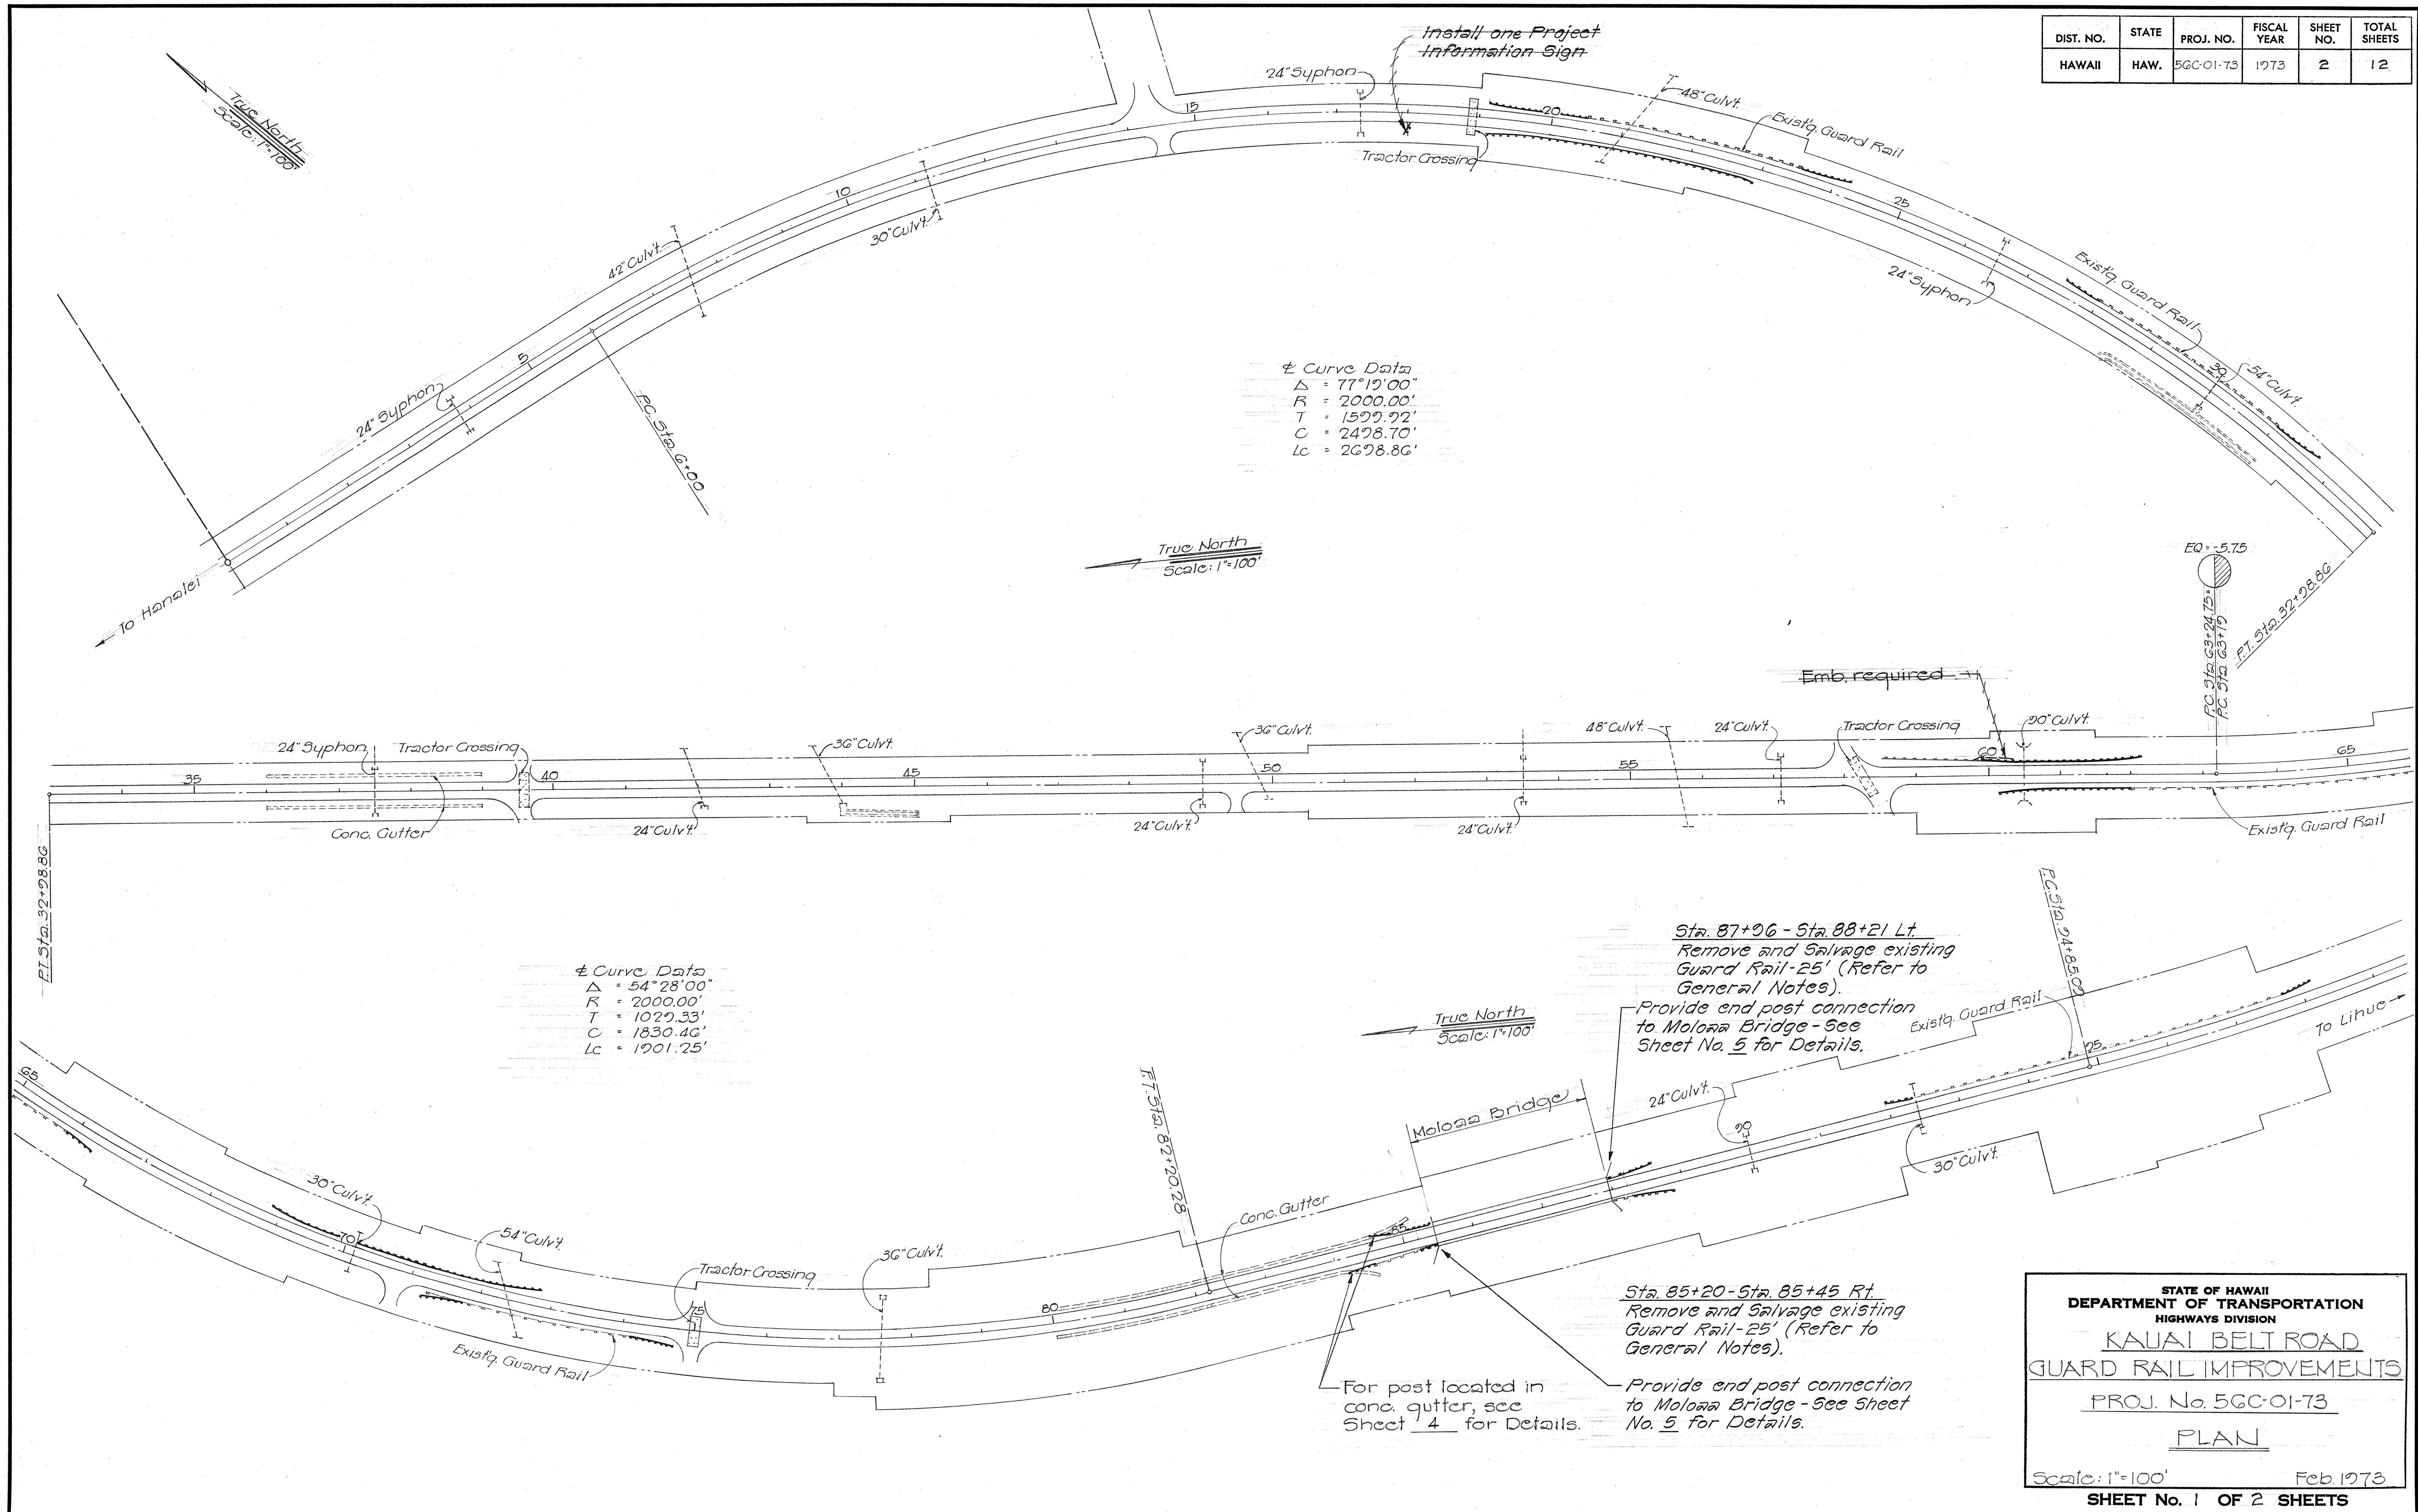


ORIGINAL PLAN	SURVEY PLOTTED BY _____	DATE _____
NOTE BOOK	DRAWN BY _____	" _____
	TRACED BY _____	" _____
	DESIGNED BY _____	" _____
	QUANTITIES BY _____	" _____
No. _____	CHECKED BY _____	" _____

GENERAL NOTES:

- 1- All Stations refer to Kauai Belt Road, Proj. No. 5-0560(2) Unit 2.
- 2- The Contractor shall keep at least one lane open to traffic during working hours and both lanes open to traffic during non-working hours.
- 3- The work necessary in removing and salvaging shall include hauling and stockpiling the existing guard rails and posts. These items of work will not be measured or paid for directly but shall be considered incidental to the item "Guard Rail, Type 3 - Single w/Steel Posts."
- 4- The Engineer shall determine in the field the limits and elevations of the borrow area. The contractors attention is directed to Section 203.02 (A)(4) - Borrow.
- 5- Provide smooth transition from existing guard rail to new guard rail installation. Adjust placement of existing guard rails if necessary to accomplish smooth transition. The amount of adjustment will be determined by the Engineer in the field.
- 6 All new guard rail installation shall consist of Type 3 - Single with Steel Post unless otherwise specified.
- 7- The work necessary in providing the end post connections and ramp down curbs to Molokaa Bridge shall include all materials and equipment necessary to complete the work. These items will not be measured or paid for separately but shall be considered incidental to Guard Rail, Type 3 - Single with Steel Posts.

Curve Data
 $\Delta = 56^{\circ}50'00''$
 $R = 3500.00'$
 $T = 1893.76'$
 $C = 3331.16'$
 $Lc = 3471.75'$

DIST. NO.	STATE	PROJ. NO.	FISCAL YEAR	SHEET NO.	TOTAL SHEETS
HAWAII	HAW.	56C-01-73	1973	3	12

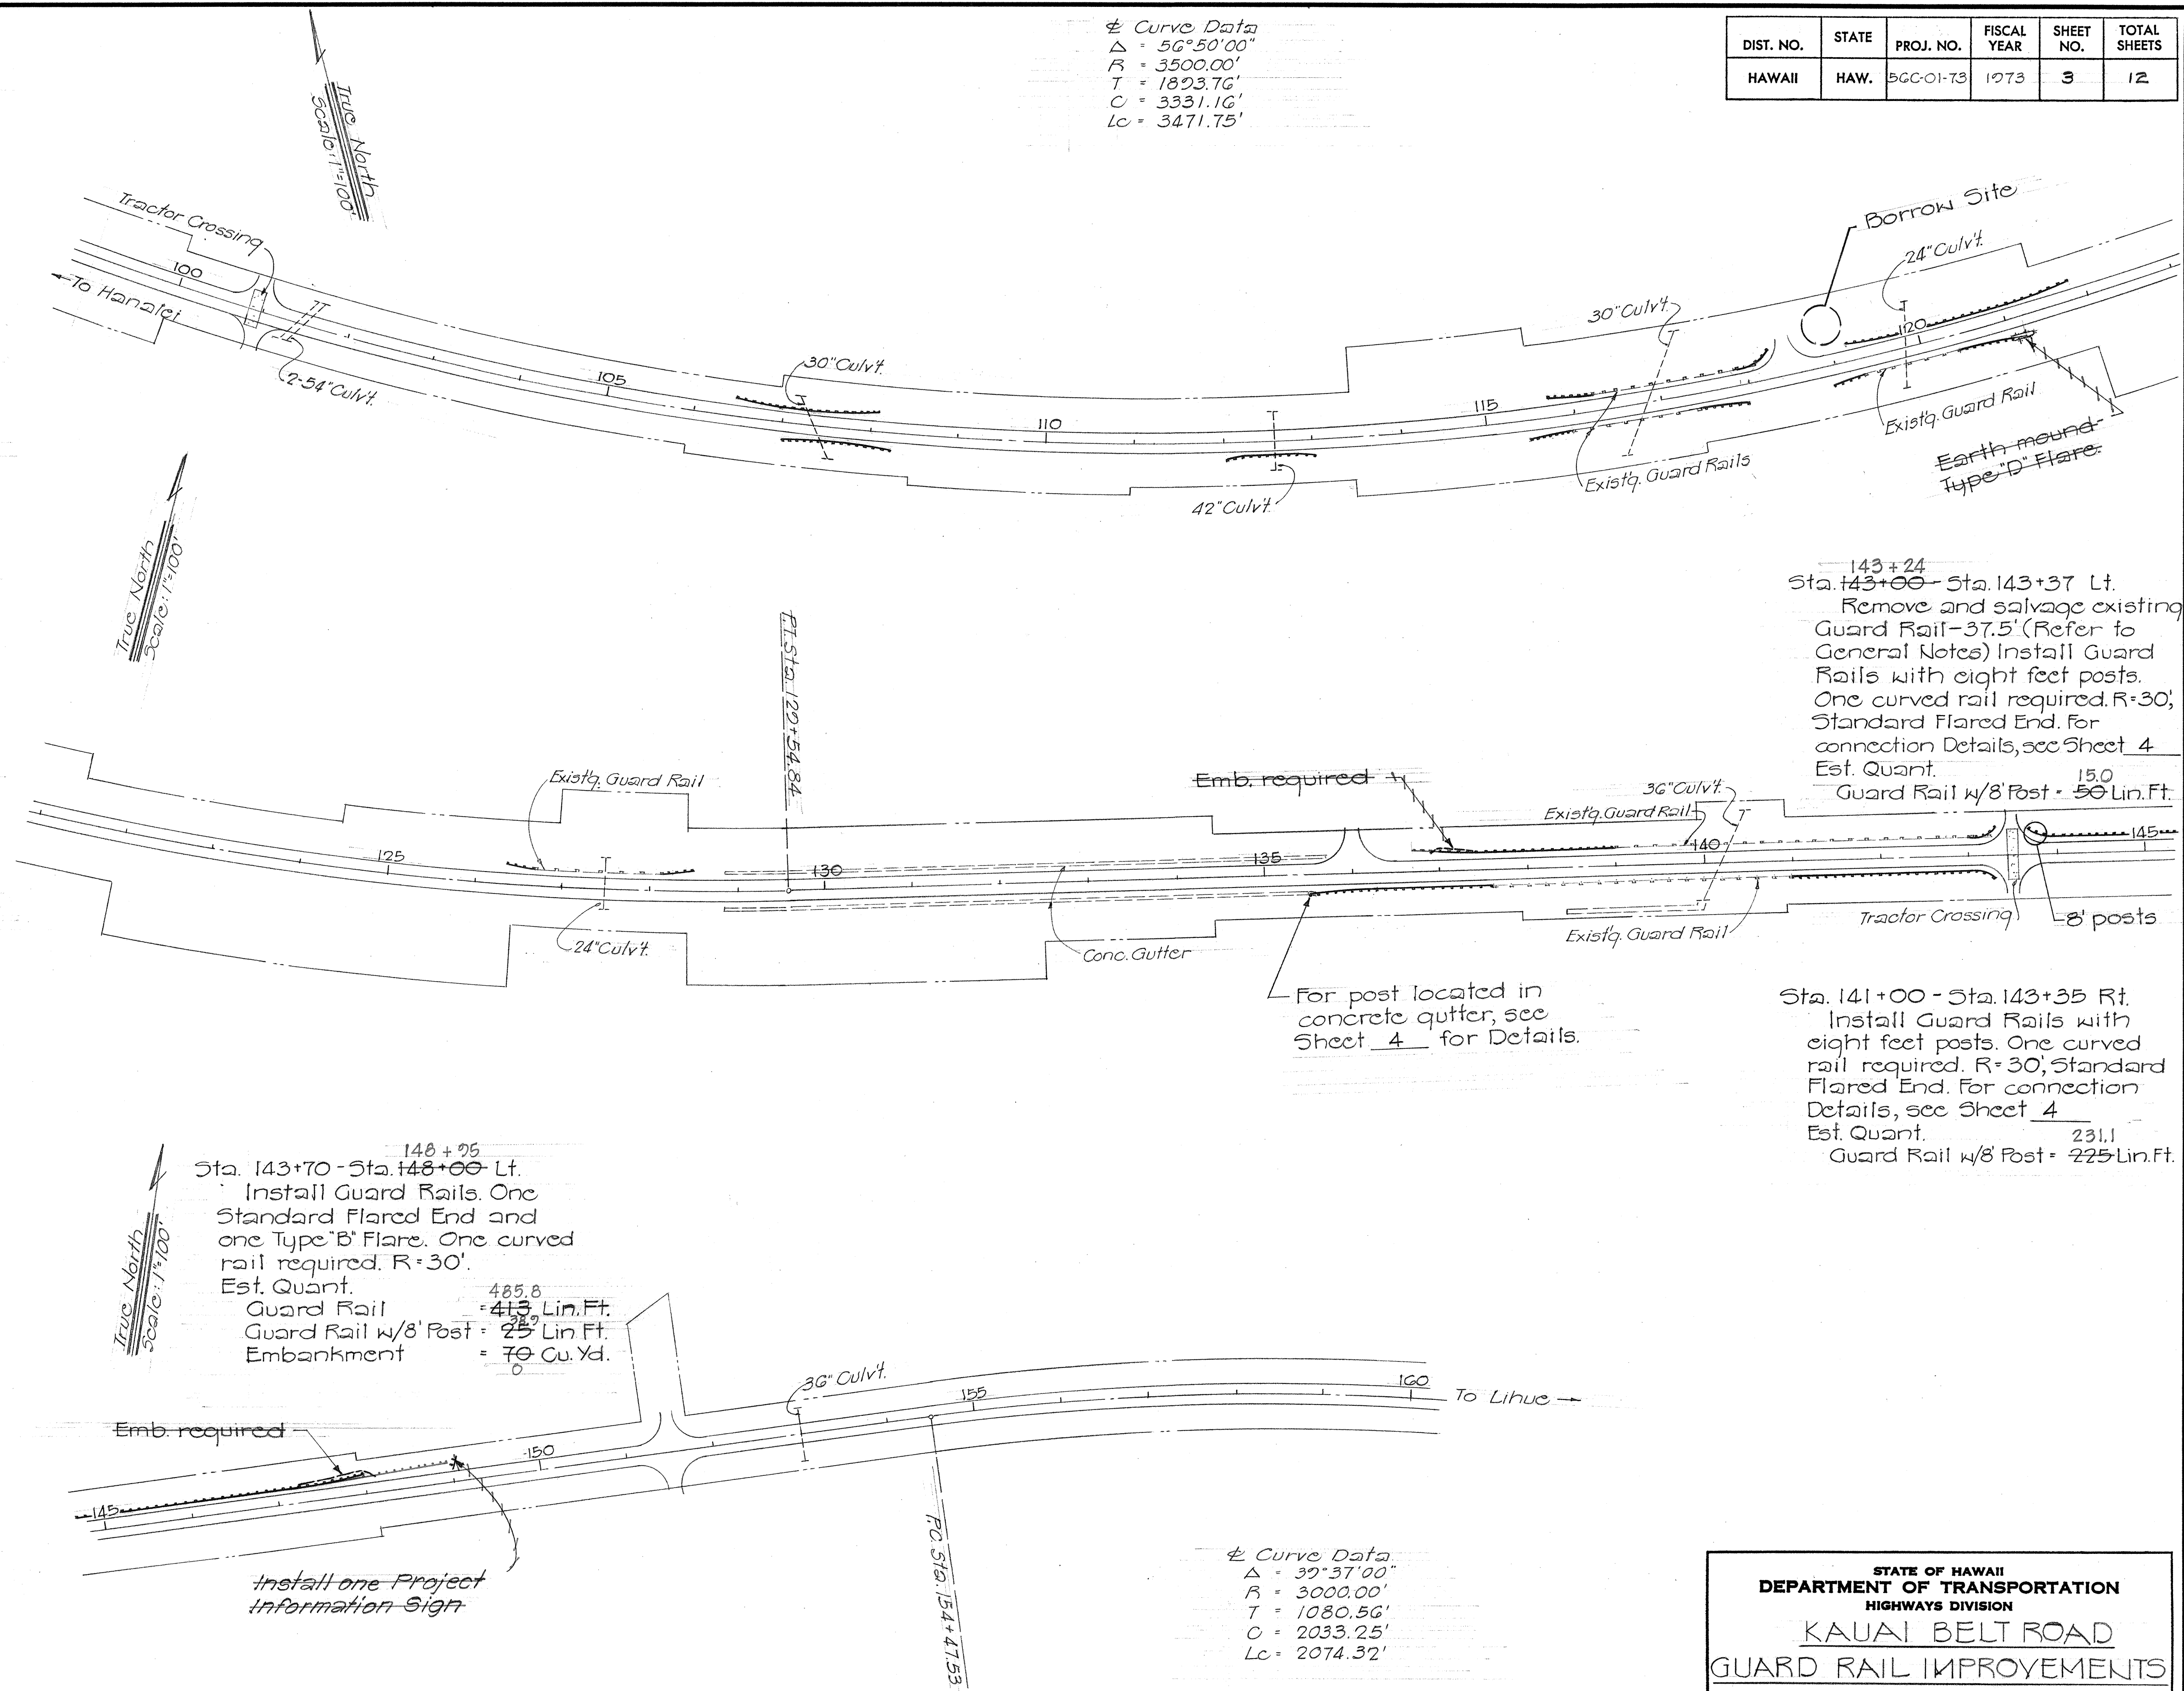

DATE	_____
SURVEY PLOTTED BY	_____
DRAWN BY	_____
DESIGNED BY	_____
CHECKED BY	_____
ORIGINAL PLAN	_____
NOTE BOOK	_____
No.	_____

STATE OF HAWAII
 DEPARTMENT OF TRANSPORTATION
 HIGHWAYS DIVISION
KAUAI BELT ROAD
GUARD RAIL IMPROVEMENTS
 PROJ. No. 56C-01-73
PLAN
 Scale: 1"=100' Feb. 1973
 SHEET No. 2 OF 2 SHEETS