Constitution of the Consti	
INDEX TO DRAWINGS	
SHEET NO	DESCRIPTION
	TITLE SHEET
2-3	PLAN
4	MISC. DETAILS
5	DETAILS - MOLOAA STREAM
	BRIDGE
6-11	STANDARD DETAILS
12	PROJECT INFORMATION SIGN
**.	

DEPARTMENT OF TRANSPORTATION
HIGHWAYS DIVISION


"AS BUILT"
PLANS FOR


KAUAI BELT ROAD, GUARD RAIL IMPROVEMENTS

PROJECT NO. 56C-01-73

DISTRICTS OF KAWAIHAU & HANALEI

ISLAND OF KAUAI

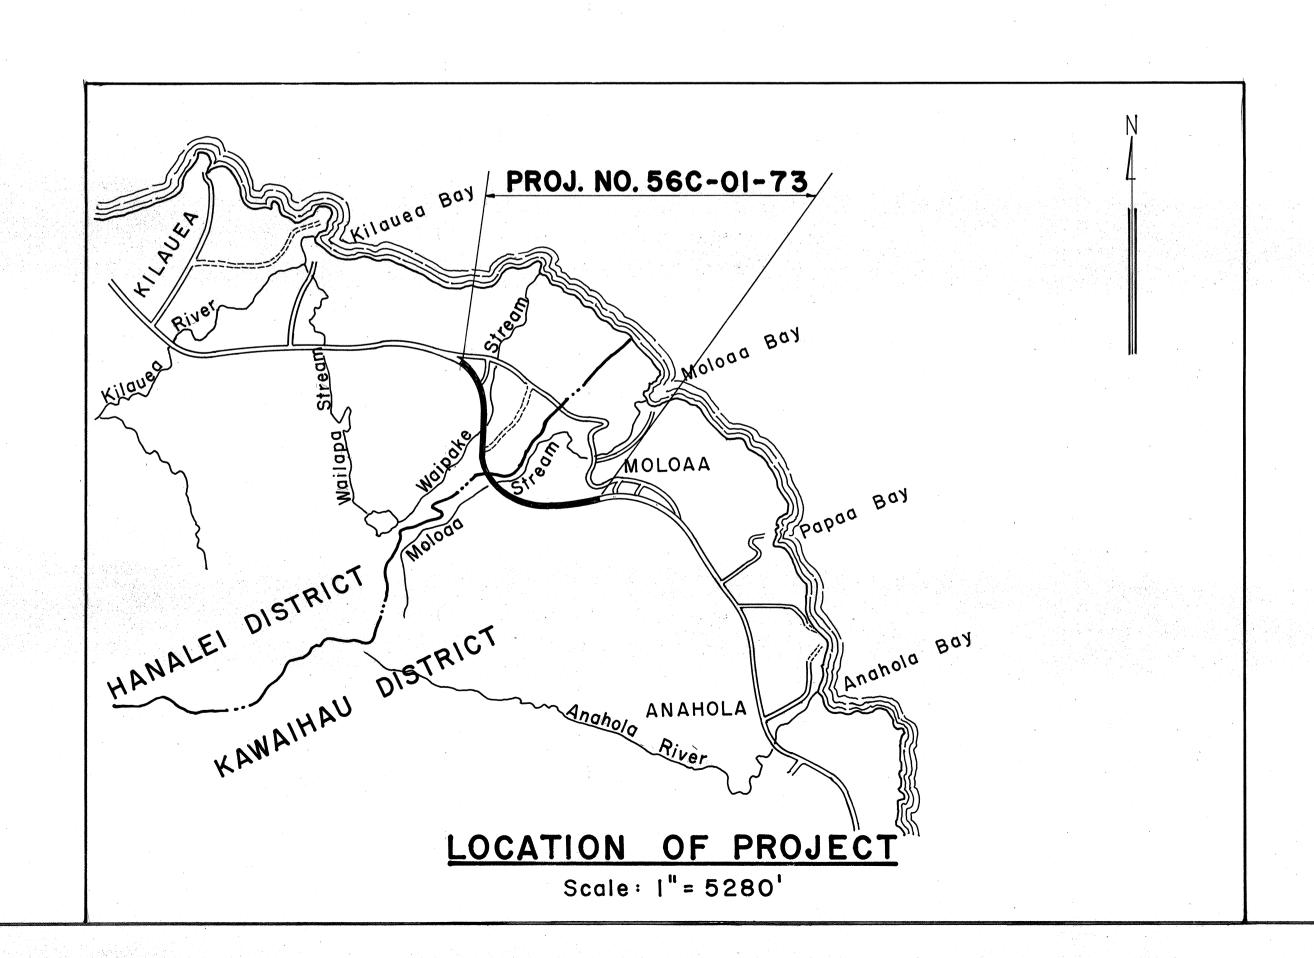

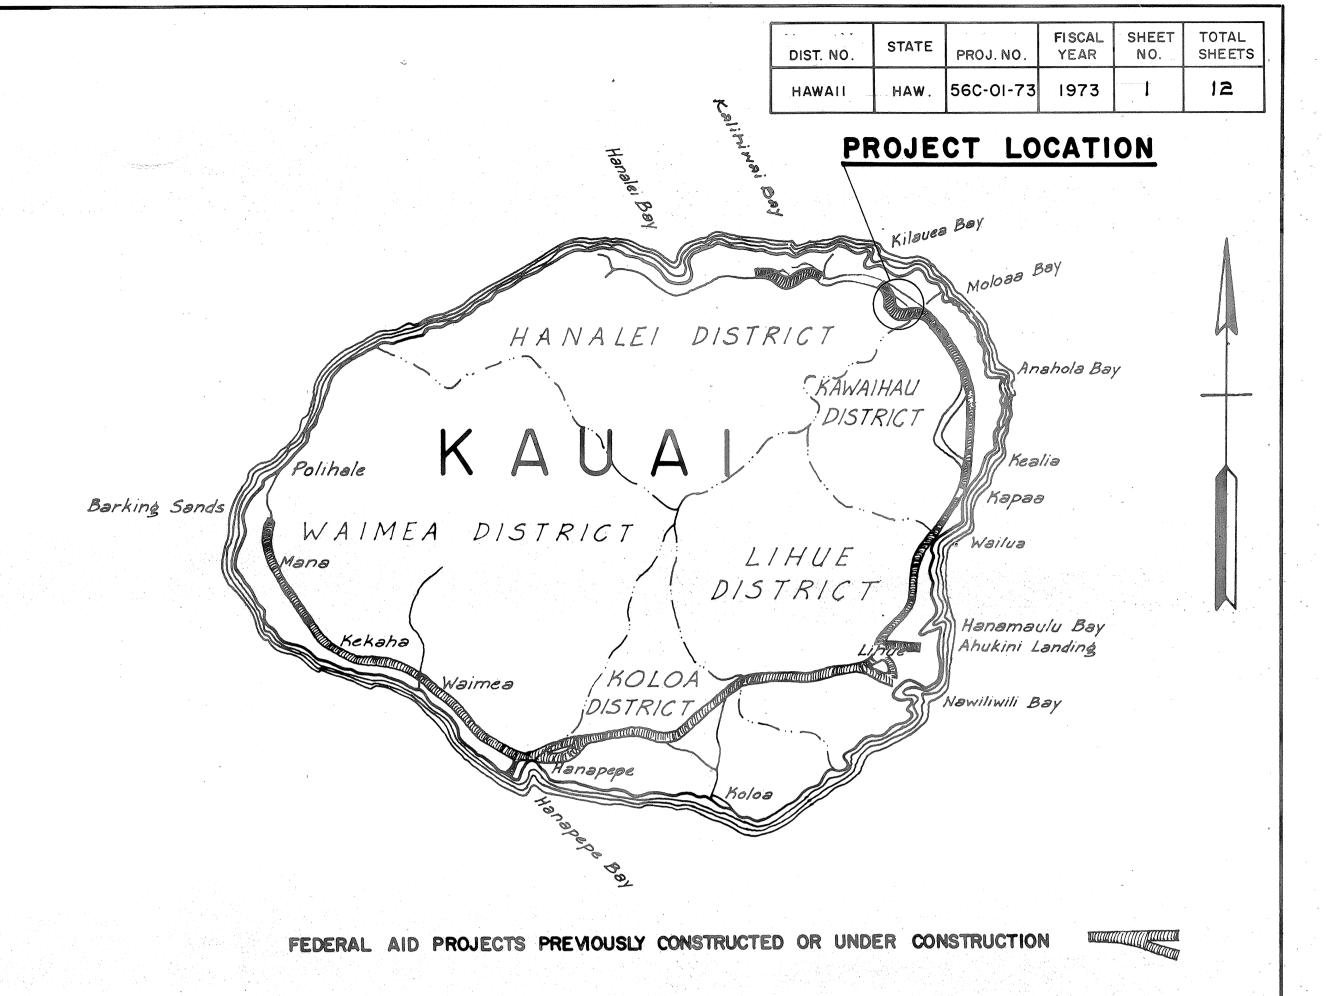

NOTE: ALL CHANGES MADE DURING CONSTRUCTION HAVE BEEN NOTED ON THESE TRACINGS IN RED AND CHECKED BY:

PROJECT ENGINEER DATE

DEPARTMENT OF TRANSPORTATION STATE OF HAWAII APPROVED:

Prunny Lee 9/12/2 DIR. OF TRANSPORTATION DATE

GINAL DESIGNED BY

LAN DRAWN BY

TRACED BY

E BOOK QUANTITIES CHECKED BY

CHECKED BY