

DIST. NO.	STATE	PROJ. NO.	FISCAL YEAR	SHEET NO.	TOTAL SHEETS
HAWAII	HAW.	56A-01-74	1974	1	53

STATE OF HAWAII

DEPARTMENT OF TRANSPORTATION

HIGHWAYS DIVISION

AS BUILT PLANS FOR


KAUAI BELT ROAD

WAIKAEA BRIDGE TO KAWAIHAU ROAD

PROJECT NO. 56A-01-74

KAWAIHAU DISTRICT

ISLAND OF KAUAI

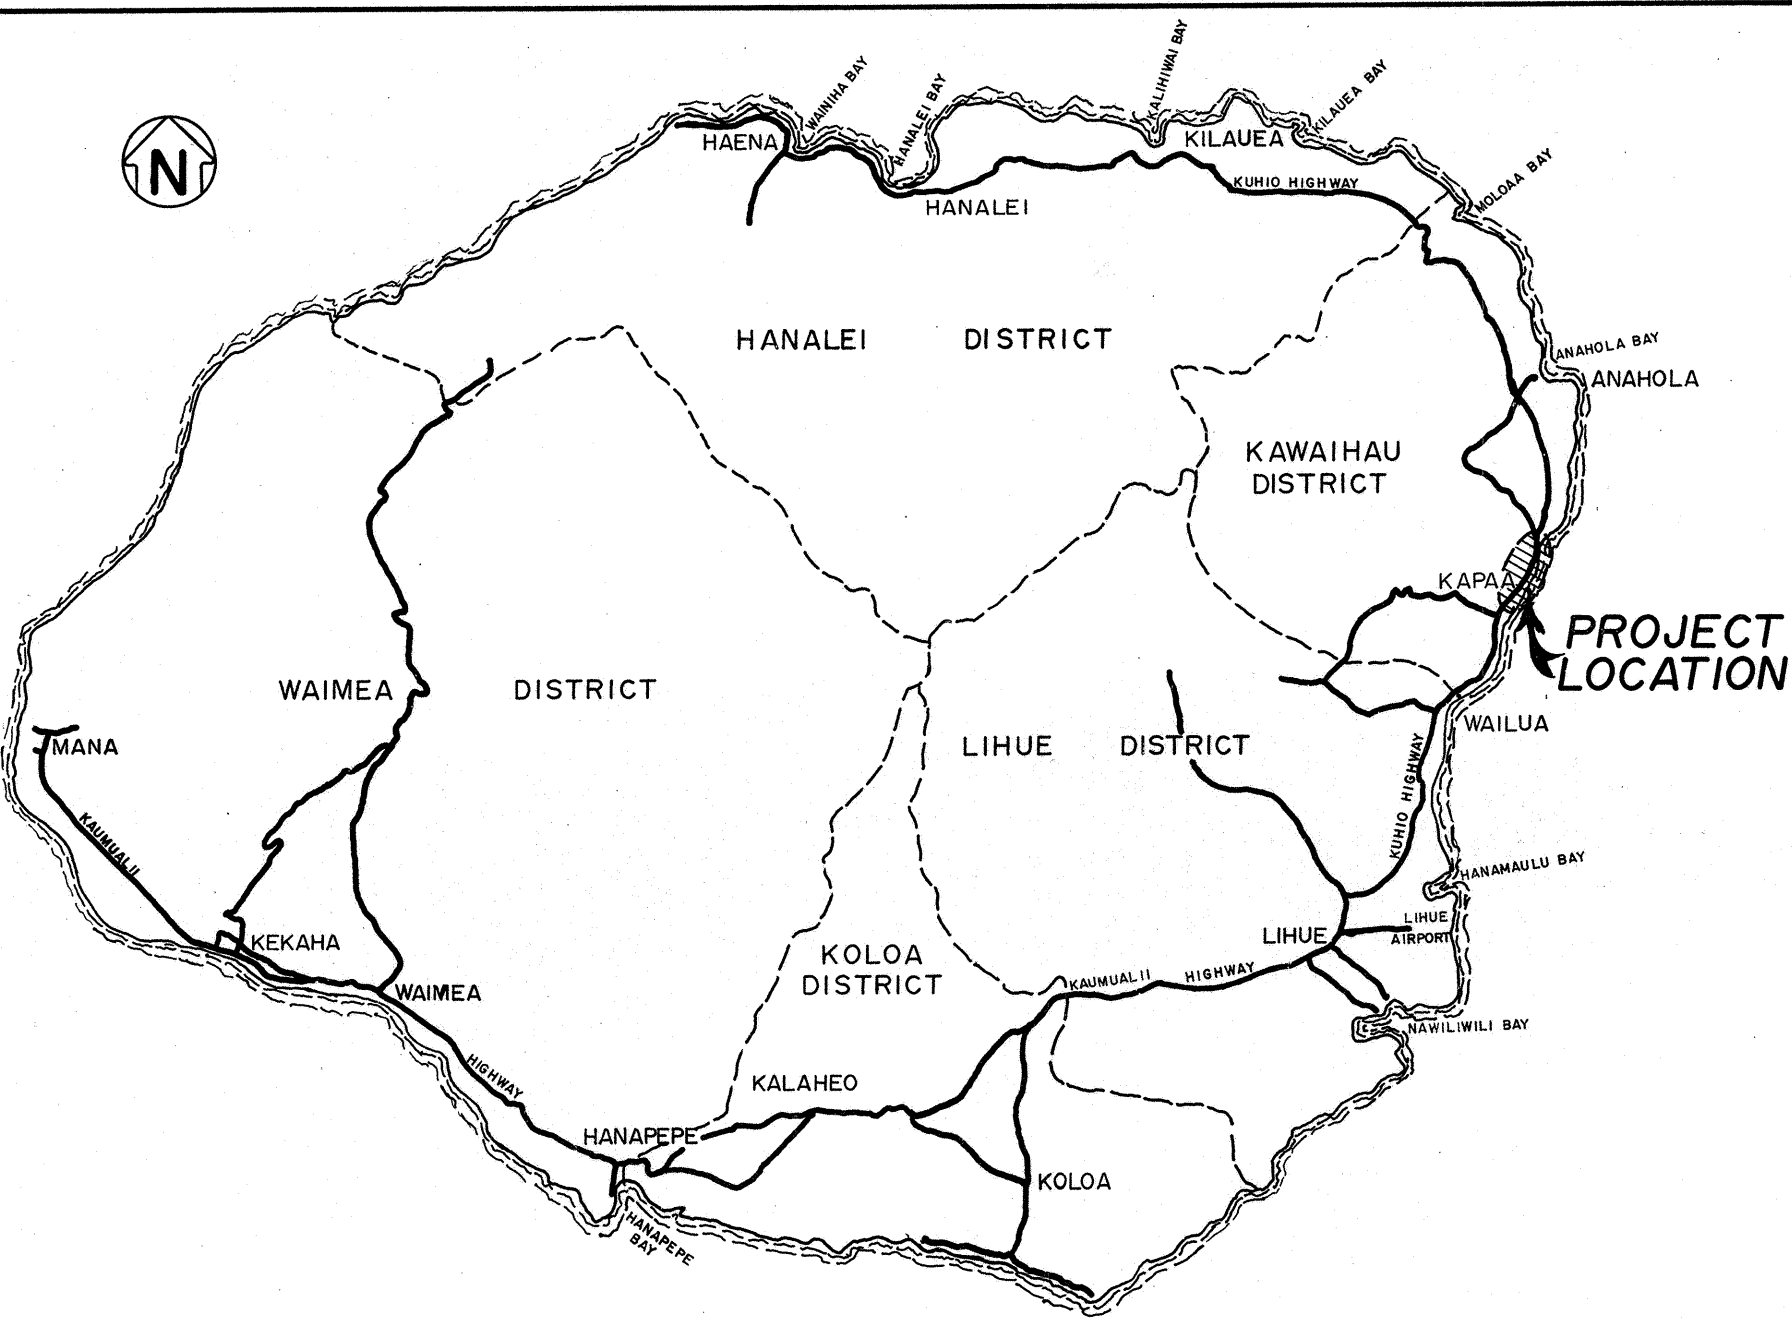


LOCATION MAP

ISLAND OF KAUAI

SCALE IN MILES

0 1 2 3 4

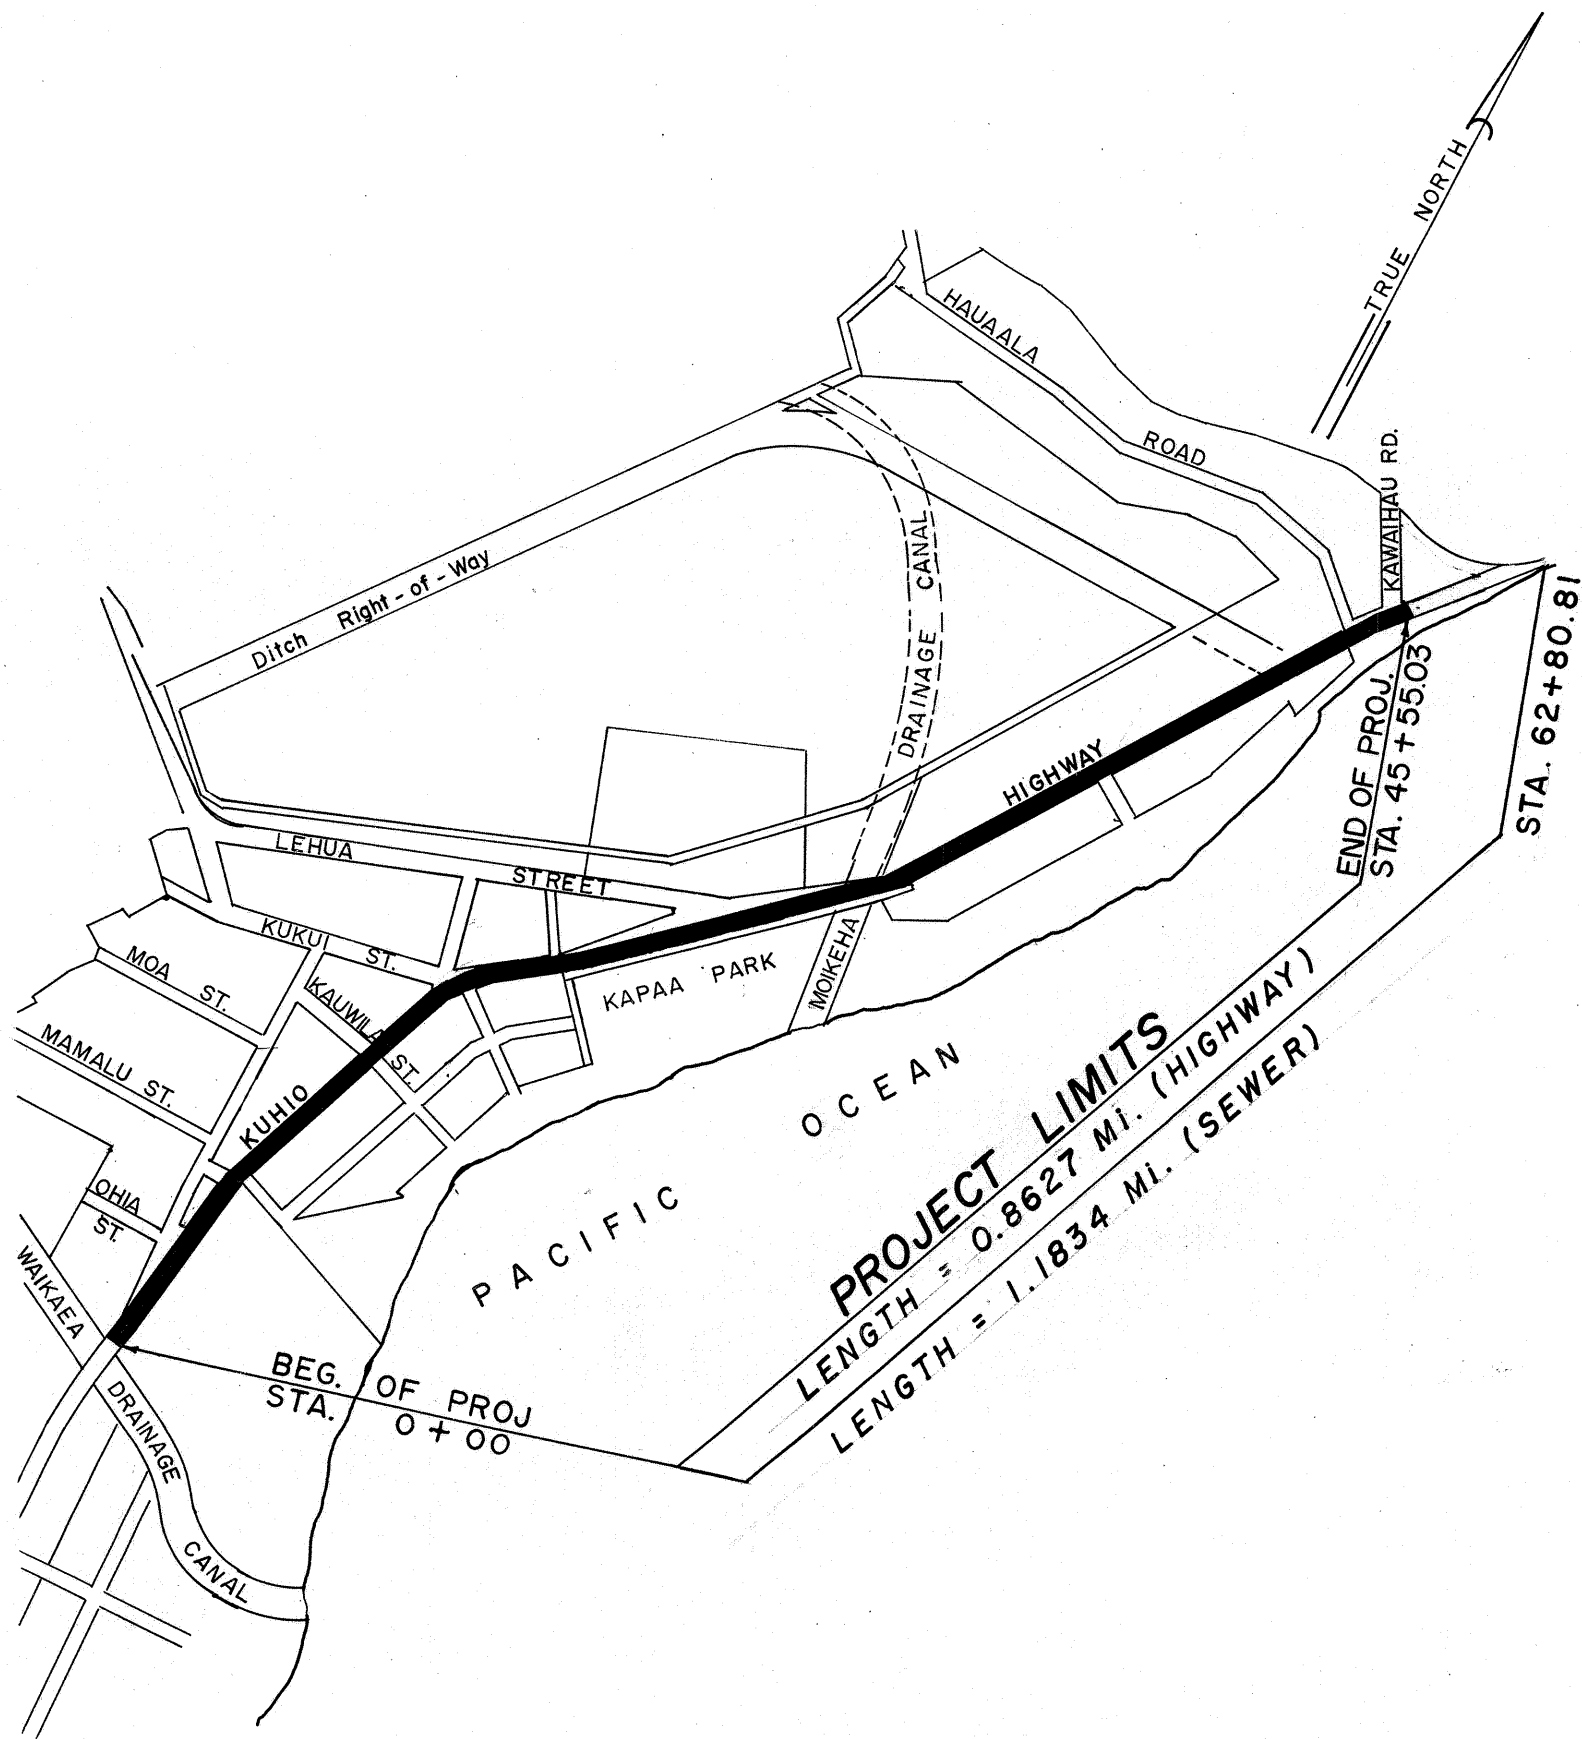

VICINITY MAP

SCALE: 1" = 600'

INDEX TO DRAWINGS

SHEET NO.	DESCRIPTION
1	TITLE SHEET
2-5	PLAN and PROFILE
6-7	TYPICAL ROADWAY SECTIONS
8-12	INTERSECTION PLANS
13-14	PAVEMENT MARKER & UTILITY RELOCATION PLAN
15-20	CROSS SECTIONS
21-40	STANDARD DETAILS
41-42	HAWAIIAN TELEPHONE MANHOLE DETAILS
43-44	PLAN & PROFILE - NEW 12" WATERLINE
44A-44B	PLAN & PROFILE - NEW 3" WATERLINE - C.O. NO. 4
45-46	WATER DETAILS
47-51	PLAN & PROFILE - COUNTY SEWER LINE
52	SEWER DETAILS
53	BORING LOGS

DESIGN DESIGNATION

CURRENT ADT (1972)	10,180
DESIGN ADT (1992)	20,220
DHV	9.5 %
D	55/45
T	4 %
V	35 M.P.H.

PREPARED BY:

KUTAKA, PORTUGAL & IBARA, INC.

ENGINEERS & SURVEYORS

LIHUE, KAUAI, HAWAII

NOTE:

ALL CHANGES MADE DURING CONSTRUCTION HAVE BEEN INCORPORATED ON THESE PLANS IN RED EXCEPT CHANGES IN THE ORIGINAL THEORETICAL QUANTITIES.

Chermayeff

PROJECT ENGINEER

3-30-78

DATE

DEPARTMENT OF TRANSPORTATION

STATE OF HAWAII

APPROVED:

E. Olvey Wright

9/19/74

DIR. OF TRANSPORTATION

DATE