•		
	SHEET NO 1 2-5 6-11	TITLE SHEET PLAN AND PROFILE MODIFIED CATCH BASIN, STANDARD, & MISC. DETAILS
·	12-13	ROADWAY STANDARD AND MISCELLANEOUS DETAILS
	June, 1975 Date	
	548-7537 Phone - Loc.	
	D. Bevier PSBE By	
	District ned By	

DEPARTMENT OF TRANSPORTATION HIGHWAYS DIVISION


AS BUILT !


PLANS FOR

KUHIO HIGHWAY DRAINAGE IMPROVEMENTS BETWEEN POINCIANA & HARDY STREETS

PROJECT NO. 56A-06-70 UNIT II

DISTRICT OF LIHUE
ISLAND OF KAUAI

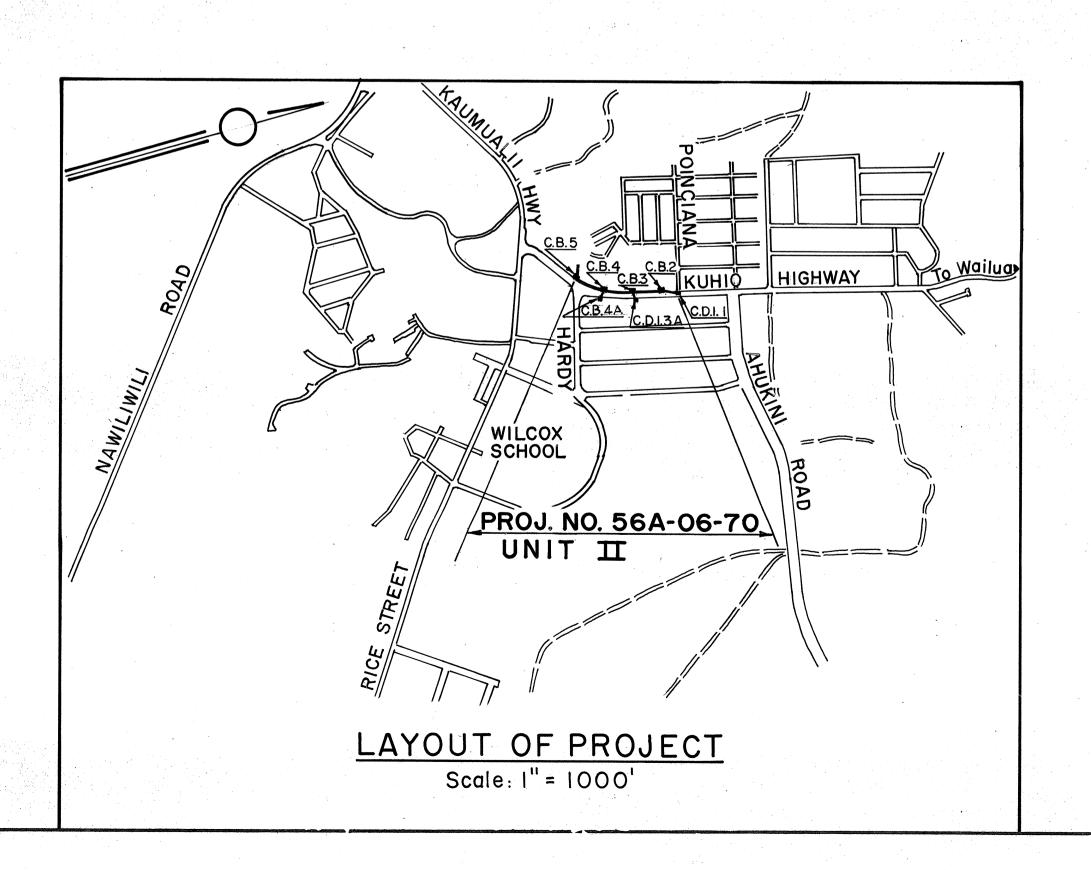

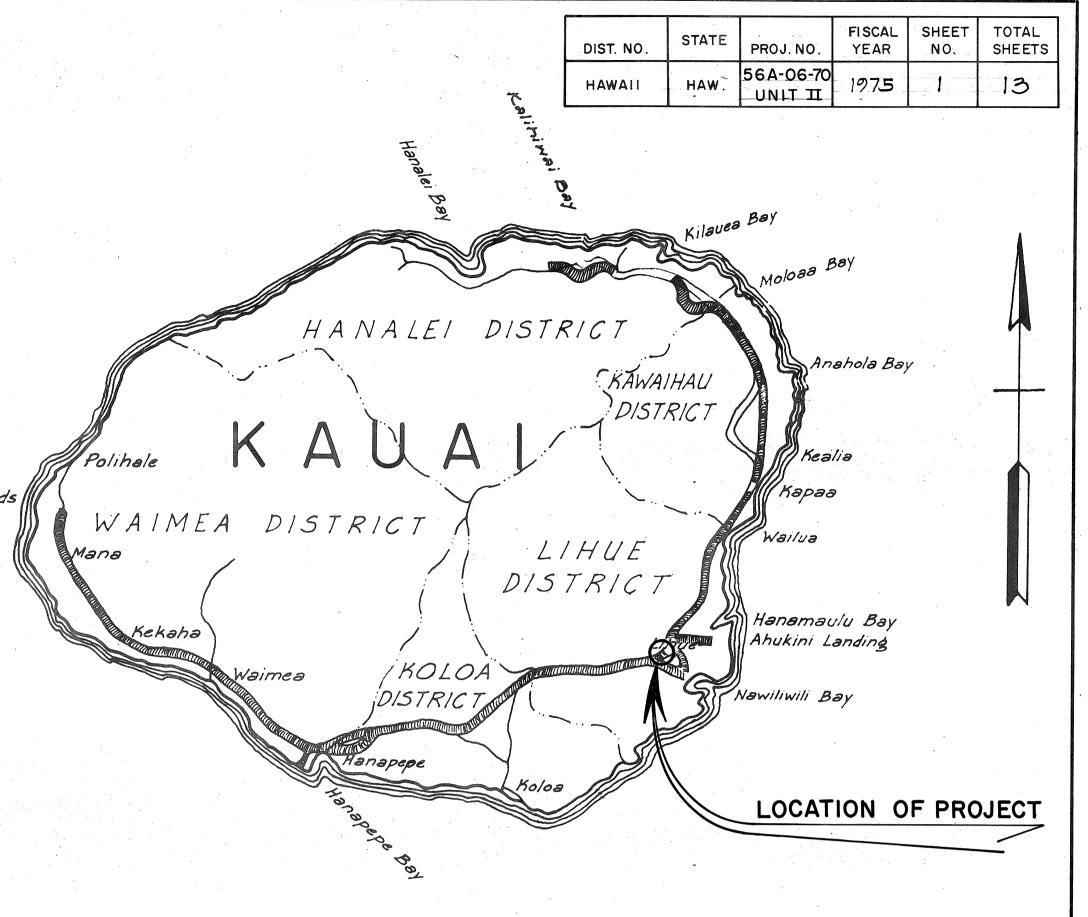

FEDERAL AID PROJECTS PREVIOUSLY CONSTRUCTED OR UNDER CONSTRUCTION

ALL CHANGES MADE DURING CONSTRUCTION
HAVE BEEN INCORPORATED ON THESE PLANS
EXCEPT CHANGES IN THE ORIGINAL THEORETICAL
QUANTITIES

PROJECT ENGINEER

8-11-81 DATE

DEPARTMENT OF TRANSPORTATION
STATE OF HAWAII

APPROVED:

DIR. OF TRANSPORTATION DATE