
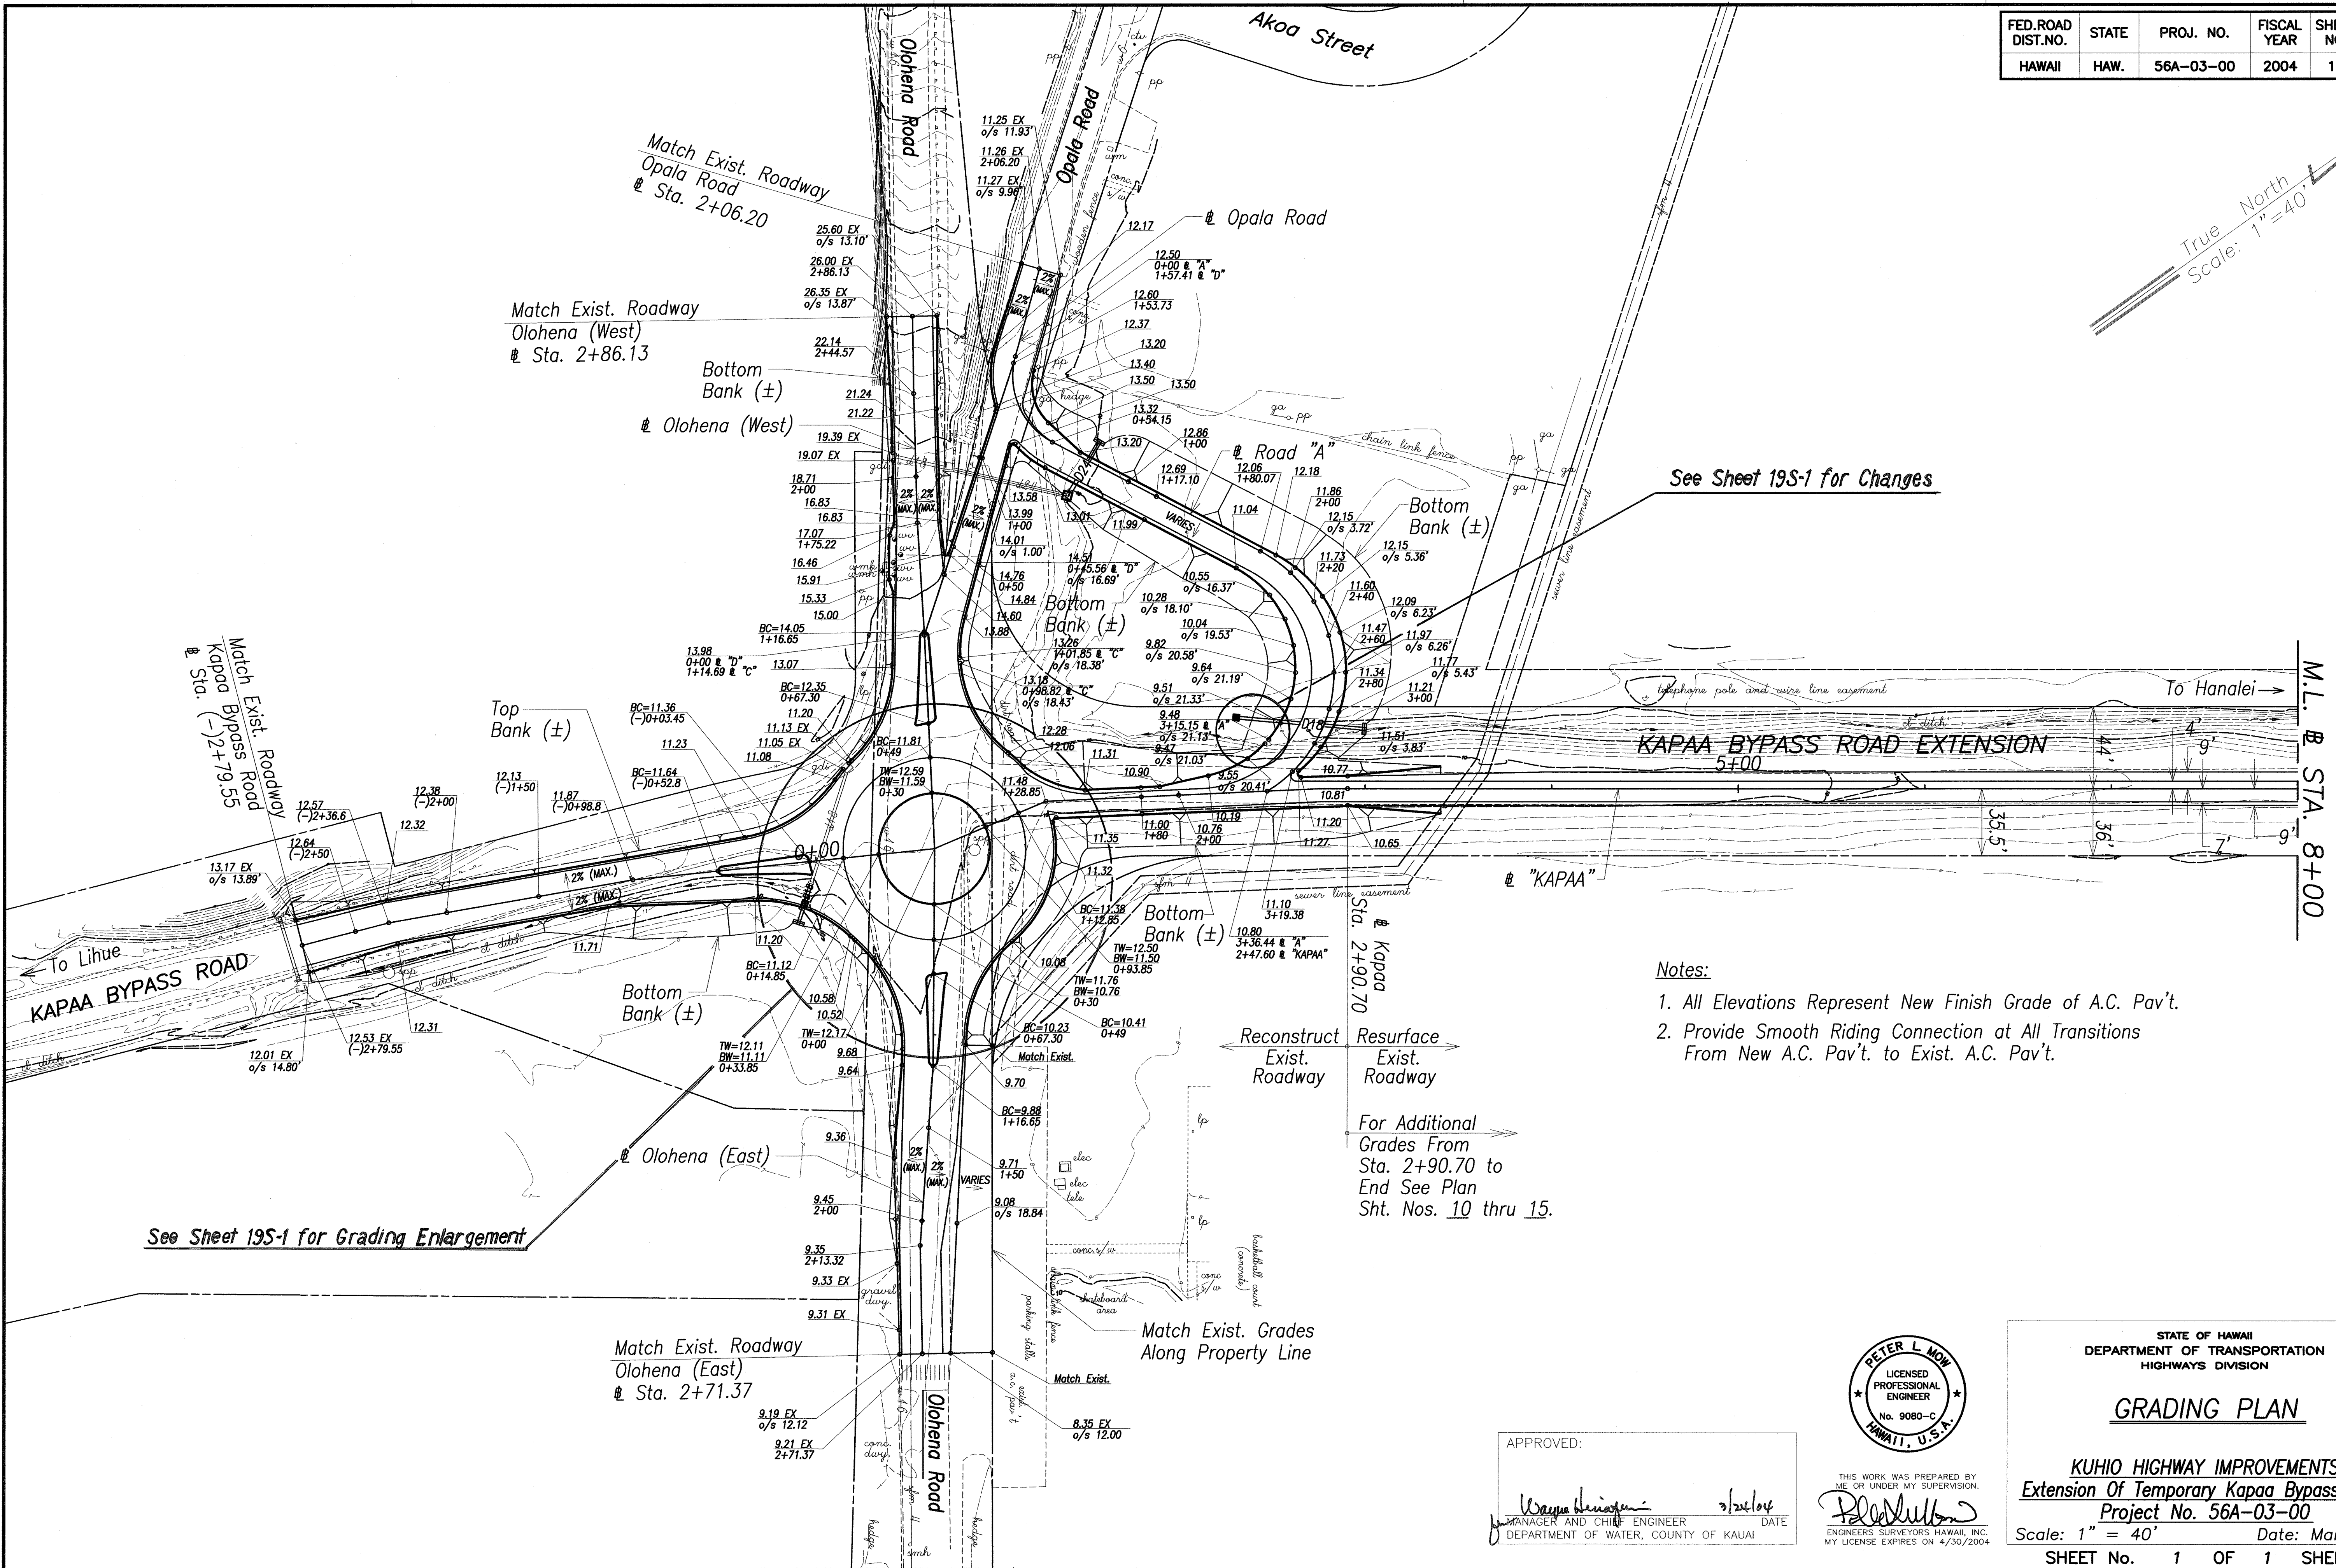


FED. ROAD DIST. NO.	STATE	PROJ. NO.	FISCAL YEAR	SHEET NO.	TOTAL SHEETS
HAWAII	HAW.	56A-03-00	2004	19	66

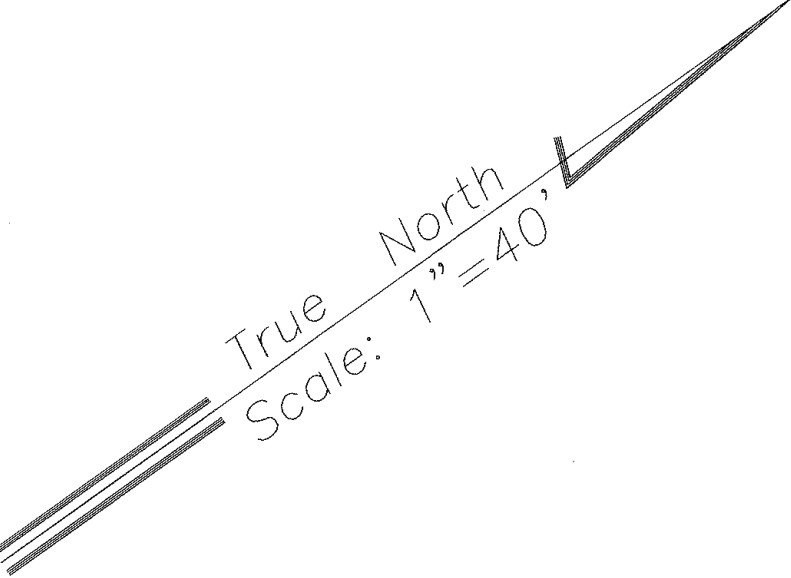

- Notes:
1. All Elevations Represent New Finish Grade of A.C. Pav't.
 2. Provide Smooth Riding Connection at All Transitions From New A.C. Pav't. to Exist. A.C. Pav't.

Reconstruct
Exist.
Roadway


Resurface
Exist.
Roadway

For Additional
Grades From
Sta. 2+90.70 to
End See Plan
Sht. Nos. 10 thru 15.

ORIGINAL PLAN	SURVEY PLOTTED BY	DATE
NOTE BOOK	DESIGNED BY	
XX/XX	QUANTITIES BY	
XX/XX	CHECKED BY	
No.		

APPROVED:

Wayne Huiangani 3/26/04
MANAGER AND CHIEF ENGINEER
DEPARTMENT OF WATER, COUNTY OF KAUAI

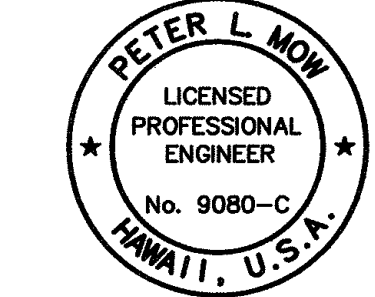

THIS WORK WAS PREPARED BY
ME OR UNDER MY SUPERVISION.
Peter L. Mow
ENGINEERS SURVEYORS HAWAII, INC.
MY LICENSE EXPIRES ON 4/30/2004

STATE OF HAWAII
DEPARTMENT OF TRANSPORTATION
HIGHWAYS DIVISION

GRADING PLAN


KUHIO HIGHWAY IMPROVEMENTS
Extension Of Temporary Kapaa Bypass Road
Project No. 56A-03-00

Scale: 1" = 40' Date: Mar 2004


SHEET No. 1 OF 1 SHEETS

"AS-BUILT"


FED. ROAD DIST. NO.	STATE	FED. AID PROJ. NO.	FISCAL YEAR	SHEET NO.	TOTAL SHEETS
HAWAII	HAW.	56A-03-00	2004	19S-1	66

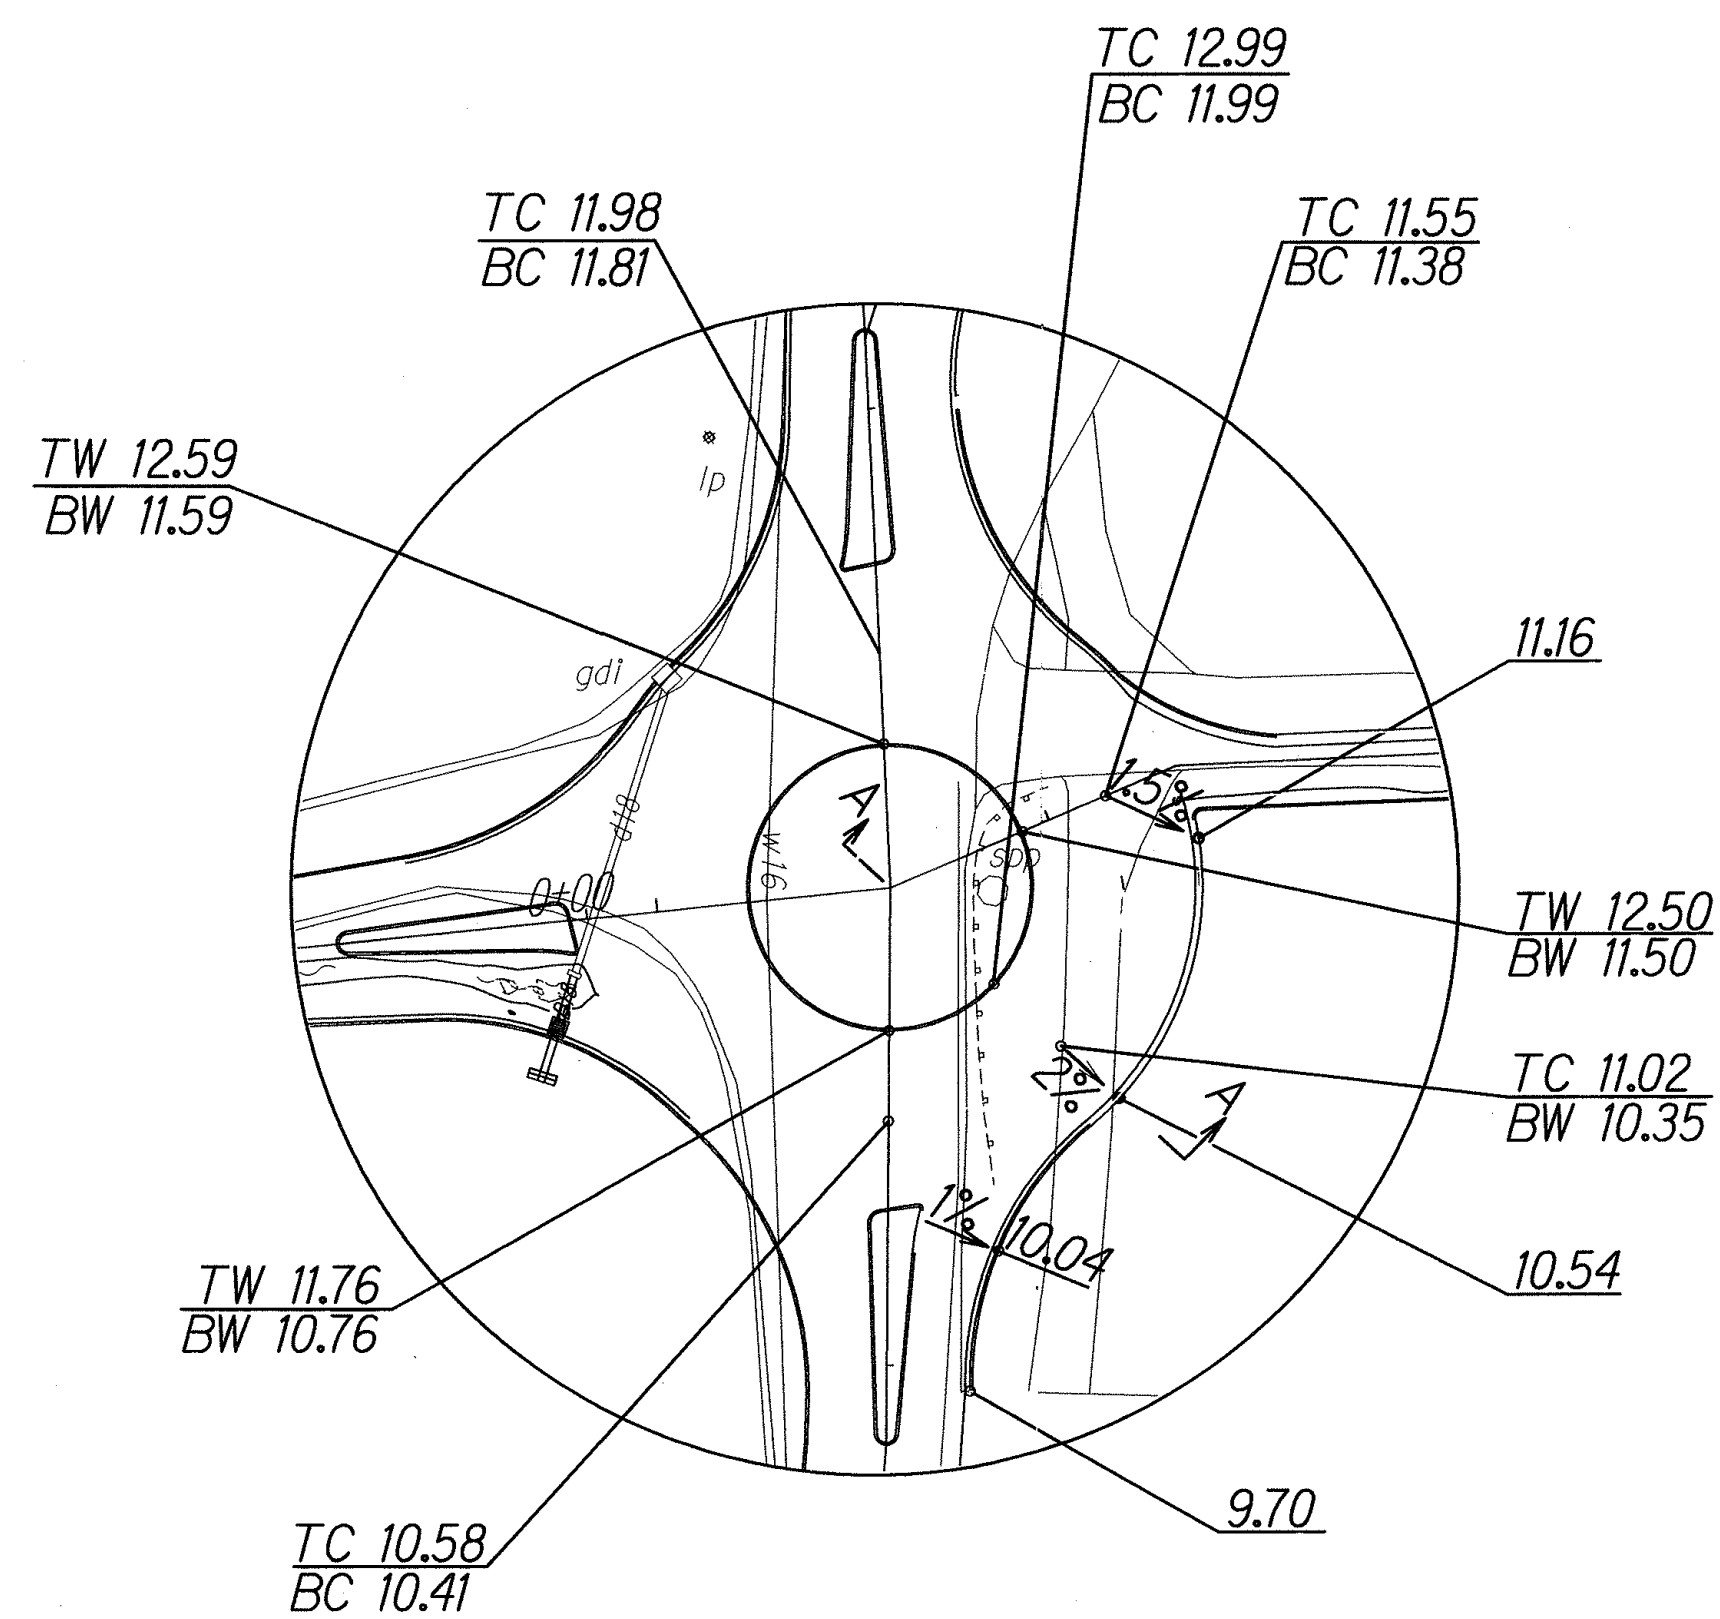

Grading Plan
Not to Scale

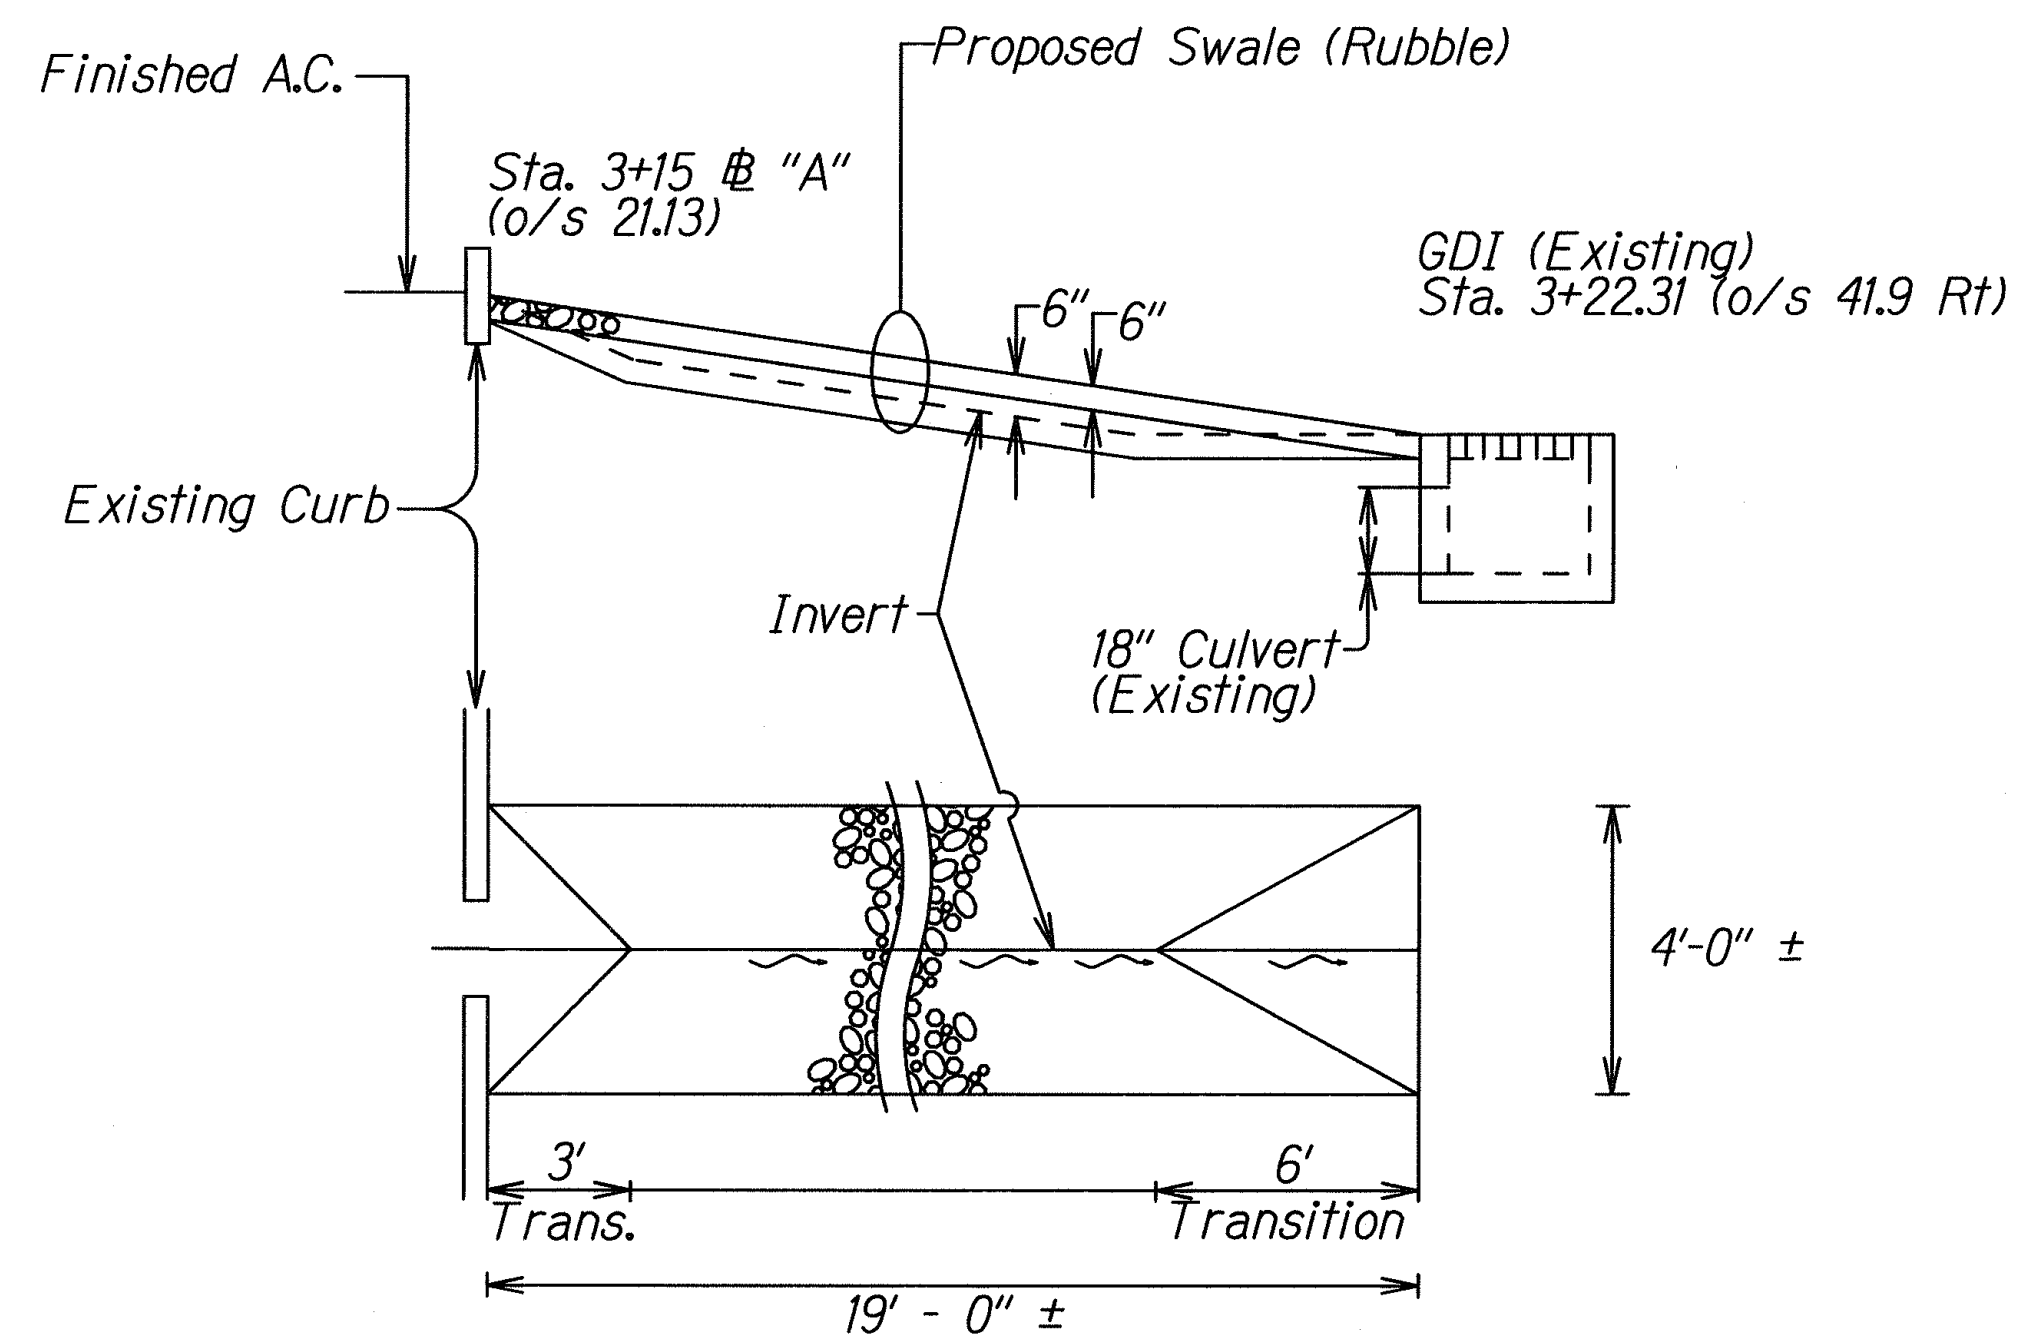

61614 RUBBLE SWALE
Not to Scale

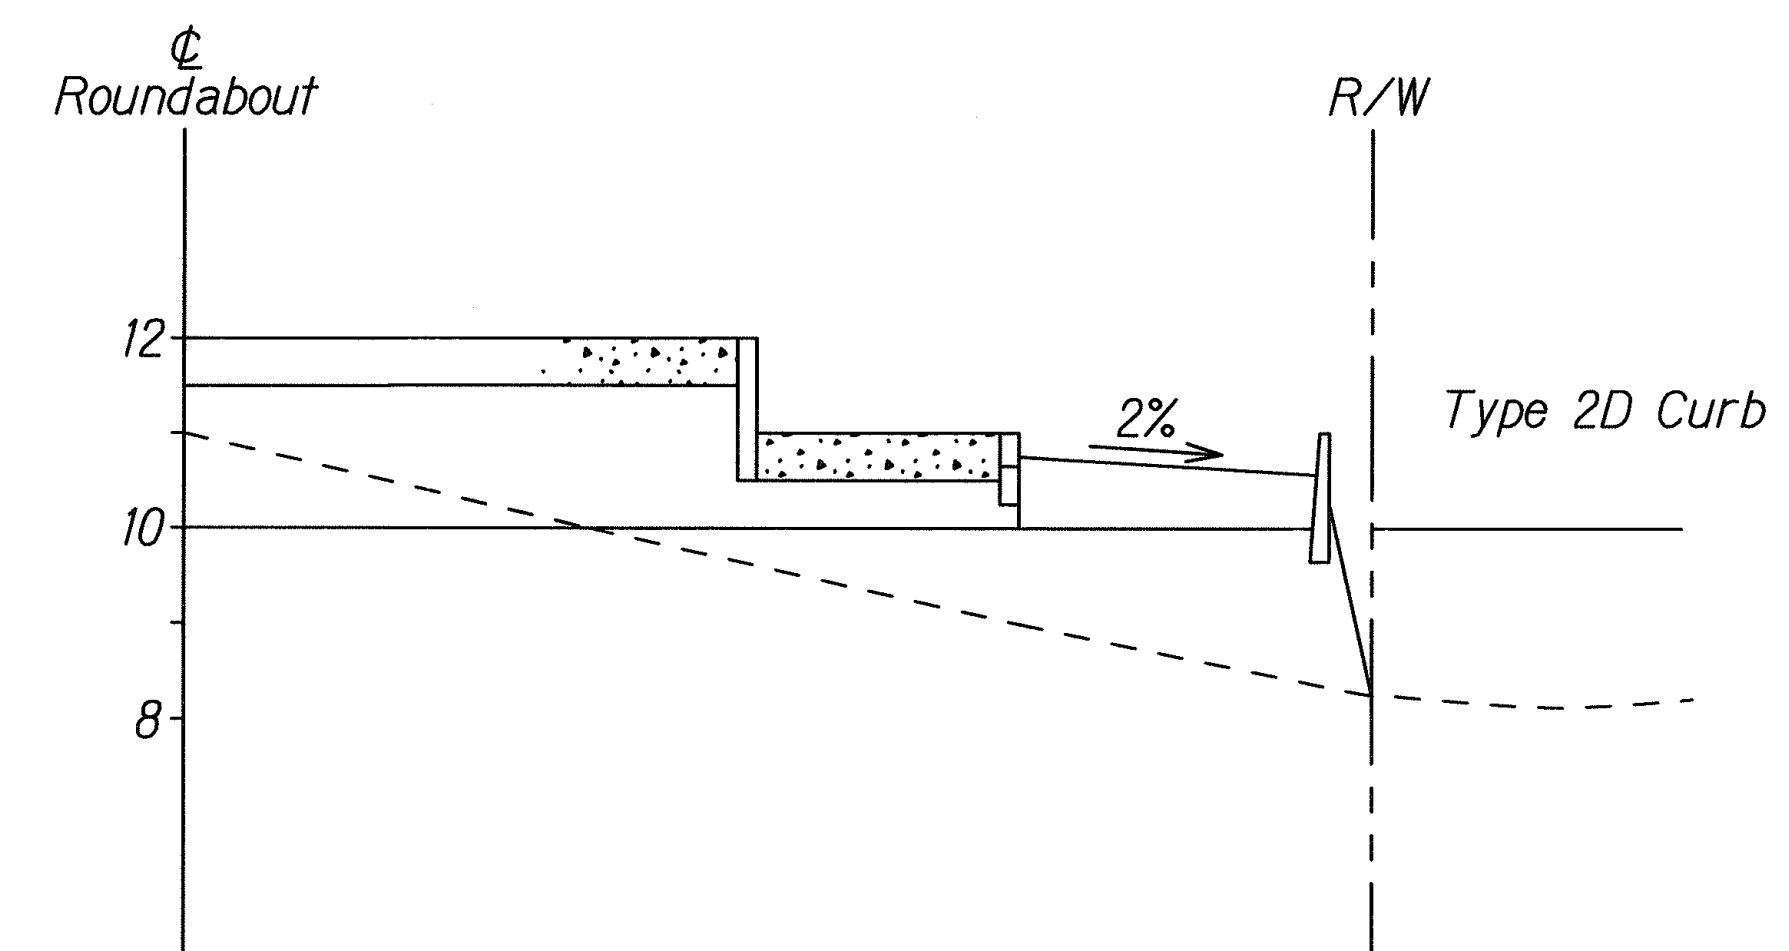

SECTION A-A
Not to Scale

ORIGINAL PLAN	SURVEY PLOTTED BY	DATE
NOTE BOOK	DRAWN BY	
dd2/mark	TRACED BY	
	CHECKED BY	

STATE OF HAWAII
DEPARTMENT OF TRANSPORTATION
HIGHWAYS DIVISION

GRADING PLAN

KUHIO HIGHWAY IMPROVEMENTS
Extension of Temporary Kapaa Bypass Road
Project No. 56A-03-00

Scale: 1" = 40' Date: Mar., 2004

SHEET No. 1 OF 1 SHEETS