



FED. ROAD DIST. NO.	STATE	PROJ. NO.	FISCAL YEAR	SHEET NO.	TOTAL SHEETS
HAWAII	HAW.	56A-03-00	2004	15	66


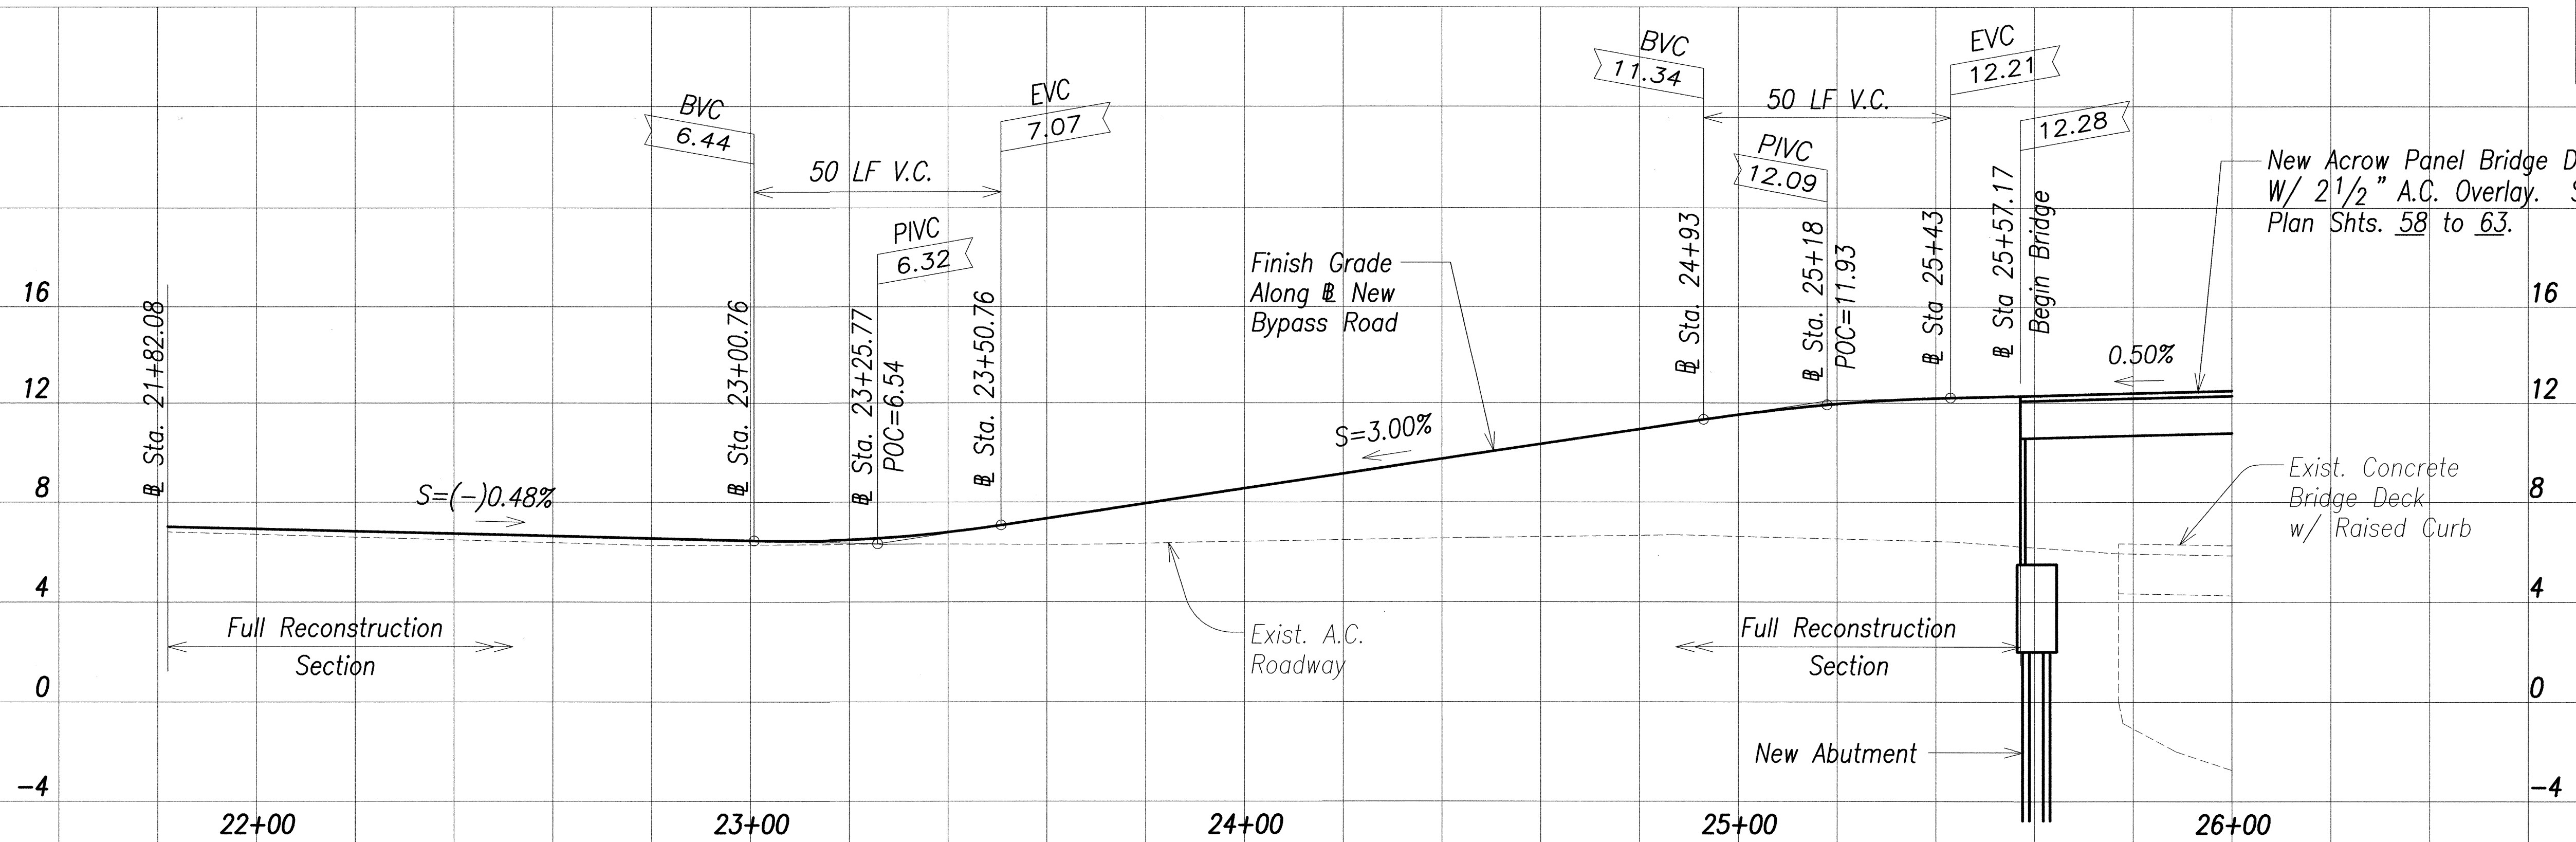


PROFILE - BRIDGE APPROACH (SOUTH SIDE)

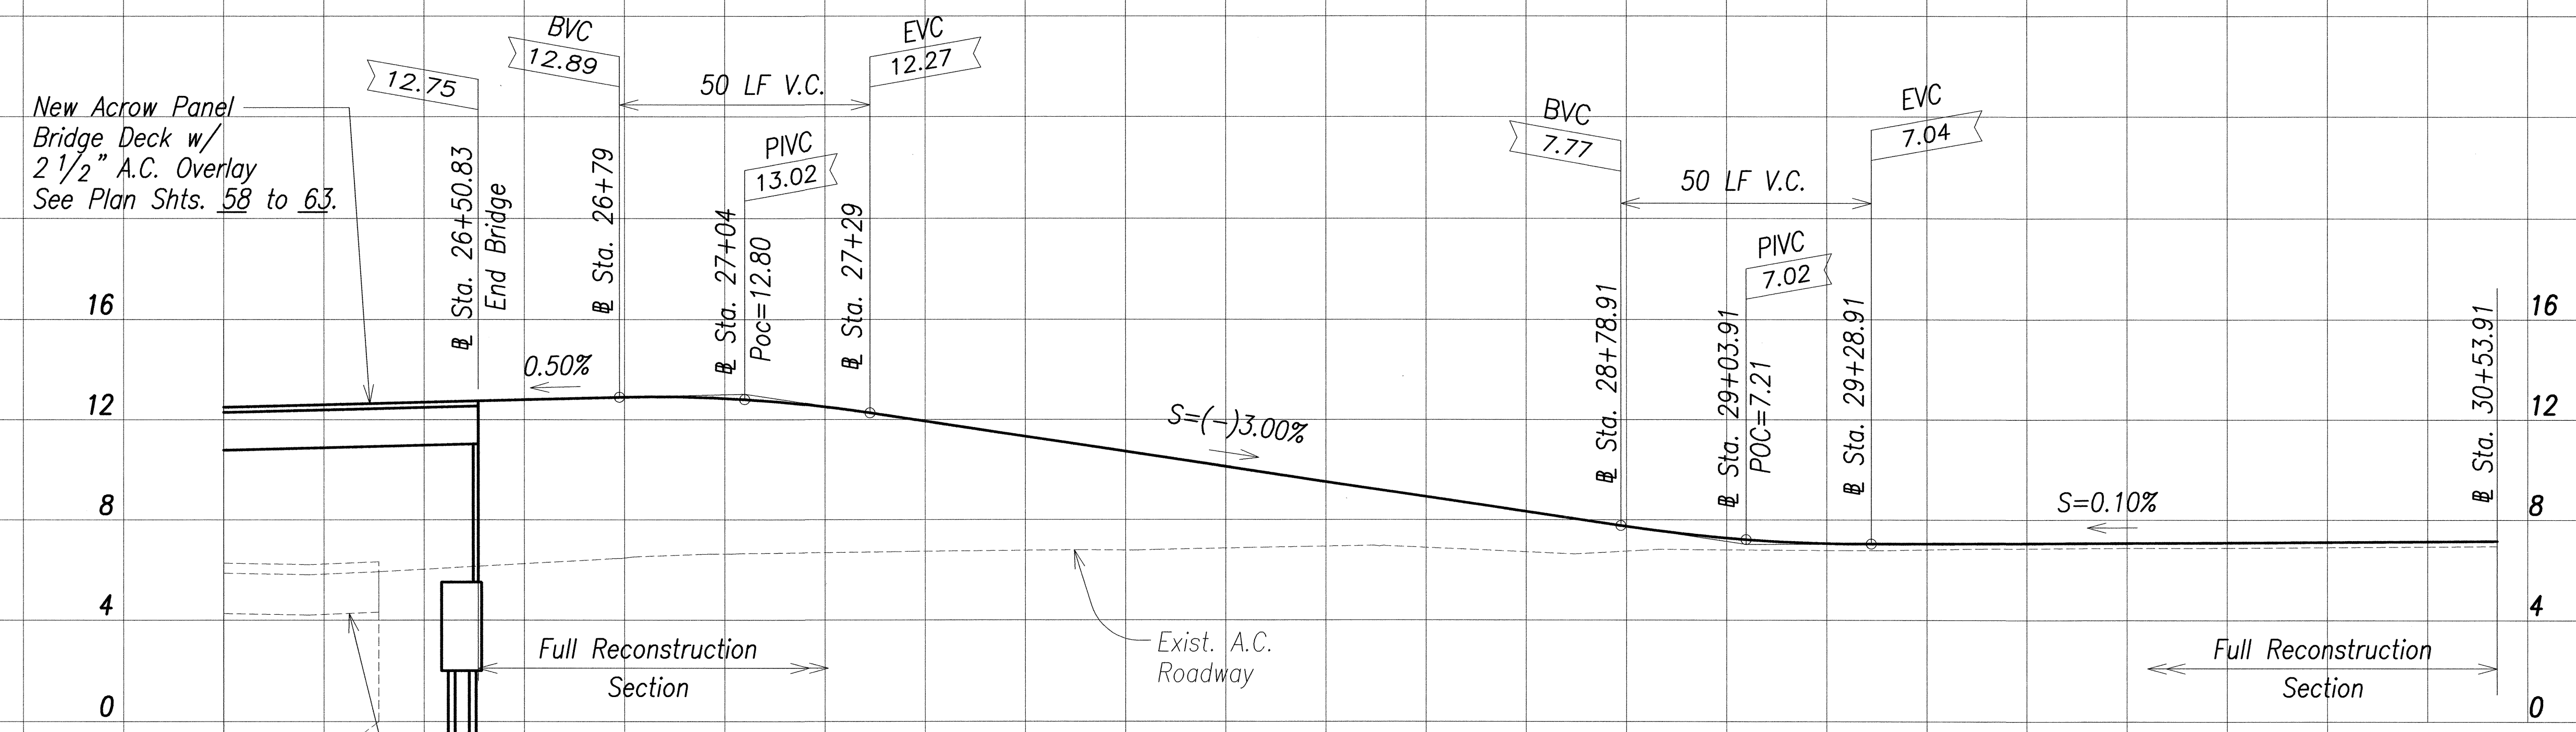

PROFILE - BRIDGE APPROACH (NORTH SIDE)

ORIGINAL PLAN
DATE
SURVEY PLOTTED BY
DRAWN BY
NOTED BY
DESIGNED BY
CHECKED BY
No.

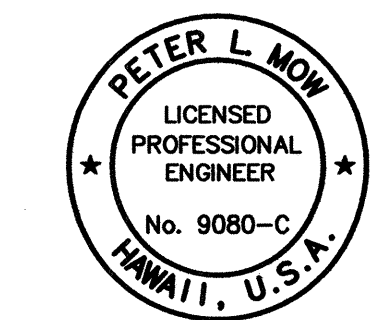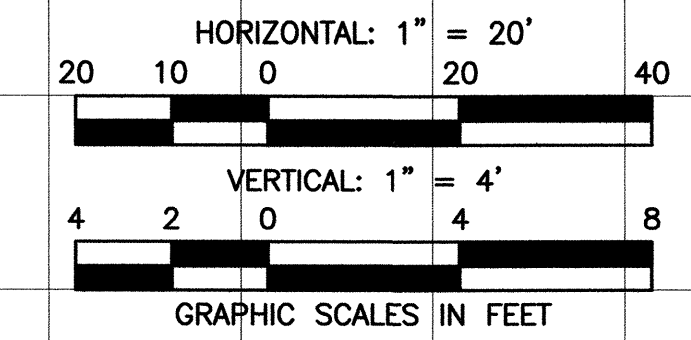

THIS WORK WAS PREPARED BY
ME OR UNDER MY SUPERVISION.
Peter L. Dow
ENGINEERS SURVEYORS HAWAII, INC.
MY LICENSE EXPIRES ON 4/30/2004

STATE OF HAWAII
DEPARTMENT OF TRANSPORTATION
HIGHWAYS DIVISION

ROADWAY PROFILE
KUHIO HIGHWAY IMPROVEMENTS
Extension Of Temporary Kapaa Bypass Road
Project No. 56A-03-00

Scale: As Noted
Date: Mar 2004
SHEET No. 1 OF 1 SHEETS