
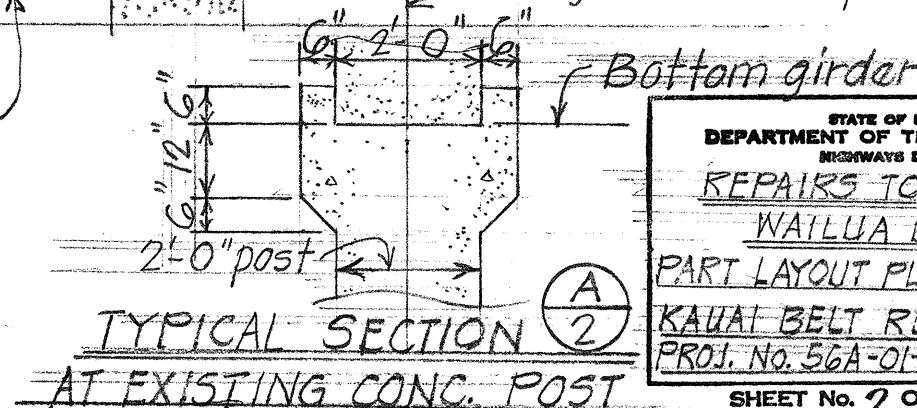
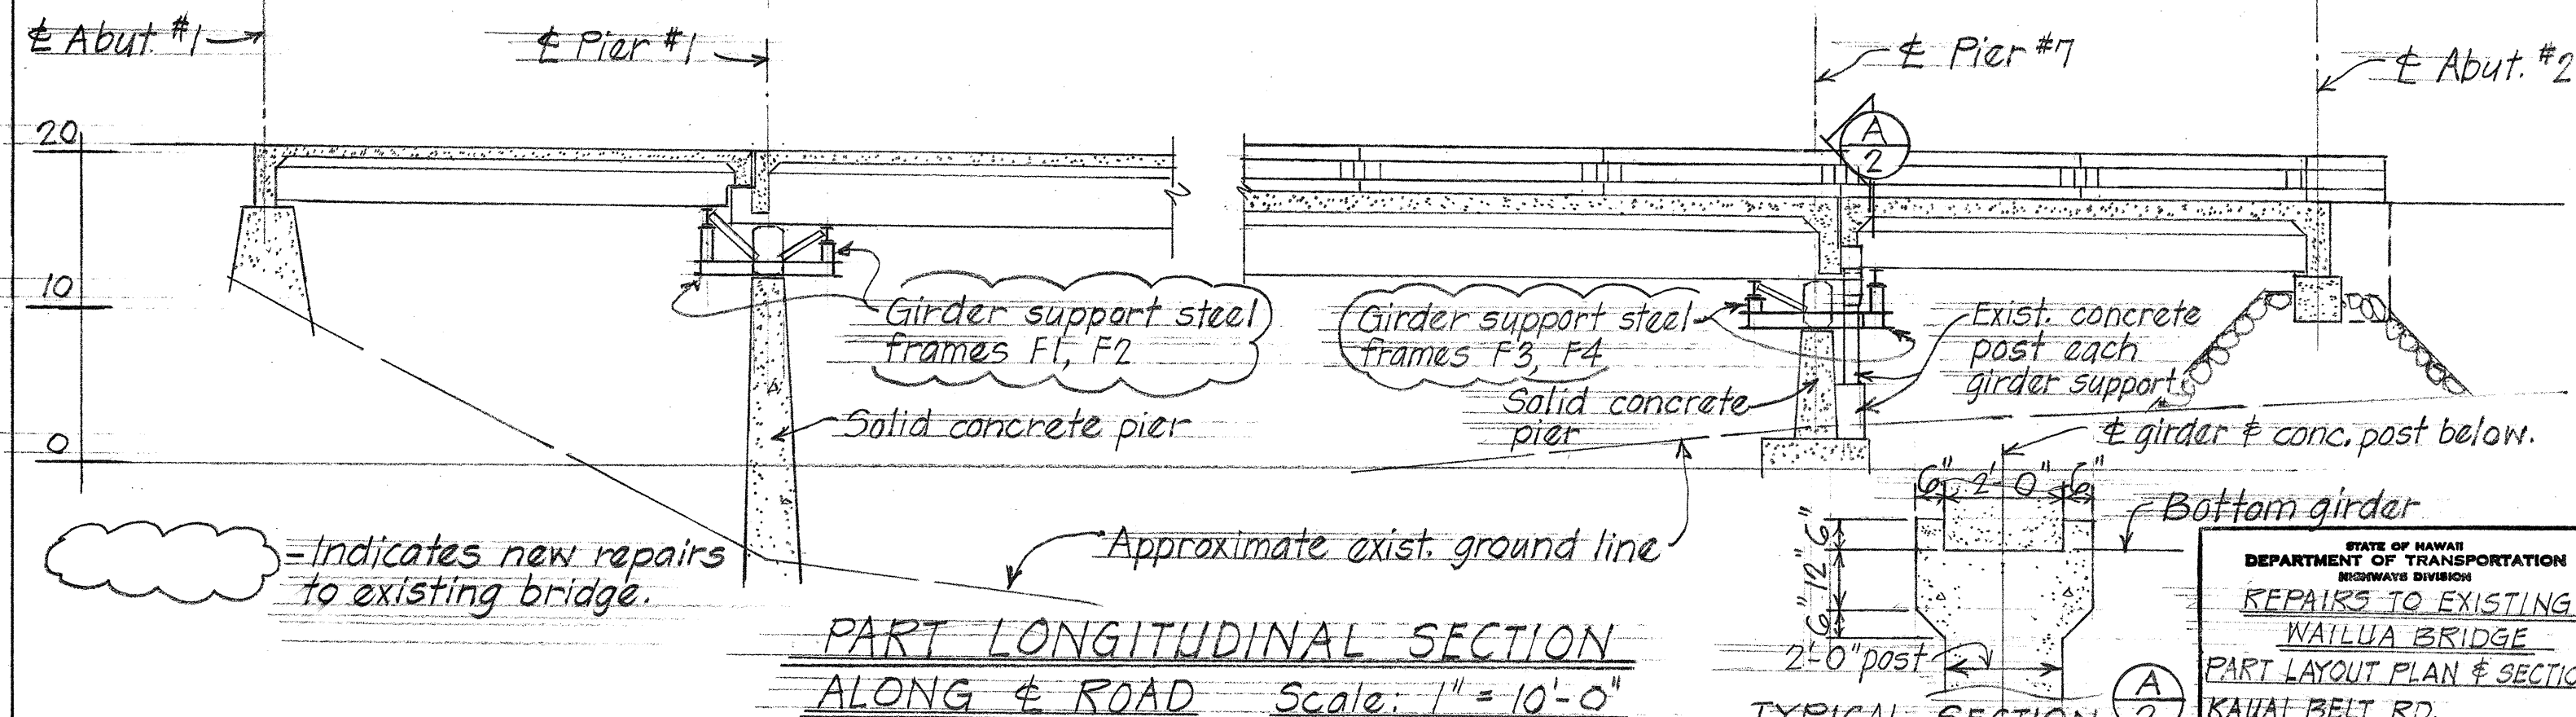


FED. ROAD DIST. NO.	STATE	FED-AID PROJ. NO.	FISCAL YEAR	SHEET NO.	TOTAL SHEETS
HAWAII	HAW.	56A-01-75	1975	2	5

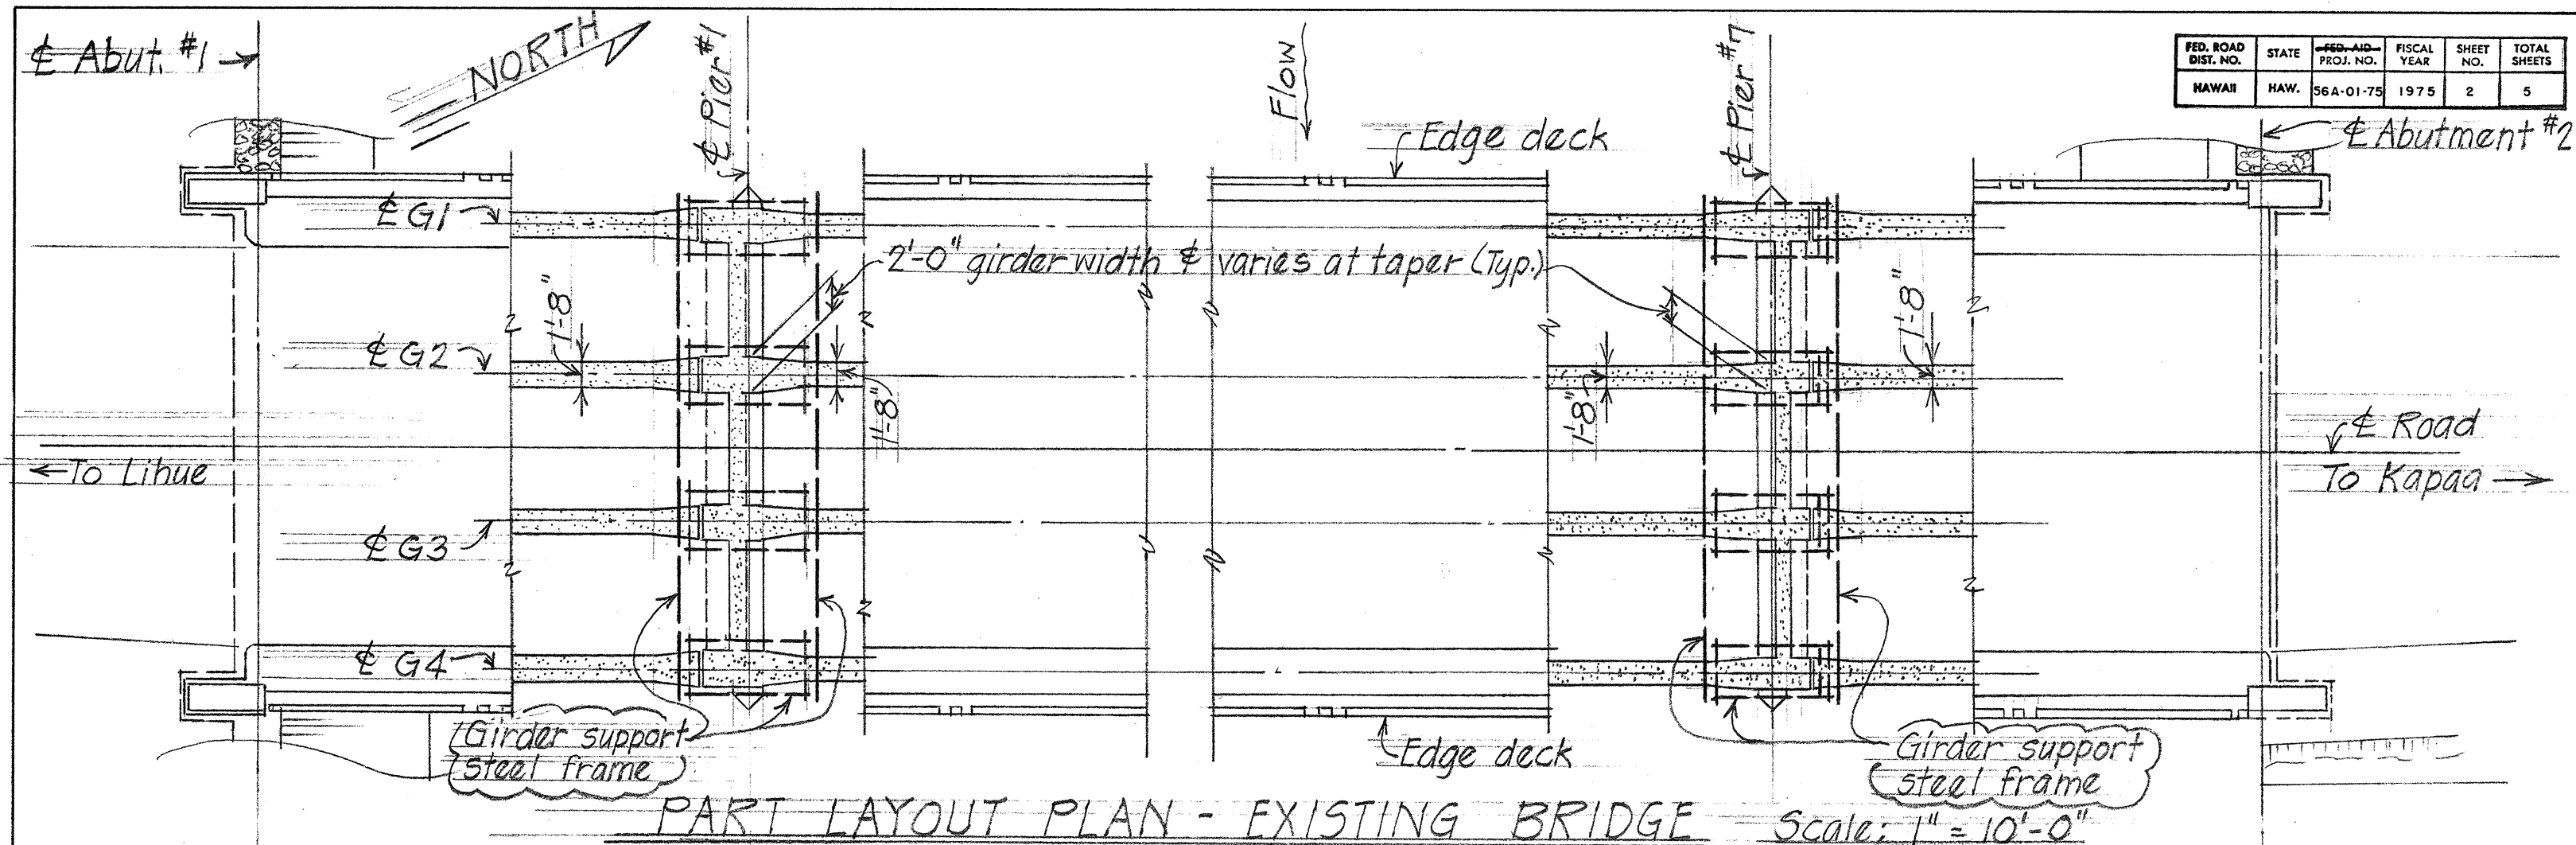

STATE OF HAWAII
DEPARTMENT OF TRANSPORTATION
HIGHWAYS DIVISION
REPAIRS TO EXISTING
WAILUA BRIDGE
PART LAYOUT PLAN & SECTION
KAUAI BELT RD.
PROJ. No. 56A-01-75 NOV. 1974
SHEET No. 2 OF 5 SHEETS