



FED. ROAD DIST. NO.	STATE	FED. AID PROJ. NO.	FISCAL YEAR	SHEET NO.	TOTAL SHEETS
HAWAII	HAW.	56A-01-75	1975	4	5

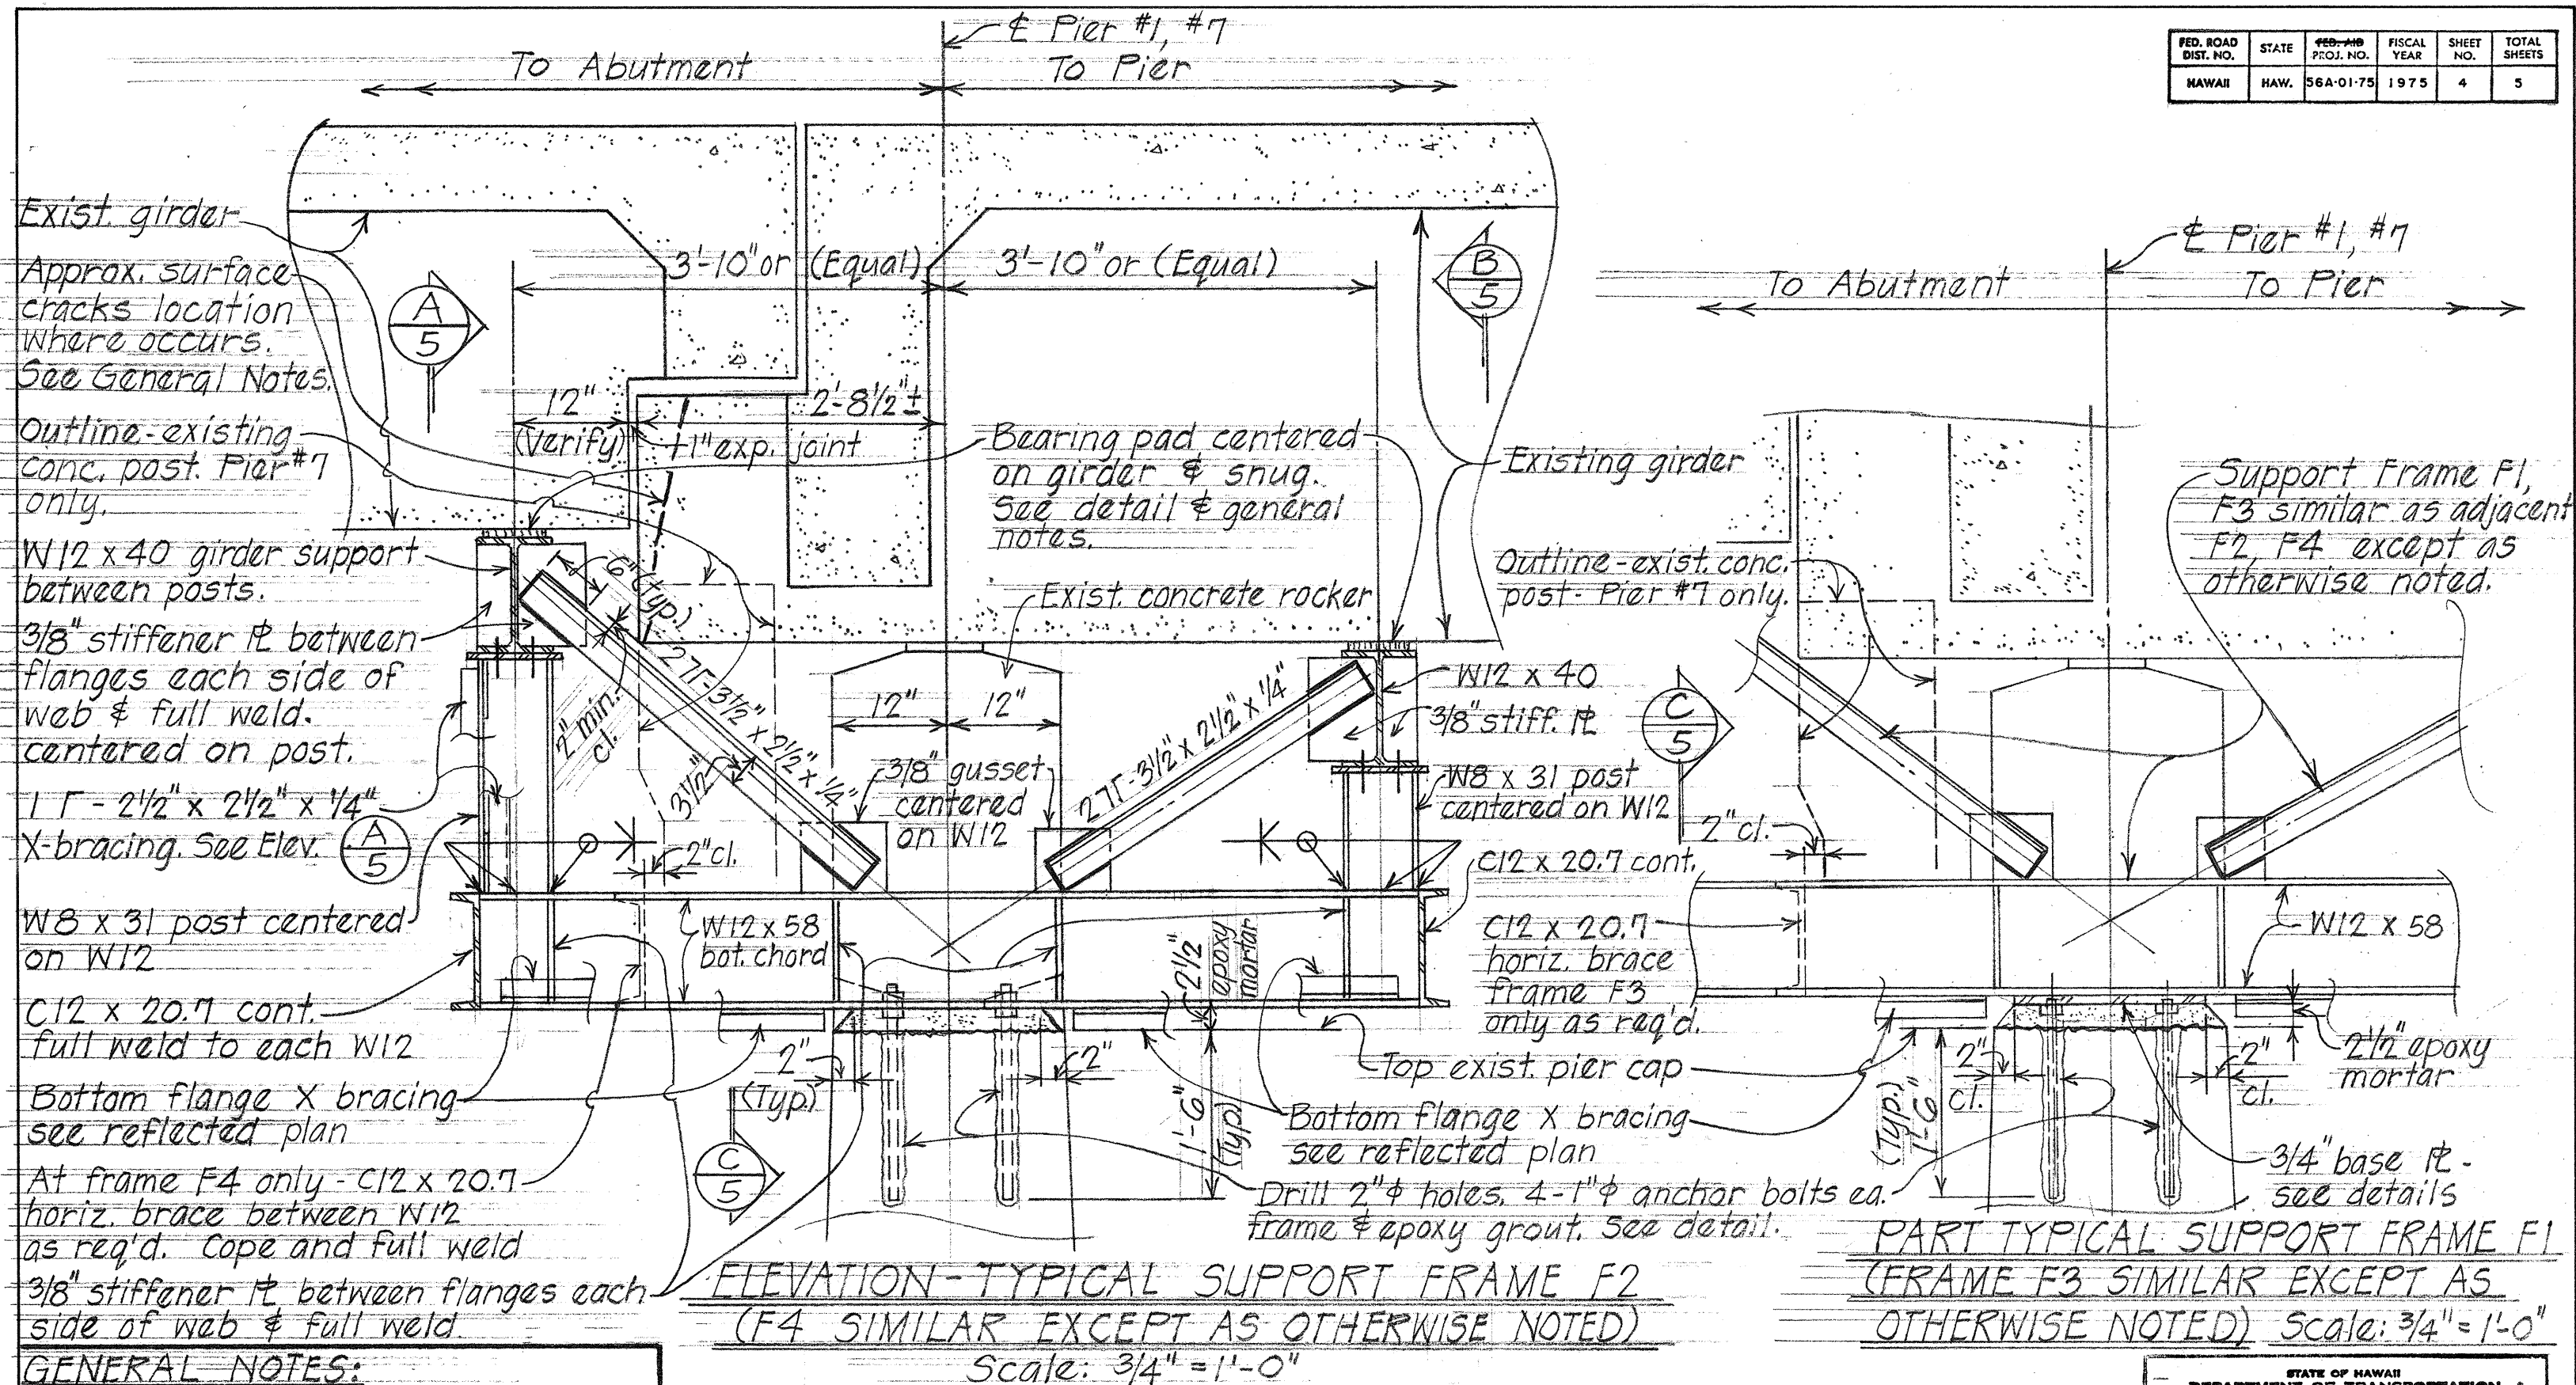


STATE OF HAWAII
DEPARTMENT OF TRANSPORTATION
HIGHWAYS DIVISION
REPAIRS TO WAILUA BRIDGE
SECTIONS & DETAILS
KAUAI BELT RD.
PROJ. No. 56A-01-75 Nov. 1974
SHEET No. 4 OF 5 SHEETS


FED. ROAD DIST. NO.	STATE	PROJ. NO.	FISCAL YEAR	SHEET NO.	TOTAL SHEETS
HAWAII	HAW.	56A-01-75	1975	5	5

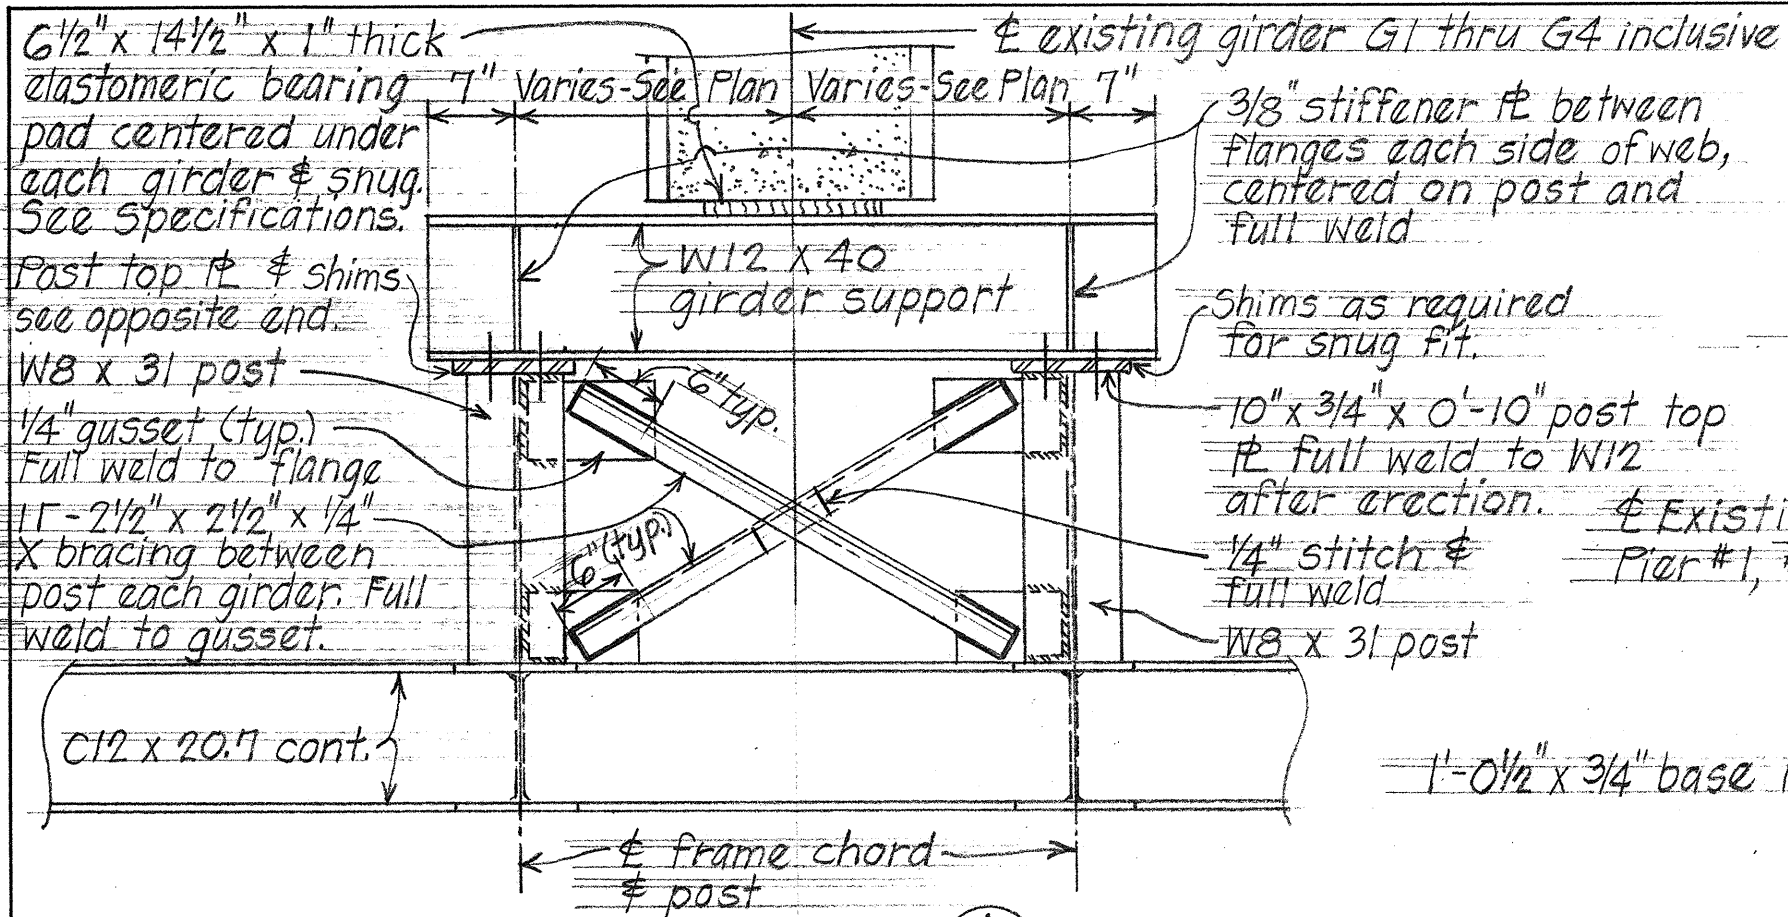

ELEVATION **A-5** Scale: 3/4" = 1'-0"

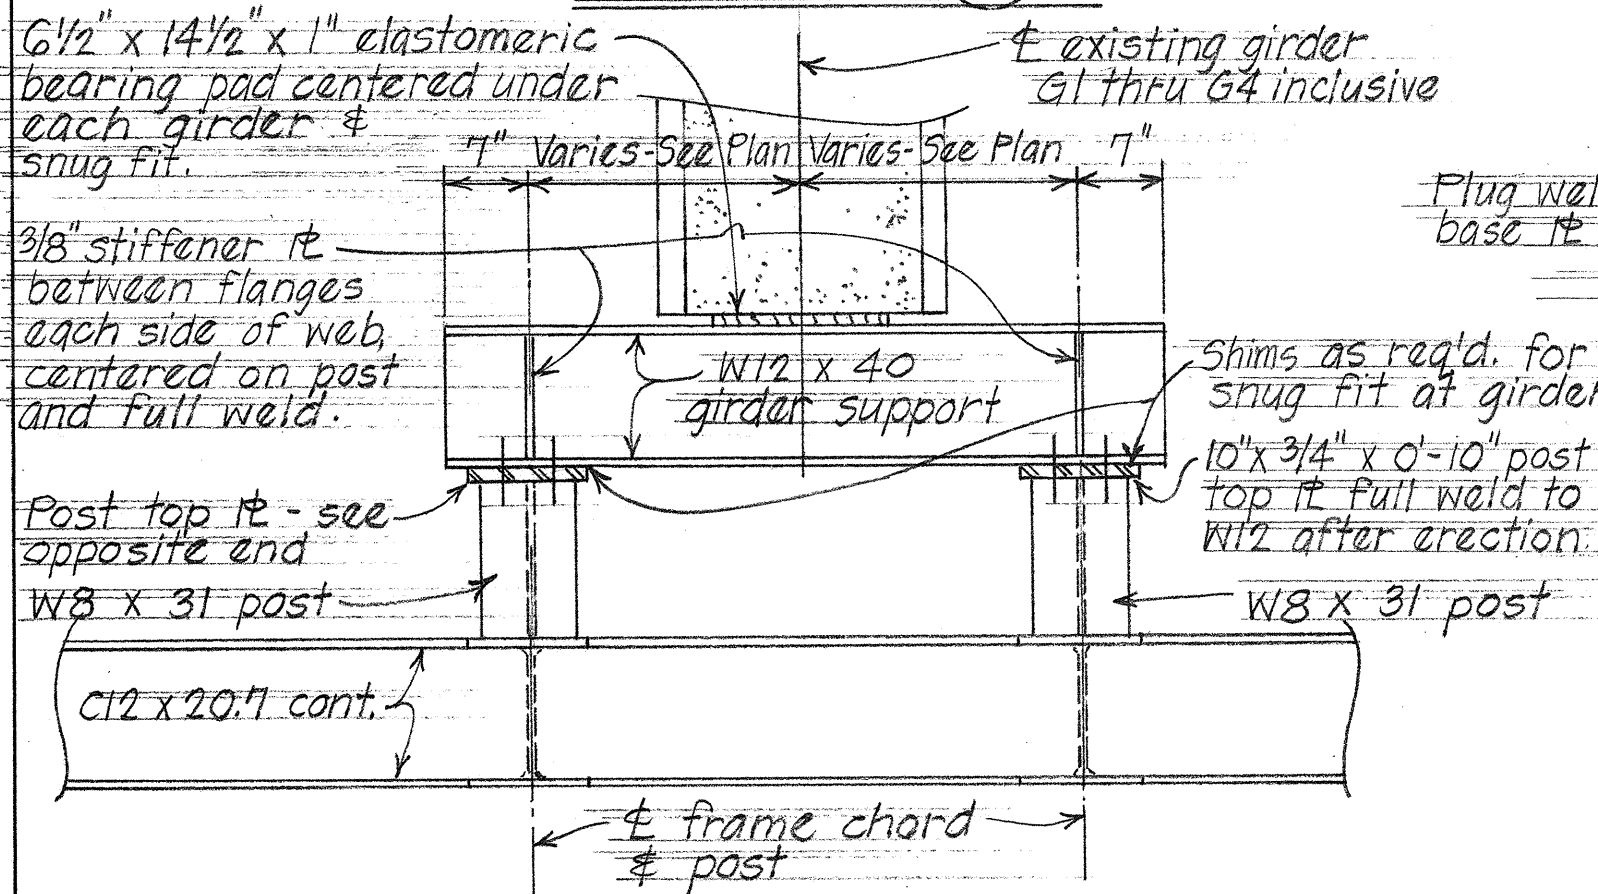


ELEVATION **B-5** Scale: 3/4" = 1'-0"

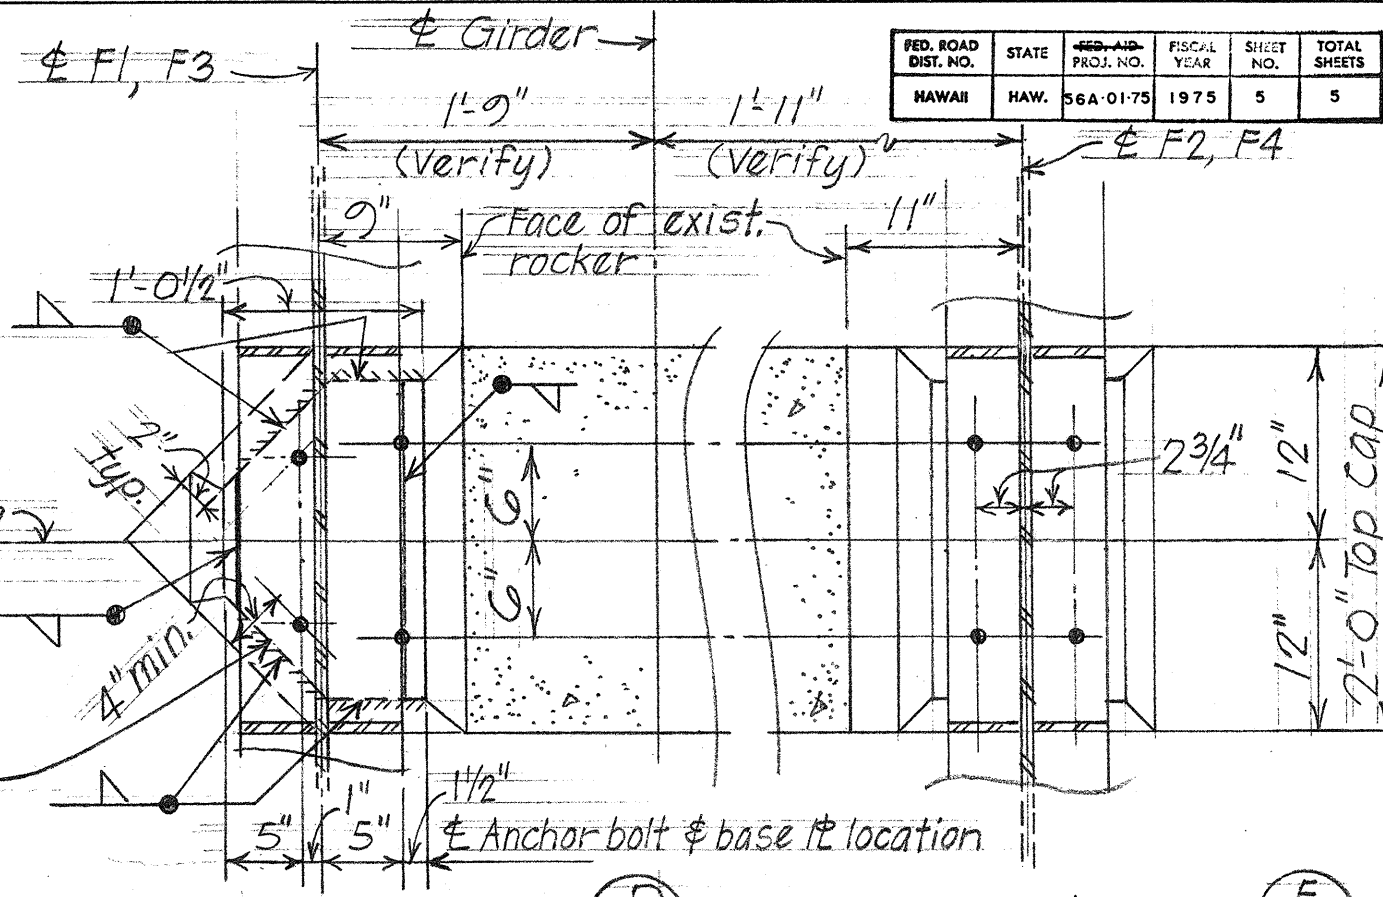

PLAN SECTION **D-5** Scale: 1" = 1'-0"

PLAN SECTION **E-5** Scale: 1" = 1'-0"

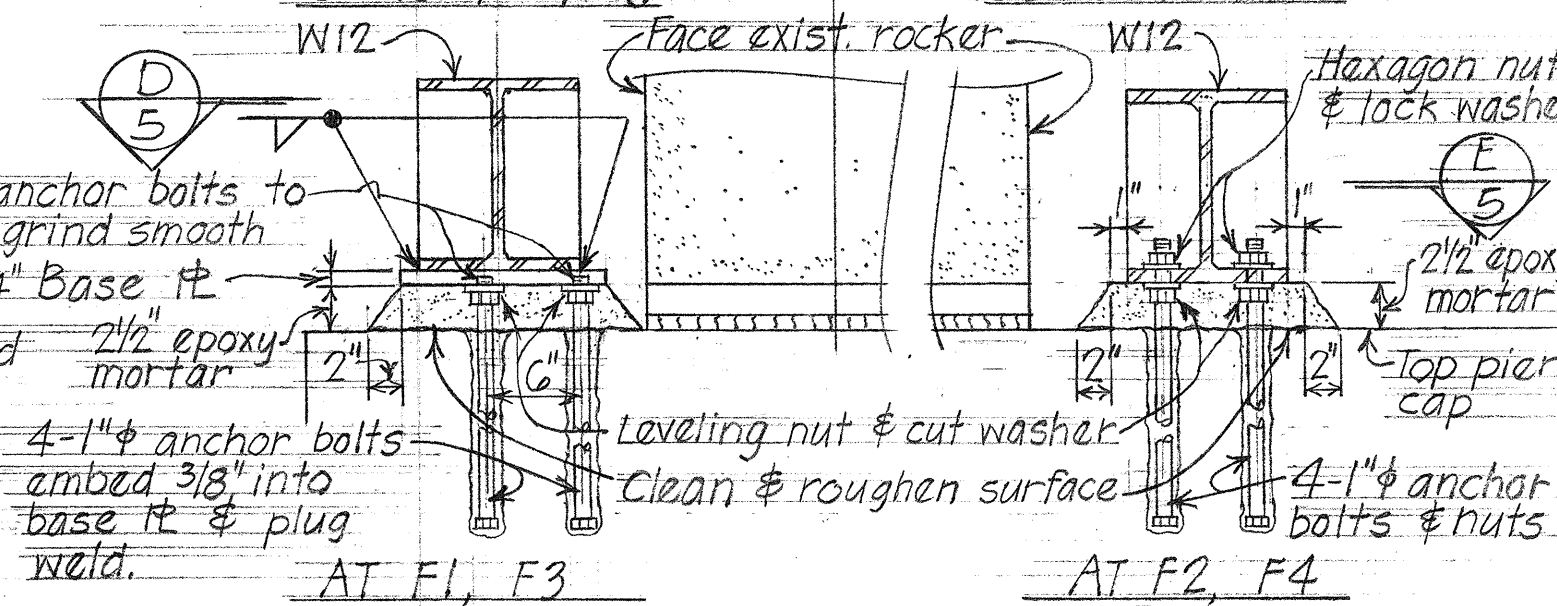

TYPICAL SECTION **C-5** Scale: 1" = 1'-0"

STATE OF HAWAII
DEPARTMENT OF TRANSPORTATION
HIGHWAYS DIVISION

REPAIRS TO WAILUA BRIDGE
SECTIONS & DETAILS
KAUAI BELT RD.

PROJ. No. 56A-01-75 Nov. 1975

SHEET No. 5 OF 5 SHEETS