


# GENERAL NOTES:


- 1- Resurfacing shall be confined to the areas as denoted on the plans by hatched lines. Overlay shall be 1/4" A.C. Pavt. Mix No. V.
- 2- Patching of existing pavement prior to resurfacing will not be required.
- 3- The item "Brooming Off" will not be measured or paid for separately but shall be considered incidental to A.C. Pavt. Mix No. V.
- 4- Rehabilitation of shoulders, pavement striping, pavement markers and removal of pavement markers shall be done by State Forces.
- 5- The edge of pavement area of the existing traveled way shall be graded by State Forces.
- 6- The contractor shall keep at least one lane open to traffic during working hours and both lanes open to traffic during non-working hours. All lanes shall be open to traffic during peak hours from 6:30 A.M. to 8:00 A.M. and from 4:00 P.M. to 5:30 P.M.
- 7- Smooth riding transition shall be provided at the beginning and end of each section as directed by the Engineer.
- 8- Provide one foot feather edge from new edge of pavement to existing adjacent pavement. See sketch below.

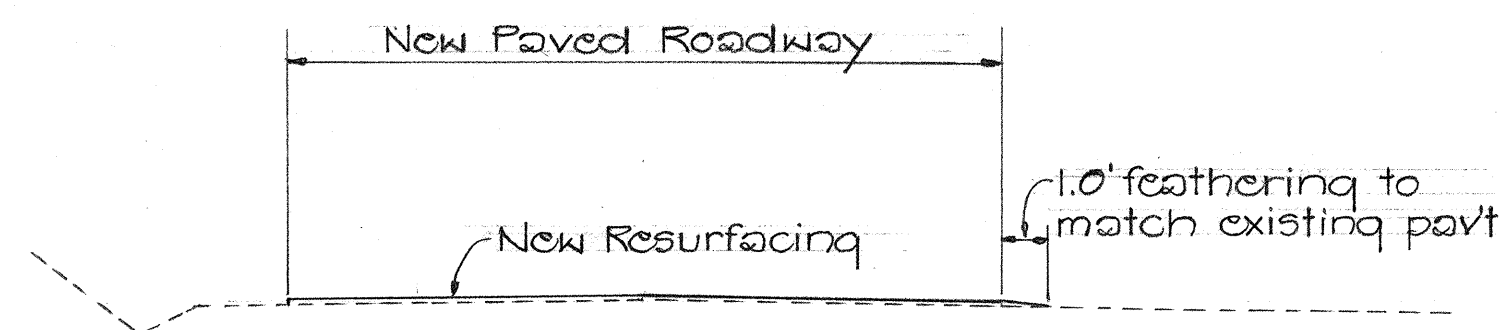

TYPICAL SECTION  
Not to Scale

## 2- Estimated Quantities for resurfacing

Location	A.C. Pavt Mix V	Tack Coat
Lihue Town	174.20 49+ Ton	422 394 Gal.
Wailua Golf Course	439.80 419 Ton	784 866 Gal.
Haleiwa Rd. Wailua Bridge to Lanika St.	915.80 93+ Ton	1636 1925 Gal.

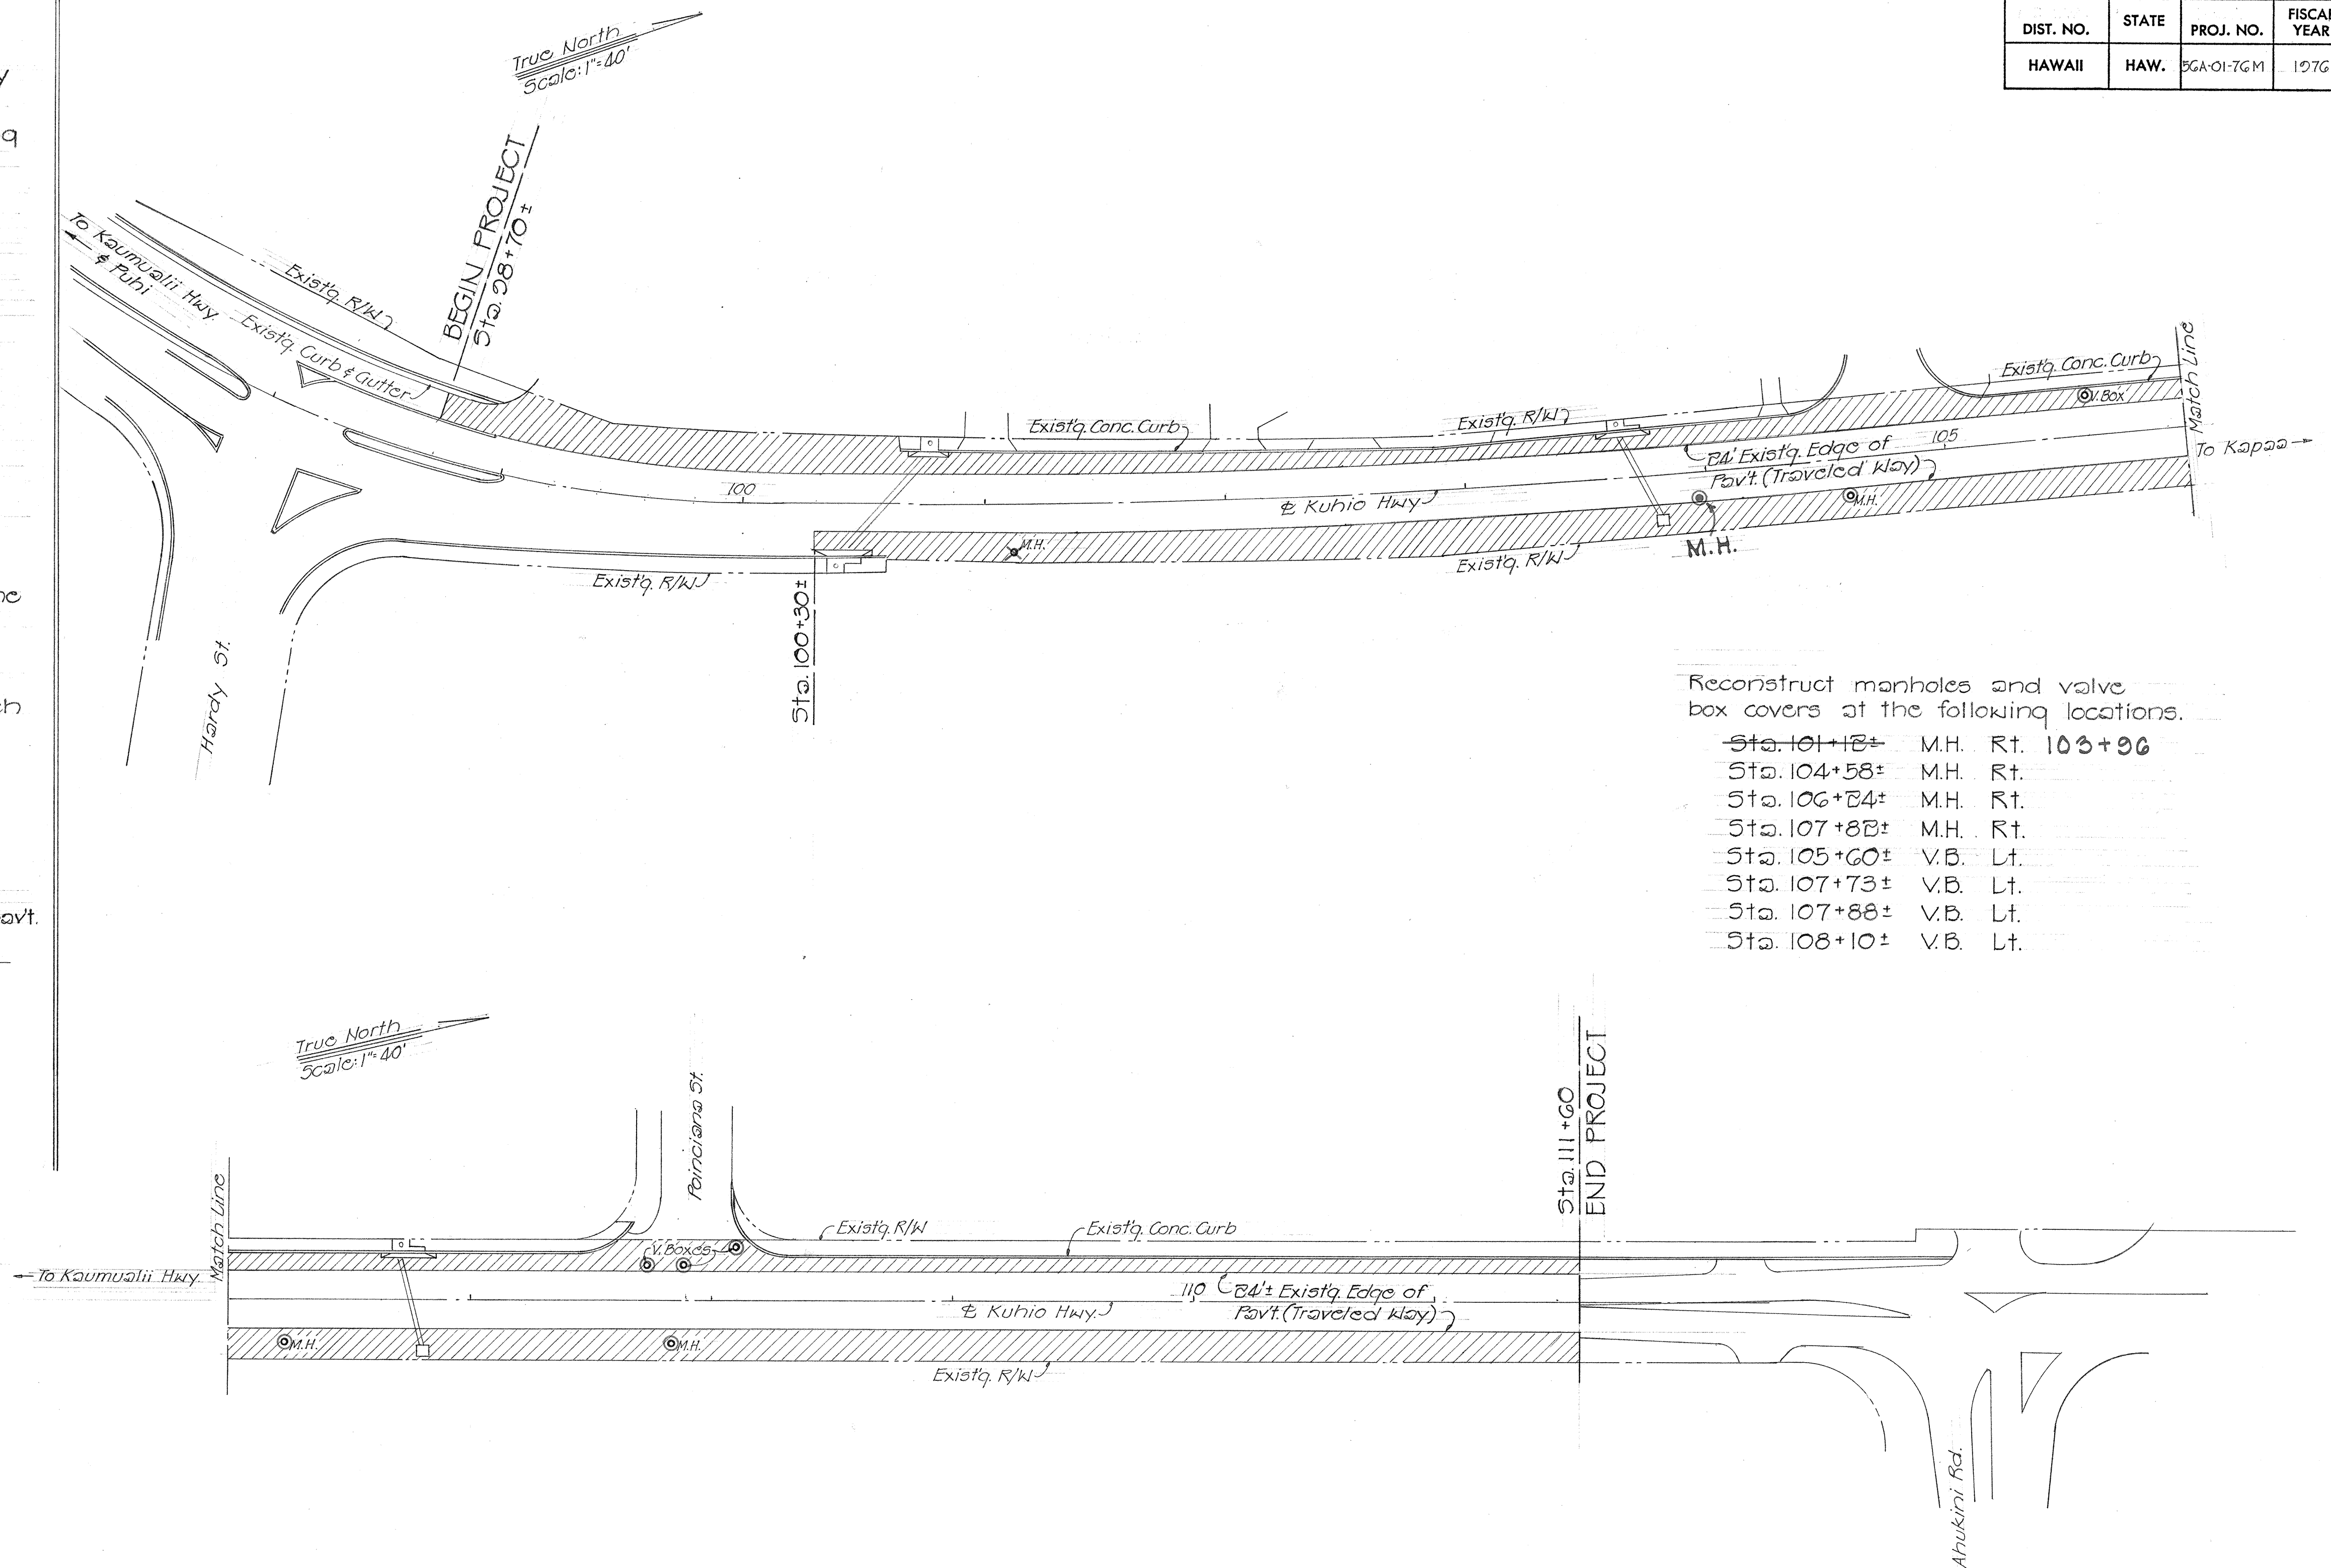

## PLAN ~ LIHUE

Scale: 1"=40'

DIST. NO.	STATE	PROJ. NO.	FISCAL YEAR	SHEET NO.	TOTAL SHEETS
HAWAII	HAW.	56A-01-76M	1976	2	3

Reconstruct manholes and valve box covers at the following locations.

Sta. 101+12±	M.H. Rt.	103+96
Sta. 104+58±	M.H. Rt.	
Sta. 106+84±	M.H. Rt.	
Sta. 107+88±	M.H. Rt.	
Sta. 105+60±	V.B. Lt.	
Sta. 107+73±	V.B. Lt.	
Sta. 107+88±	V.B. Lt.	
Sta. 108+10±	V.B. Lt.	

SURVEY PLOTTED BY	DATE
DESIGNED BY	
NOTED BY	
CHECKED BY	
ORIGINAL PLAN	
NOTE BOOK	
QUANTITIES BY	
CHECKED BY	
No.	

STATE OF HAWAII DEPARTMENT OF TRANSPORTATION HIGHWAYS DIVISION
KUHIO HIGHWAY RESURFACING VARIOUS LOCATIONS
PROJ. No. 56A-01-76M
PLAN~LIHUE & GENERAL NOTES
Scale: As Shown
Mar. 1976
SHEET No. 1 OF 1 SHEETS