


DIST. NO.	STATE	PROJ. NO.	FISCAL YEAR	SHEET NO.	TOTAL SHEETS
HAWAII	HAW.	5GA-01-76M	1976	3	3

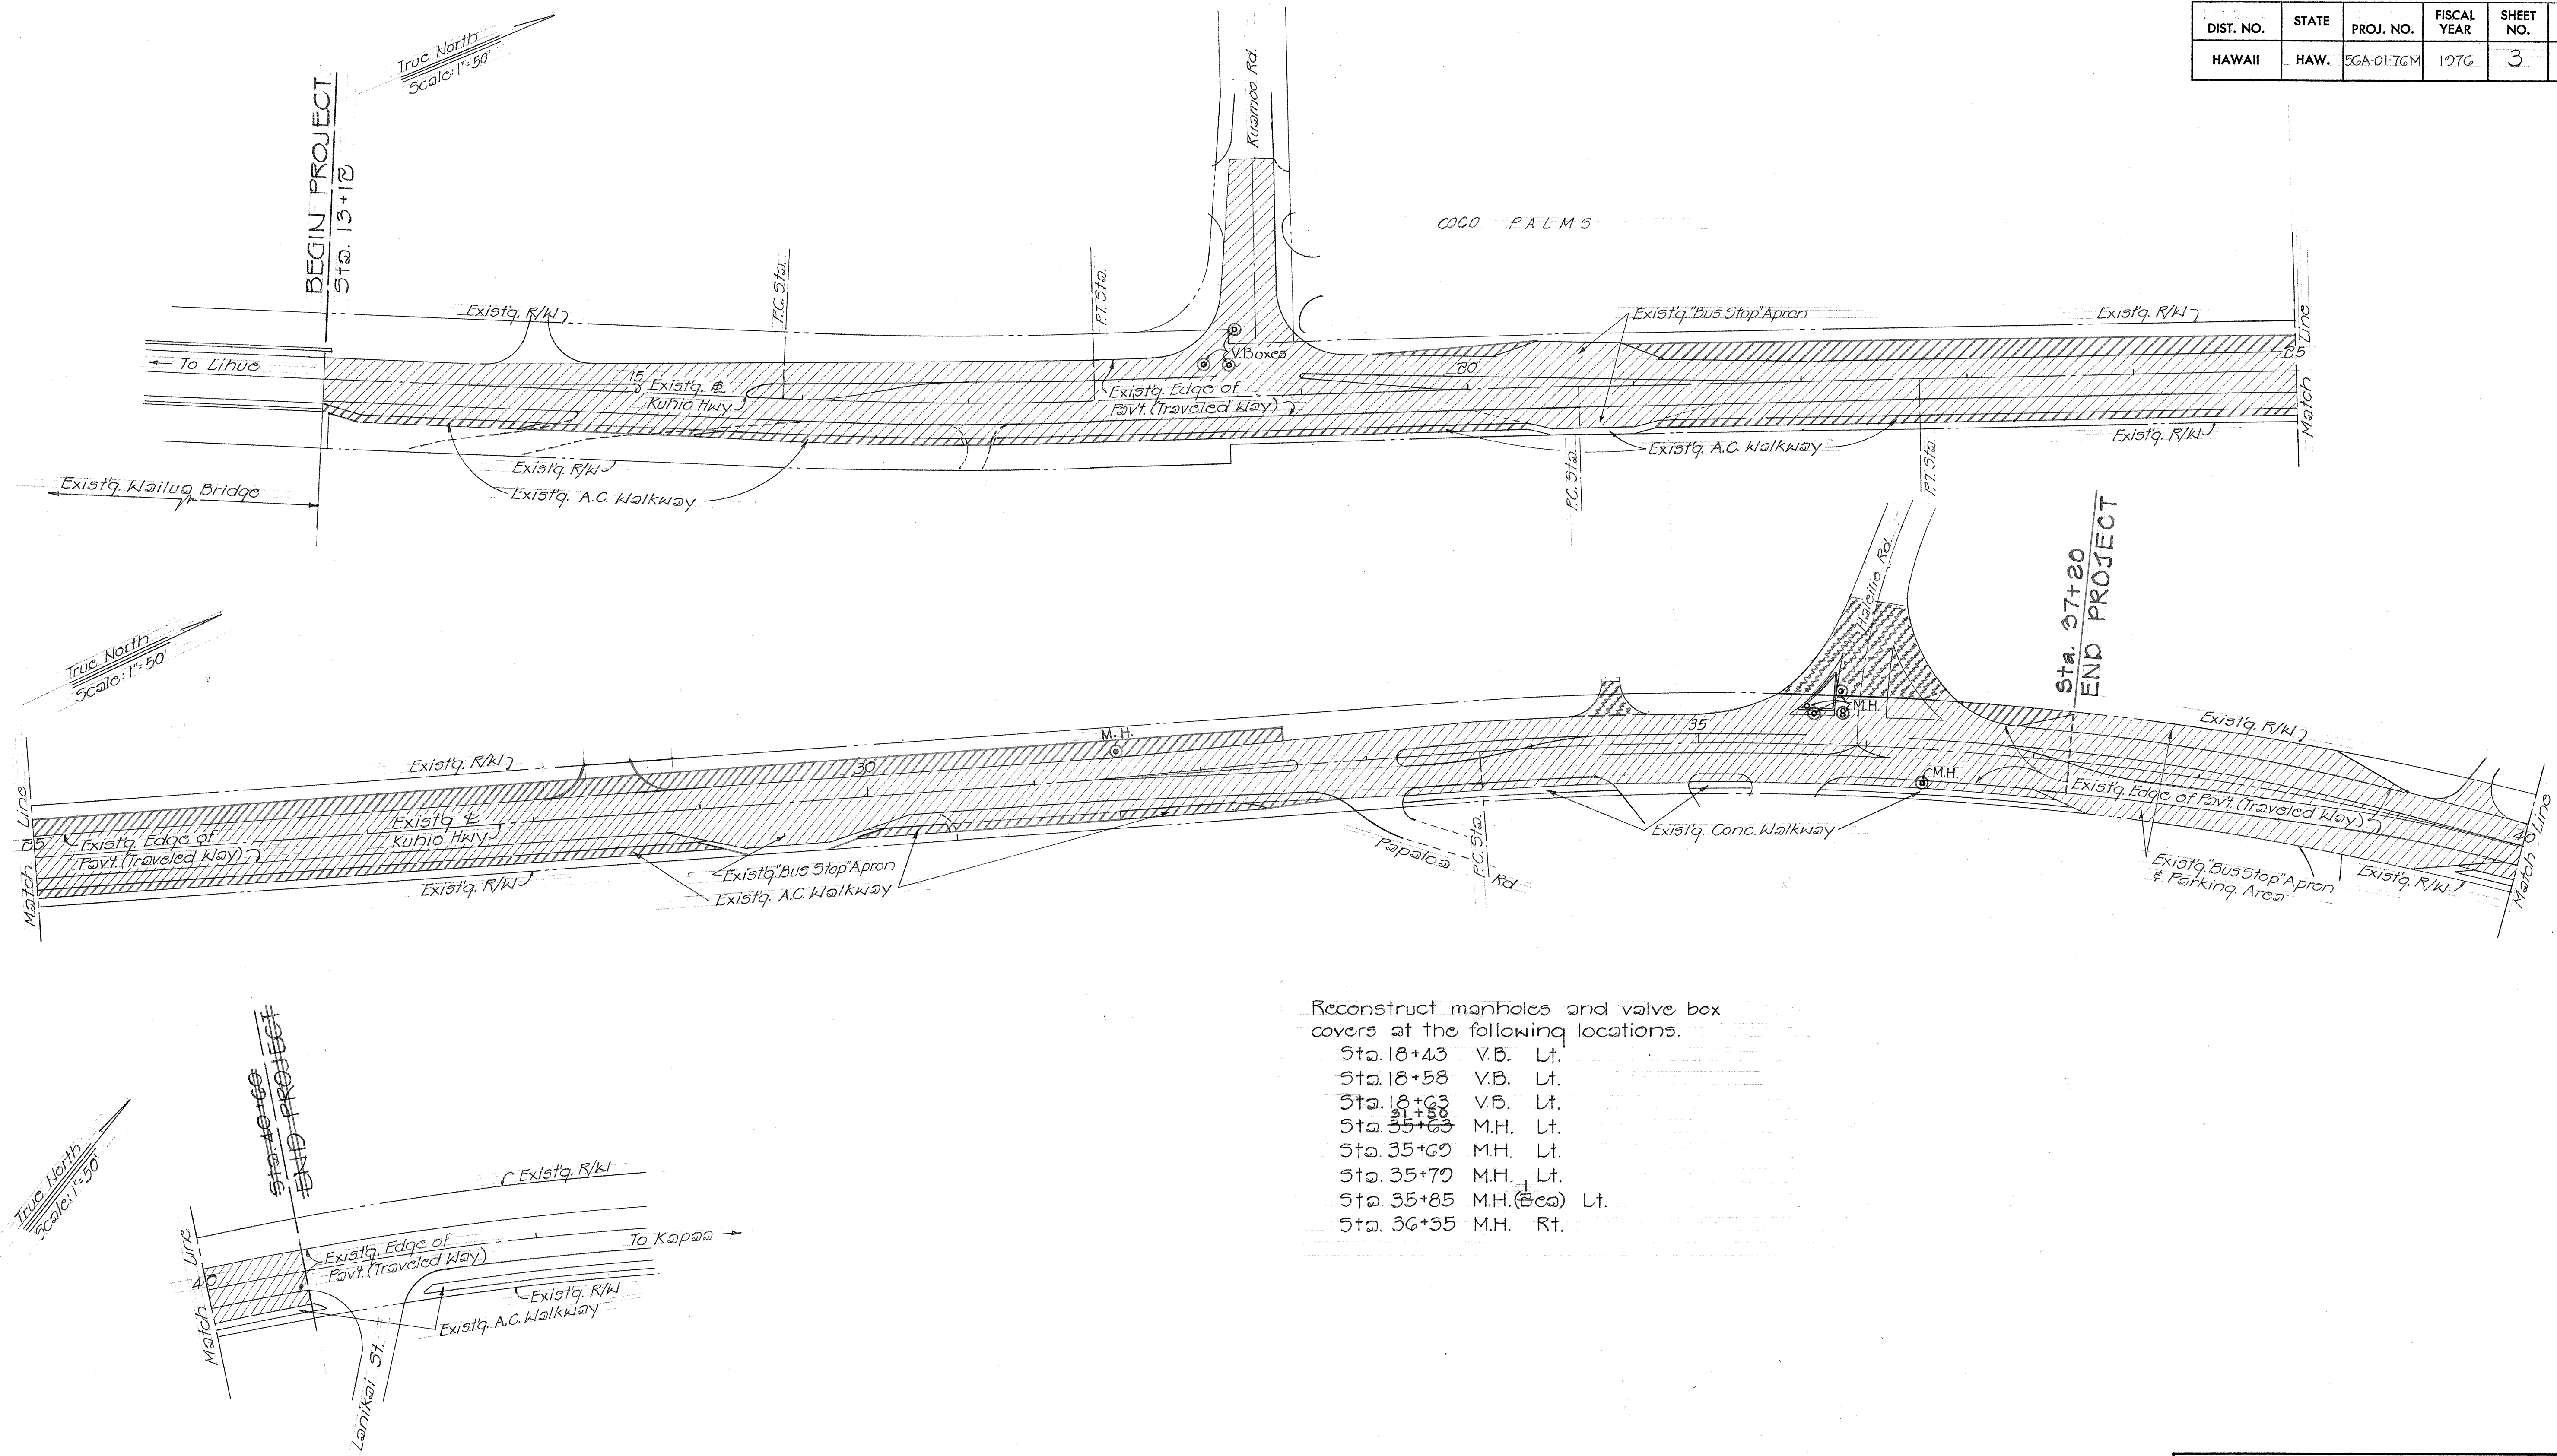

- Reconstruct manholes and valve box covers at the following locations.
- Sta. 18+43 V.B. Lt.
 - Sta. 18+58 V.B. Lt.
 - Sta. 18+63 V.B. Lt.
 - Sta. 35+63 M.H. Lt.
 - Sta. 35+69 M.H. Lt.
 - Sta. 35+79 M.H. Lt.
 - Sta. 35+85 M.H. (Sec) Lt.
 - Sta. 36+35 M.H. Rt.

PLAN ~ WAILUA BRIDGE TO LANIKAI STREET
Scale: 1"=50'

ORIGINAL PLAN	DATE
DESIGNED BY	
TRACED BY	
NOTE BOOK	
QUANTITIES BY	
CHECKED BY	

STATE OF HAWAII
DEPARTMENT OF TRANSPORTATION
HIGHWAYS DIVISION
KUHIO HIGHWAY RESURFACING
VARIOUS LOCATIONS
PROJ. No. 5GA-01-76M
PLAN ~ WAILUA BRIDGE TO LANIKAI STREET
Scale: As Shown Mar. 1976
SHEET No. 1 OF 1 SHEETS