
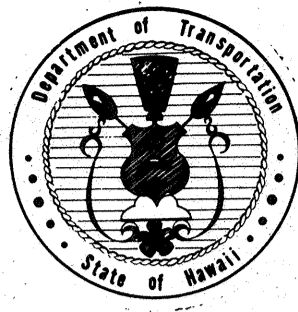



INDEX TO DRAWINGS	
SHEET NO.	DESCRIPTION
1	TITLE SHEET
2	PLAN-LIHUE & GENERAL NOTES
3	PLAN-WAILUA BRIDGE TO LANIKAI ST.

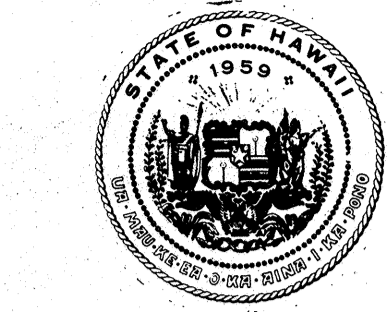

STATE OF HAWAII  
DEPARTMENT OF TRANSPORTATION  
HIGHWAYS DIVISION



"AS BUILT"  
PLANS FOR  
KUHIO HIGHWAY RESURFACING,  
VARIOUS LOCATIONS  
PROJECT NO. 56A-01-76M  
DISTRICTS OF LIHUE & KAWAIHAU  
ISLAND OF KAUAI

DIST. NO.	STATE	PROJ. NO.	FISCAL YEAR	SHEET NO.	TOTAL SHEETS
HAWAII	HAW.	56A-01-76M	1976	1	3

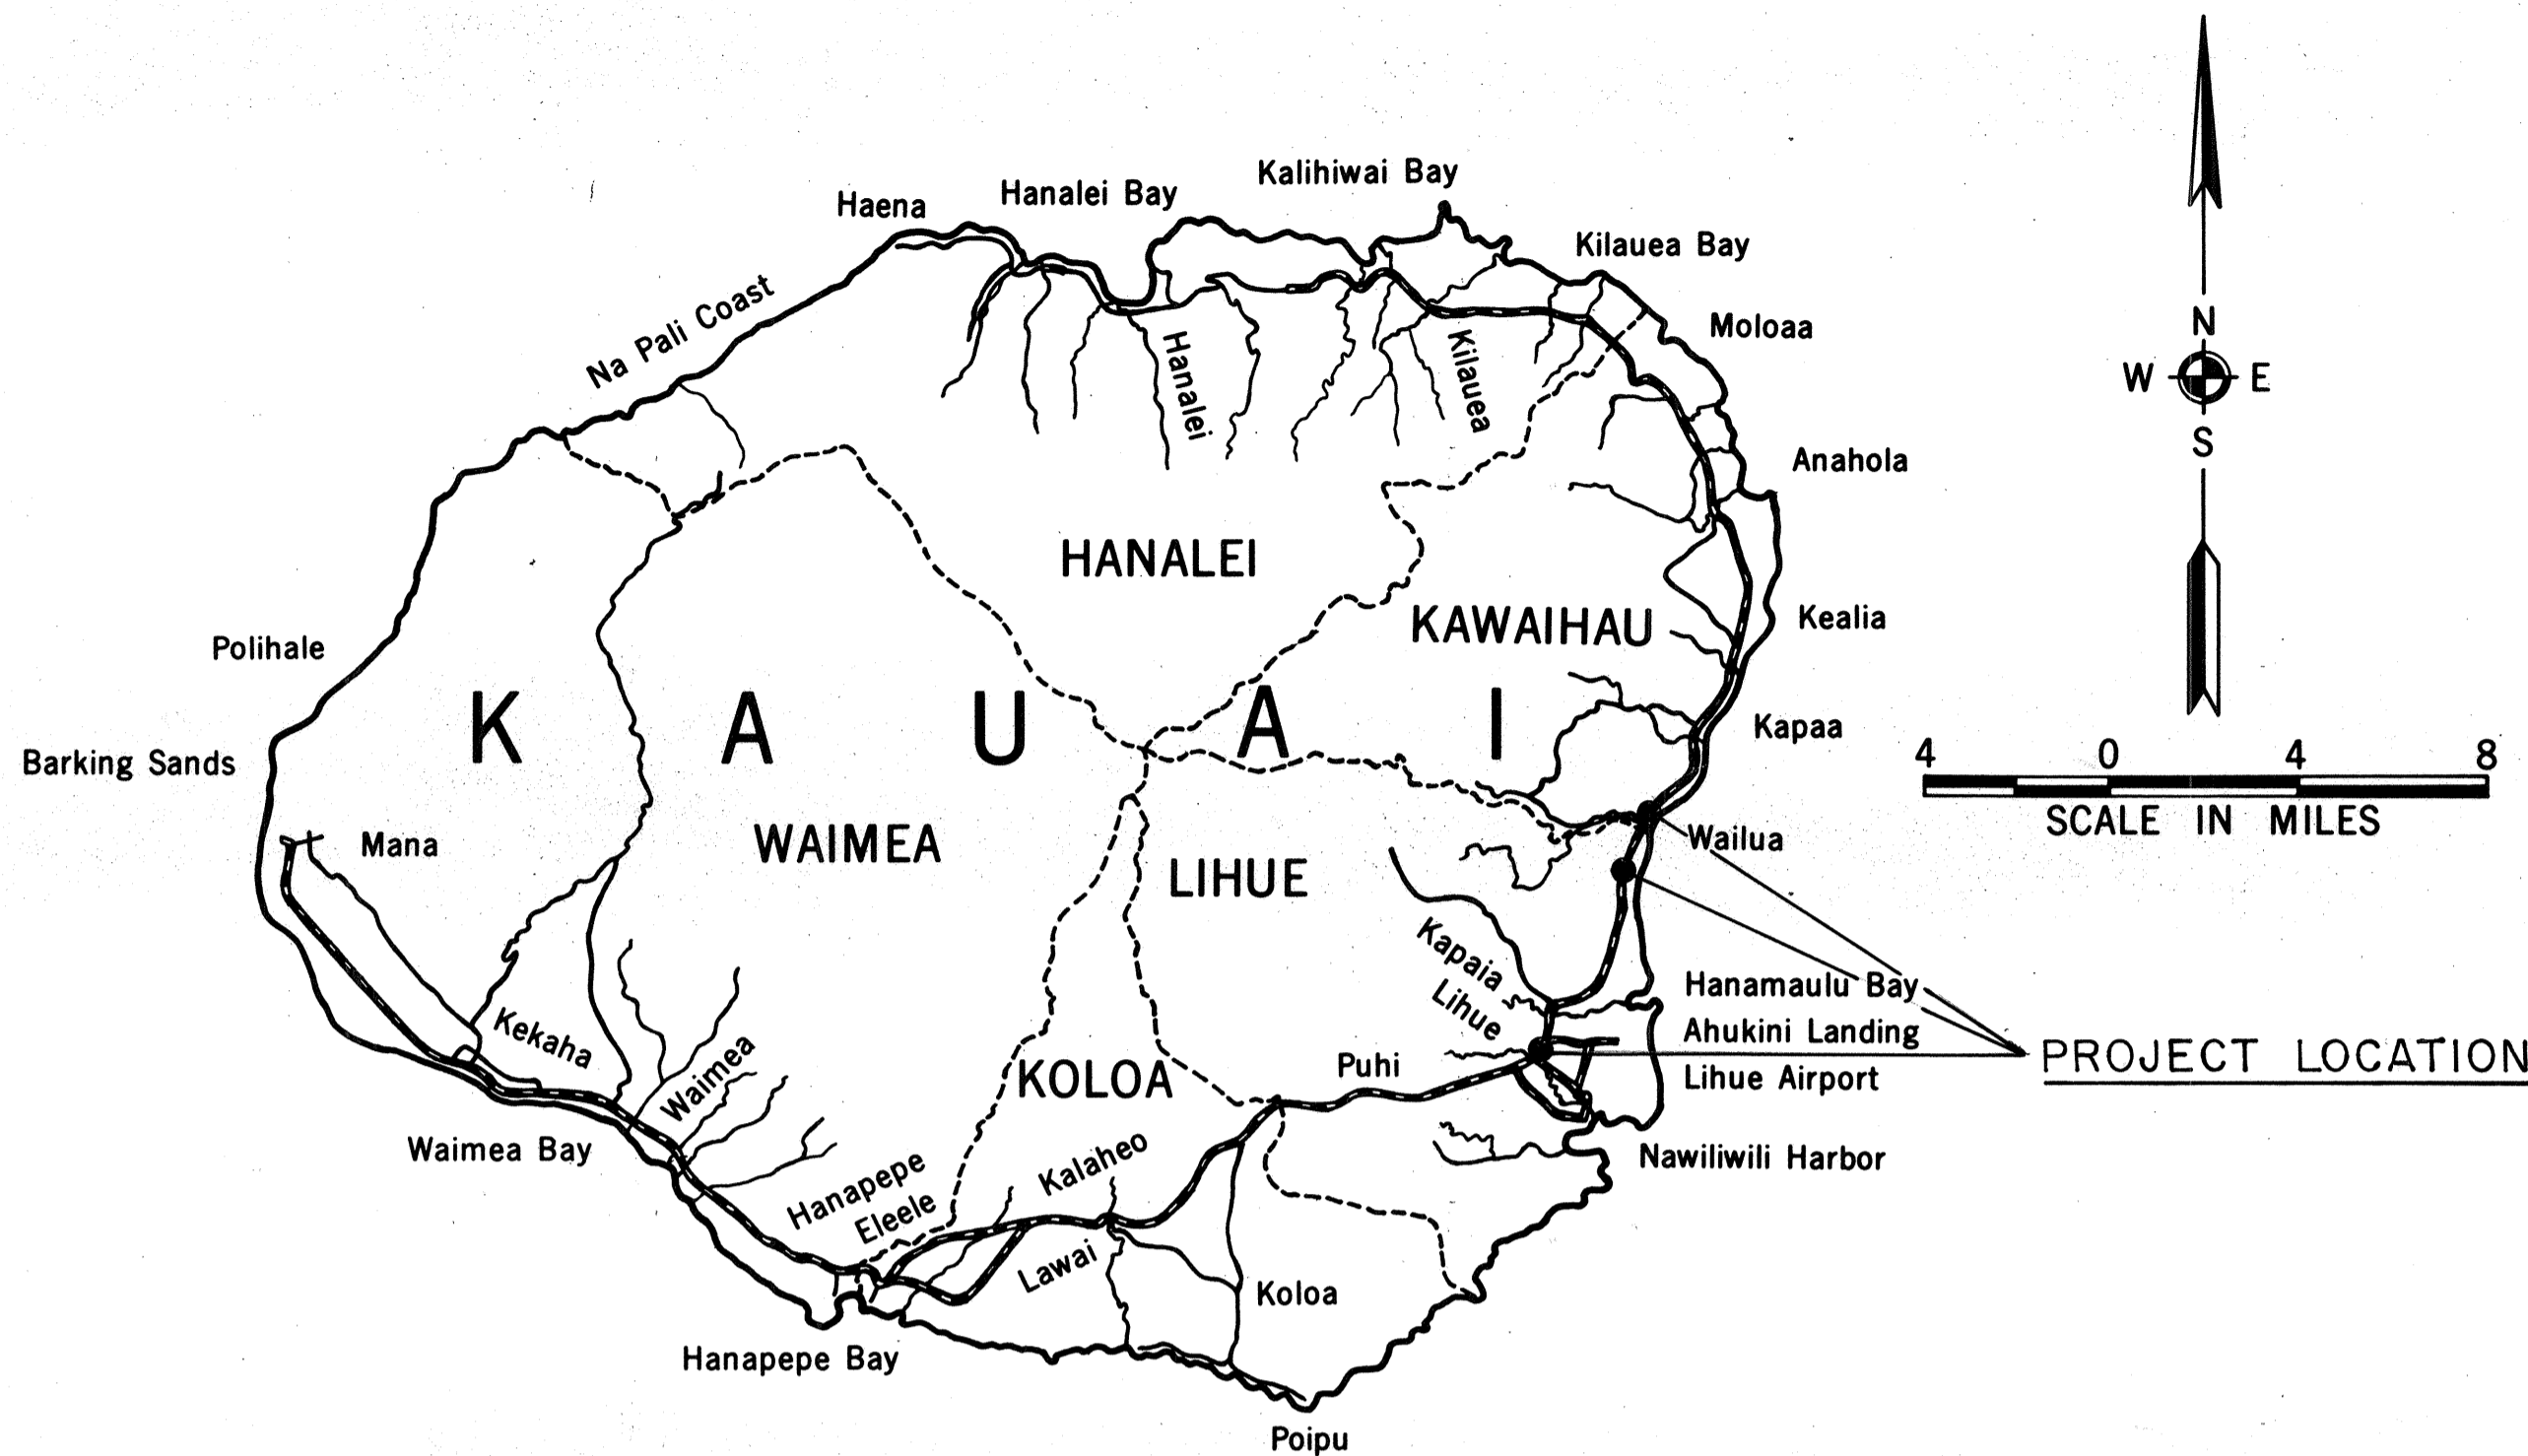

FEDERAL AID PROJECTS PREVIOUSLY CONSTRUCTED  
OR UNDER CONSTRUCTION

KAUAI DISTRICT DESIGNED BY D. BEVIER 548-7537 MAR 16, 1976 P. S. & E. BY PHONE DATE

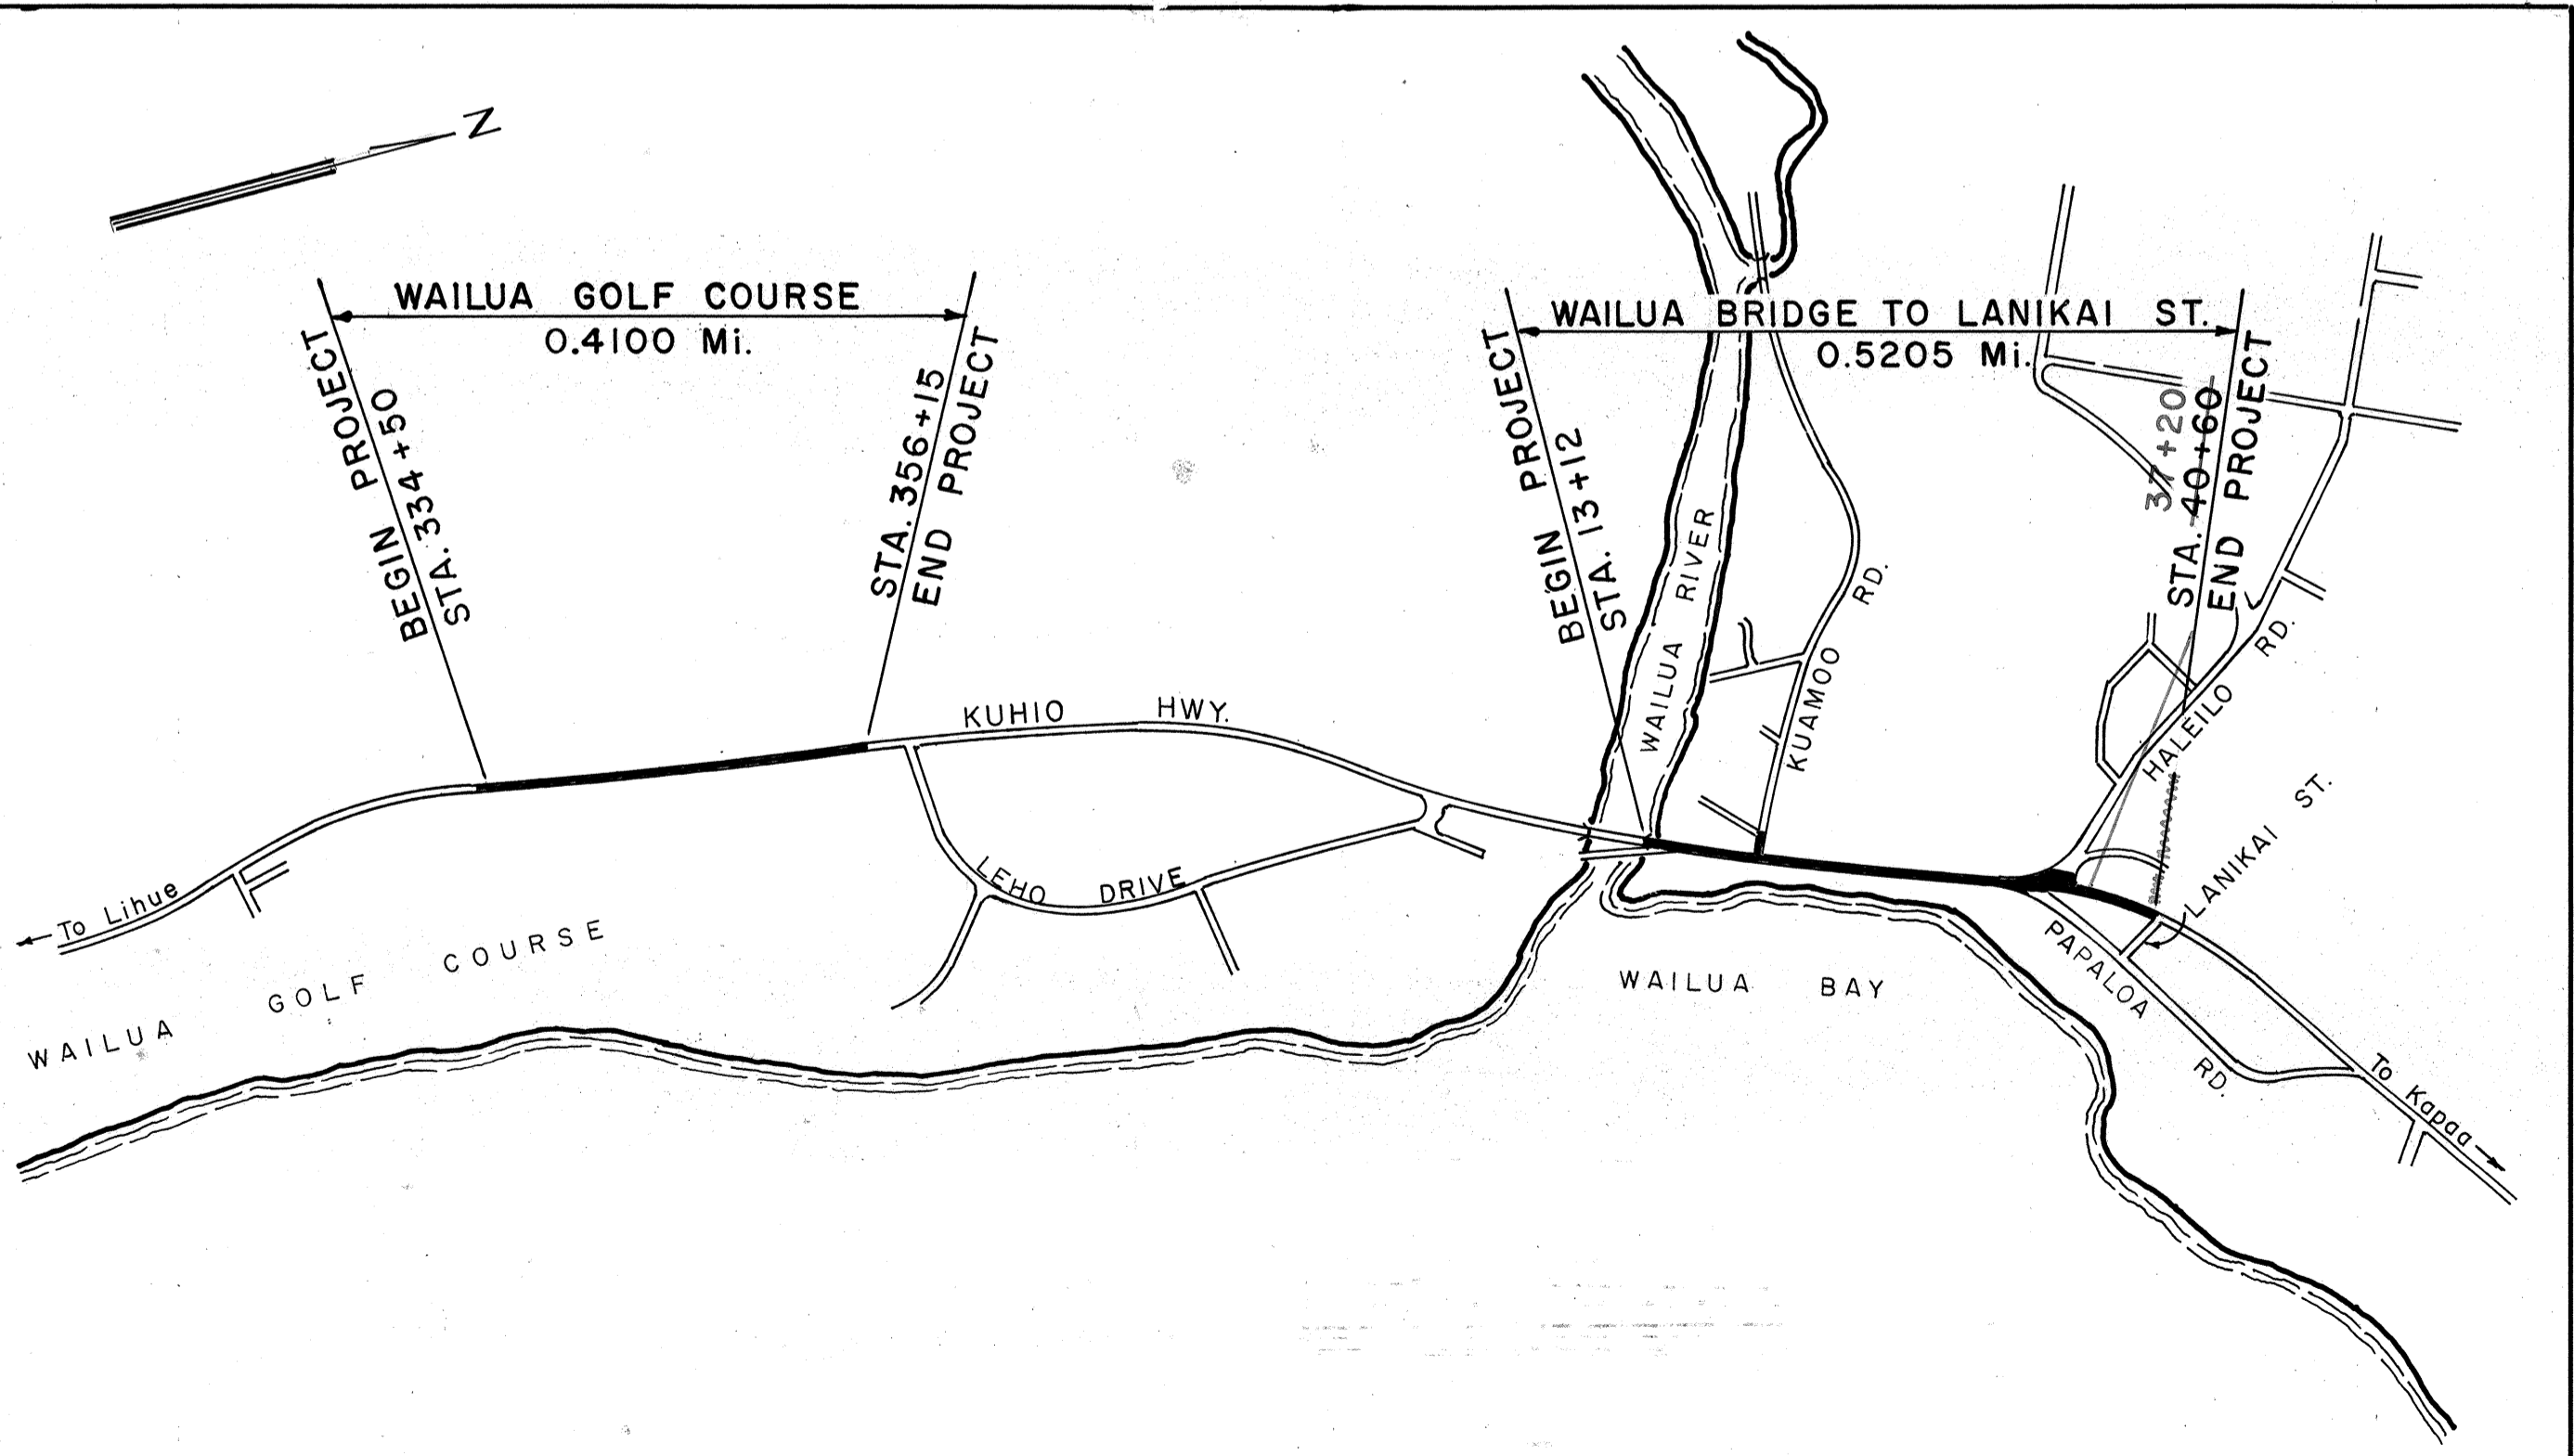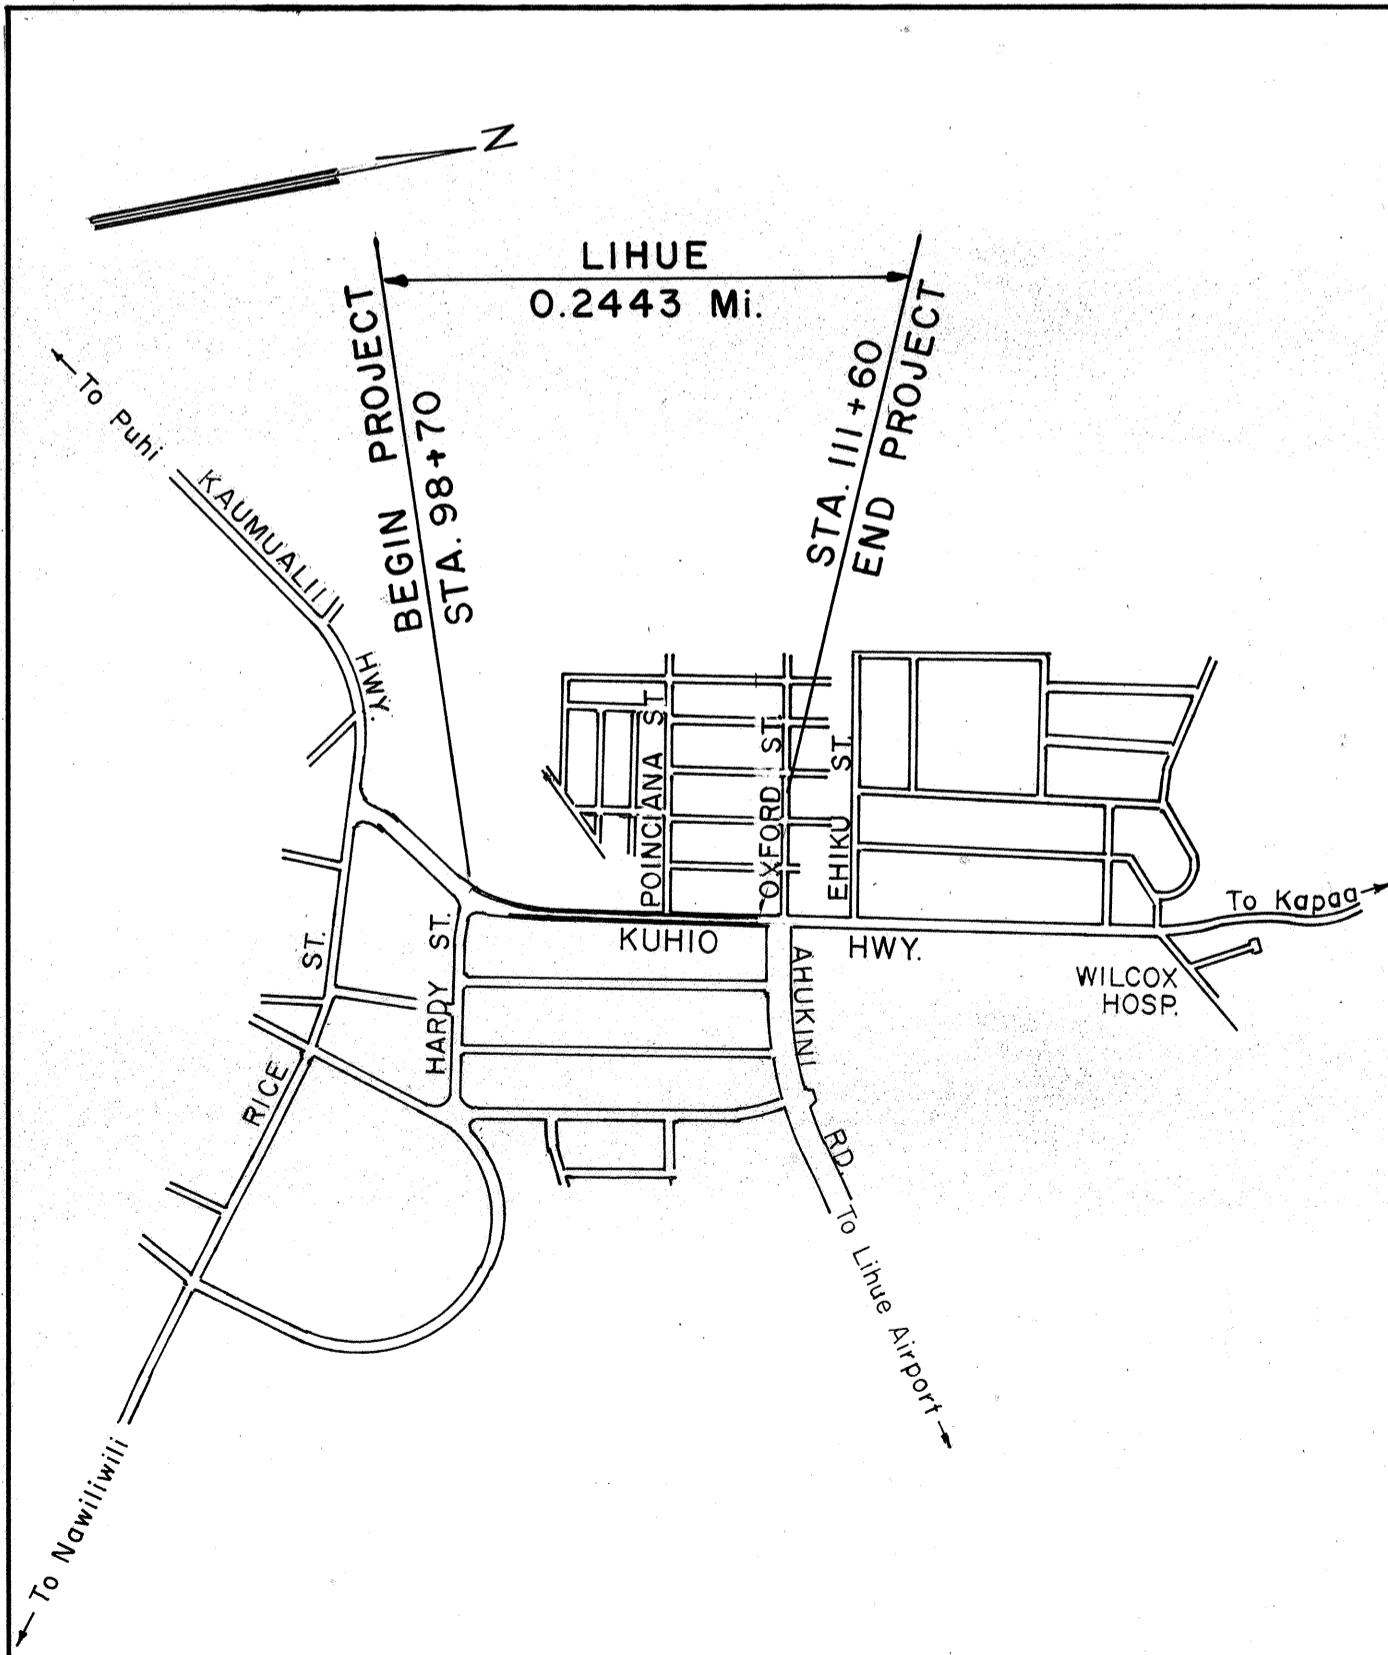

LOCATION OF PROJECTS  
Scale: 1" = 1000'

NOTE:  
ALL CHANGES MADE DURING CONSTRUCTION  
HAVE BEEN NOTED IN RED ON THESE  
TRACINGS AND CHECKED BY:

*[Signature]*  
PROJECT ENGINEER

2-23-77  
DATE

DEPARTMENT OF TRANSPORTATION STATE OF HAWAII	
APPROVED: <i>R. Higashionna</i>	3-19-76
for DIR. OF TRANSPORTATION	DATE