
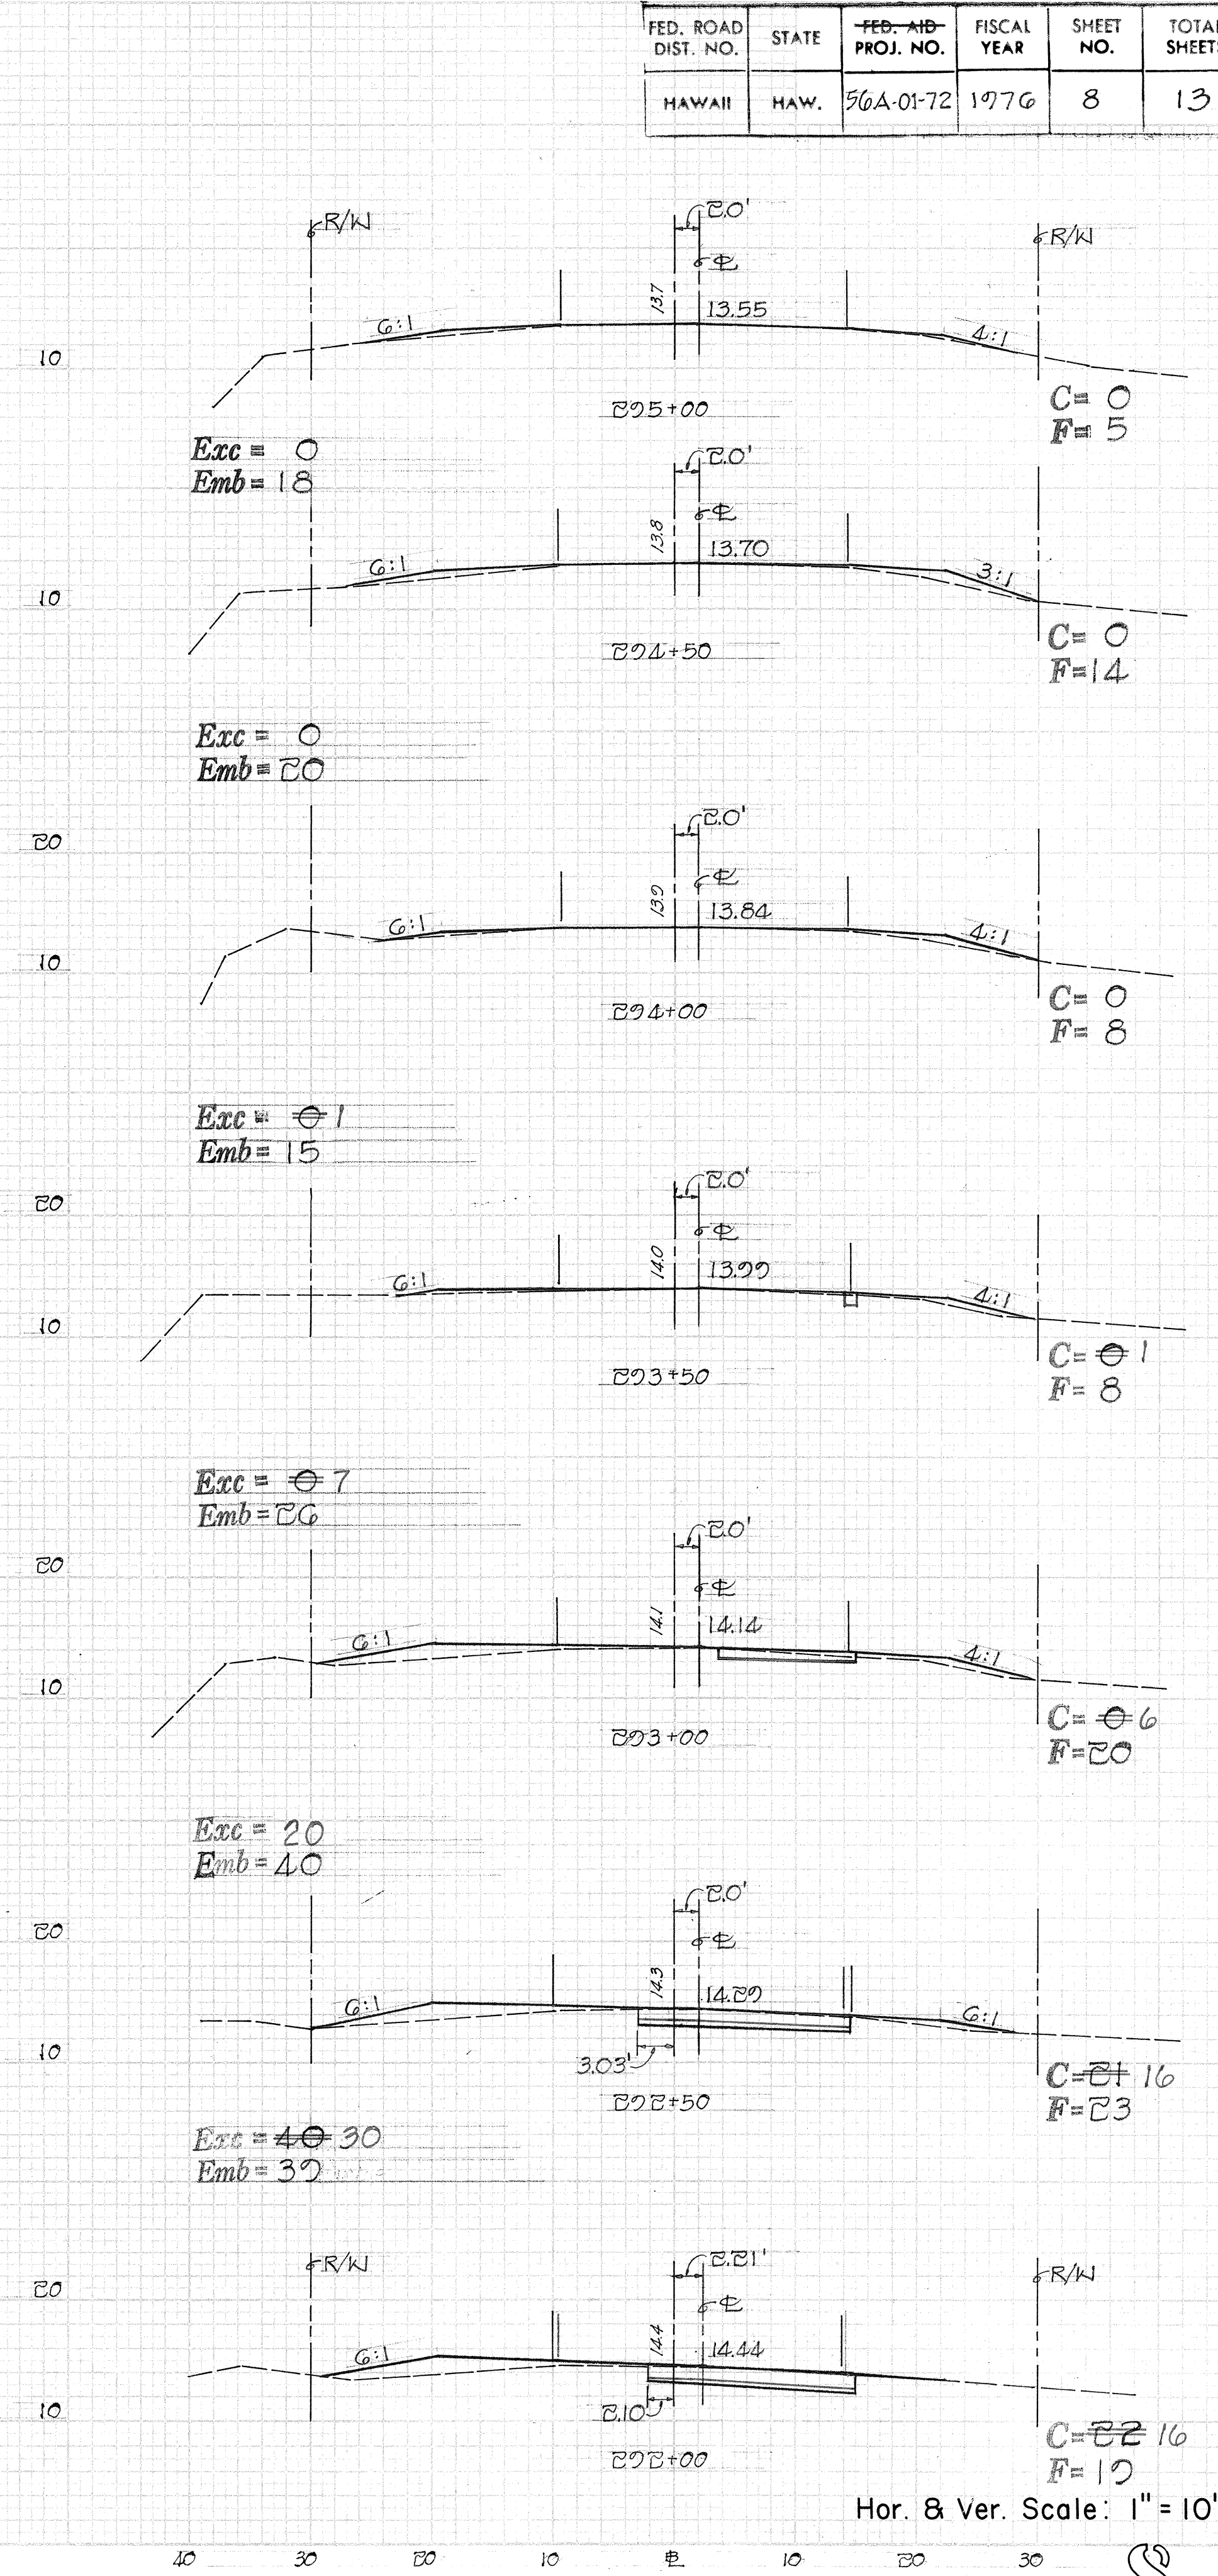
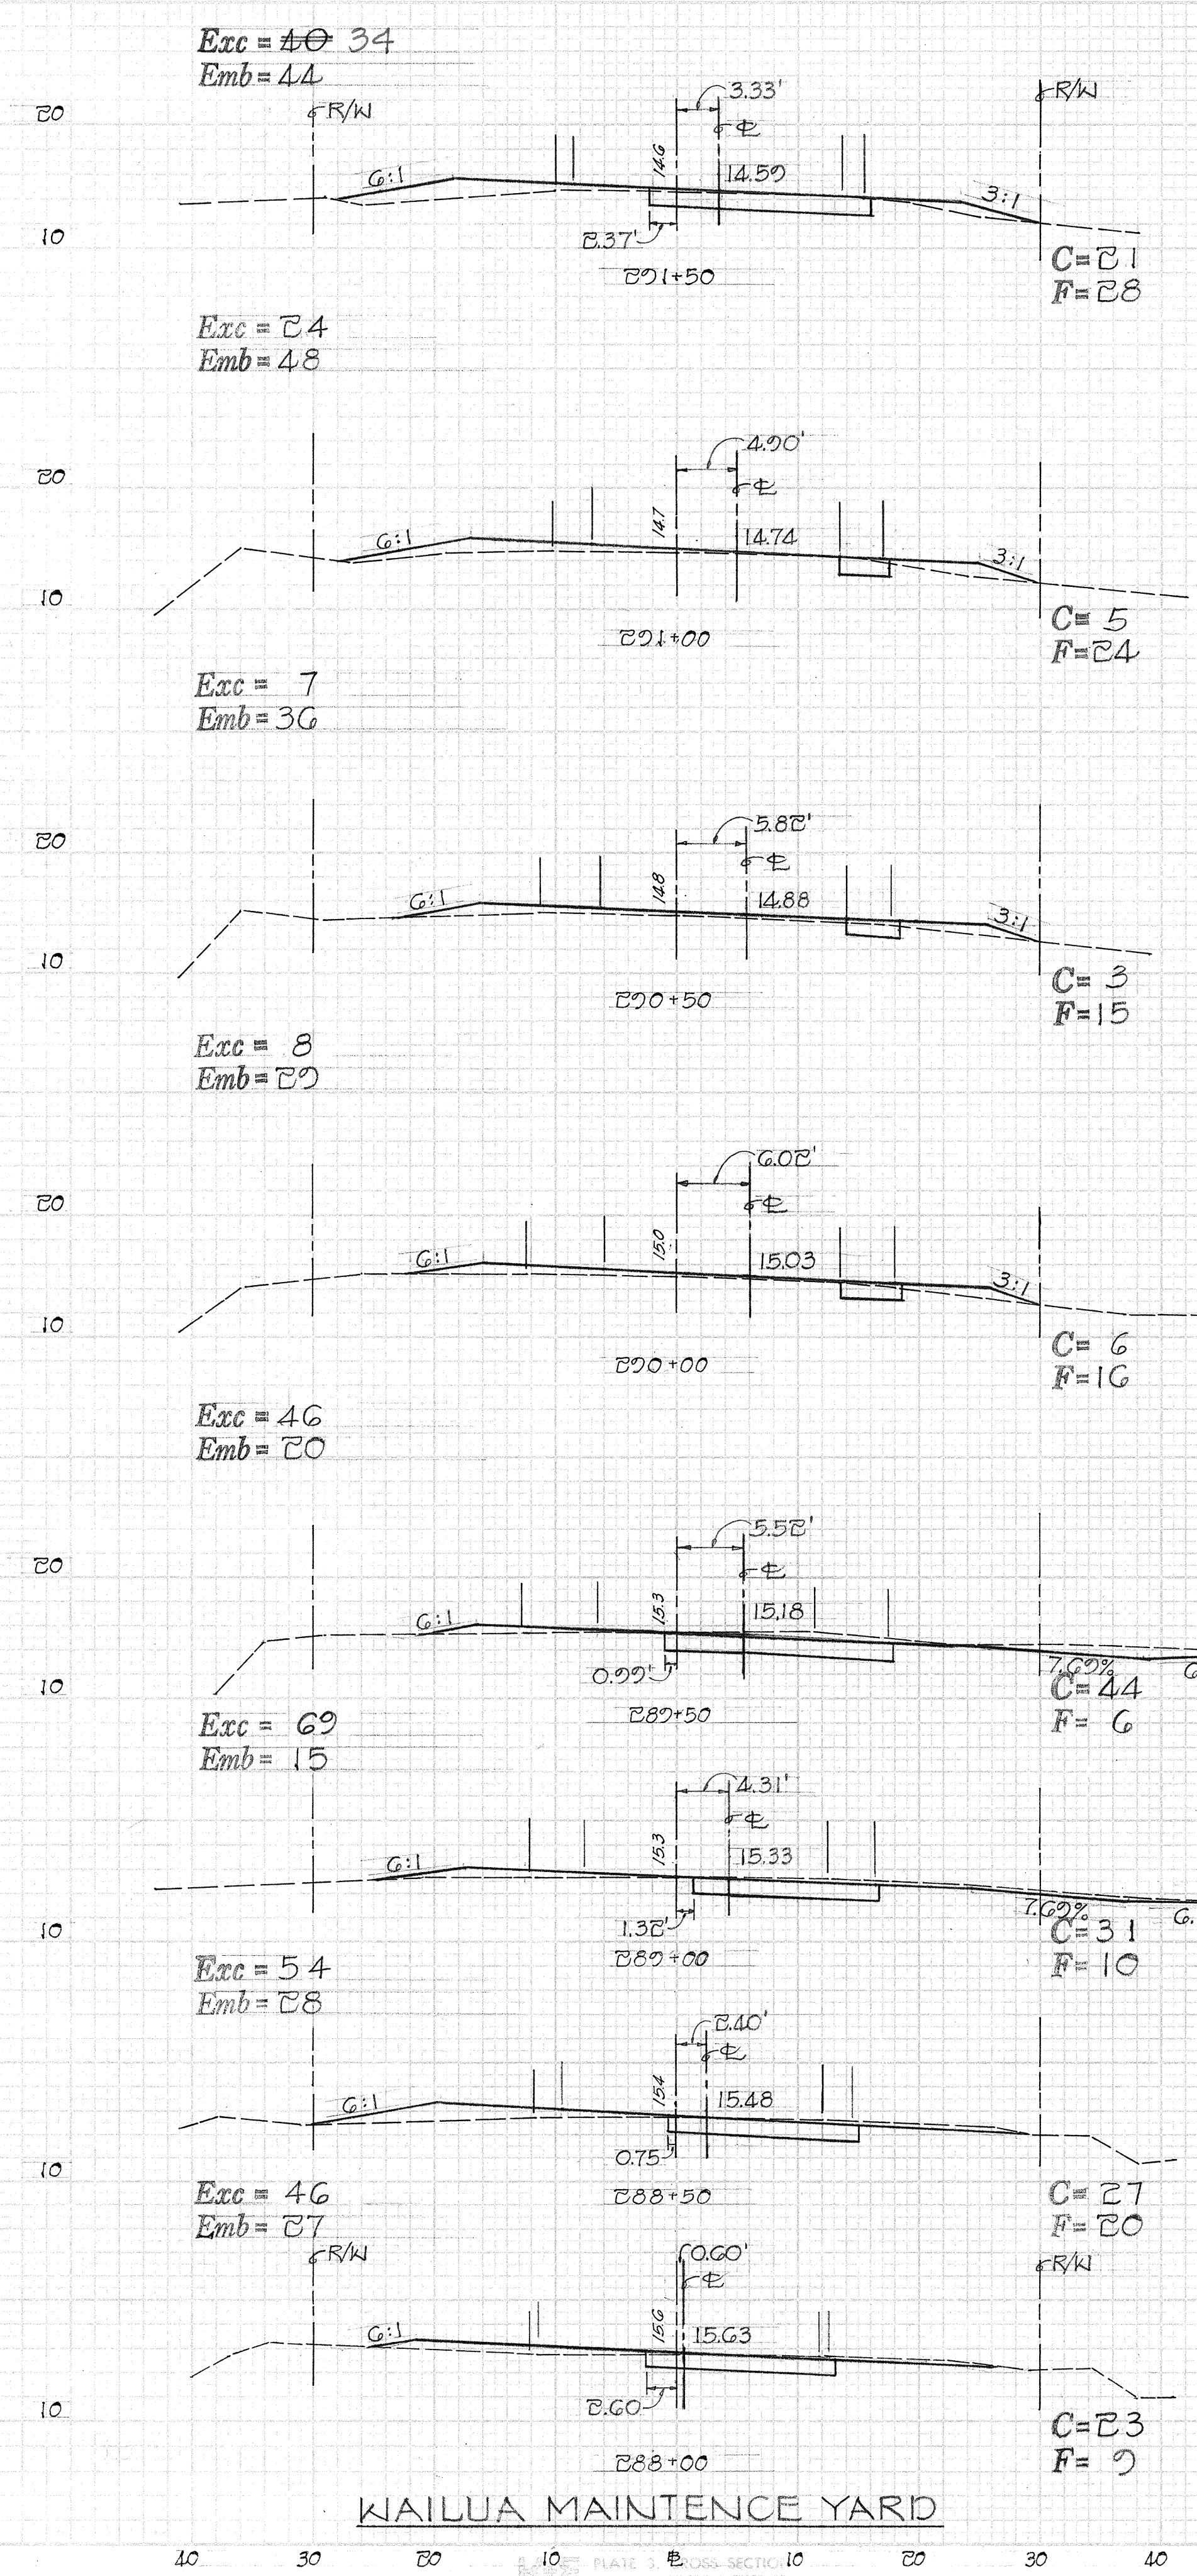


FED. ROAD DIST. NO.	STATE	FED. AID PROJ. NO.	FISCAL YEAR	SHEET NO.	TOTAL SHEETS
HAWAII	HAW.	56A-01-72	1976	8	13


FINAL SURVEY
DATE
BY
NO. 1
NO. 2
NO. 3
NO. 100

ORIGINAL SURVEY
DATE
BY
NO. 1
NO. 2
NO. 3
NO. 100

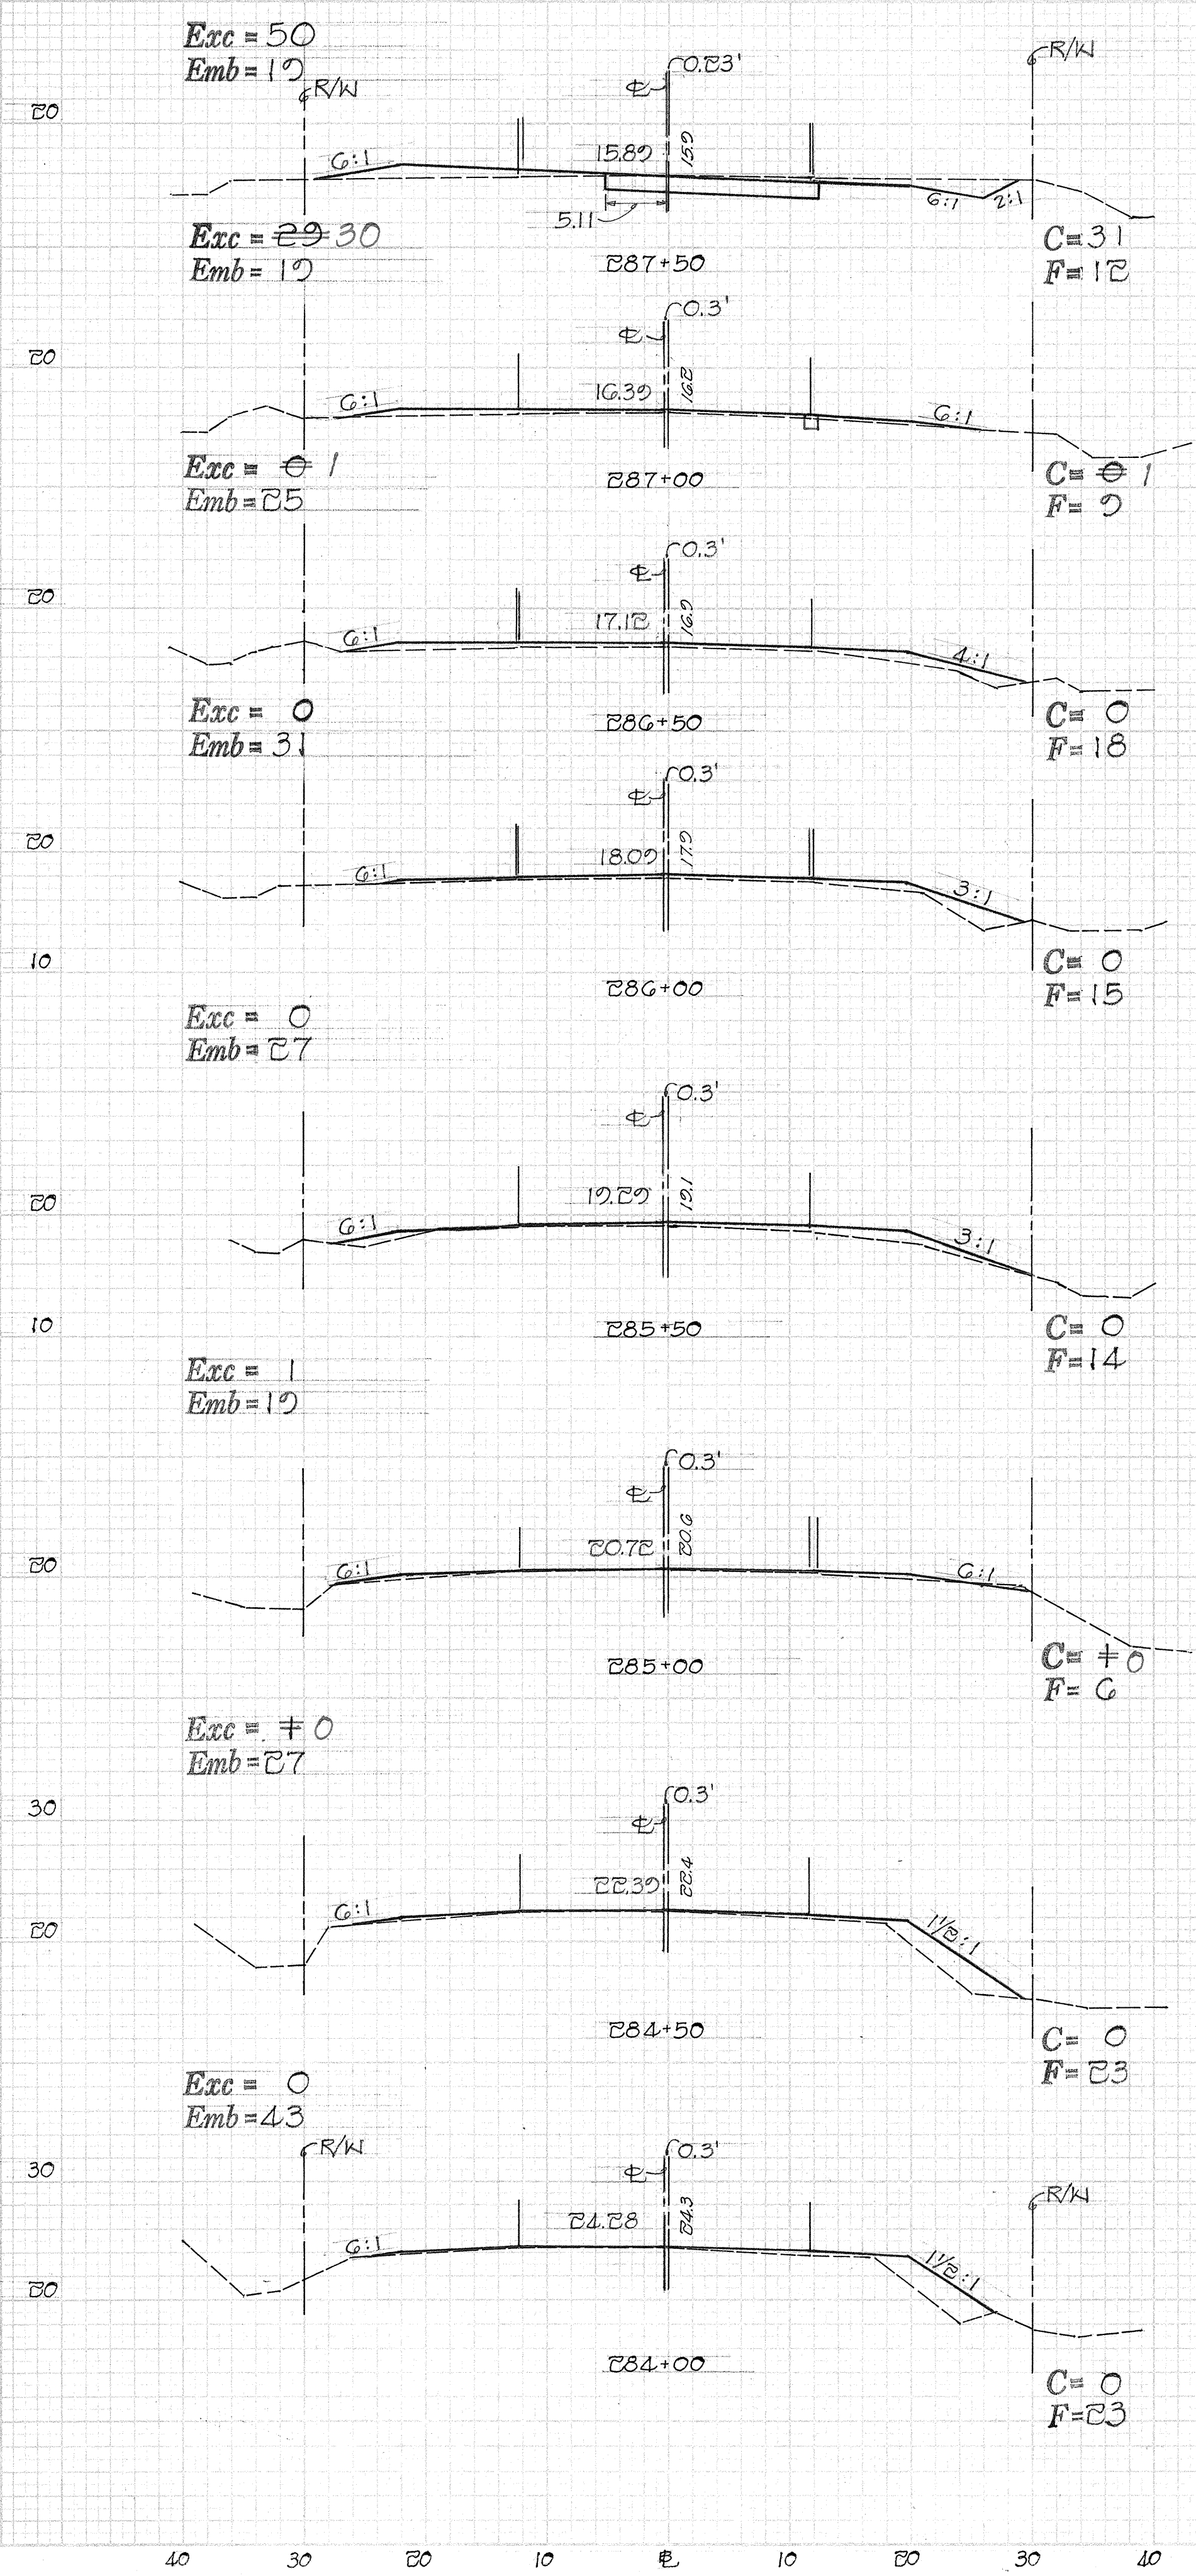

WAILUA MAINTENANCE YARD

Hor. & Ver. Scale: 1" = 10'

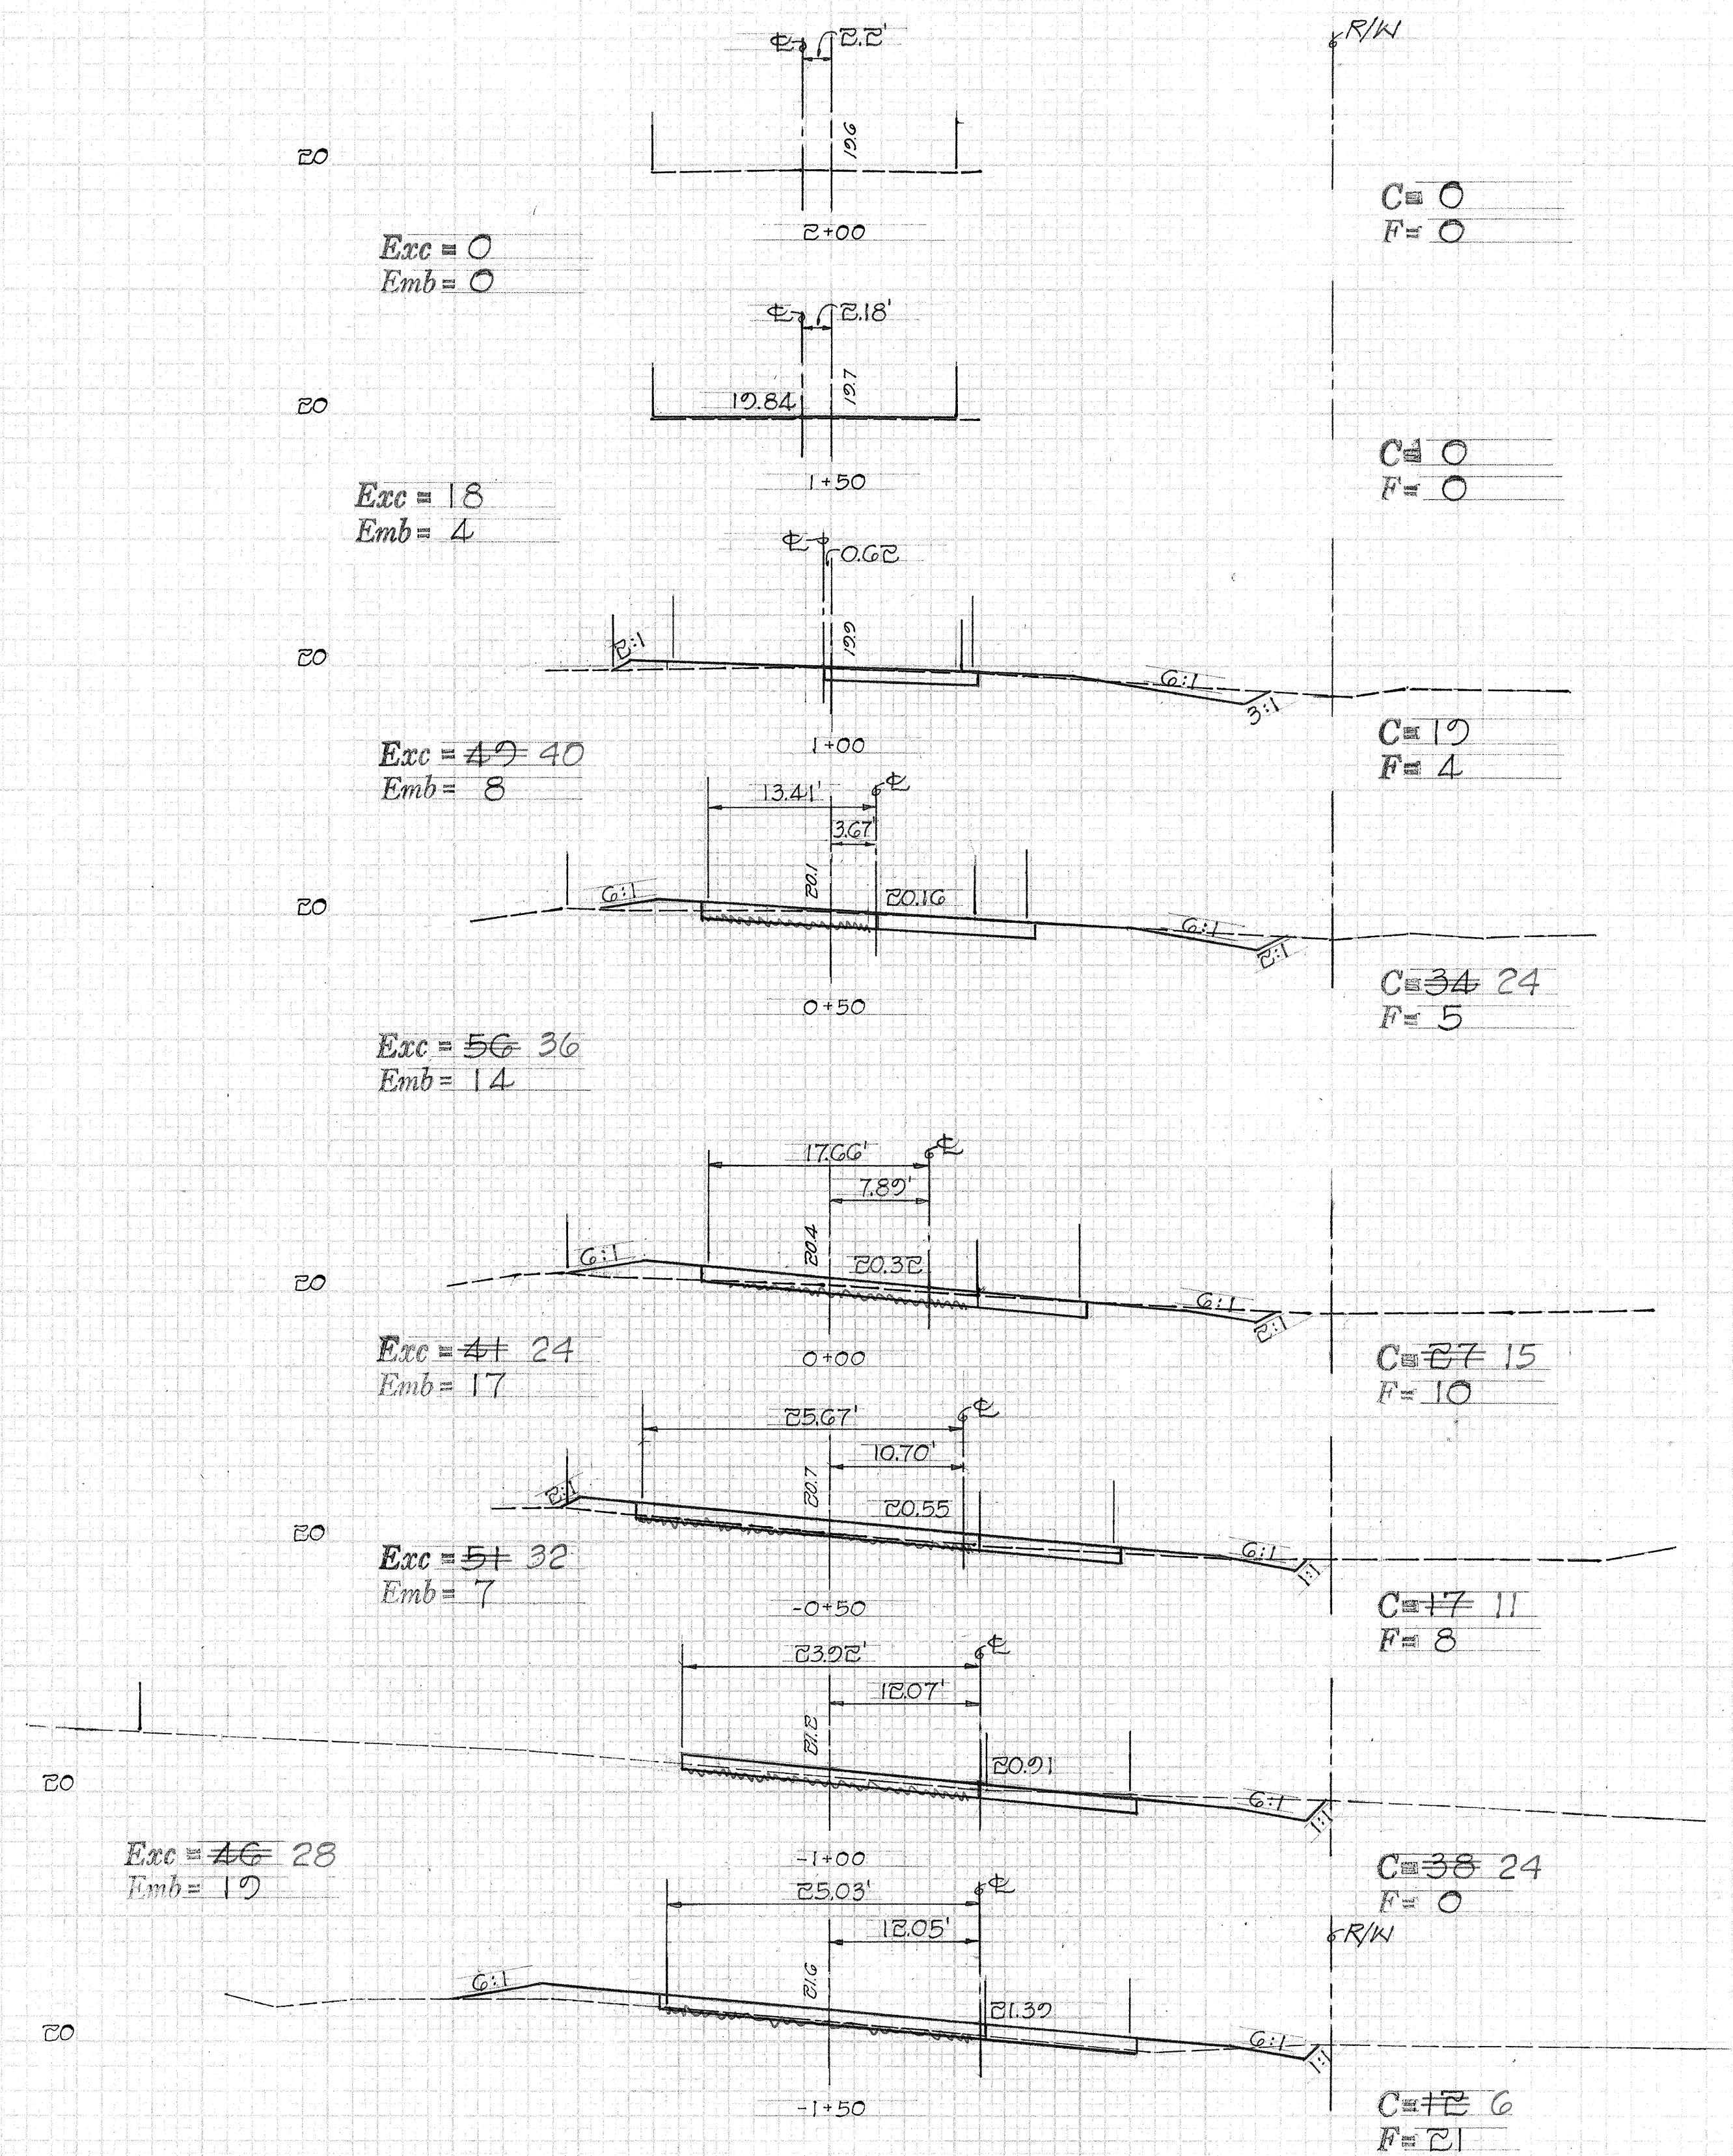

Hor. & Ver. Scale: 1" = 10'