

DIST. NO.	STATE	PROJ. NO.	FISCAL YEAR	SHEET NO.	TOTAL SHEETS
HAWAII	HAW.	56A-01-72	1976	4	13

D-9-9

True North
Scale: 1"=20'

Provide a smooth riding connection at beginning and end of Project.

Sta. 284+00 to Sta. 285+00

Resurface existg. pavement of Roadway (Excluding Reconstructed Areas) with New A.C. Pavt. (1" min.) to required elevation for Normal Crown and Super-elevation Grades.

Est. Quant.

A.C. Pavt. Mix V = 200 Tons 510 Tons
Tack Coat = 200 Gals. 442 Gals.
Pavt. Area = 1333 C.Y.



Sta. 288+05

Demolish existg. Conc. Tractor Crossing. The work necessary to Demolish will not be measured or paid for separately but shall be considered incidental to Roadway Exc.

Est. Quant.

Aqg. Subbase Course = 4 C.Y.

PLAN	DATE	BY	DATE	BY
DESIGNED				
CHECKED				
NOTED				
NO.				

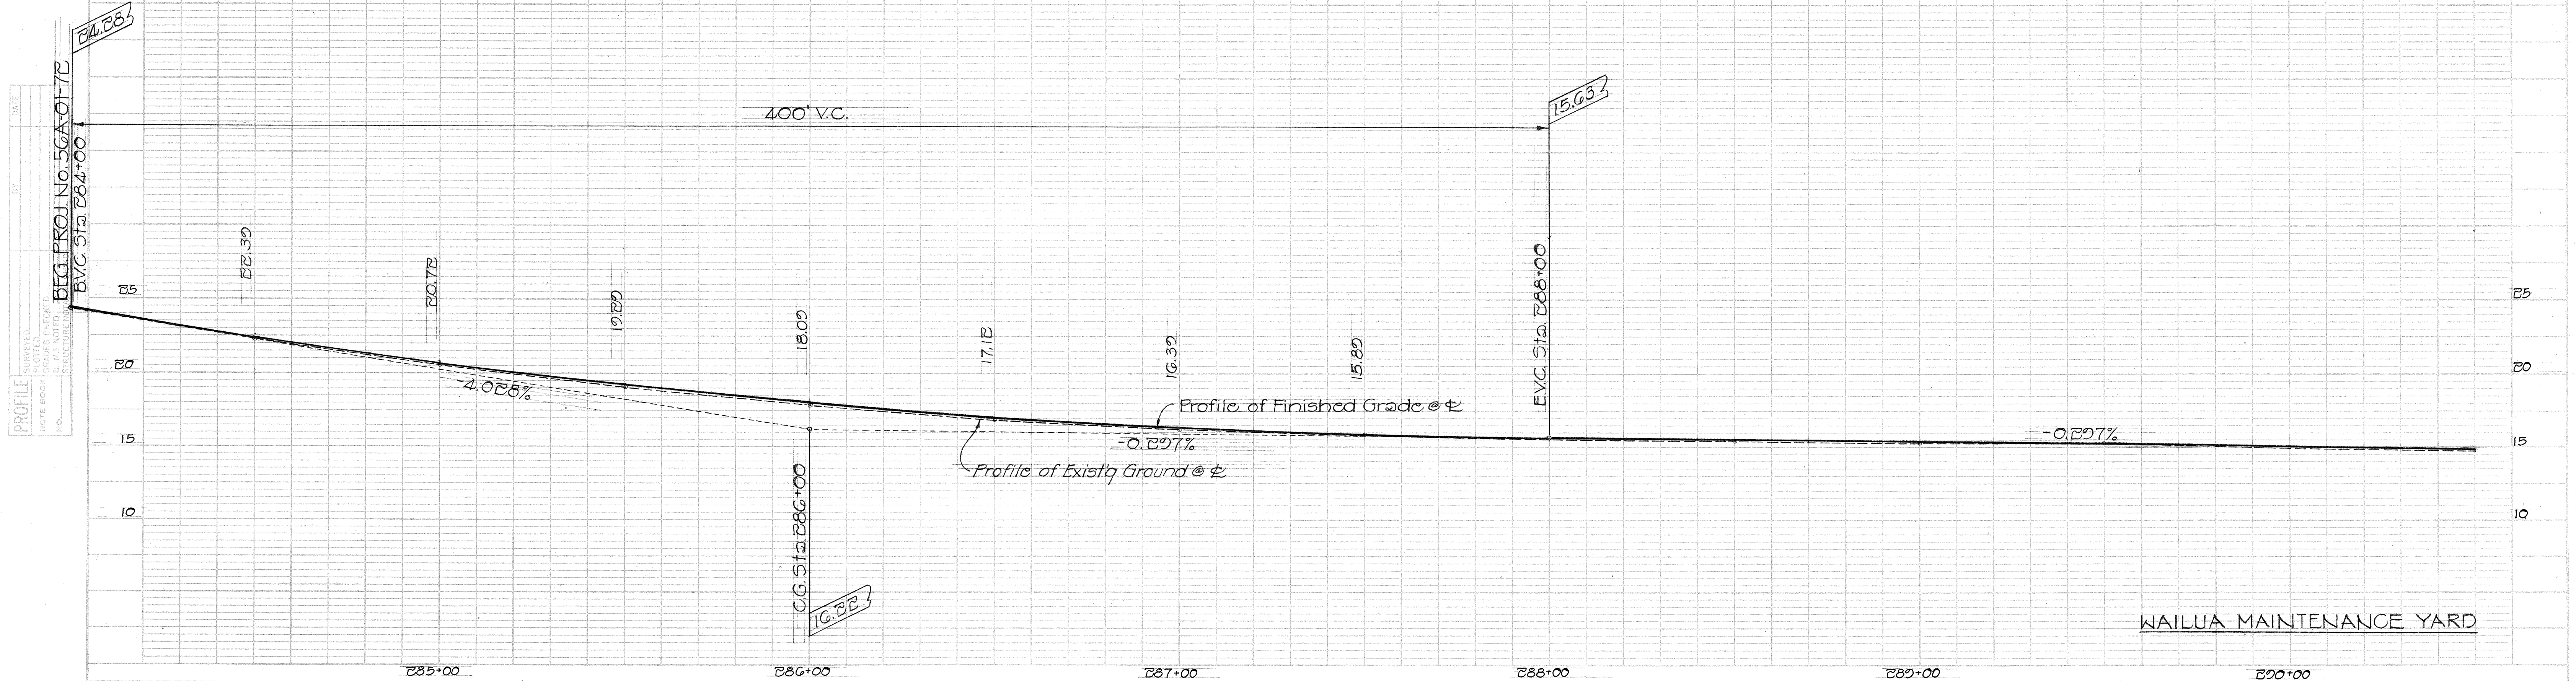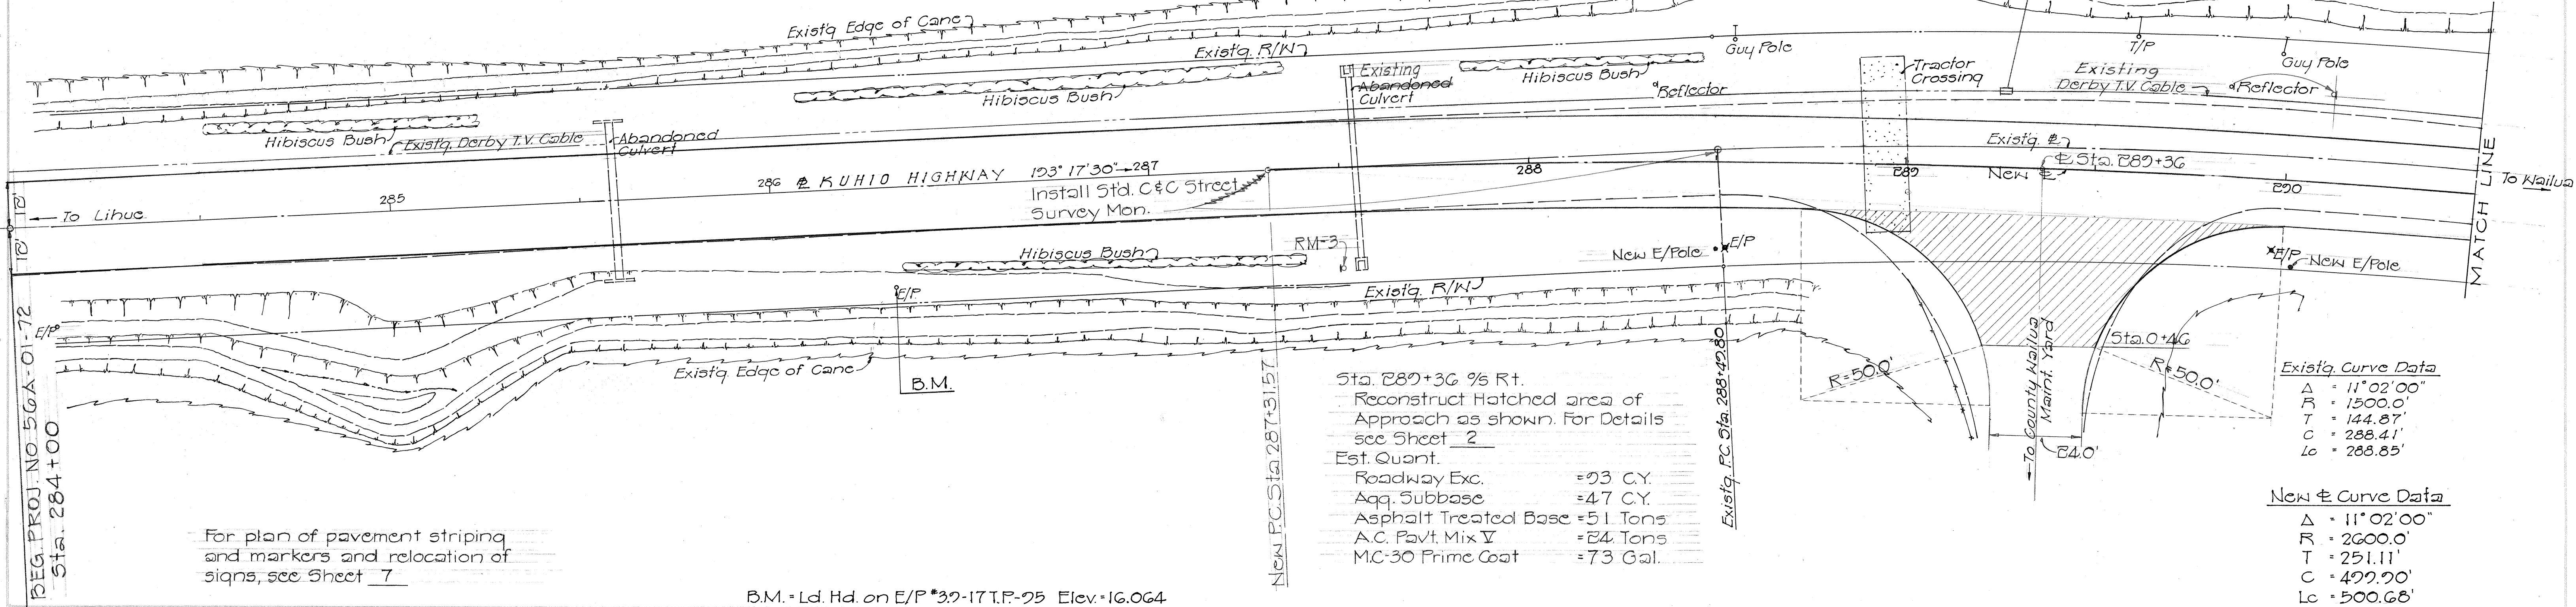



DIST. NO.	STATE	PROJ. NO.	FISCAL YEAR	SHEET NO.	TOTAL SHEETS
HAWAII	HAW.	5GA-01-72	1976	5	13

True North
Scale: 1"=20'

All Utility work
to be done by others

PLAN	DATE	BY
SURVEYED		
NOTED		
NOTE BOOK		
NO.		

PROFILE	DATE	BY
SURVEYED		
NOTED		
NOTE BOOK		
NO.		

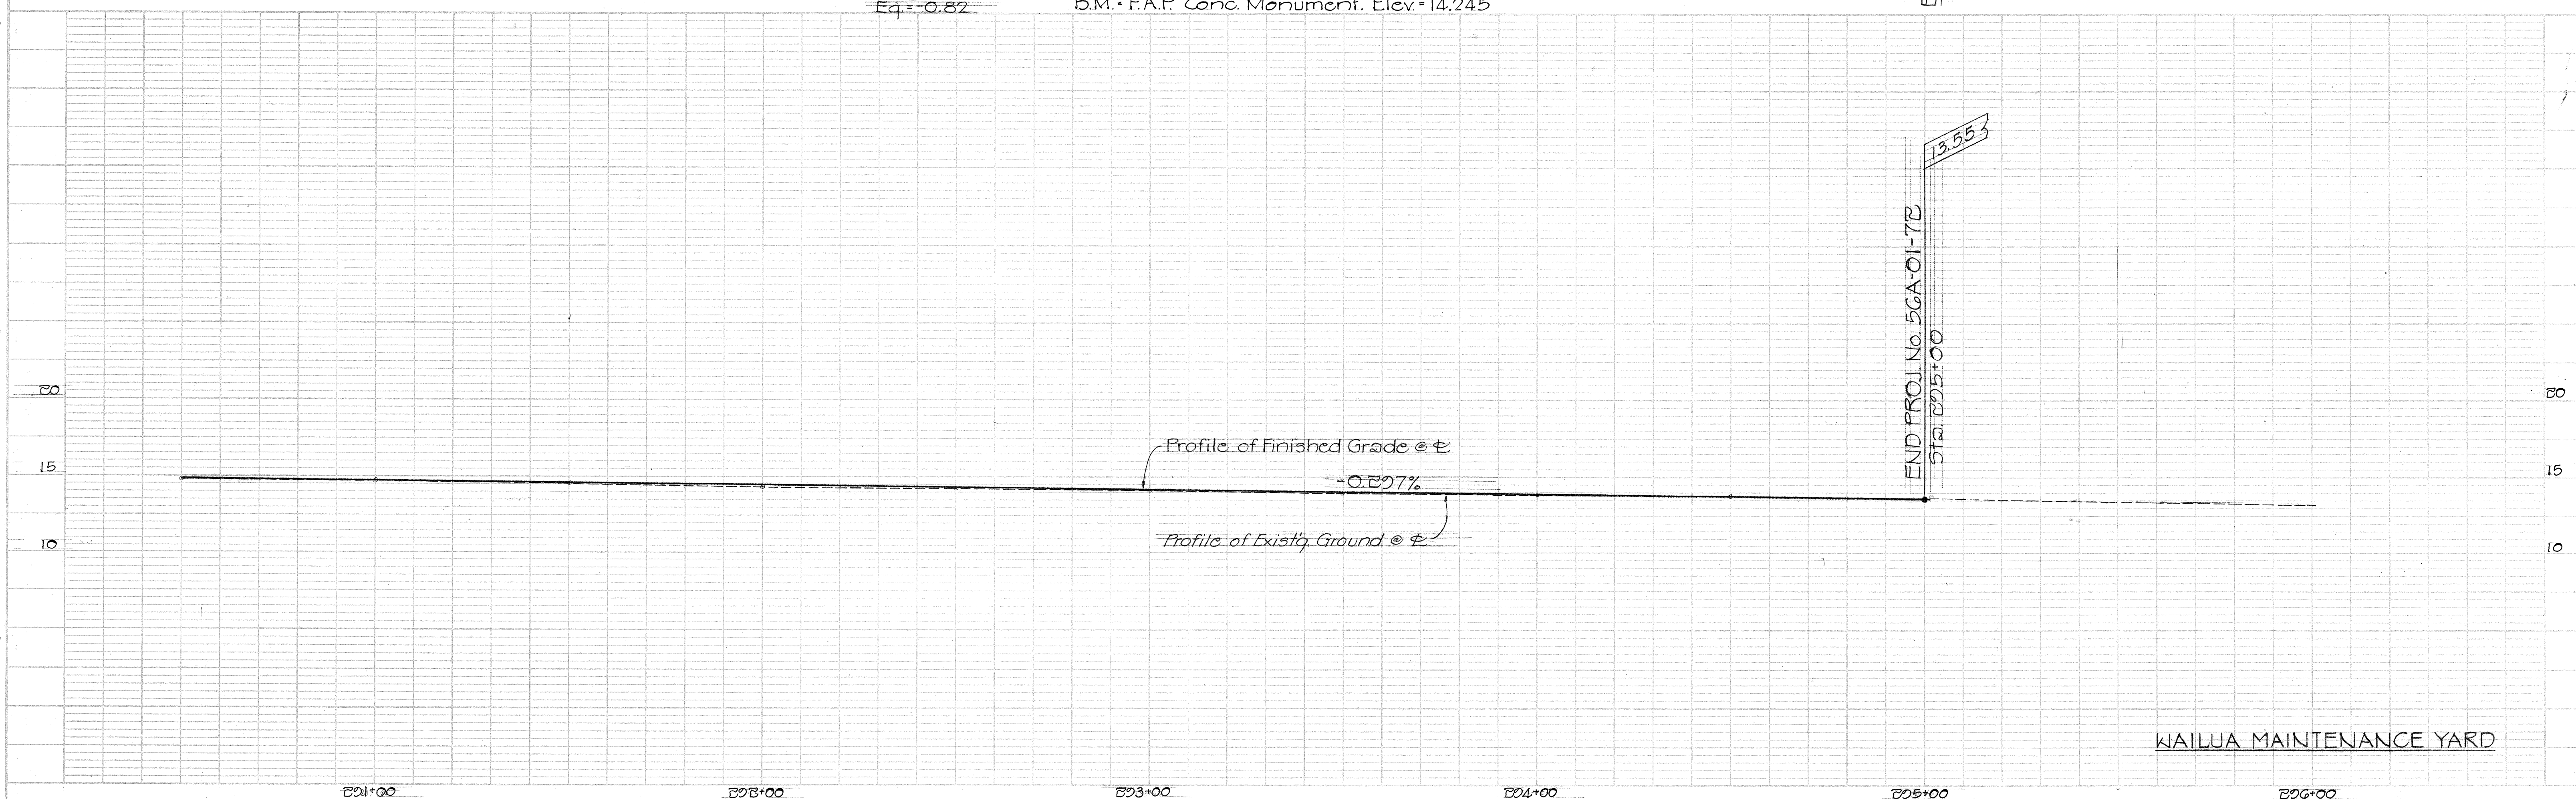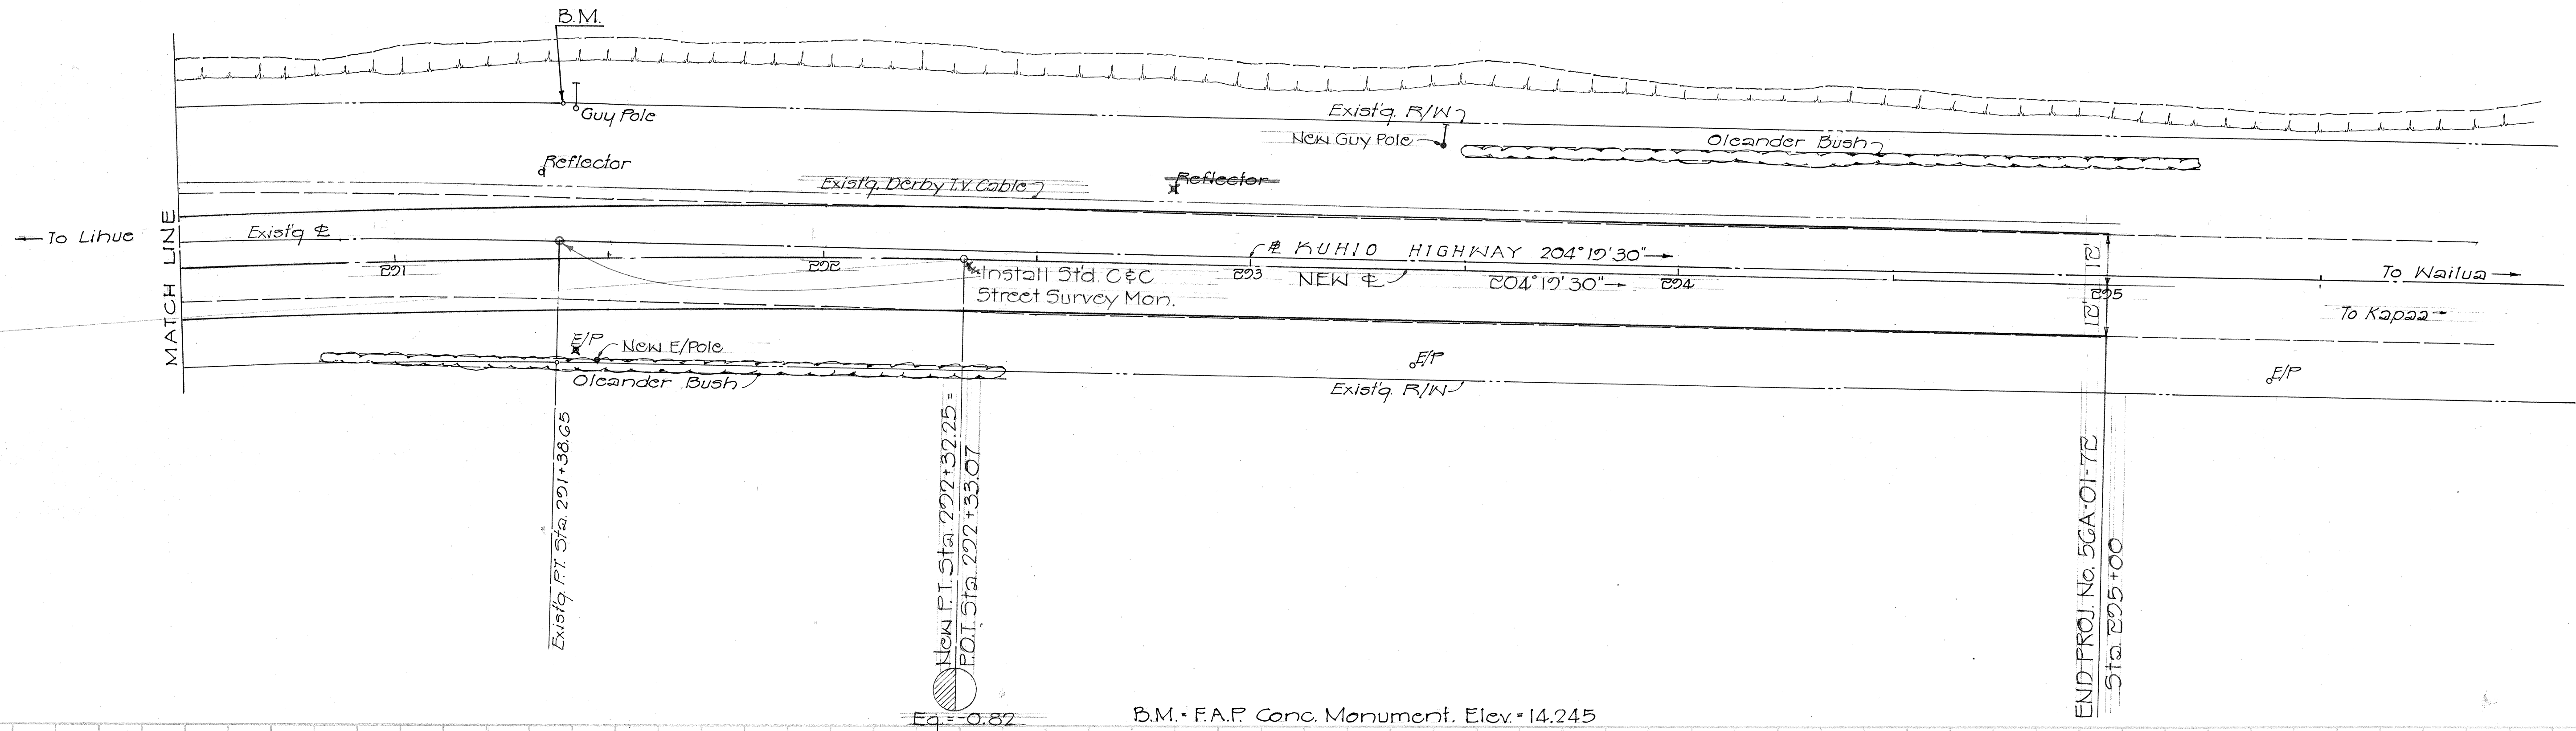

WAILUA MAINTENANCE YARD

VERT. 5' HORIZ. 20'


PLATE 1, PLAN-PROFILE
KEUFFEL & ESSER CO.

48 70-0 PHOENIX 3" VERTICAL SCALE 1" HORIZONTAL SCALE


5

MAINTENANCE YARD

DIST. NO.	STATE	PROJ. NO.	FISCAL YEAR	SHEET NO.	TOTAL SHEETS
HAWAII	HAW.	5GA-01-72	1976	6	13

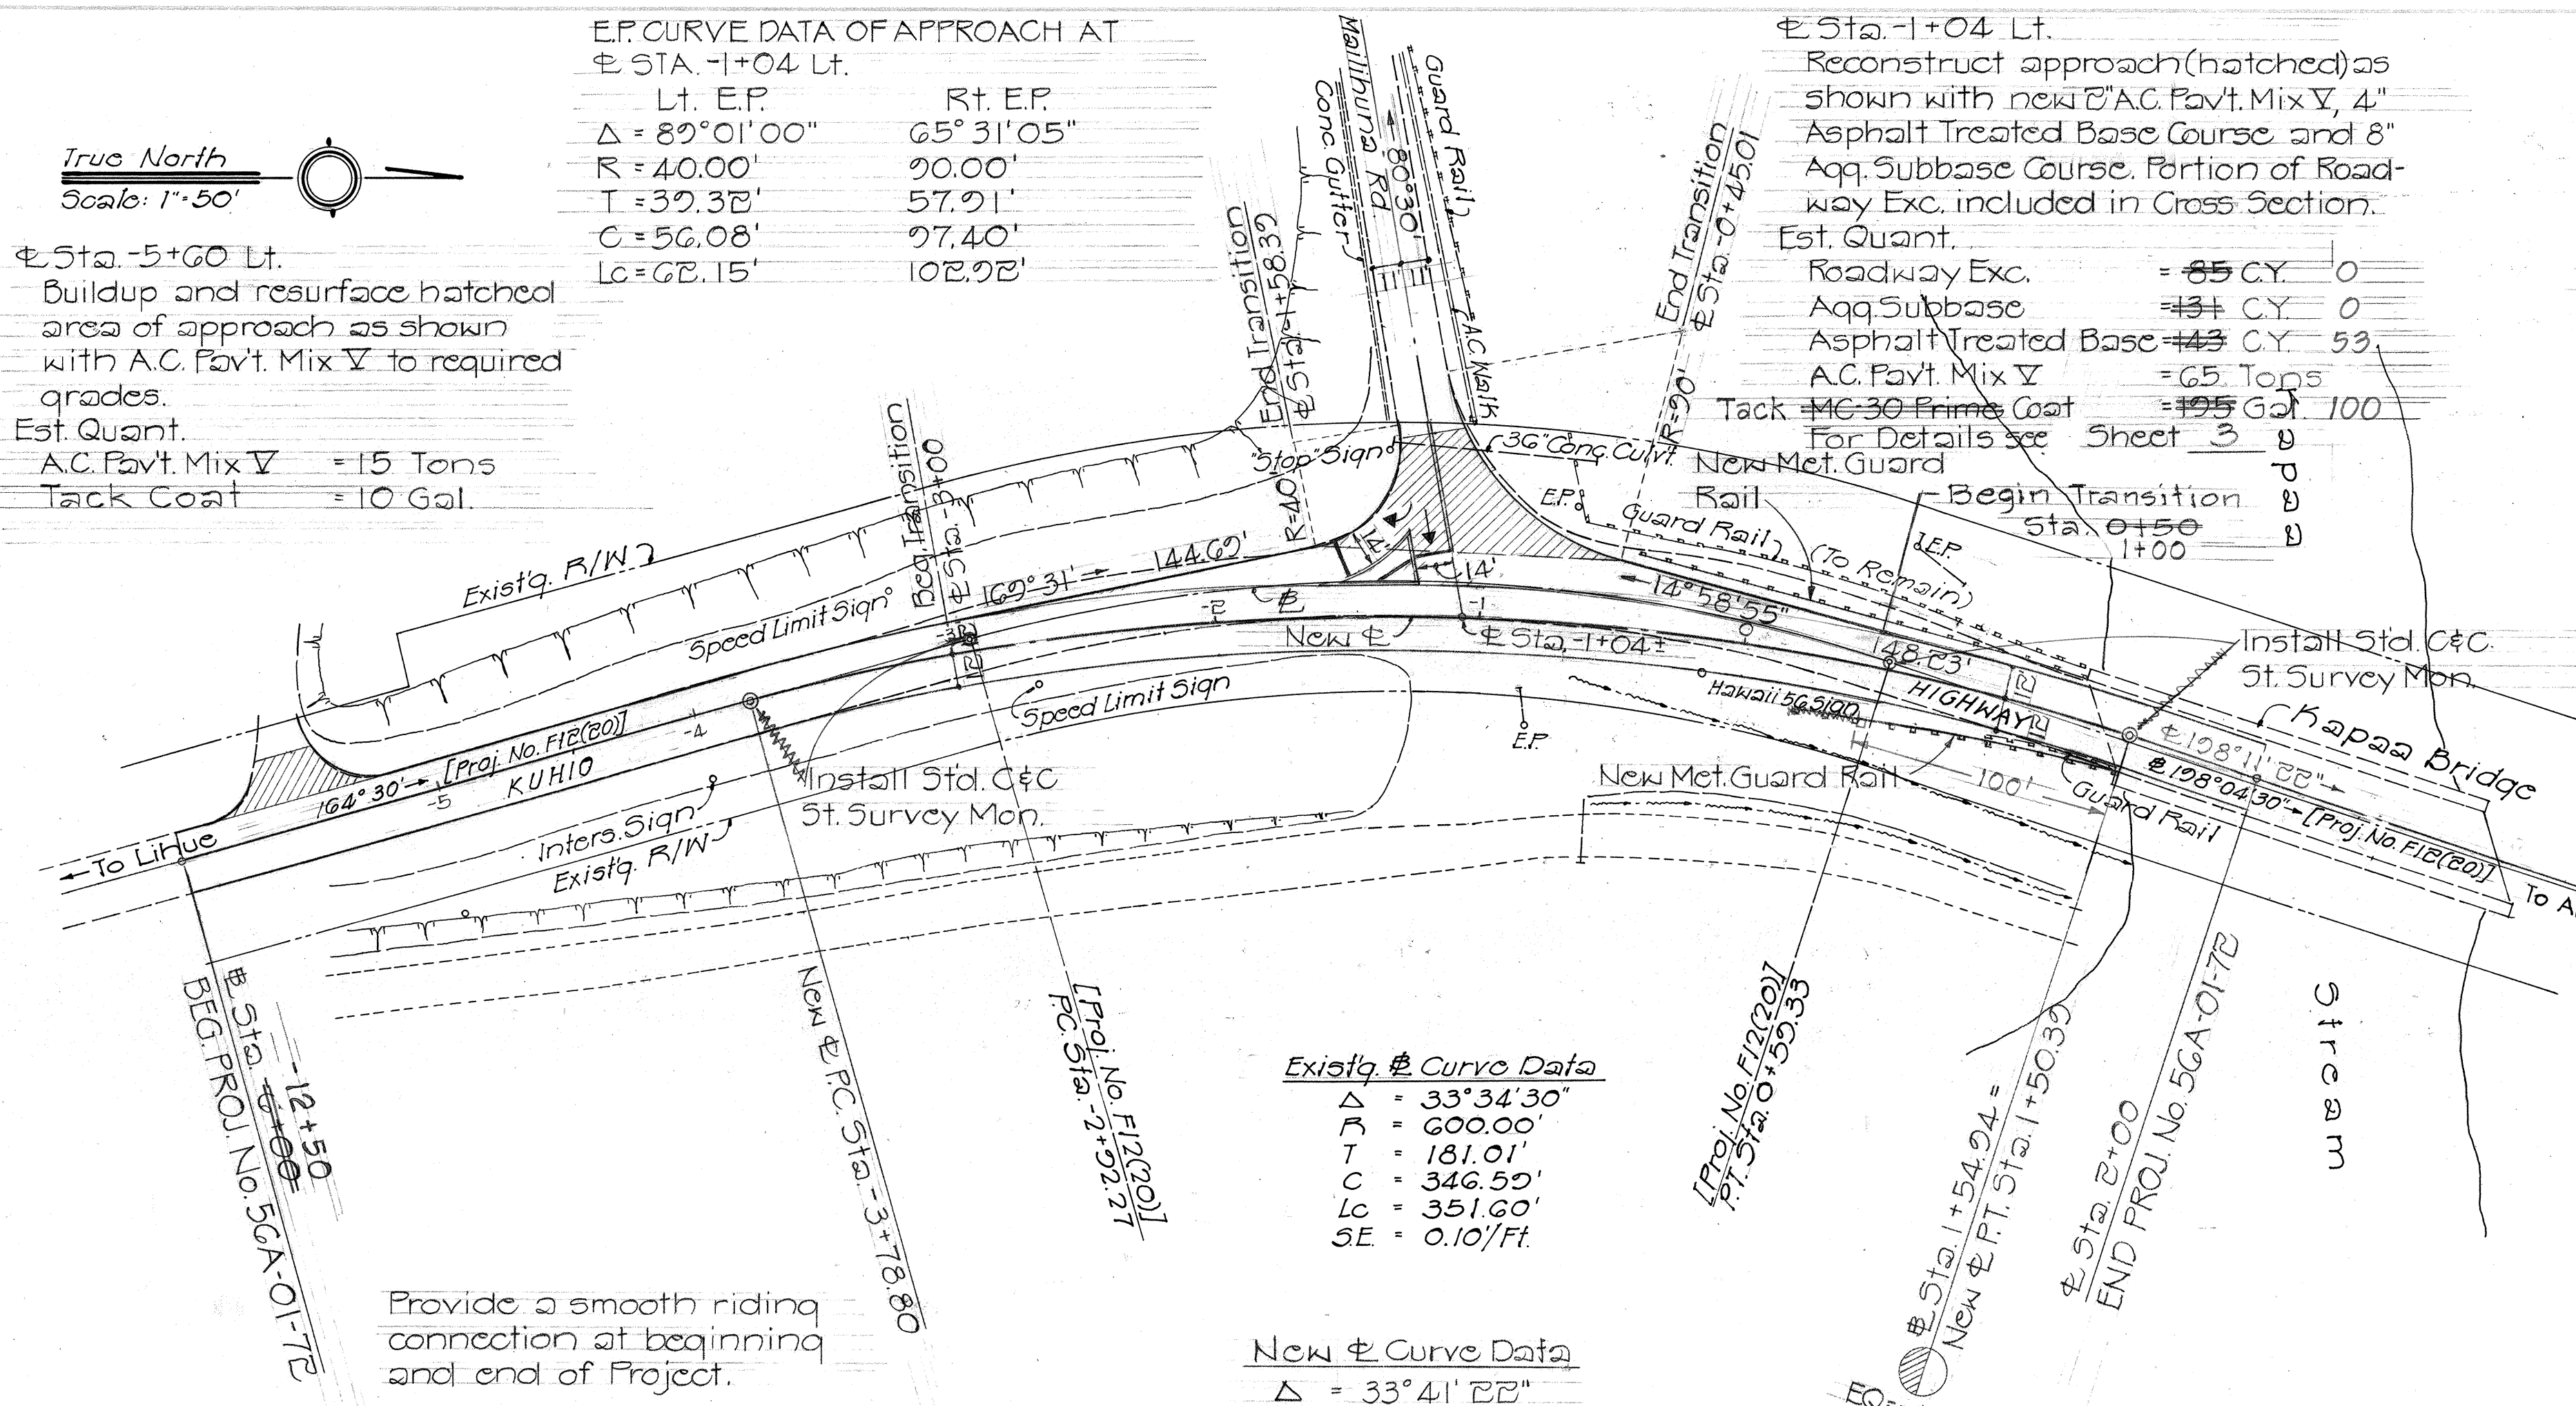

DIST. NO.	STATE	PROJ. NO.	FISCAL YEAR	SHEET NO.	TOTAL SHEETS
HAWAII	HAW.	56A-01-7E	1976	7	13

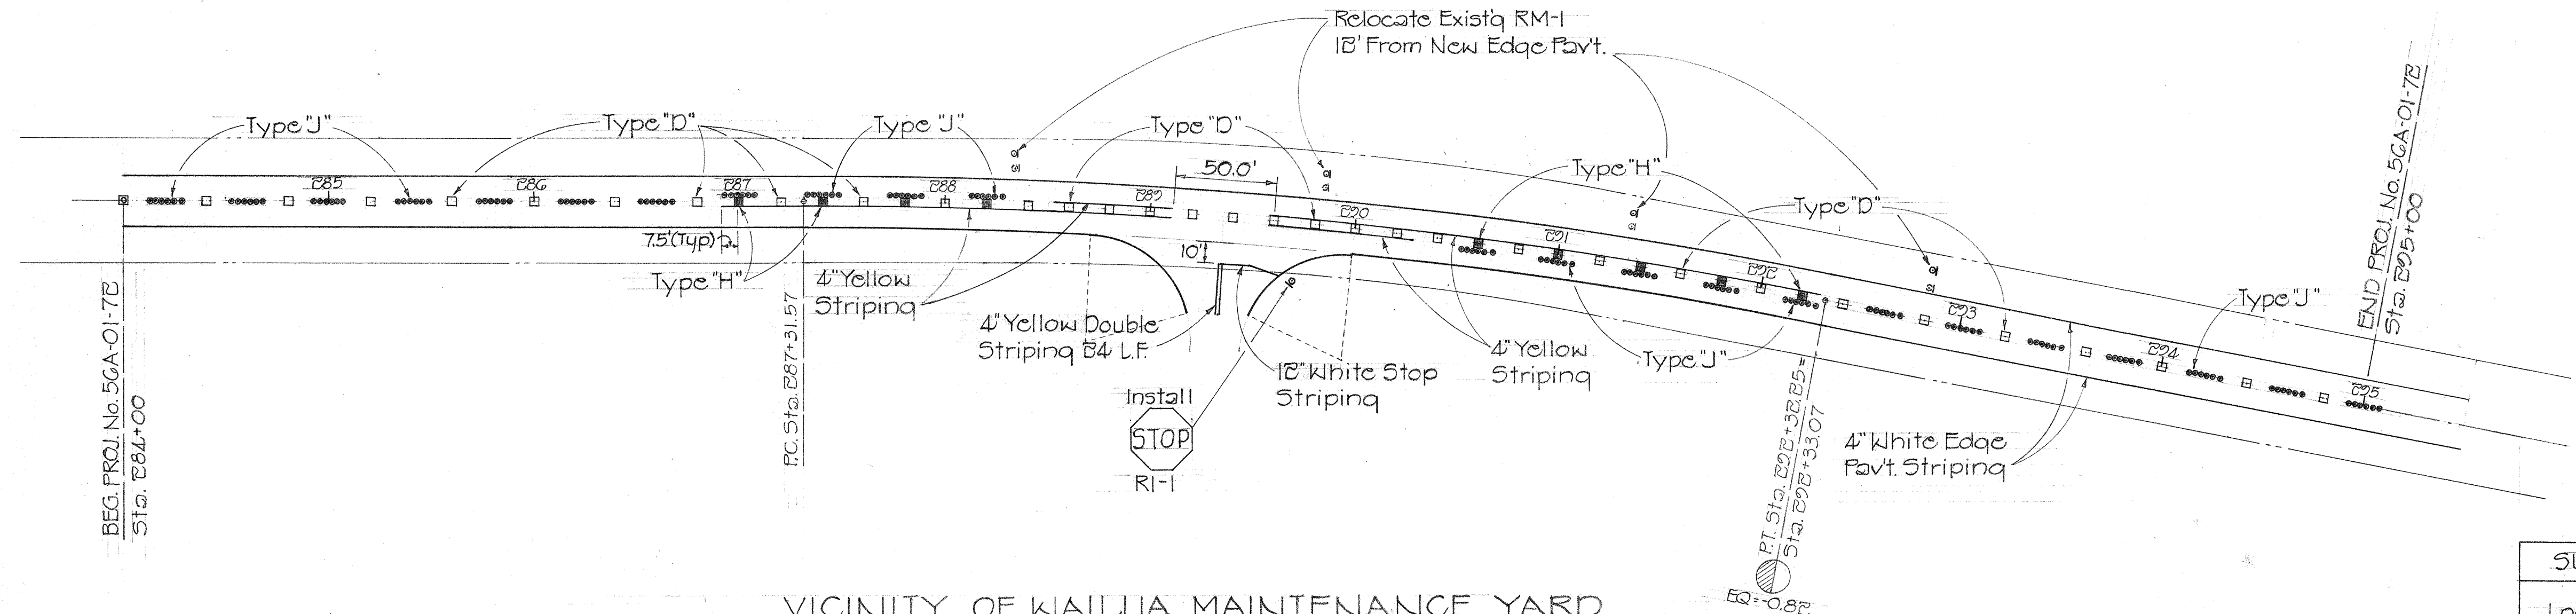


VICINITY OF WAILUA MAINTENANCE YARD
PLAN OF STRIPING, RAISED PAVEMENT MARKERS & SIGNS
Scale: 1"=50'

LEGEND ~RAISED PAVEMENT MARKERS


○	TYPE "A"
◻	TYPE "C"
◻	TYPE "D"
◻	TYPE "H"
●	TYPE "J"

SUMMARY OF PAVEMENT MARKINGS

Location	Striping L.F.		Raised Markers Ea.		
	Yellow	White	Type "D"	Type "H"	Type "J"
Road C	485 476		33 33	0	138 144
Edge of Pavt.		600 2353			
Approach	54 28	58 26			
Total	509 504	600 2379	33 33	0	138 144

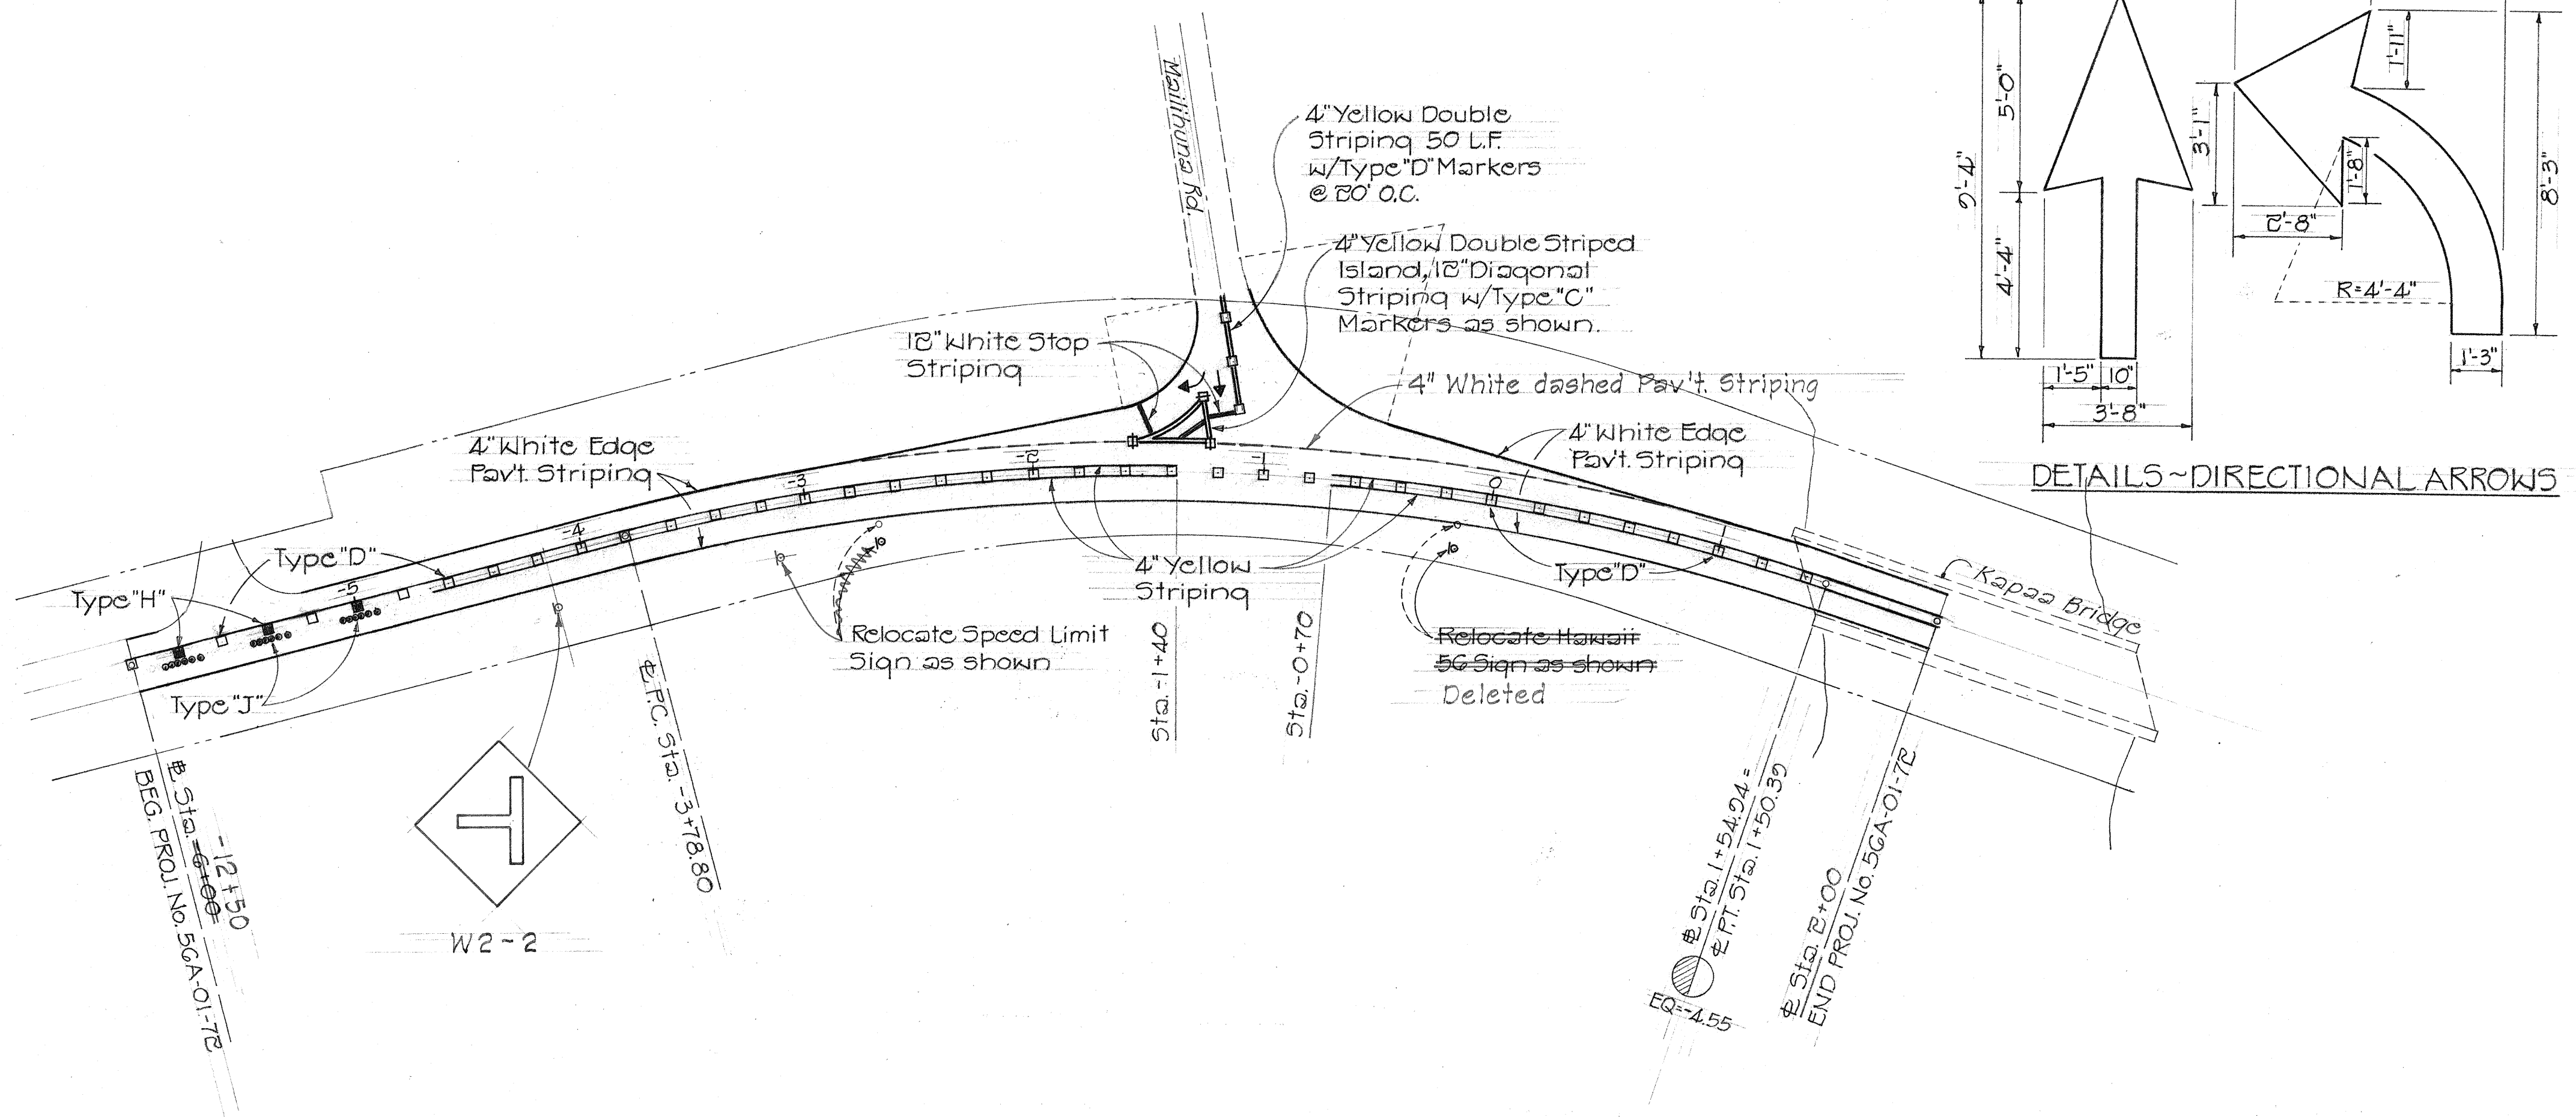

VICINITY OF MAILIHUNA ROAD
PLAN OF STRIPING, RAISED PAVEMENT MARKERS & SIGNS
Scale: 1"=50'

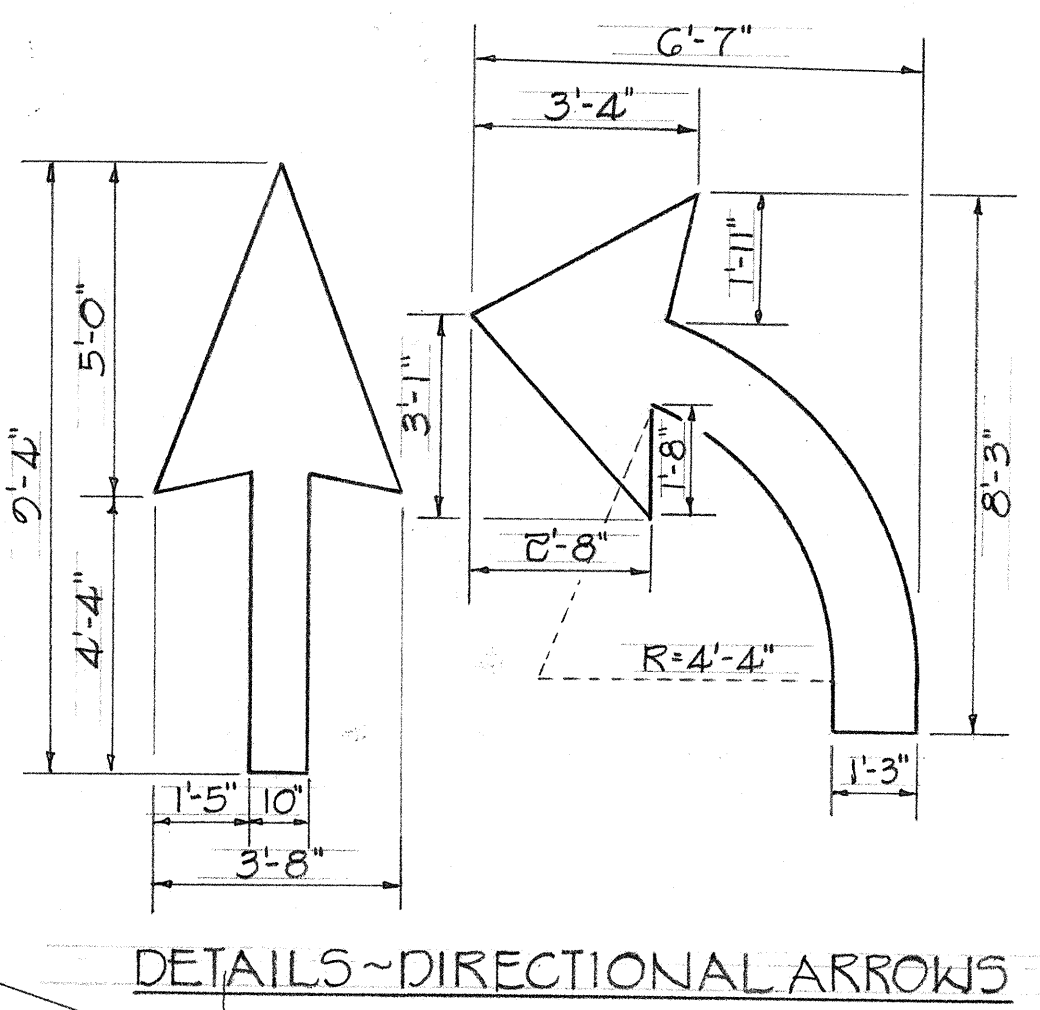

SUMMARY OF PAVEMENT MARKINGS							
Location	Pavt. Arrow Ea.	Striping L.F.		Raised Markers Ea.			
		Yellow	White	Type "C"	Type "D"	Type "H"	Type "J"
Road C		730 1615			35 36	3 7	18 42
Edge of Pavt.			600 3488				
Mailihuna Rd App.	2	47 39	581 28	3	3 5		
Total	2	777 1714	600 3516	3	38 41	3 7	18 42

STATE OF HAWAII
DEPARTMENT OF TRANSPORTATION
HIGHWAYS DIVISION
KAUAI BELT ROAD SAFETY IMPROVEMENTS
WAILUA MAINTENANCE YD. & MAILIHUNA RD.
PROJ. No 56A-01-7E
PLAN OF STRIPING, RAISED MARKERS & SIGNS
Scale: As shown Nov. 1975
SHEET No. 1 OF 1 SHEETS

DATE	_____
DESIGNED BY	_____
DRAWN BY	_____
CHECKED BY	_____
APPROVED BY	_____
ORIGINAL PLAN	_____
NOTE BOOK	_____
No.	_____