



DIST. NO.	STATE	PROJ. NO.	FISCAL YEAR	SHEET NO.	TOTAL SHEETS
HAWAII	HAW.	5GA-01-7E	1976	7	13

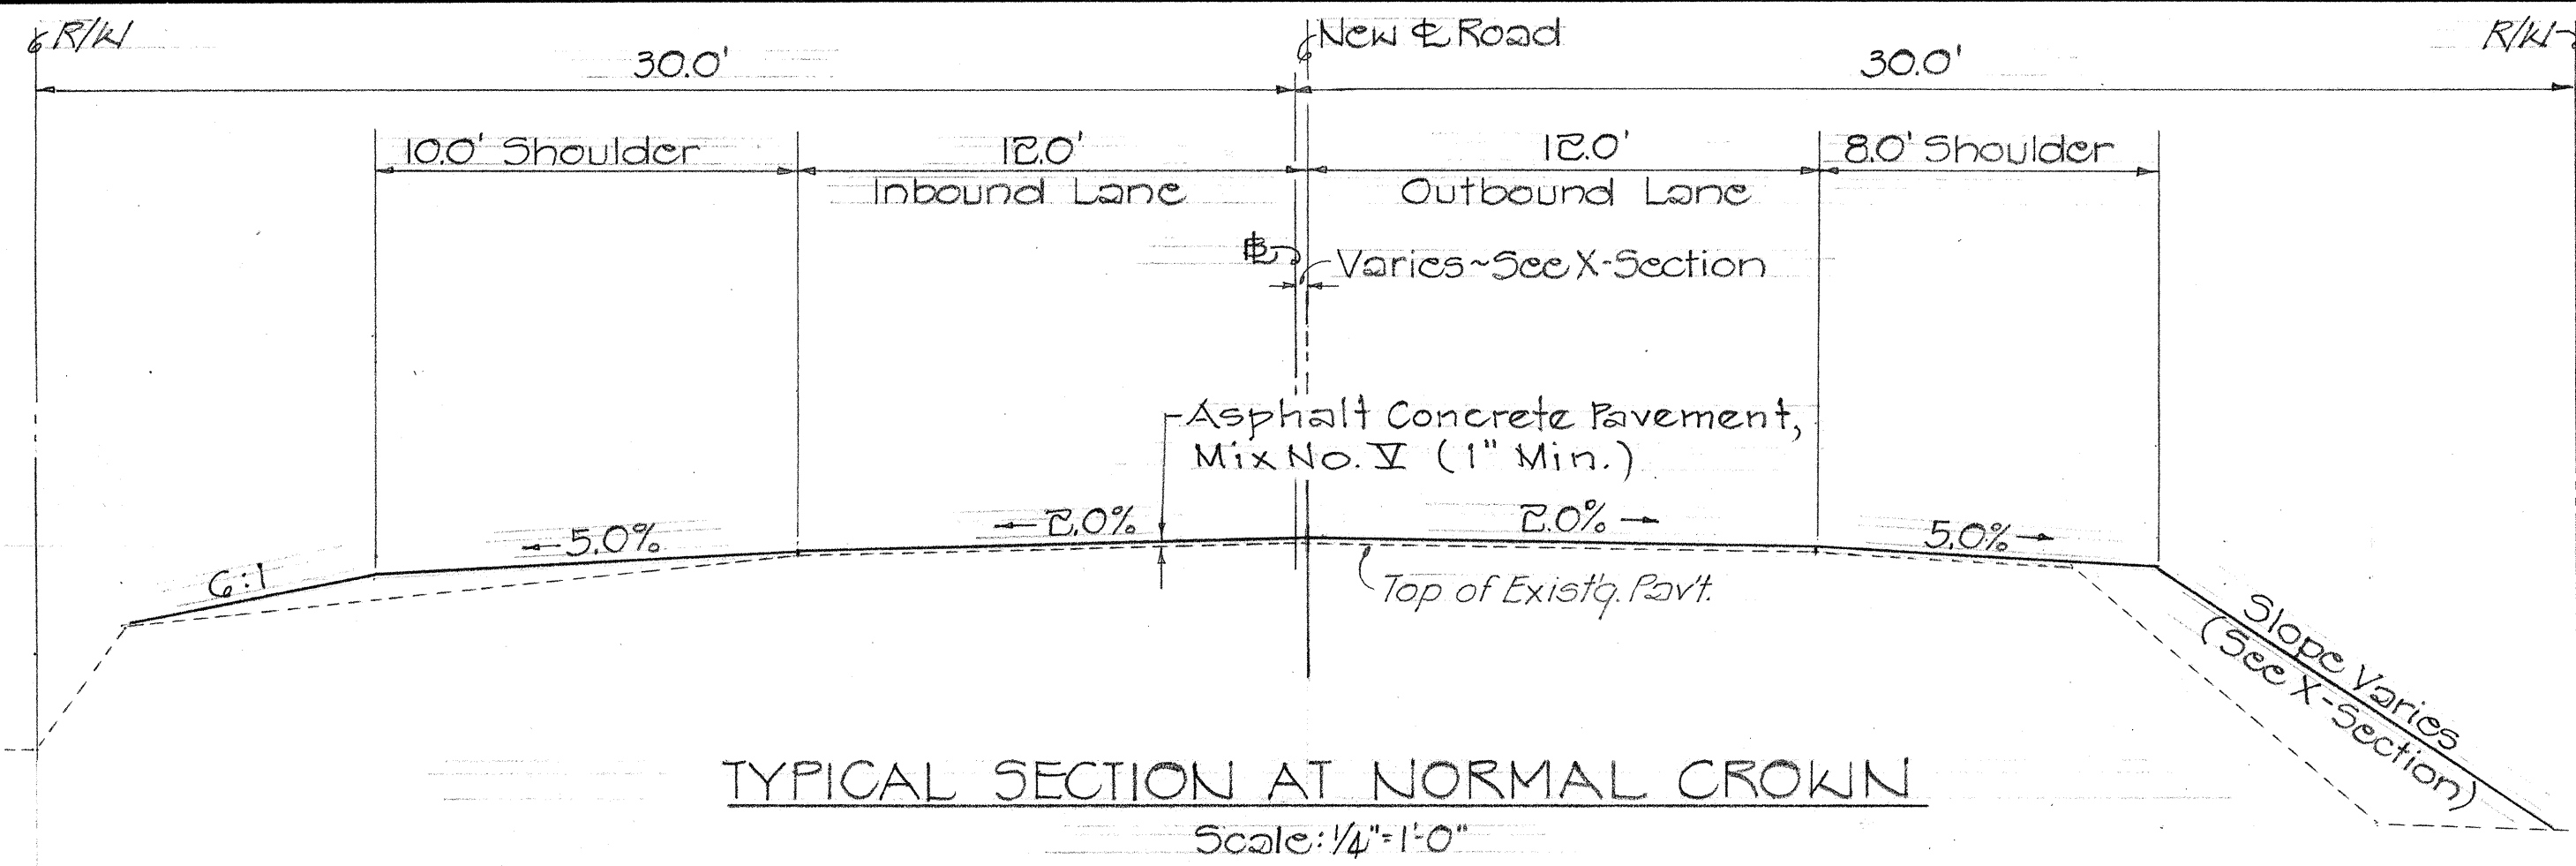


TYPICAL SECTION AT NORMAL CROWN

Scale: 1/4"=1'-0"

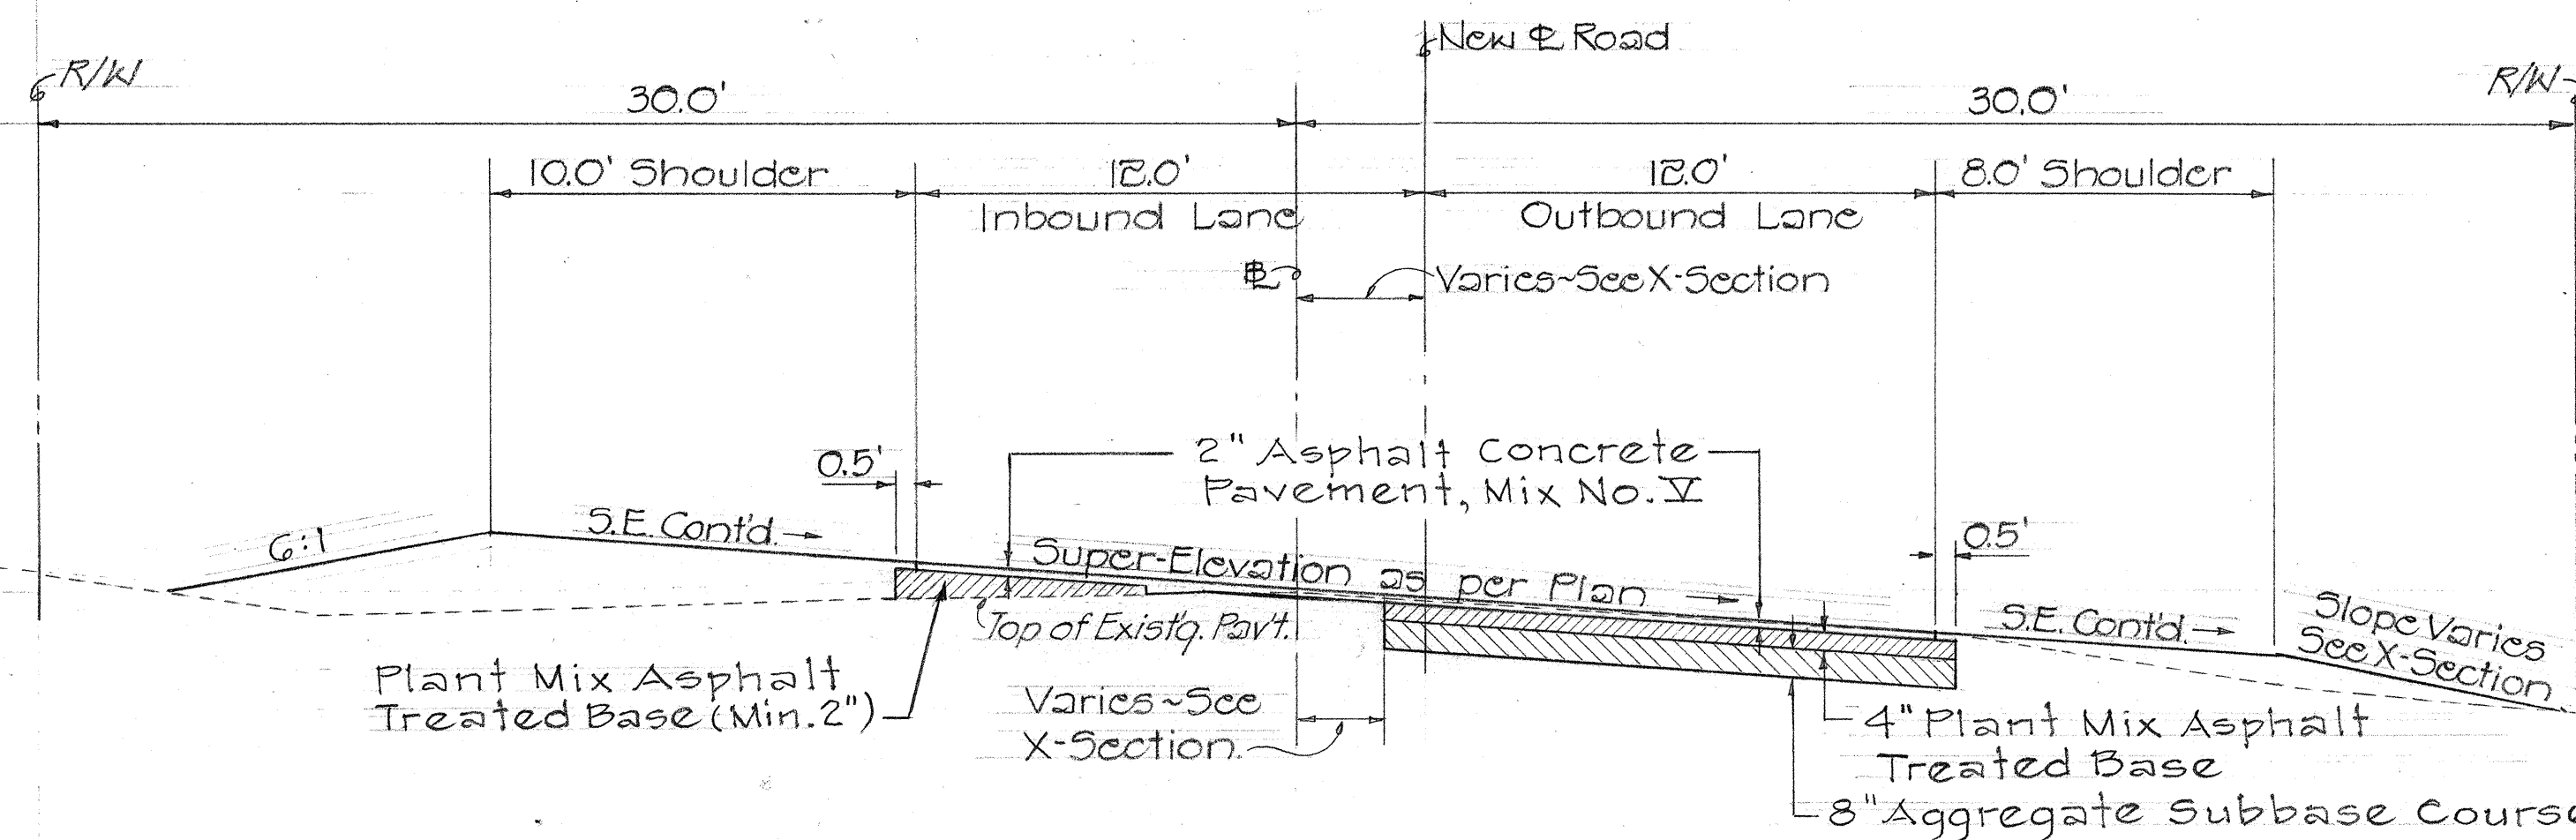


TYPICAL SECTION AT SUPER-ELEVATION

Scale: 1/4"=1'-0"

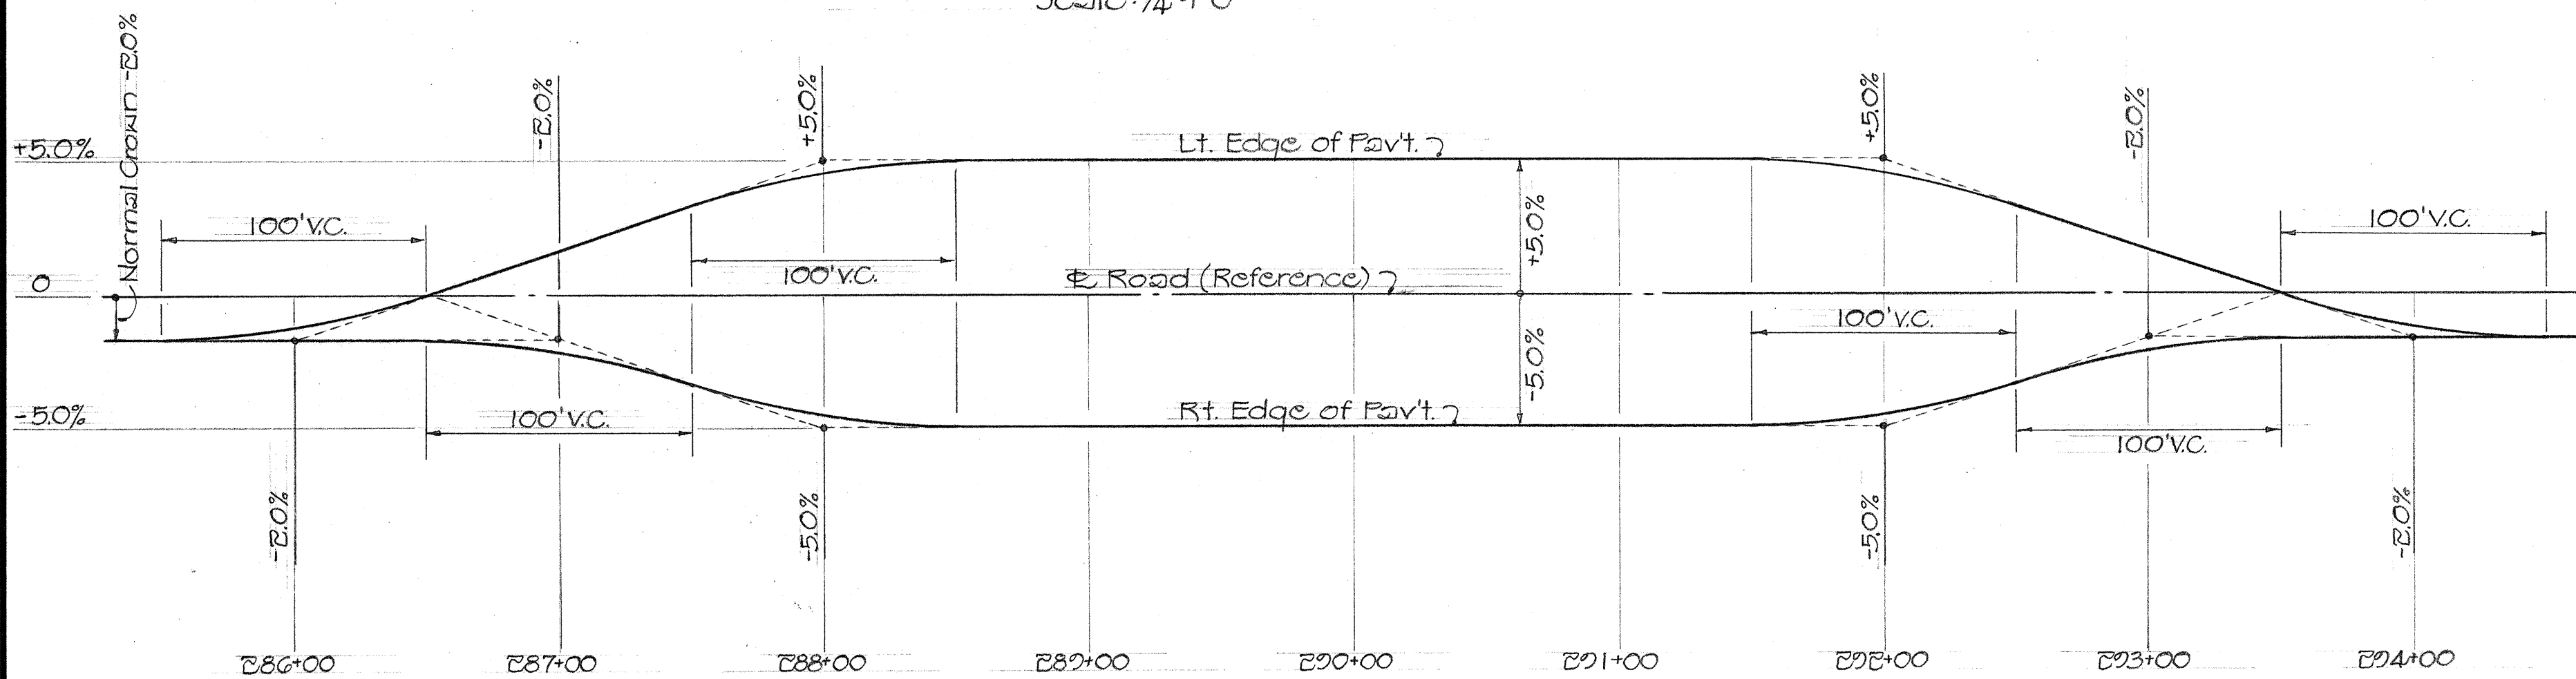

SUPER-ELEVATION OF LEFT & RIGHT EDGE OF PAVEMENT

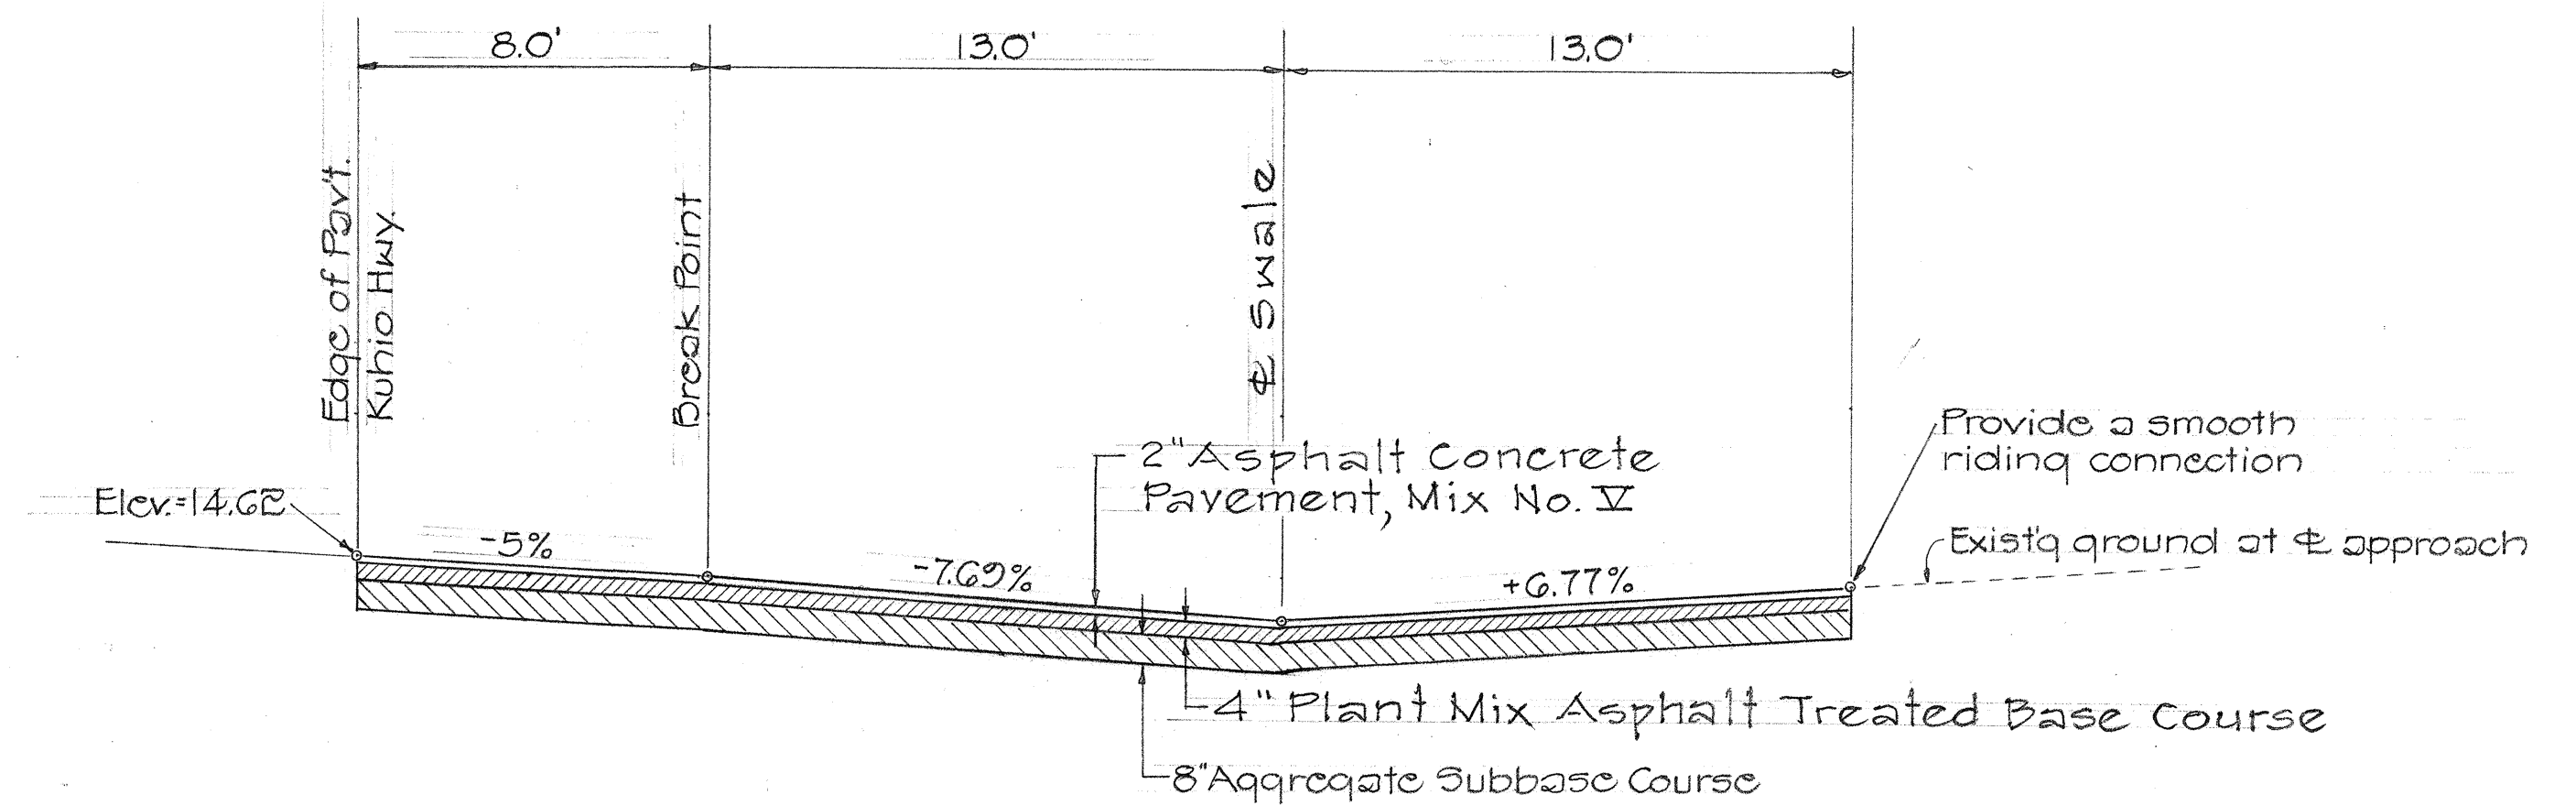

LONGITUDINAL SECTION FOR APPROACH @ STA. 289+36-RT.

Scale: 1/4"=1'-0"


GENERAL NOTES:

1. Refer to Cross Sections for areas requiring reconstruction on roadway.
2. The exact location of relocated signs shall be determined in the field by the Project Engineer.
3. All existing pavements over which embankments are to be constructed shall be scarified and compacted. The work necessary to scarify and compact shall be incidental to Roadway Excavation.
4. Materials designated to be salvaged shall be hauled and neatly stock-piled at the State's baseyard, Kahau Road, Kapaa. Salvaging, hauling and stock-piling will not be measured or paid for directly but shall be considered incidental to various contract items.


ORIGINAL PLAN	DATE
DESIGNED BY	
TRACED BY	
NOTED BY	
CHECKED BY	

STATE OF HAWAII
DEPARTMENT OF TRANSPORTATION
HIGHWAYS DIVISION
KAUAI BELT ROAD, SAFETY IMPROVEMENTS
VICINITY OF WAILUA MAINTENANCE YD.
PROJ. No. 5GA-01-7E
TYPICAL SECTION & GENERAL NOTES
Scale: As shown Nov. 1975
SHEET No. 1 OF 1 SHEETS


DIST. NO.	STATE	PROJ. NO.	FISCAL YEAR	SHEET NO.	TOTAL SHEETS
HAWAII	HAW.	5GA-01-7B	1976	3	13

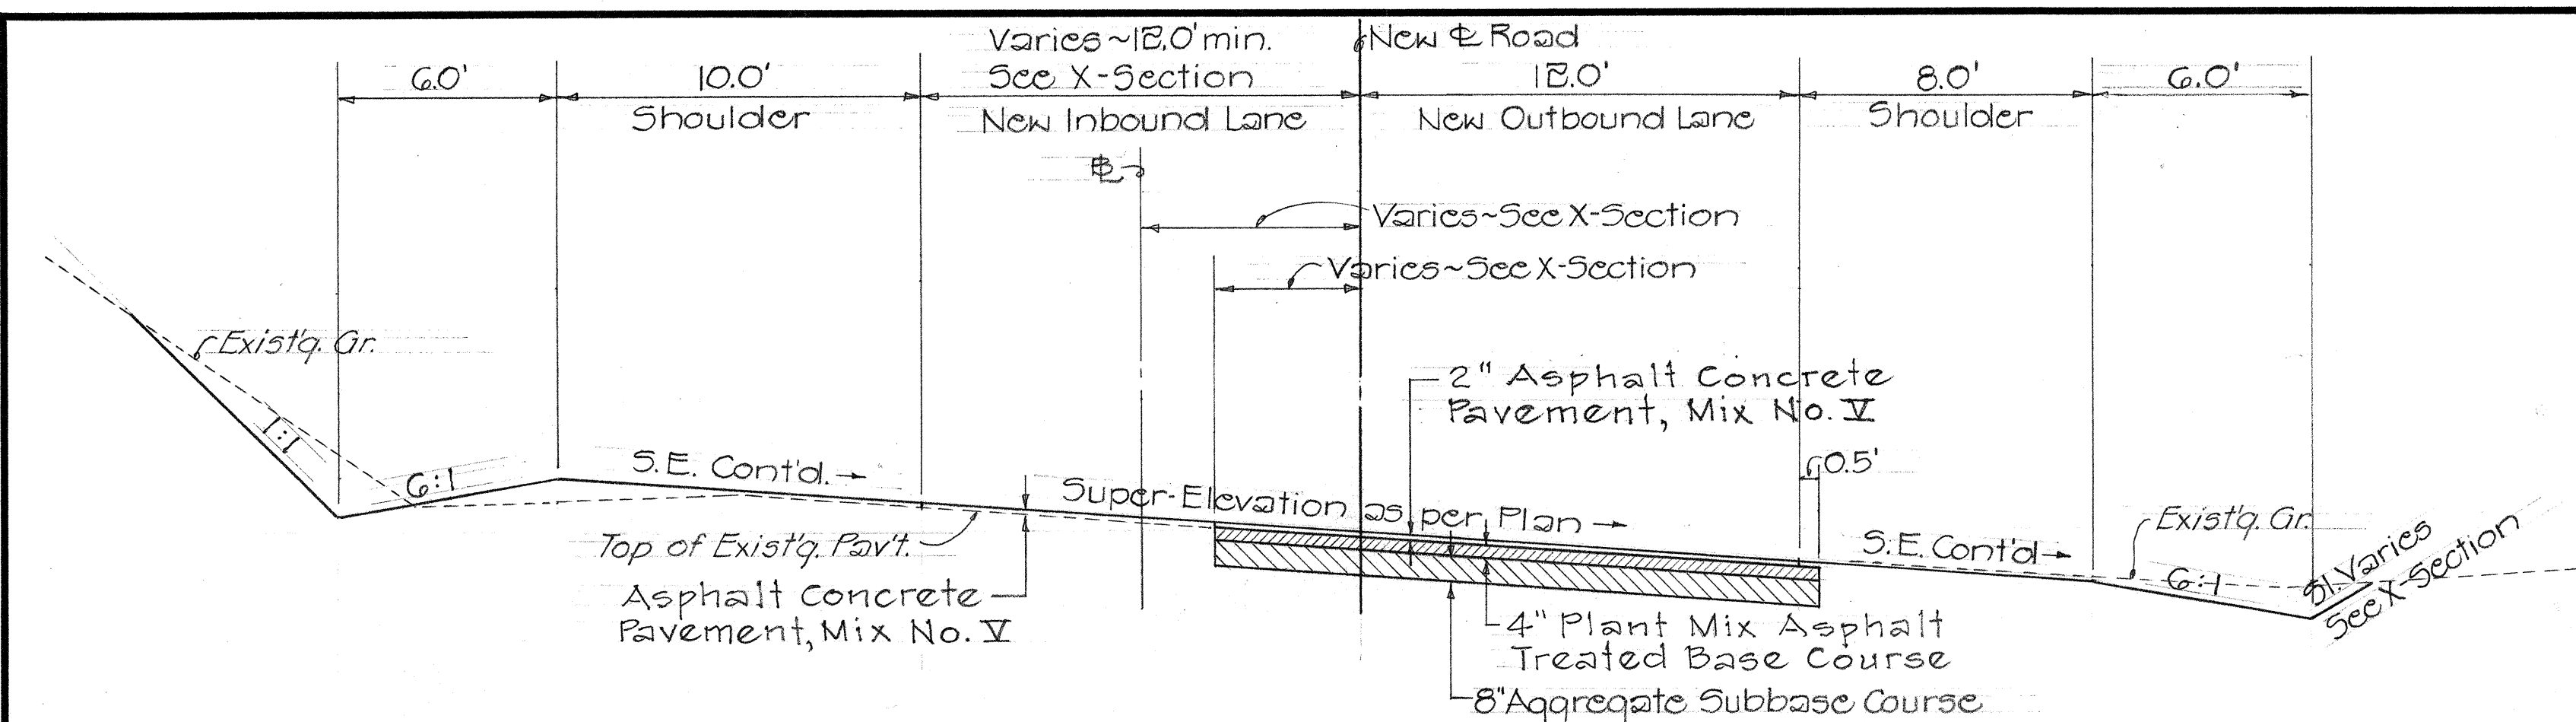


TYPICAL SECTION AT SUPER-ELEVATION
Scale: 1/4" = 1'-0"

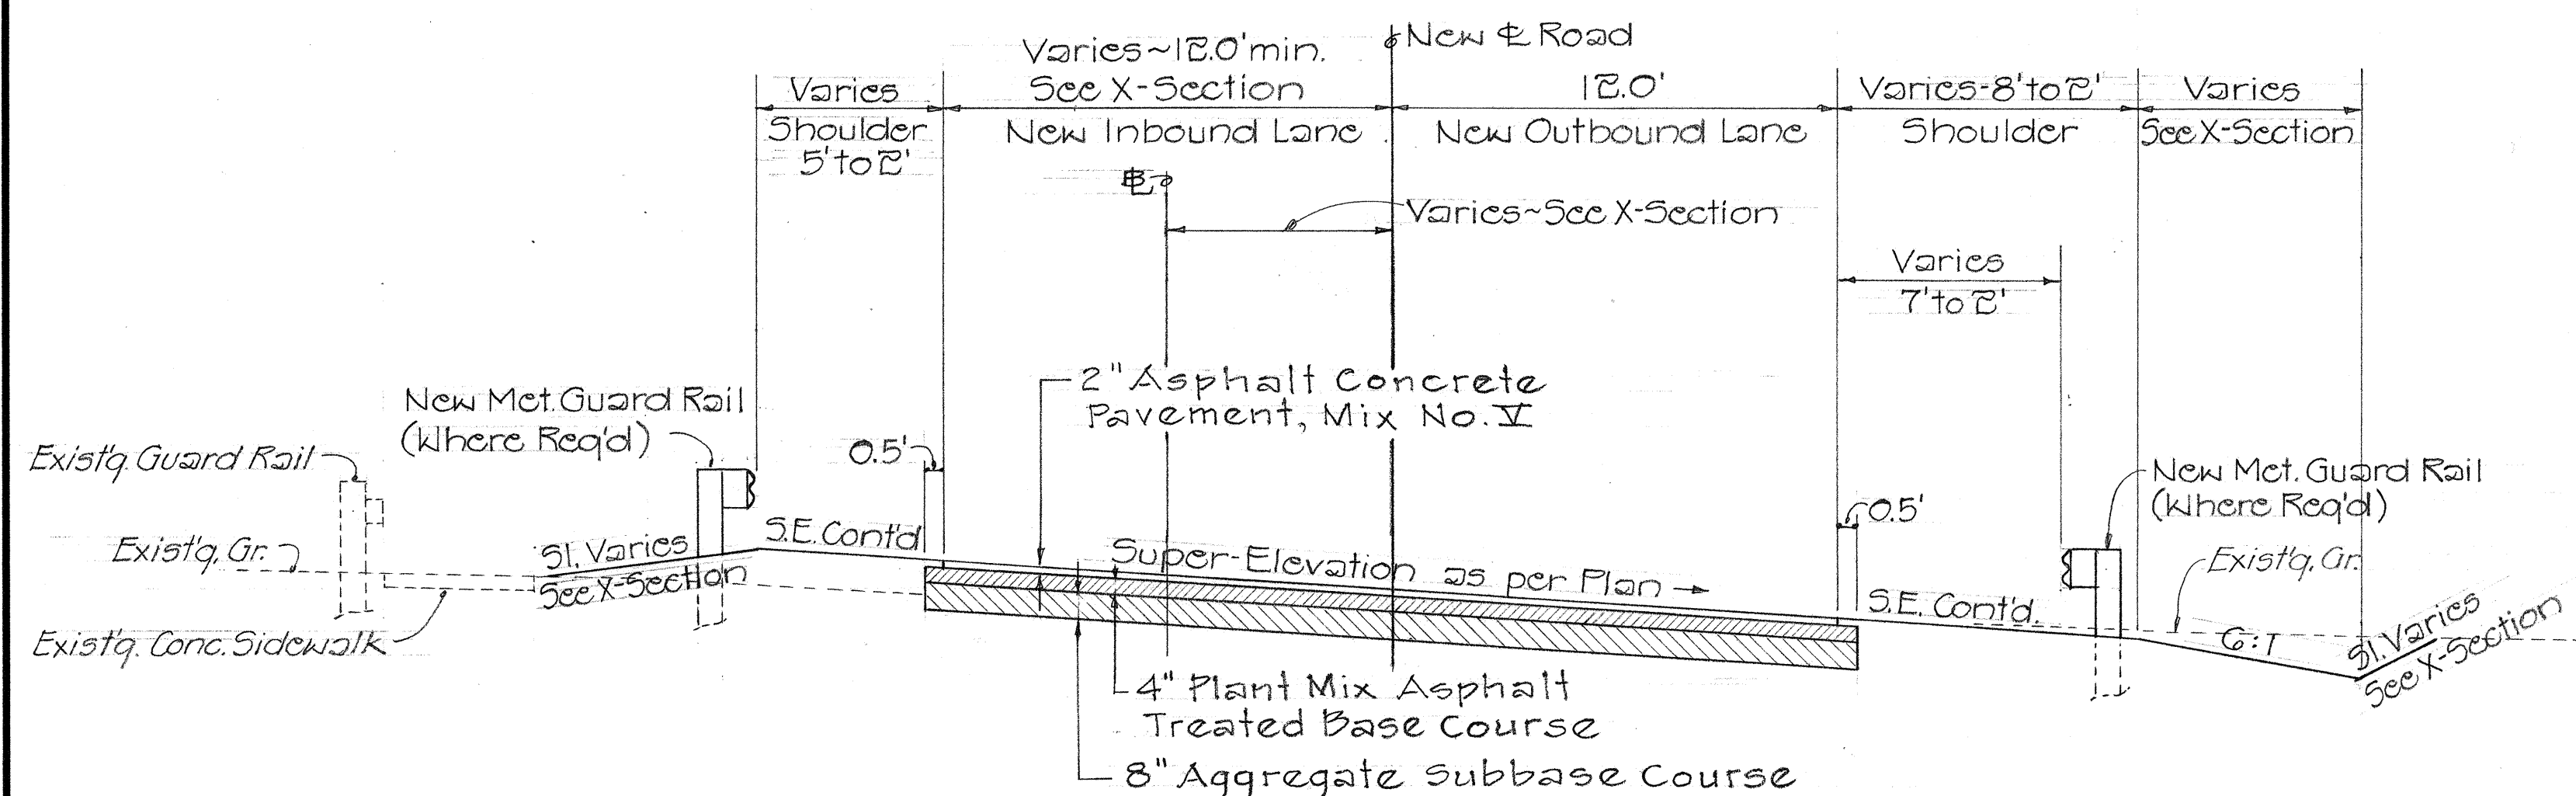

TYPICAL SECTION AT SUPER-ELEVATION
STA -0+48.07 to STA. 1+50.39
Scale: 1/4" = 1'-0"

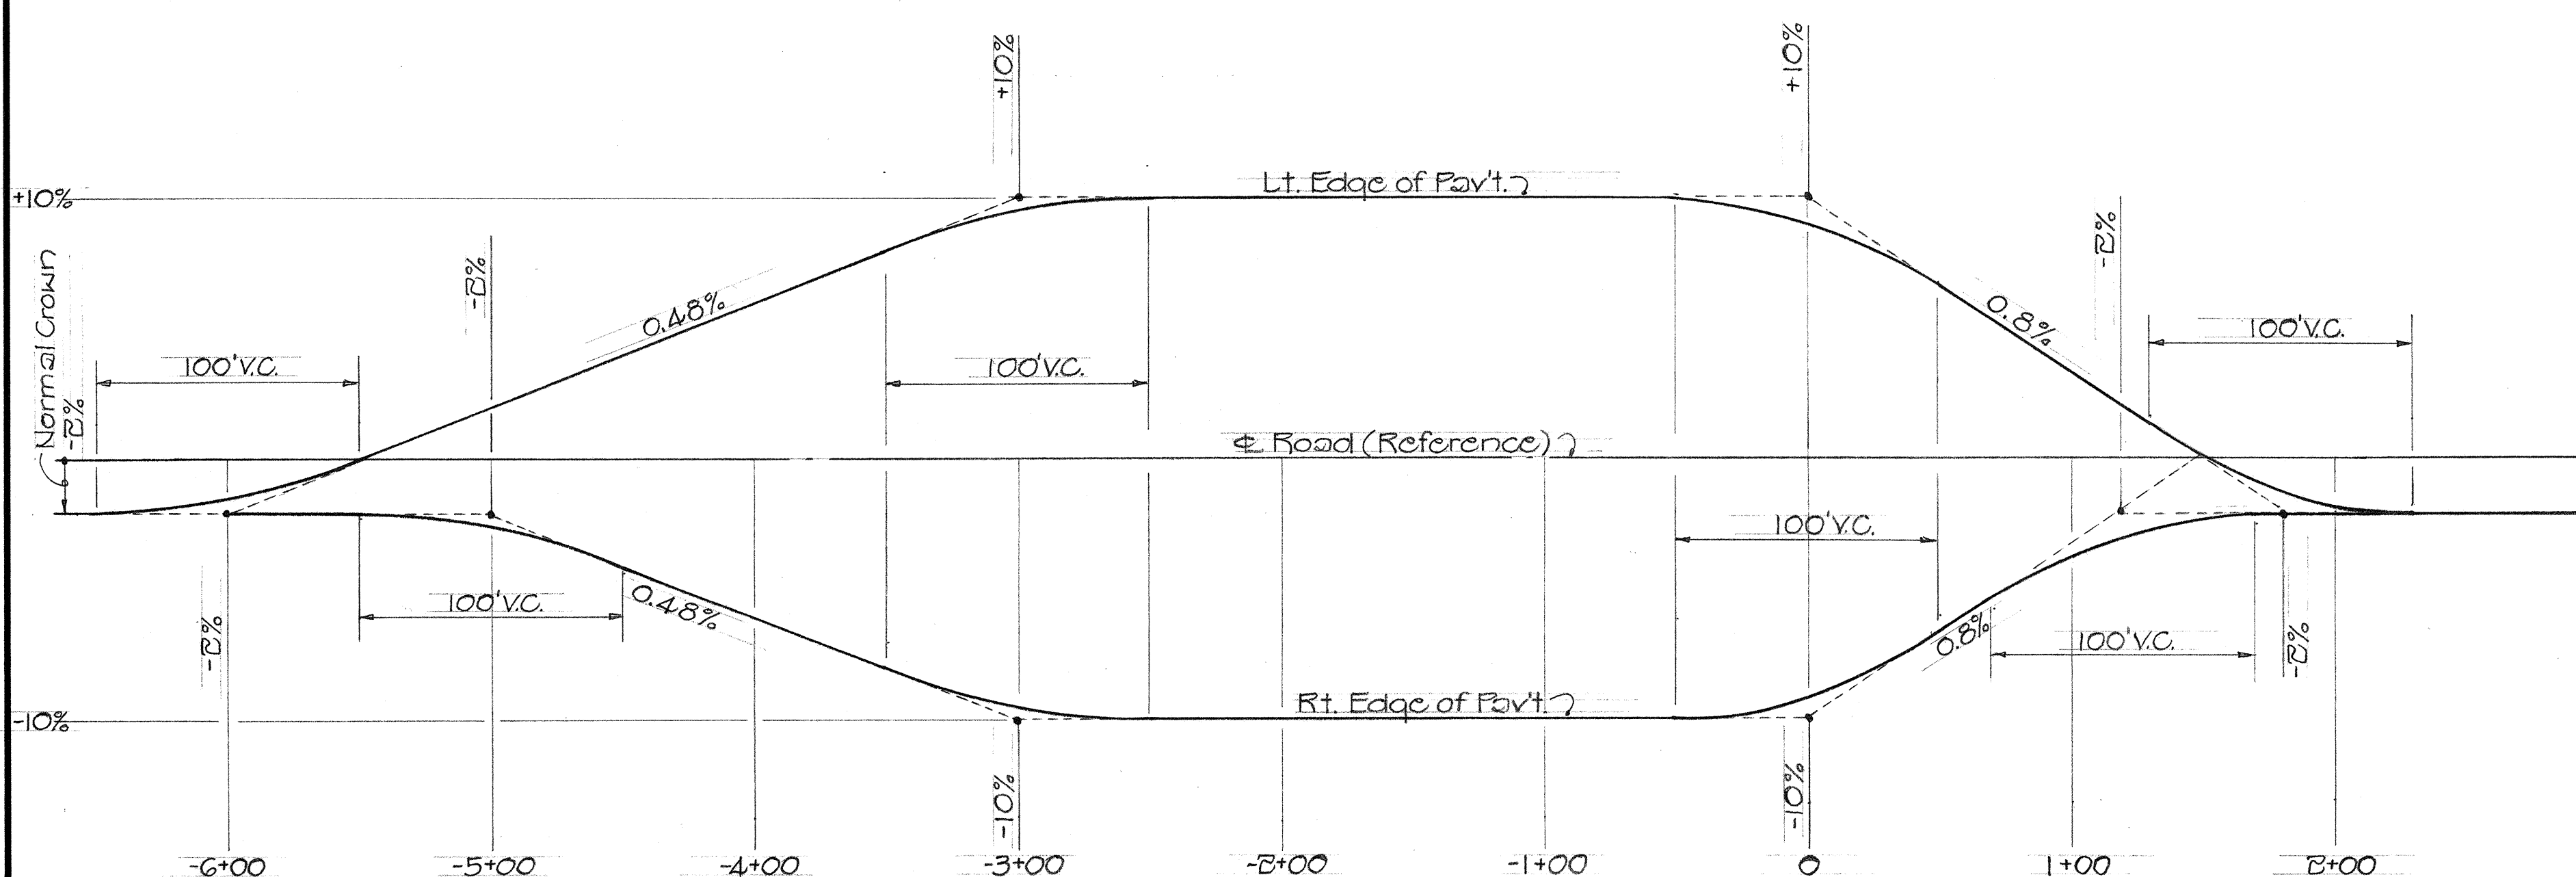

SUPER-ELEVATION OF LEFT & RIGHT EDGE OF PAVEMENT

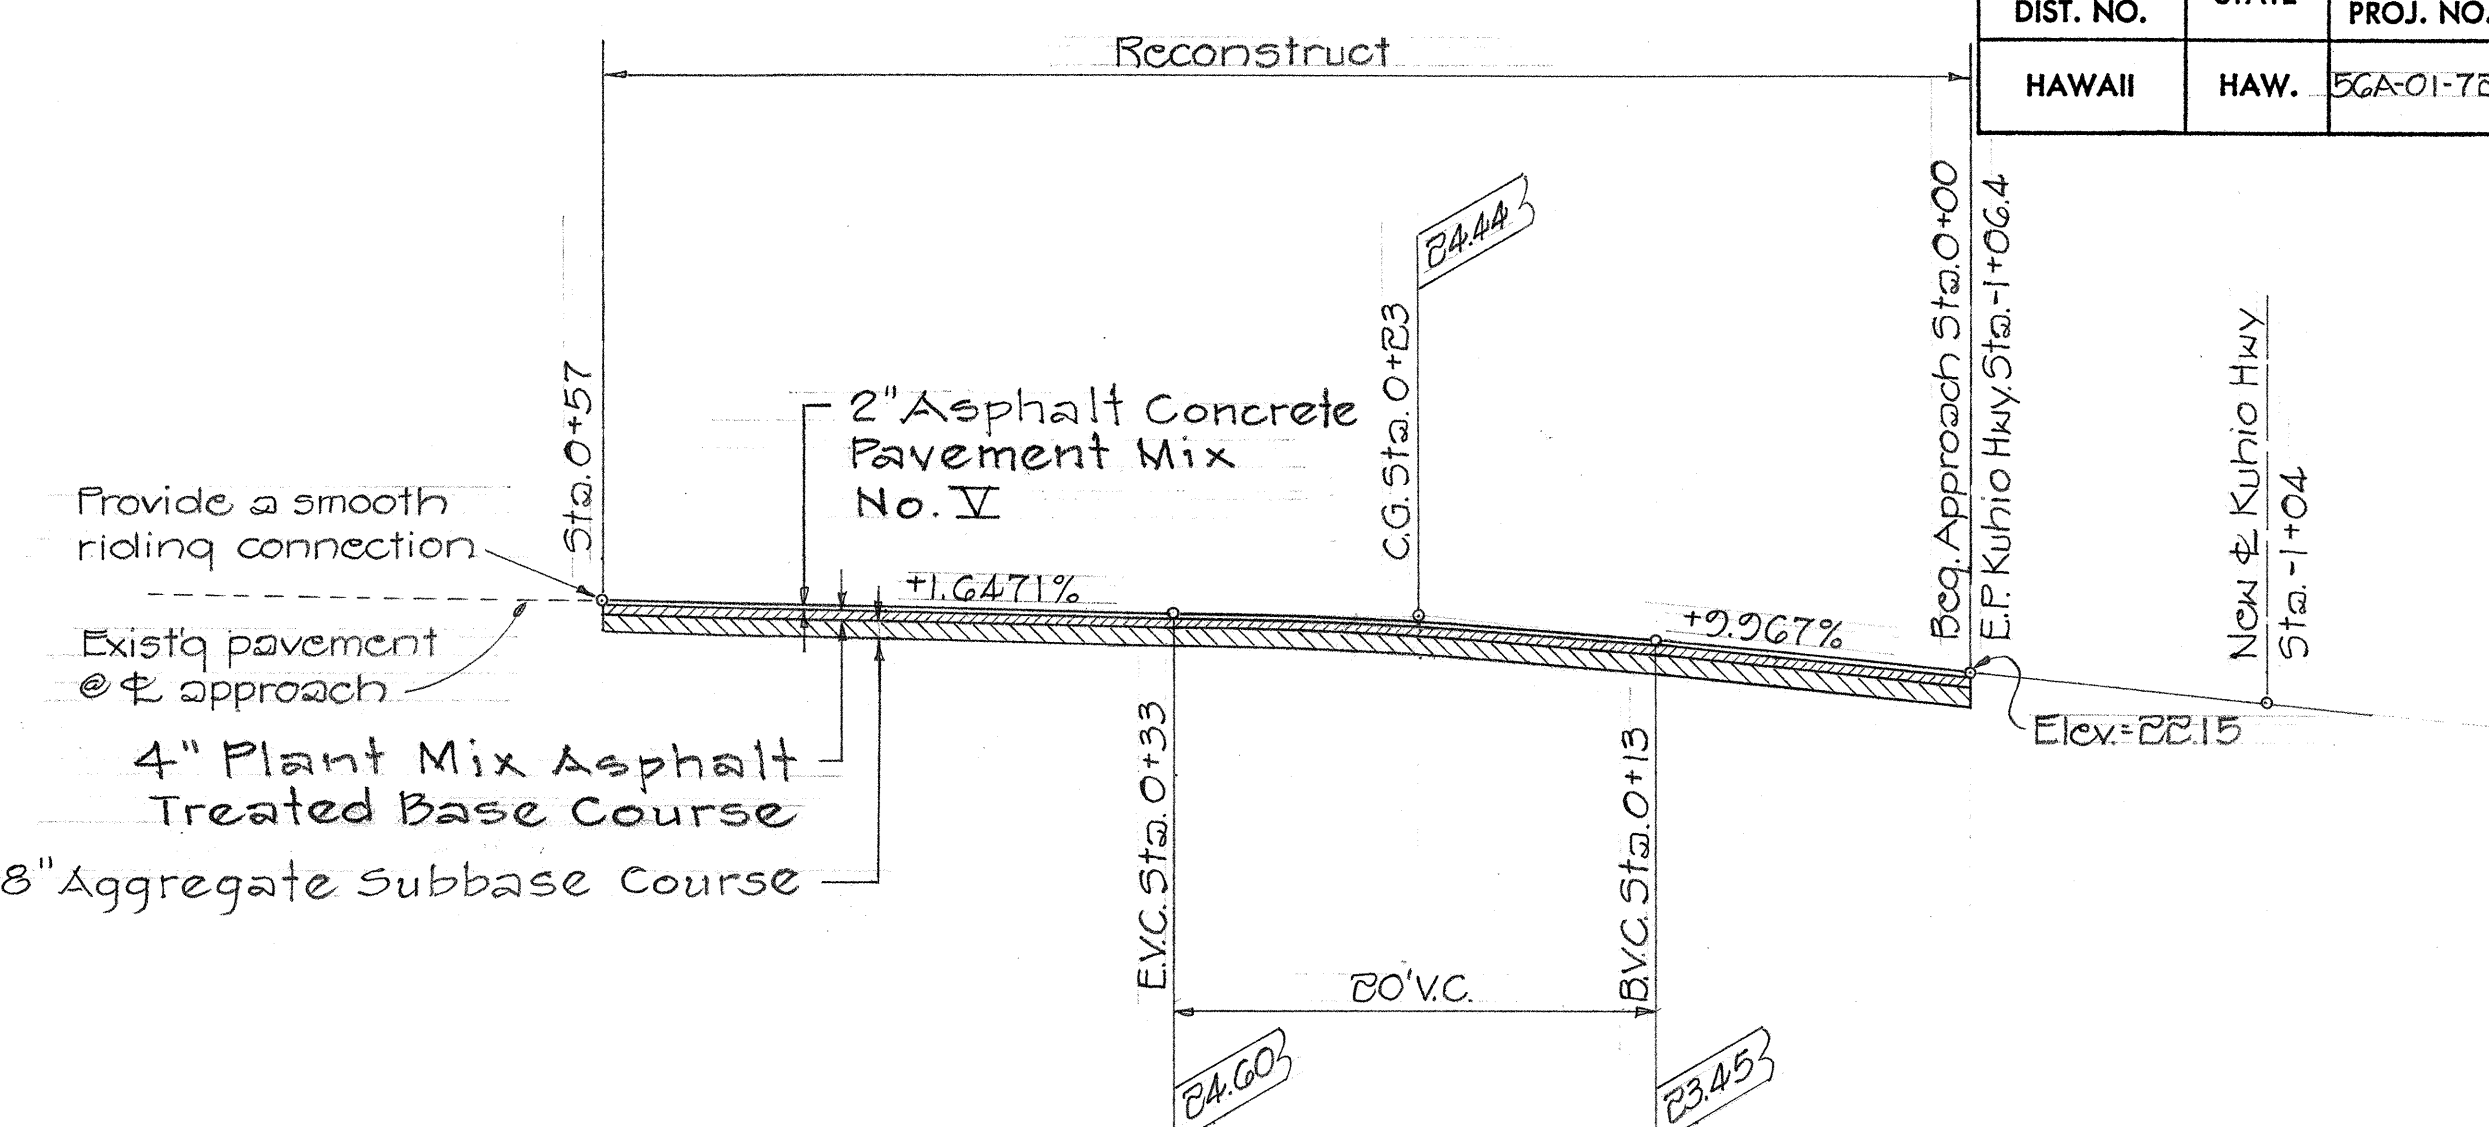

LONGITUDINAL SECTION FOR APPROACH @ STA. -1+04-LT.
Scale: 1/8" = 1'-0"

DESIGNED BY	DATE
DRAWN BY	
CHECKED BY	
APPROVED BY	

STATE OF HAWAII DEPARTMENT OF TRANSPORTATION HIGHWAYS DIVISION KAUAI BELT ROAD, SAFETY IMPROVEMENTS VICINITY OF MAILIHUNA ROAD PROJ. No. 5GA-01-7B TYPICAL SECTIONS Scale: As shown Nov. 1975 SHEET No. 1 OF 1 SHEETS
--