

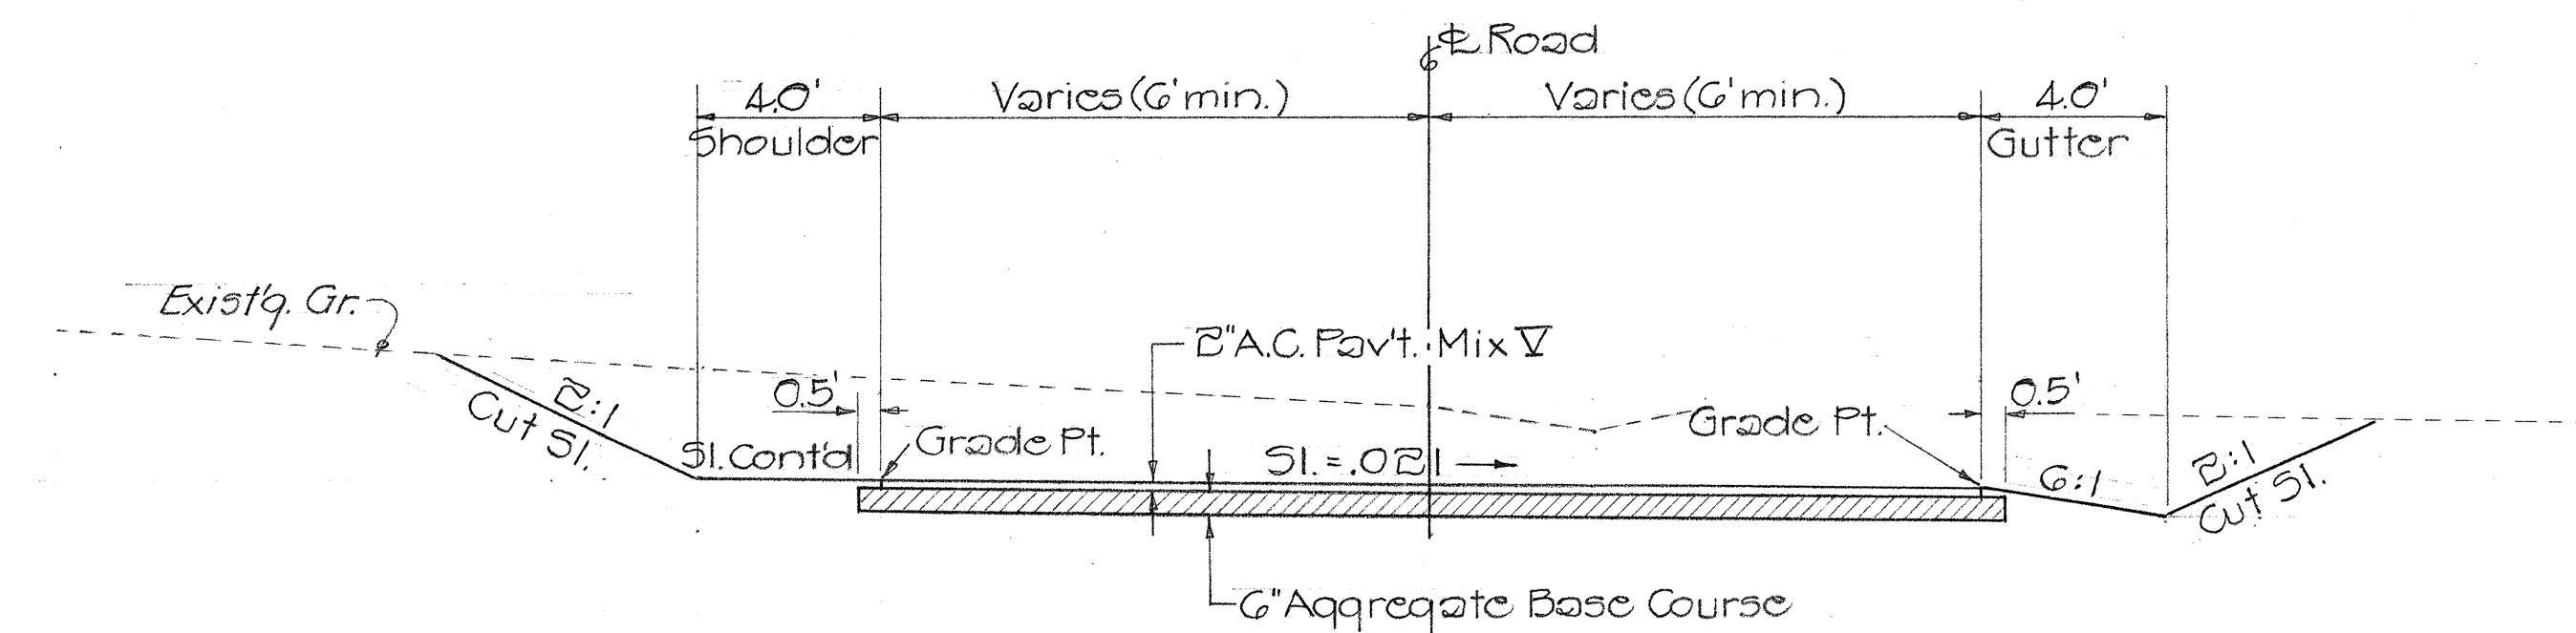
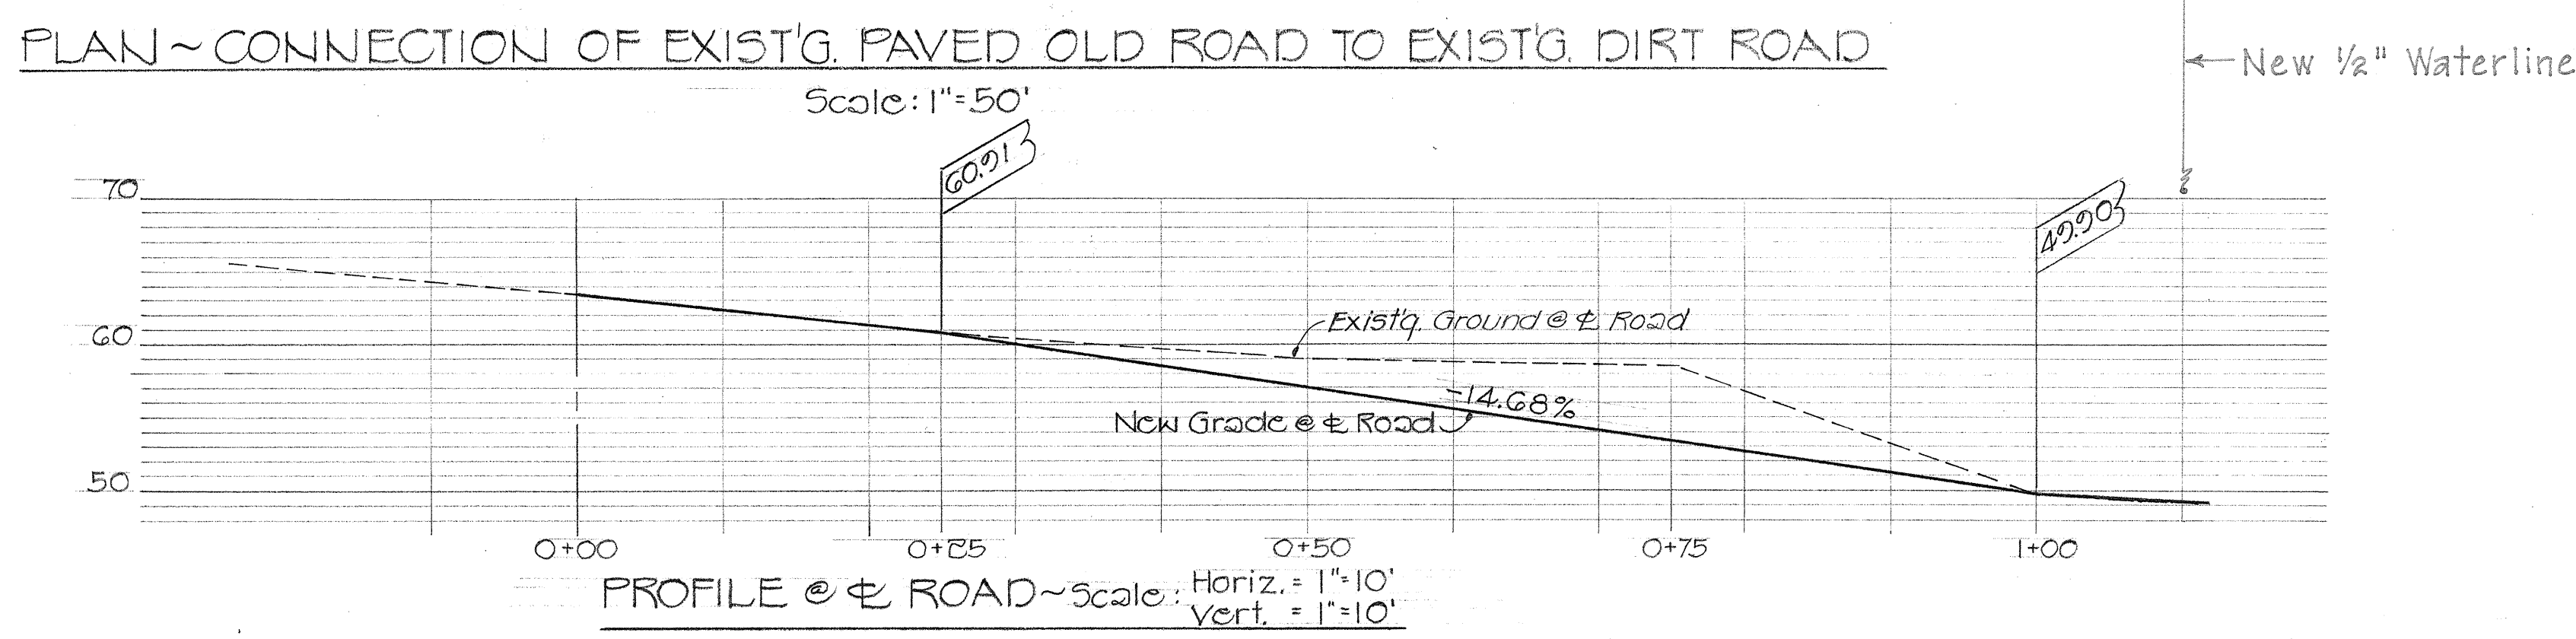


FED. ROAD DIST. NO.	STATE	FED. AID PROJ. NO.	FISCAL YEAR	SHEET NO.	TOTAL SHEETS
HAWAII	HAW.	HH-056-1(22)	1978	5	18

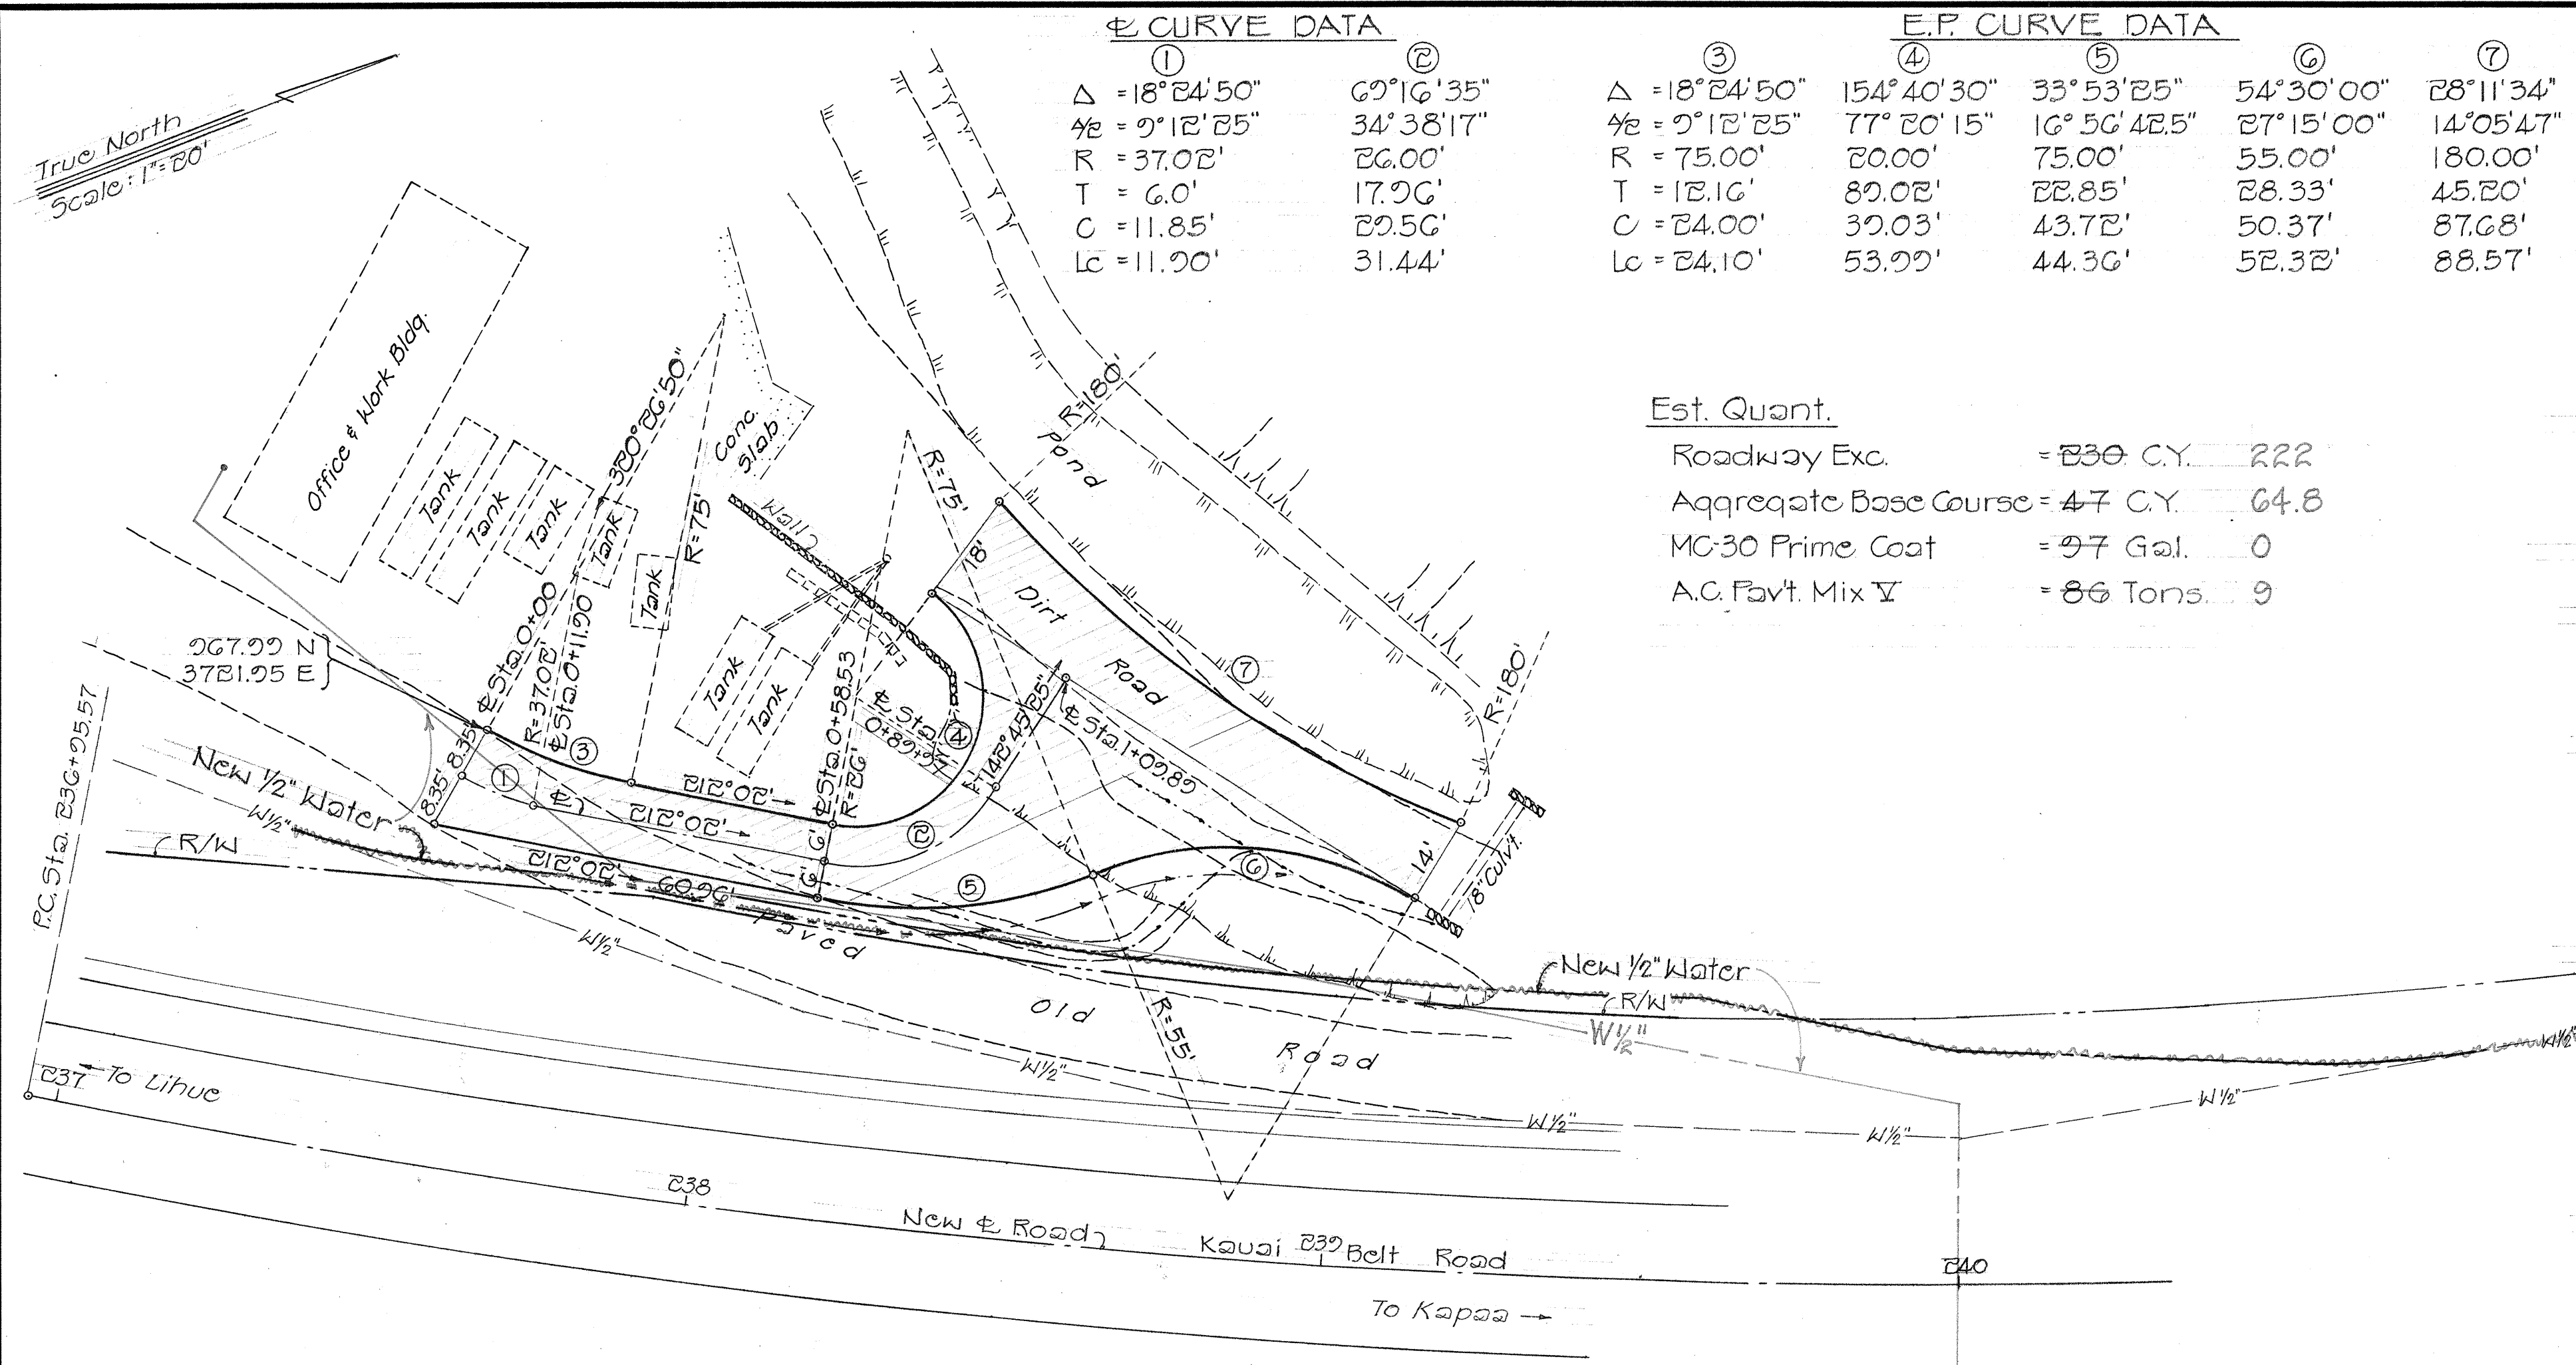

Est. Quant.

Roadway Exc.	= 230 C.Y.	222
Aggregate Base Course	= 47 C.Y.	64.8
MC-30 Prime Coat	= 97 Gal.	0
A.C. Pavt. Mix V	= 86 Tons.	9

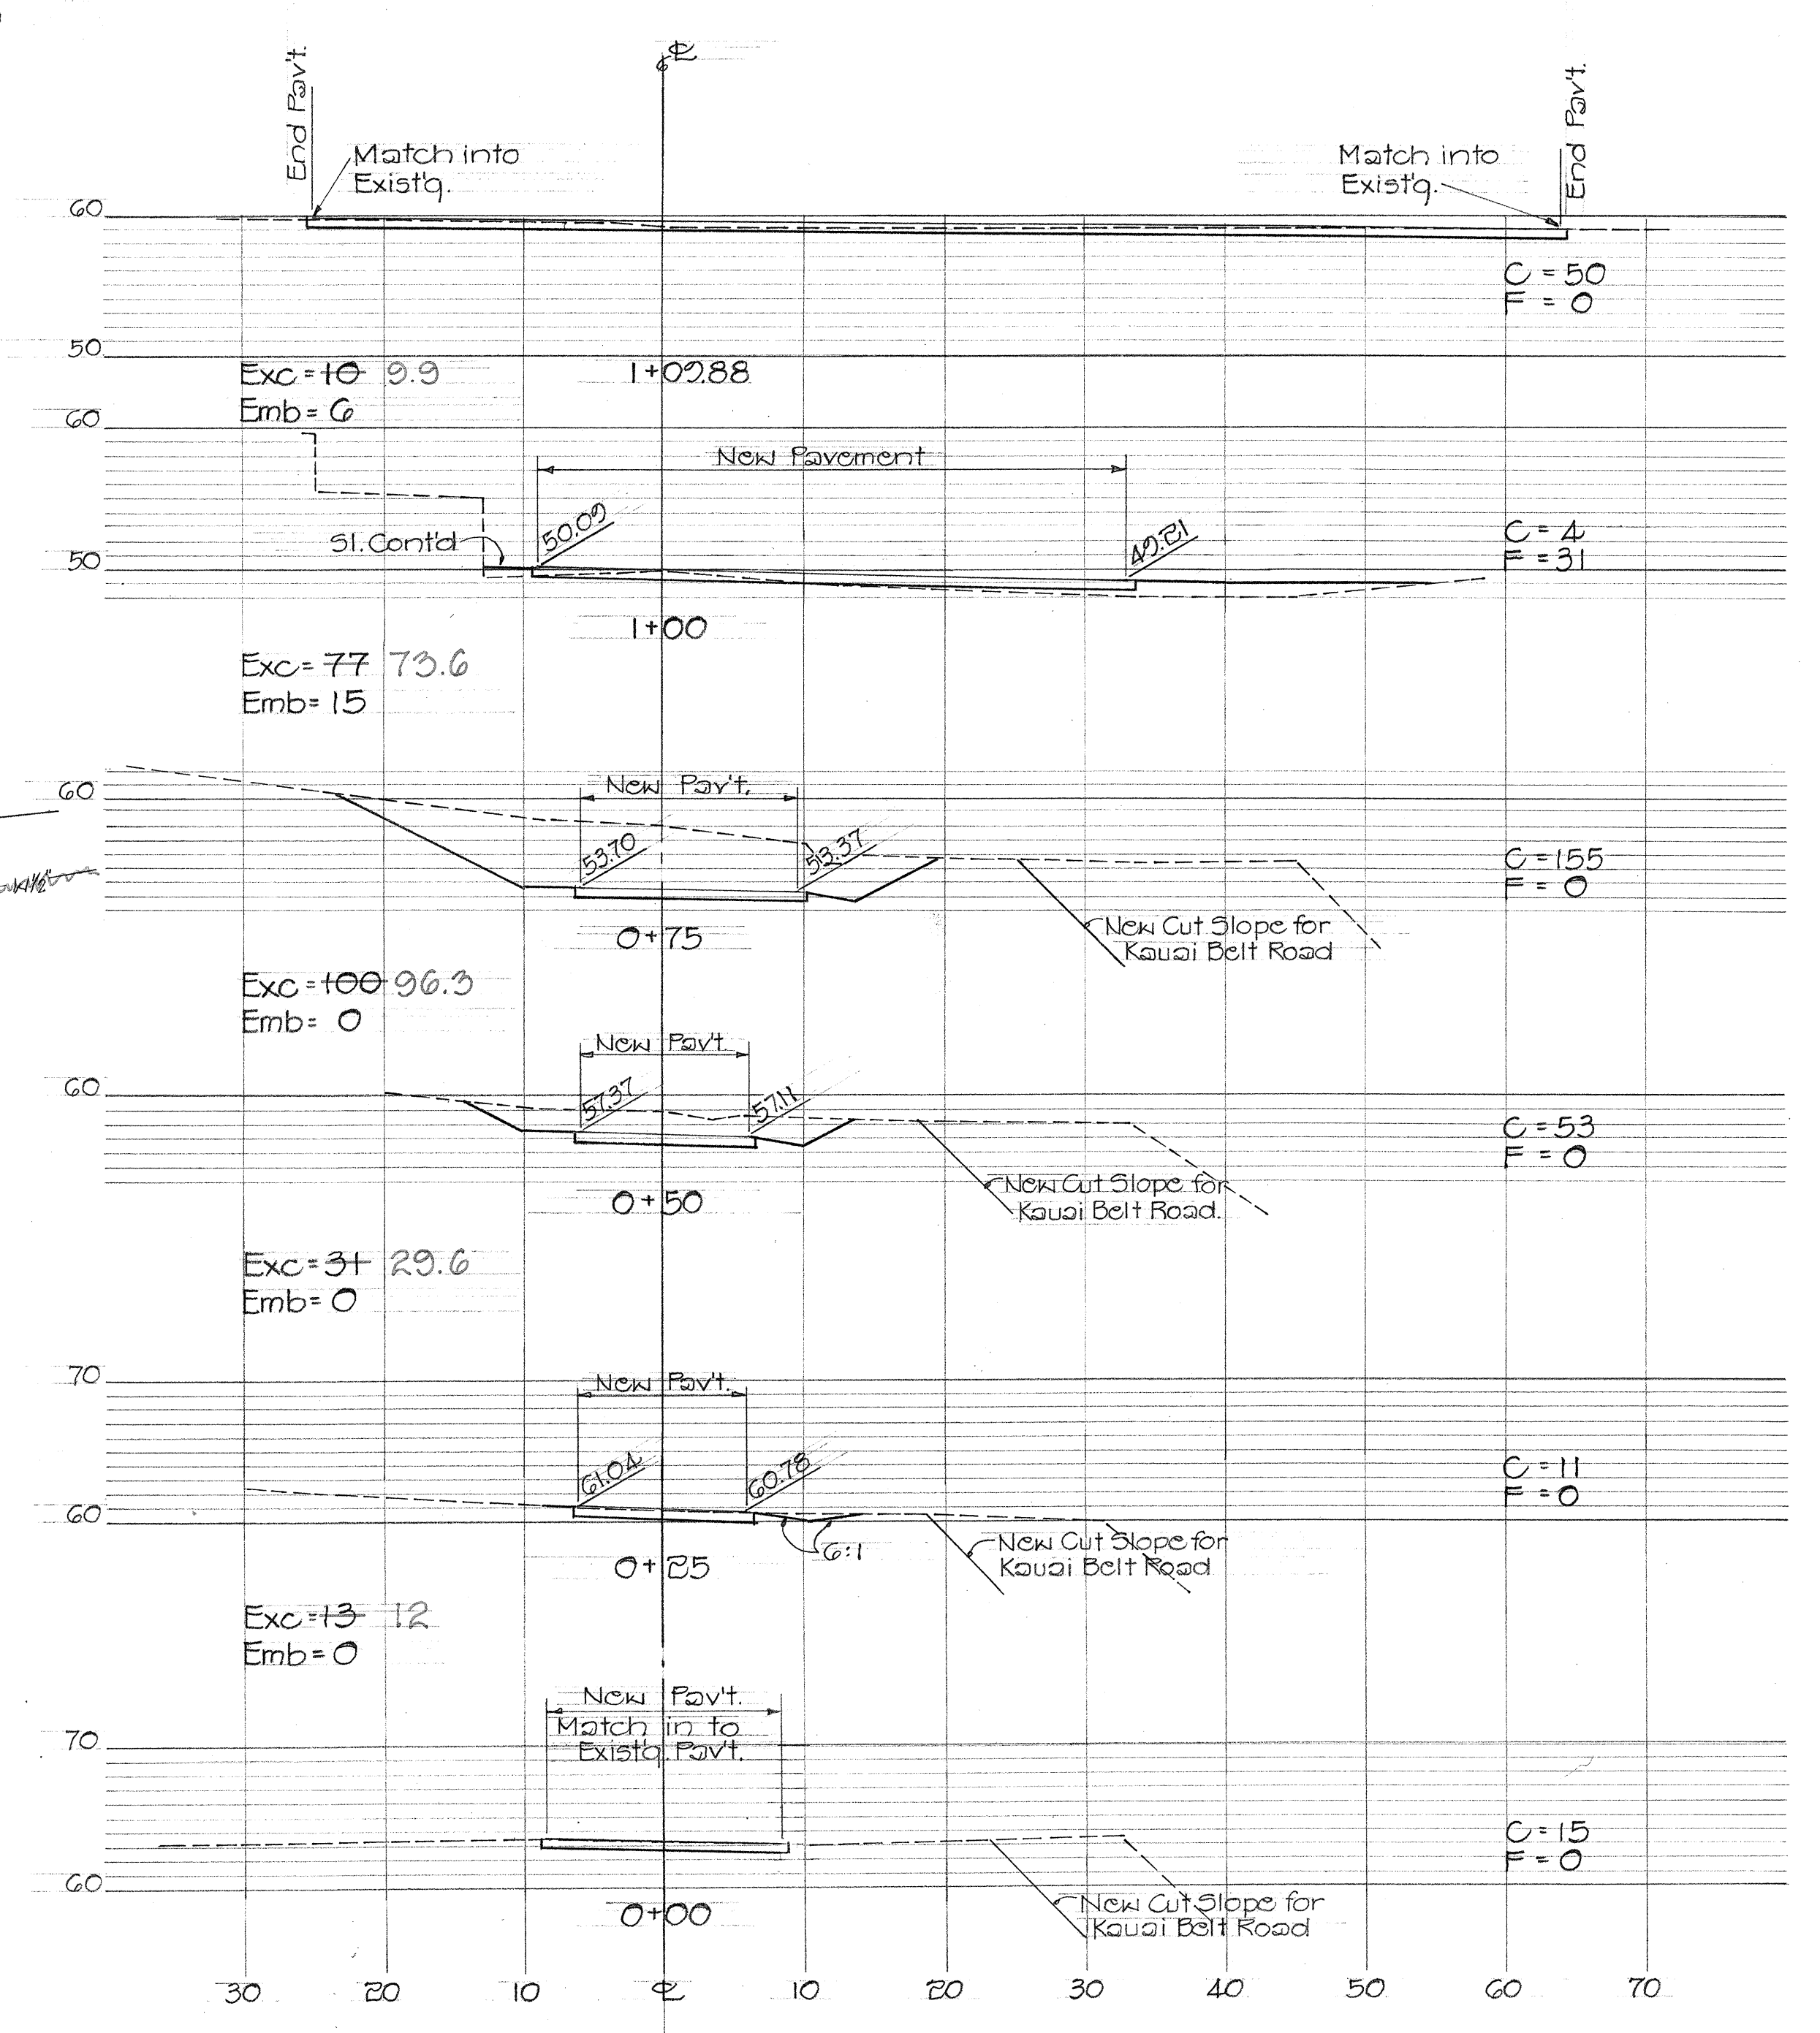

DATE	_____
SURVEY PLOTTED BY	_____
DRAWN BY	_____
DESIGNED BY	_____
QUANTITIES BY	_____
CHECKED BY	_____
ORIGINAL PLAN	_____
NOTE BOOK	_____
No.	_____

APPROVED: _____

W. J. Belkwin 10/6/76

LIHUE PLANTATION CO. LTD. DATE

STATE OF HAWAII
DEPARTMENT OF TRANSPORTATION
LAND TRANSPORTATION FACILITIES DIVISION
KAUAI BELT ROAD SAFETY IMPROVEMENTS
VICINITY OF KAUAI HARDWOODS

PROJ. No. HH-056-1(22)

PLAN & PROFILE, TYP. SECTION & X-SECTIONS
CONNECTION OF EXIST'G. PAVED
OLD ROAD TO EXIST'G. DIRT ROAD

Scale: As shown Nov. 1975

SHEET No. 1 OF 1 SHEETS