



DIST. NO.	STATE	PROJ. NO.	FISCAL YEAR	SHEET NO.	TOTAL SHEETS
HAWAII	HAW.	56A-01-80	1980	6	23

SUMMARY OF PAVEMENT MARKINGS							
Location	Pav't. Arrow, Ea.	Striping, L.F.		Raised Markers, Ea.			
		Yellow	White	Type "C"	Type "D"	Type "H"	Type "J"
Road E.		850	680		28	+0.14	56.00
Paved Island		1813	248	10.13	4.8	75	
Storage Lane		288	588	5.7	9		
Edge of Pavement			4188				
Approach		195	155		7		
Total		3218	5080	15.20	4+52	85.70	56

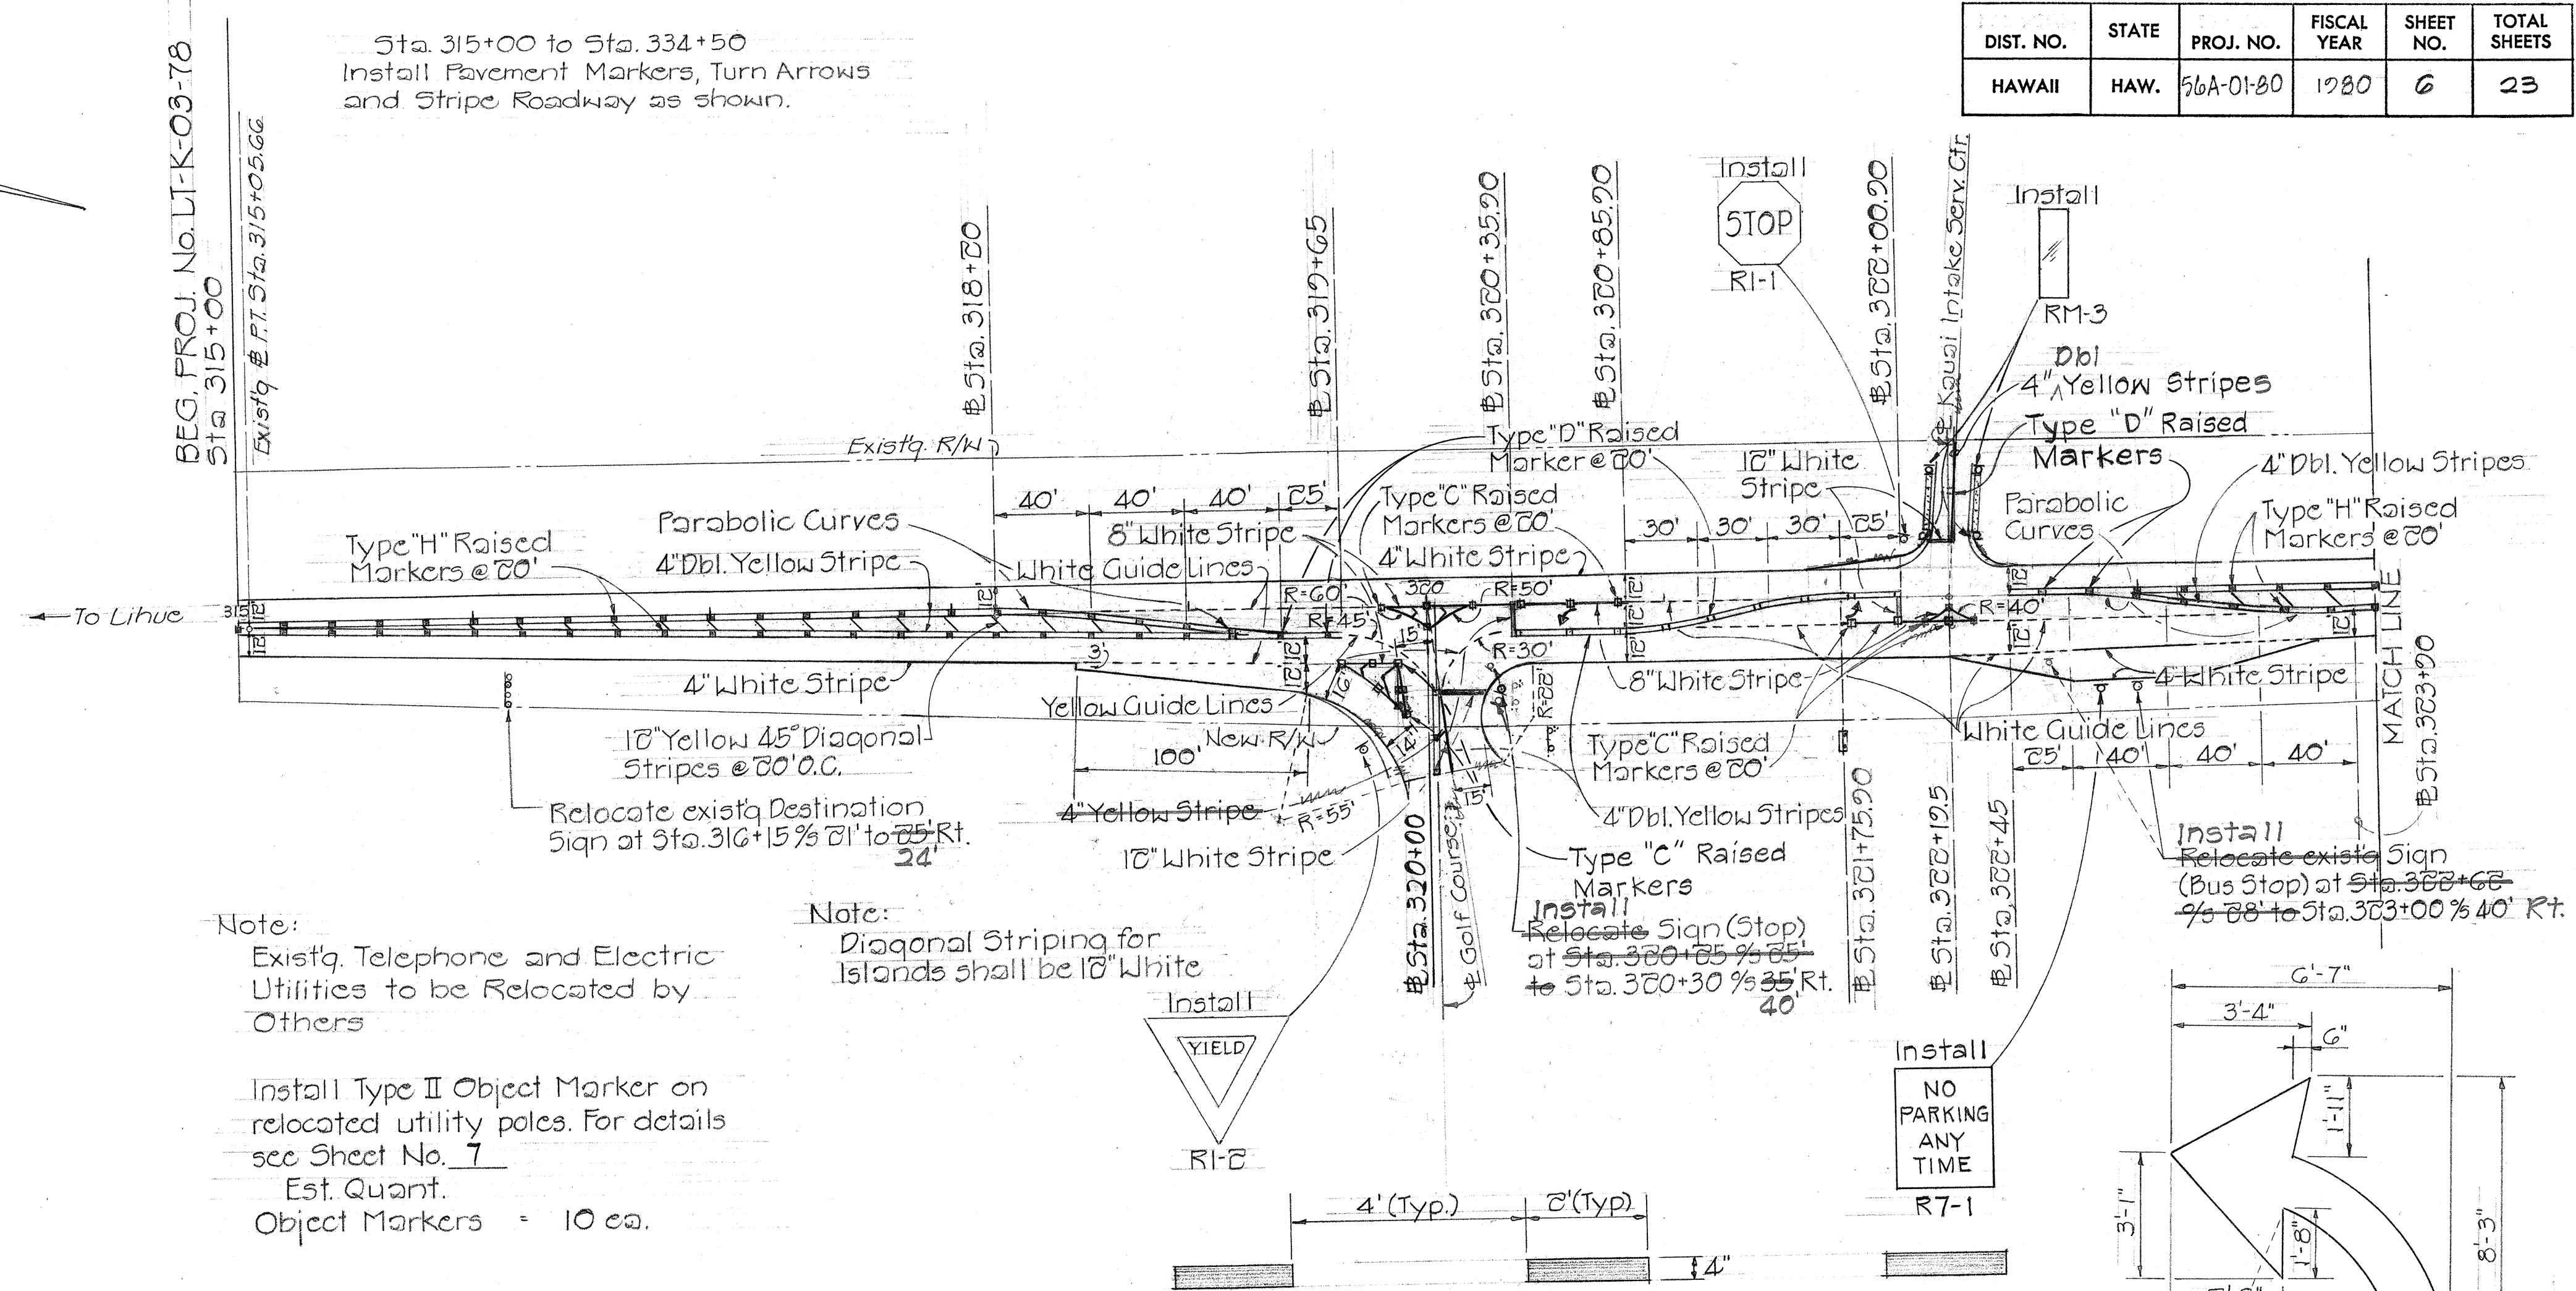

True North
Scale: 1"=50'

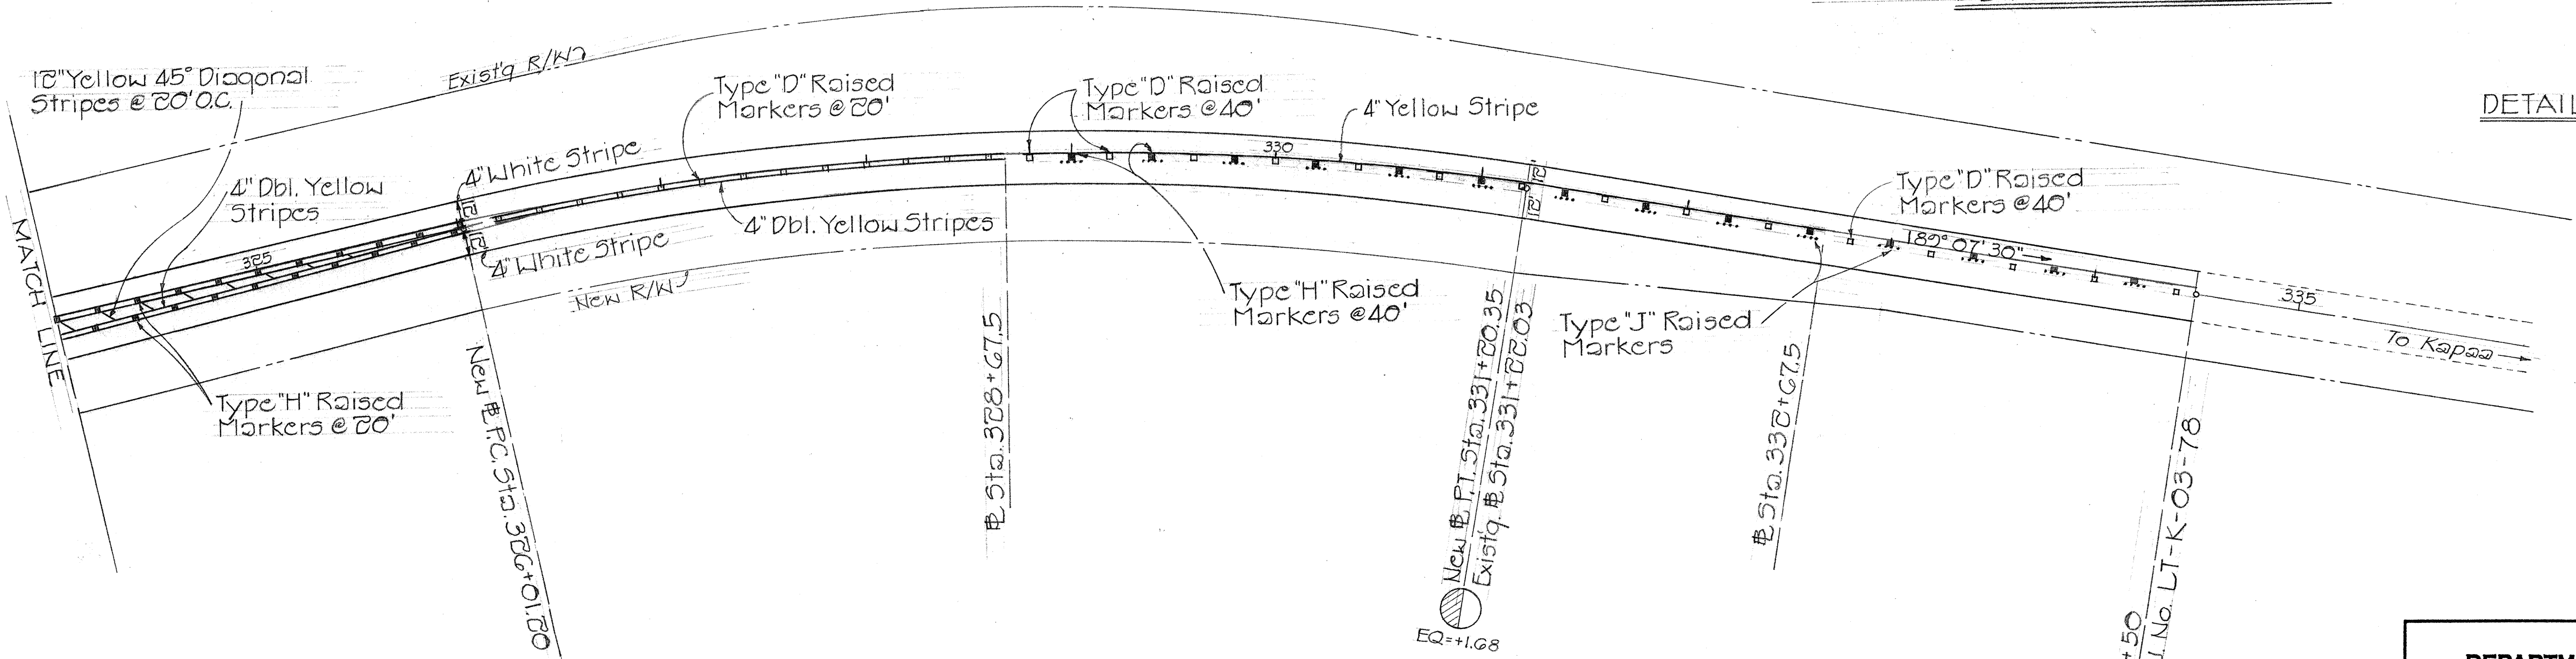

ORIGINAL PLAN	DATE
SURVEY PLOTTED BY	
DRAWN BY	
TRACED BY	
NOTED BY	
CHECKED BY	
NO.	

STATE OF HAWAII
DEPARTMENT OF TRANSPORTATION
HIGHWAYS DIVISION

KAUAI BELT ROAD- SAFETY IMPROVEMENT,
VICINITY OF WAILUA GOLF COURSE

PROJ. NO. 56A-01-80

PLAN-PAVEMENT MARKERS & STRIPING

Scale: As shown July 1978

SHEET No. 1 OF 1 SHEETS