


DIST. NO.	STATE	PROJ. NO.	FISCAL YEAR	SHEET NO.	TOTAL SHEETS
HAWAII	HAW.	56A-01-80	1980	5	23

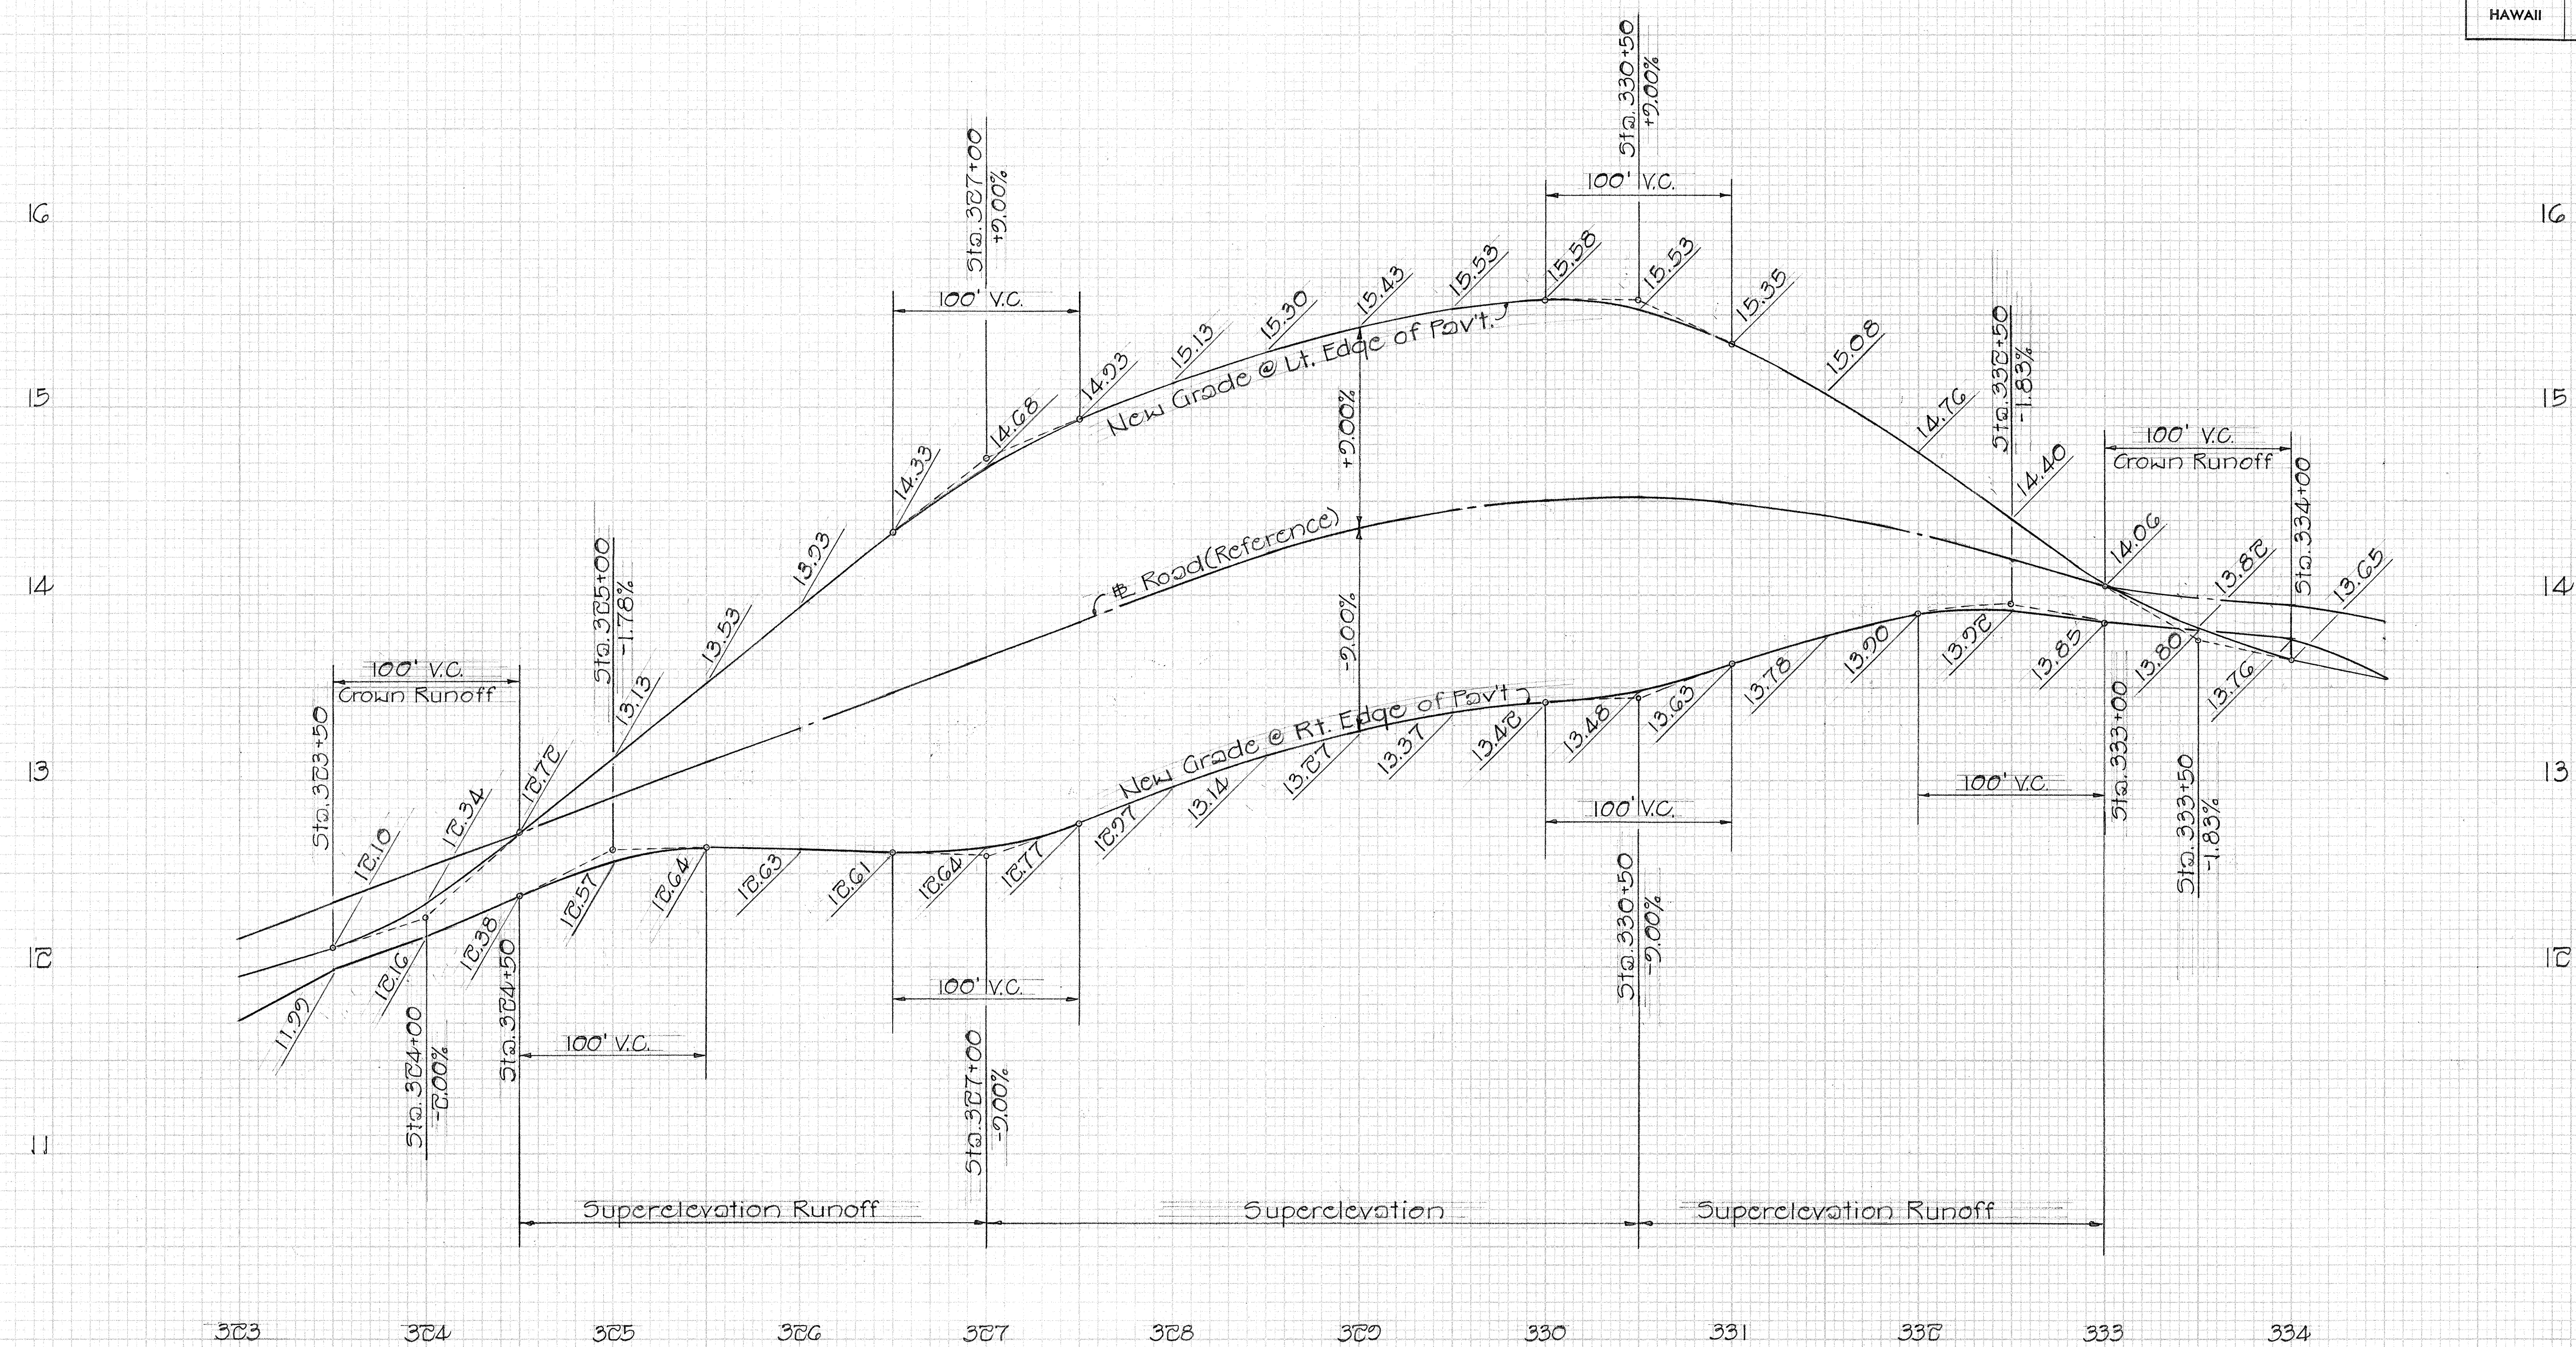

PROFILE
SUPERELEVATION OF LEFT & RIGHT EDGE OF PAYEMENT
STA. 323+50 to STA. 334+00
 Scale: Horiz = 1" = 50'
 Vert = 1" = 0.5'

FINAL SURVEY	SURVEYED	DATE
NOTE BOOK	PLOTTED	BY
AREAS	CHECKED	NO.

ORIGINAL SURVEY	SURVEYED	DATE
NOTE BOOK	PLOTTED	BY
AREAS	CHECKED	NO.