
	INDEX TO DRAWINGS
SHEET NO.	DESCRIPTION
	TITLE SHEET
2	TYPICAL SECTIONS
3-4	PLAN & PROFILE
5	PROFILE - SUPERELEVATION
	STA.323+50 TO 334+00
6*	PLAN-PAVEMENT MARKERS
	& STRIPINGS
7-21	TYPICAL & STANDARD DETAILS
22 - 23	CROSS SECTIONS
[2] 아이 아이나 아이랑 아이를 수 있다.	그래부의 하고 아름다고 하게 있다. 종독하는 경로 받는 식탁하는 이번 경화하고 있다고 있다고 있다고 하는 이번 하는 것이 된다. 그리는 것이



548-7537 PHONE

KAUAI DISTRICT DESIGNED BY

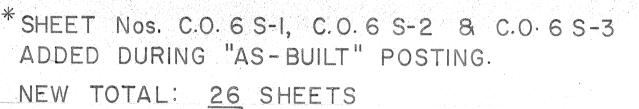

STATE OF HAWAII


DEPARTMENT OF TRANSPORTATION
INCHIGHWAYS DIVISION

"AS-BUILT"

PLANS FOR


## KAUAI BELT ROAD - SAFETY IMPROVEMENT, VICINITY OF WAILUA GOLF COURSE


PROJECT NO. 56A-01-80
DISTRICT OF LIHUE
ISLAND OF KAUAI

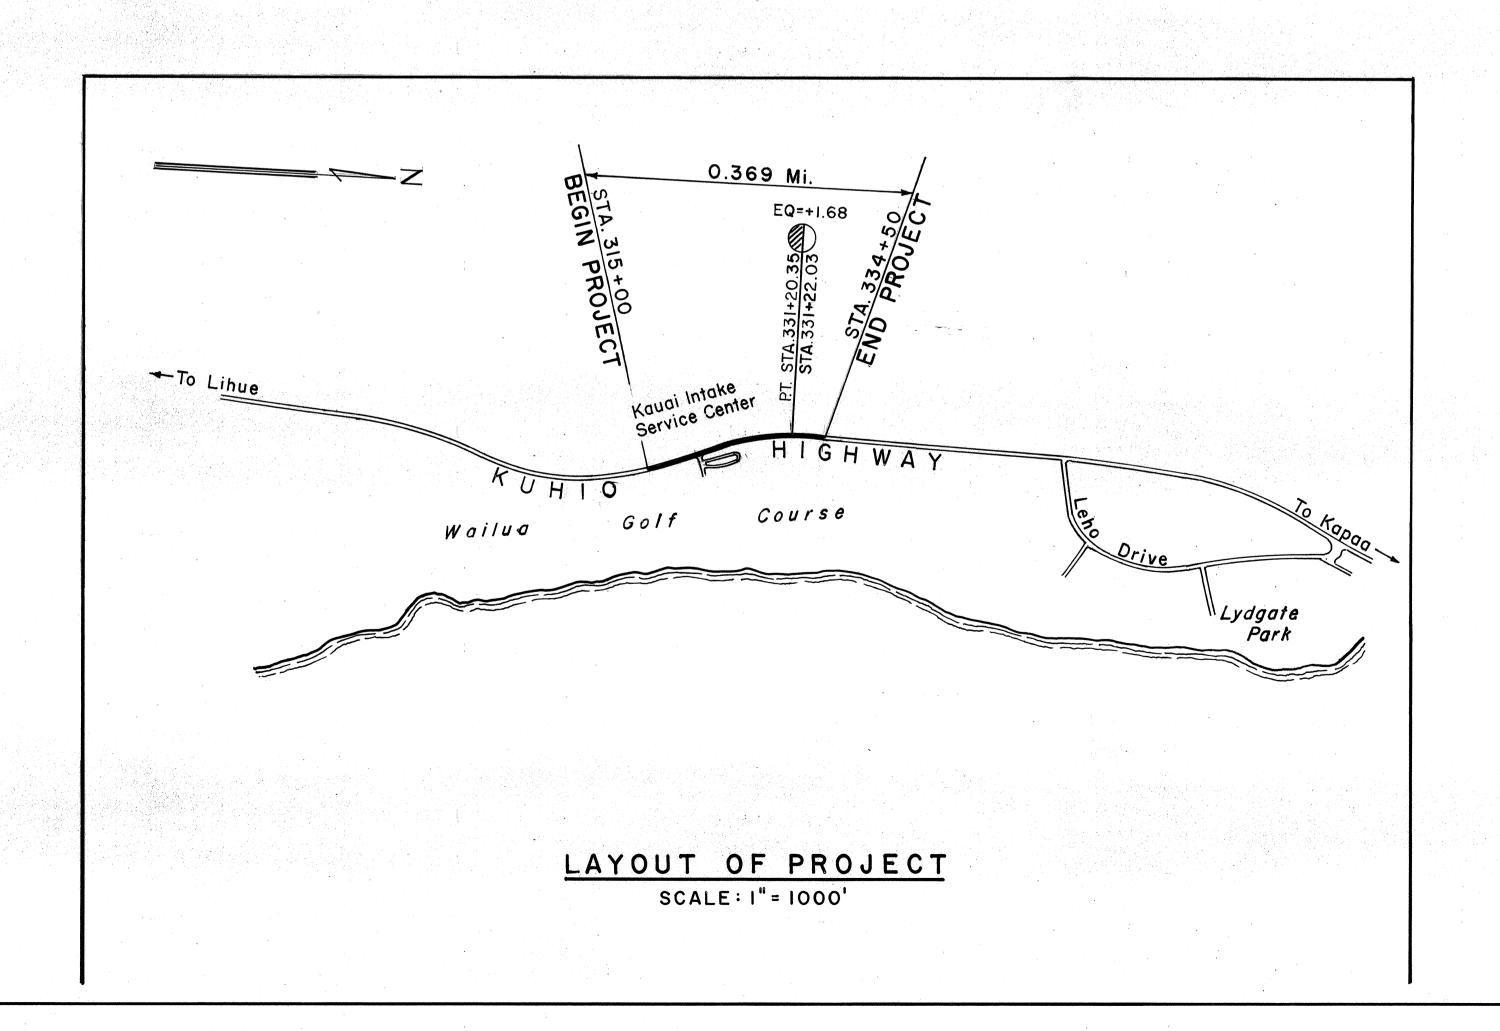


FED. ROAD DIST. NO. STATE PROJ. NO. FISCAL SHEET TOTAL SHEETS

HAWAII HAW. 56A-01-80 1980 / 23

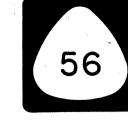

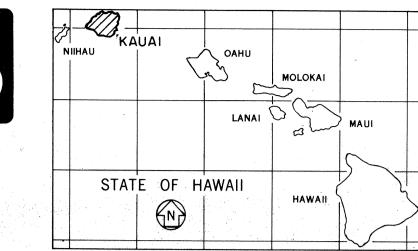

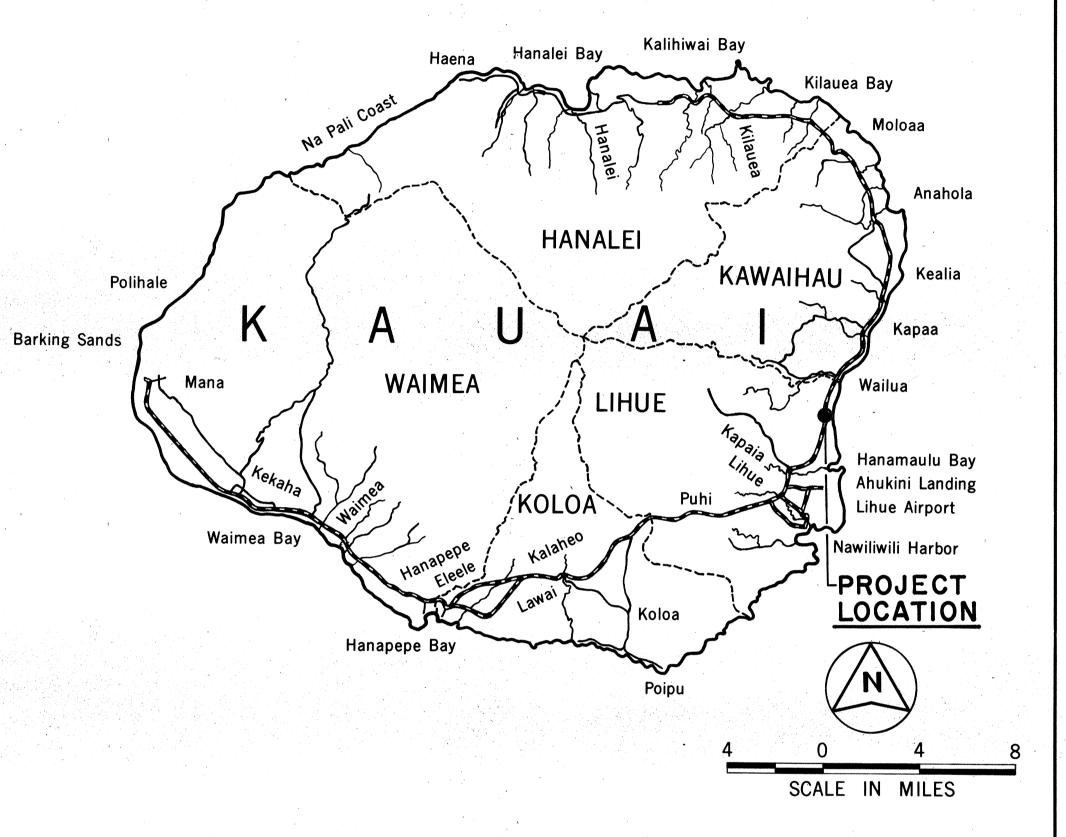

FEDERAL AID PROJECTS PREVIOUSLY CONSTRUCTED
OR UNDER CONSTRUCTION

ALL CHANGES MADE DURING CONSTRUCTION HAVE BEEN INCORPORATED ON THESE PLANS IN RED EXCEPT CHANGES IN THE ORIGINAL THEORETICAL QUANTITIES. FOR ACTUAL QUANTITIES, REFER TO PROJECT LEDGER AND/OR COMPUTATION BOOK.

RESIDENT ENGINEER

8-27-81 DATE

	DEPARTMENT OF TRANSPORTATION STATE OF HAWAII		
	APPROVED:		
(	James R. Carras	5/27/80	
	DIR. OF TRANSPORTATION	DATE.	