




FED. ROAD DIST. NO.	STATE	PROJ. NO.	FISCAL YEAR	SHEET NO.	TOTAL SHEETS
HAWAII	HAW.	HWY-K-01-81M	1980	2	3

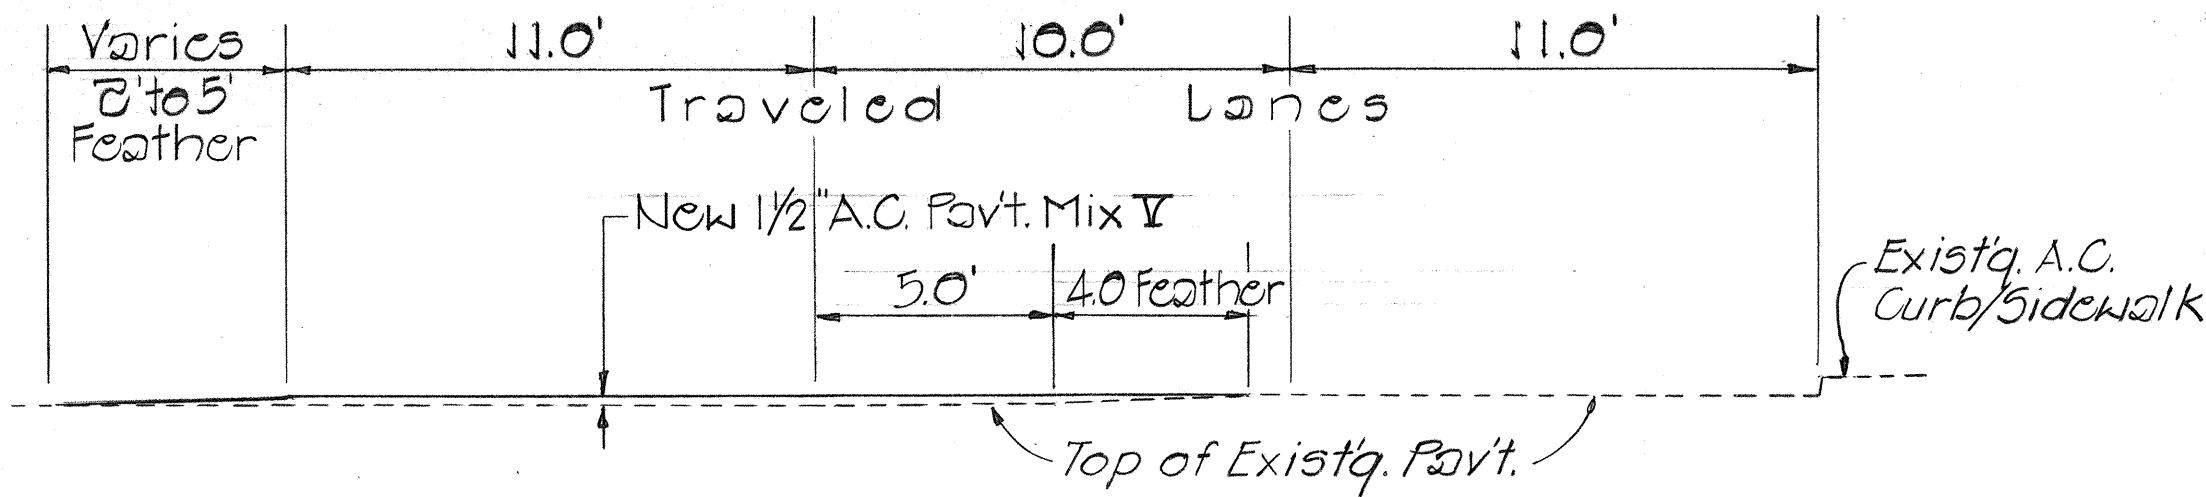


TYPICAL SECTION ①
(STA. 138+25 TO STA. 147+75)

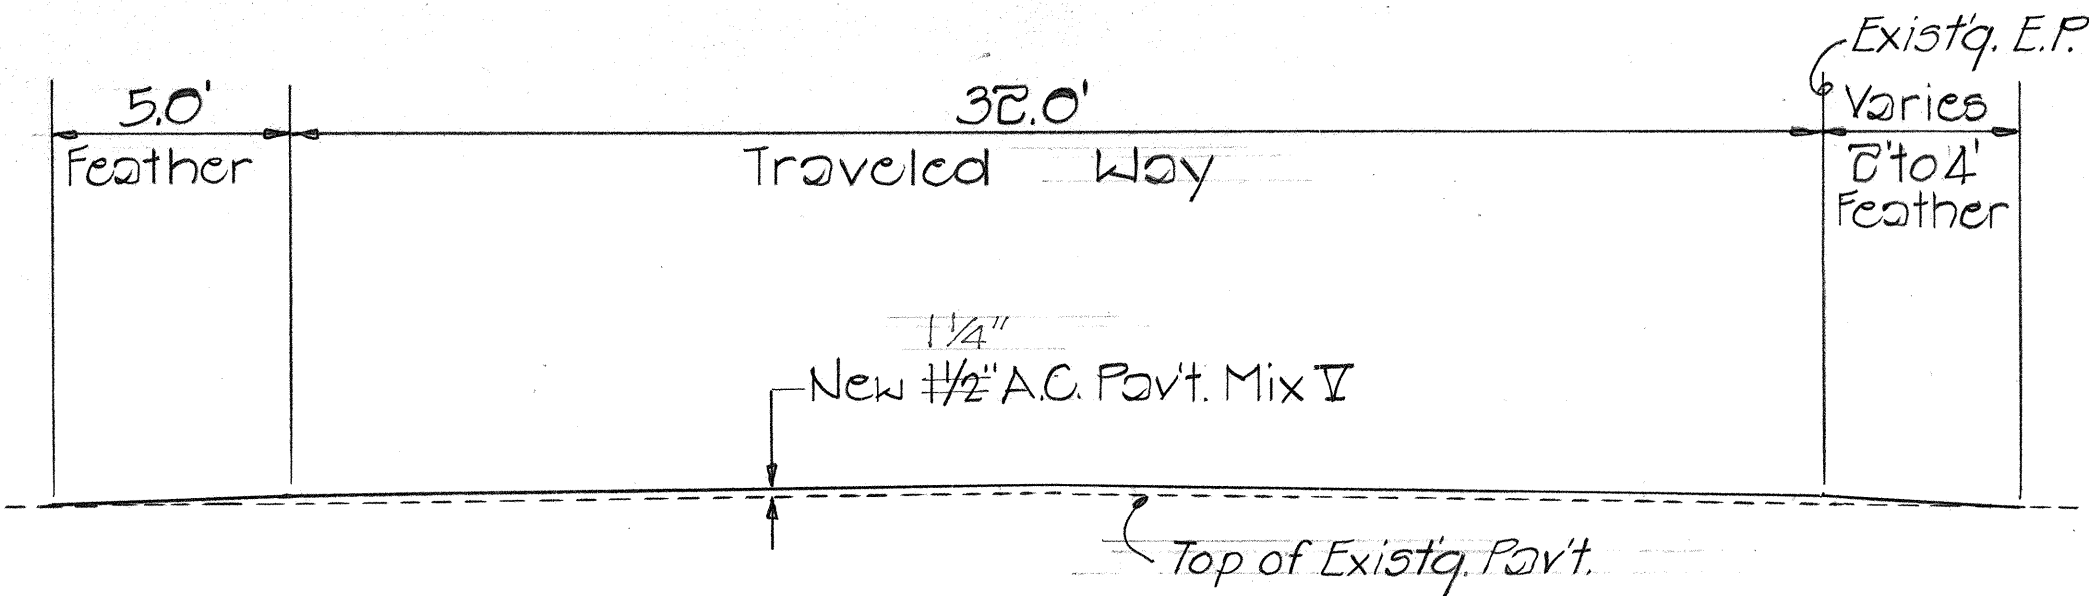


TYPICAL SECTION ②
(STA. 147+75 TO STA. 153+20)

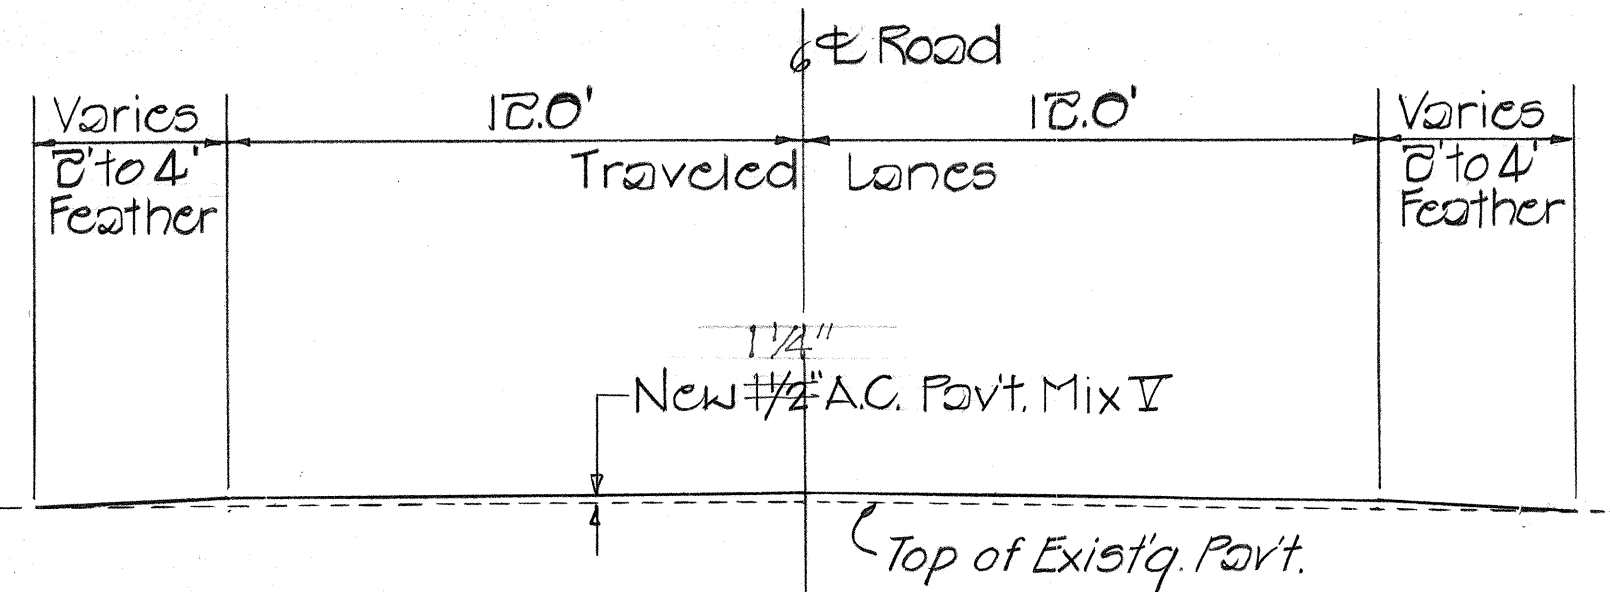


TYPICAL SECTION ③
(STA. 153+20 TO STA. 155+60)
(STA. 157+15 TO STA. 159+60)

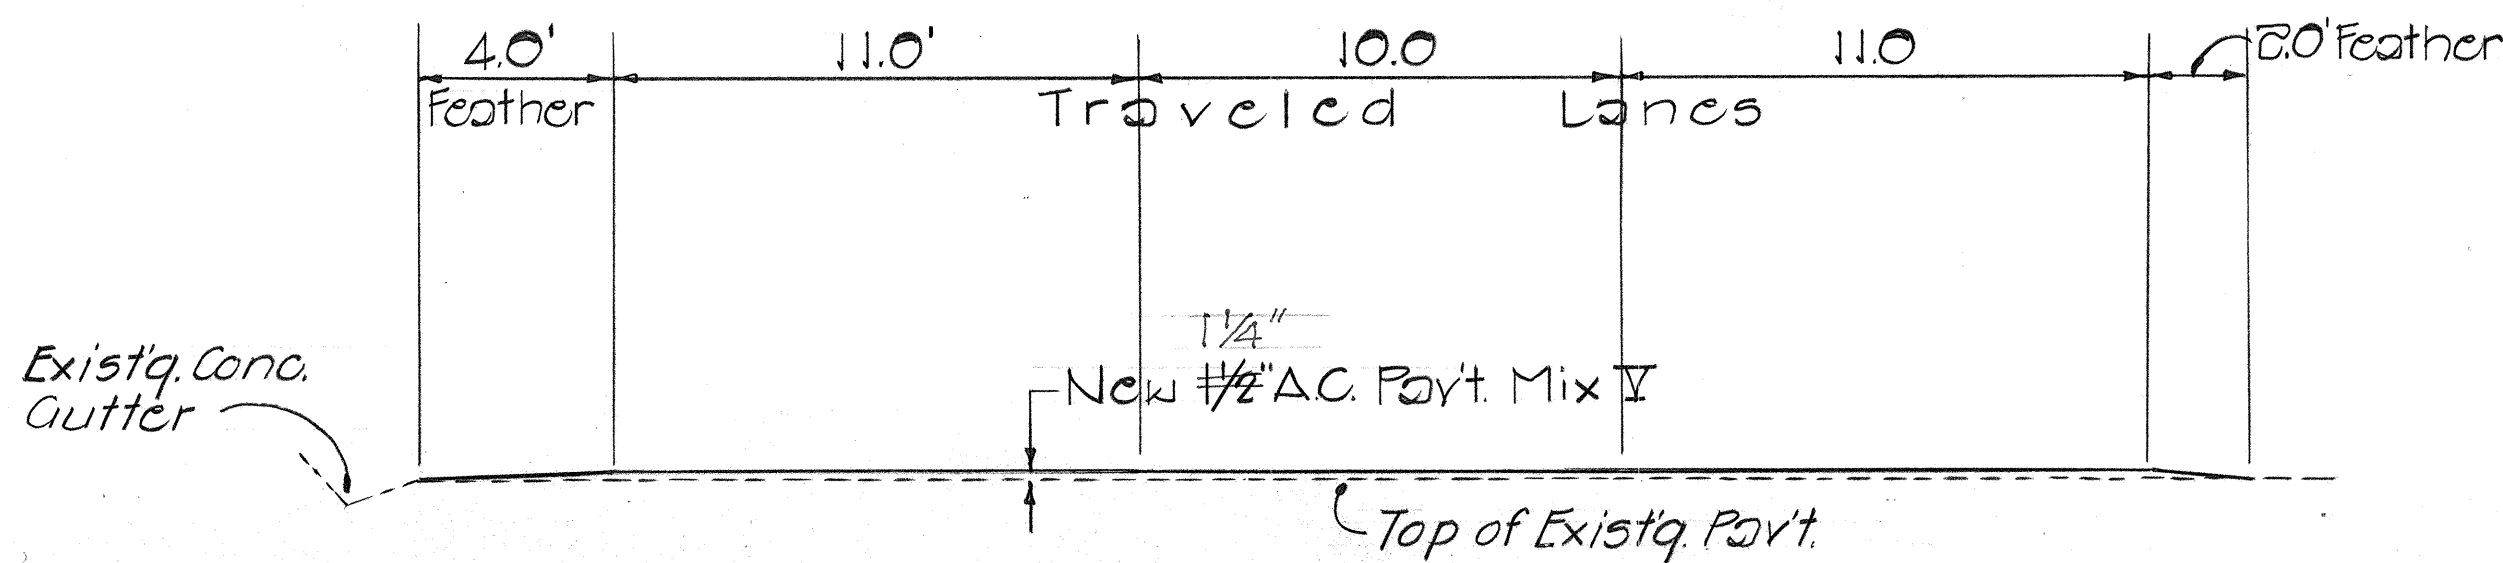


TYPICAL SECTION ④
(STA. 159+60 TO STA. 168+75)

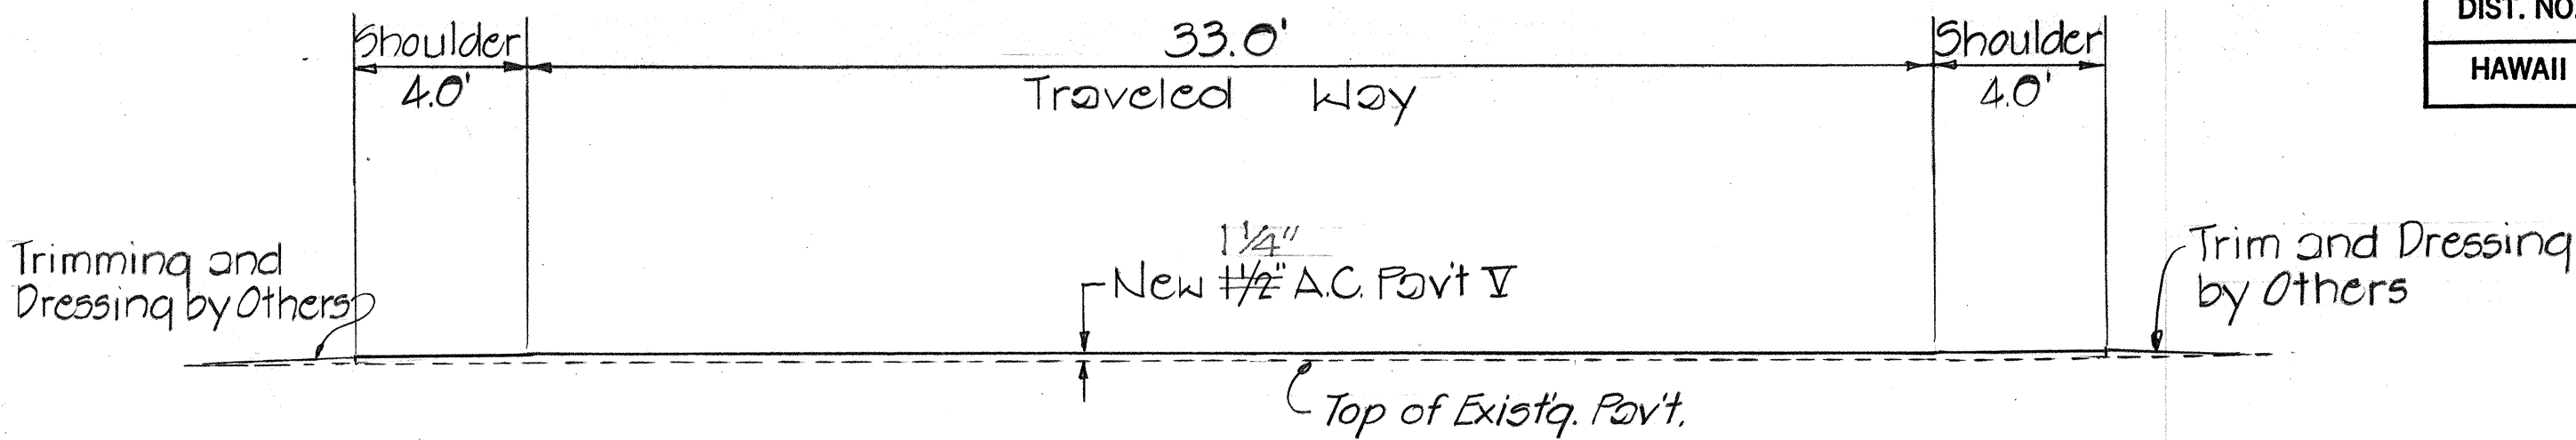


TYPICAL SECTION ⑤
(STA. 171+00 TO STA. 181+00)
179+94

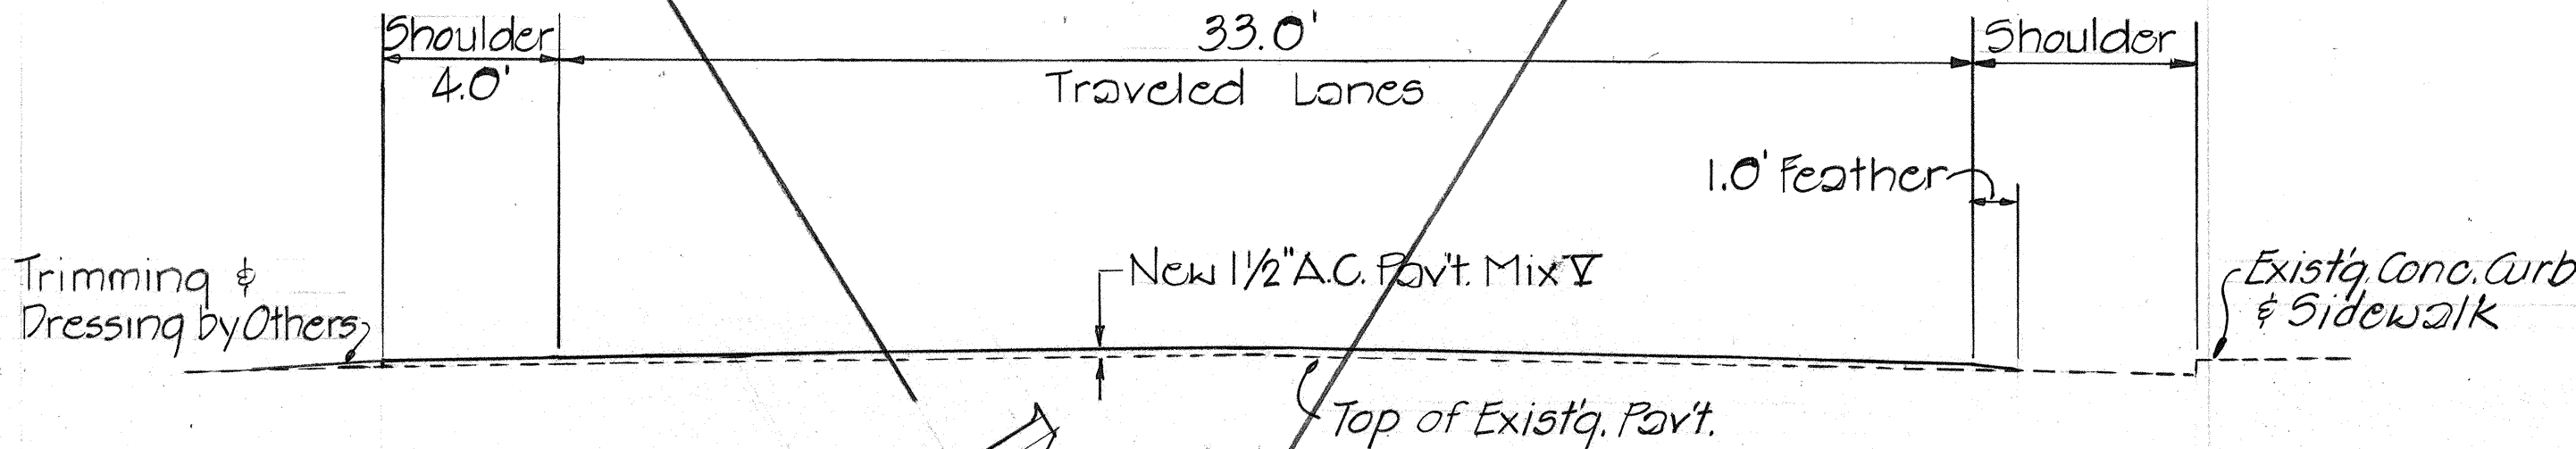

TYPICAL SECTION ⑥
(STA. 181+00 TO STA. 182+75)

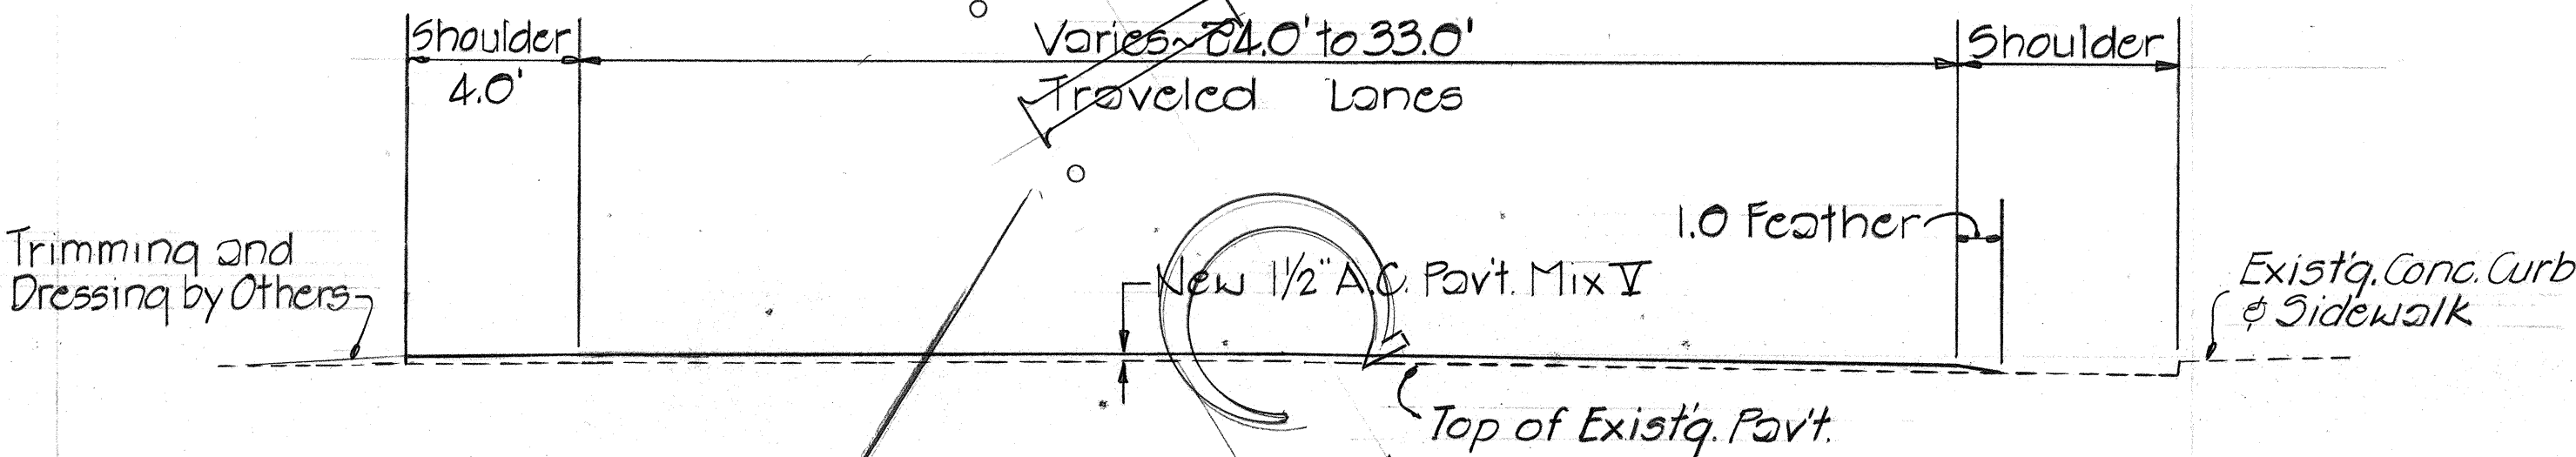

TYPICAL SECTION ⑦
(STA. 182+75 TO STA. 190+01.1)

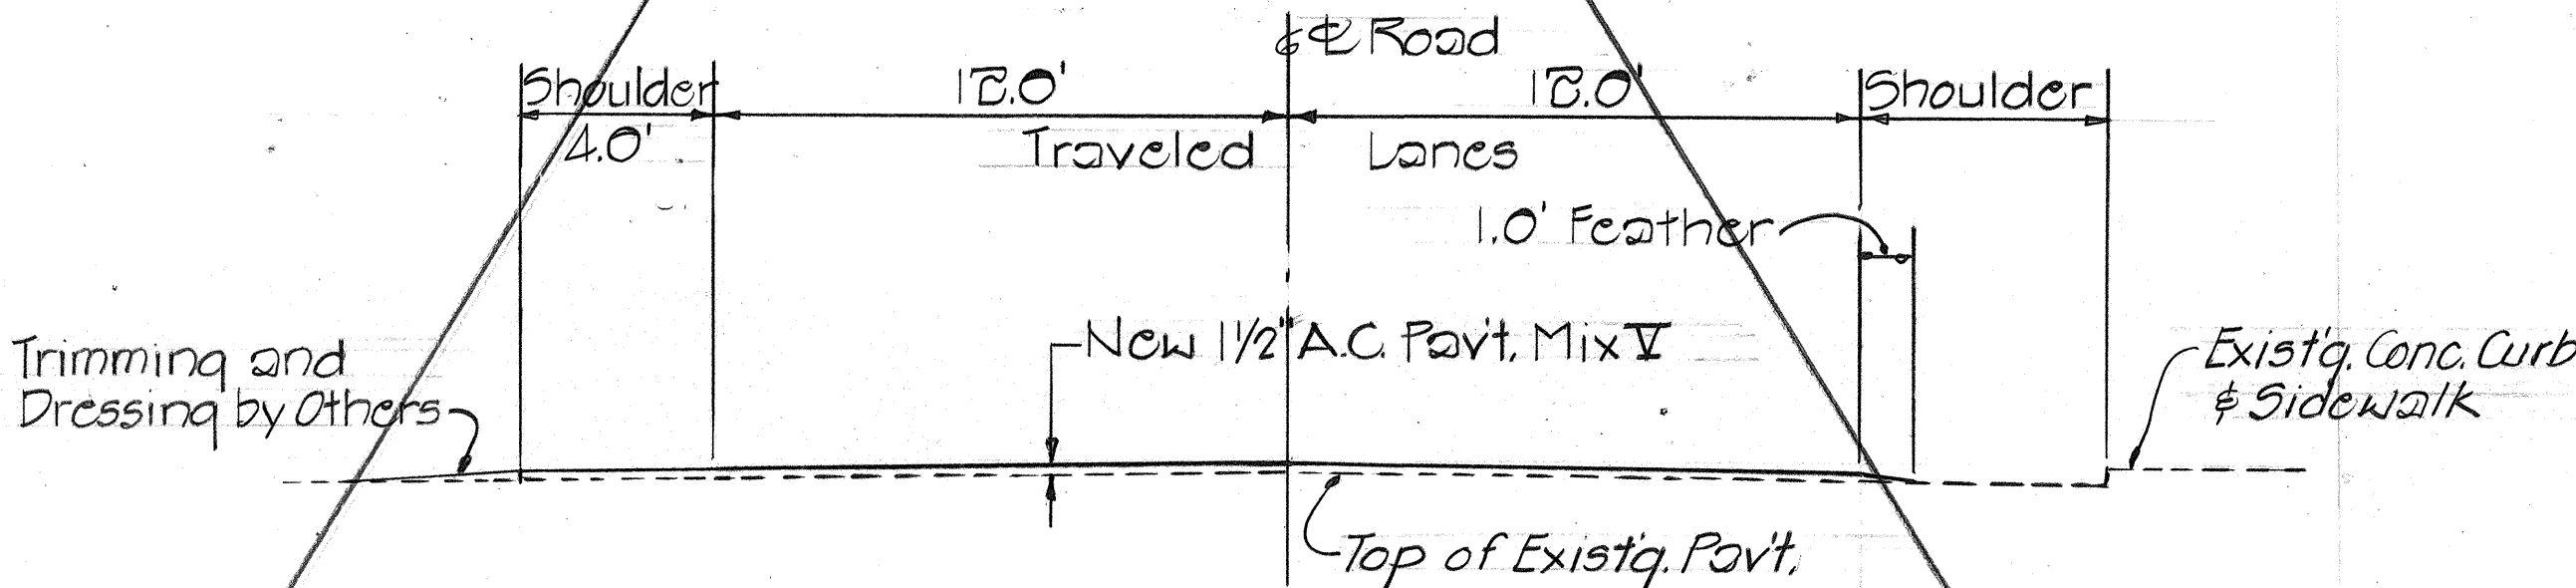

TYPICAL SECTION ⑧
(STA. 190+01.1 TO STA. 200+00)

STATE OF HAWAII

DEPARTMENT OF TRANSPORTATION

HIGHWAYS DIVISION

HIGHWAY RESURFACING AT KAPAIA AND HANAMAULU

PROJ. No. HWY-K-01-81M

TYPICAL SECTIONS

Scale: 1/4"=1'-0"

AUG. 1980

SHEET NO. 2 OF 3 SHEETS

2

DATE	
SURVEY PLOTTED BY	
DRAWN BY	
TRACED BY	
DESIGNED BY	
QUANTITIES BY	
CHECKED BY	
ORIGINAL PLAN	
NOTE BOOK	
No.	

0-0-5 6823-2122