	INDEX TO DRAWINGS
SHEET NO.	DESCRIPTION
	TITLE SHEET
2	ROADWAY, GENERAL NOTES,
	SIGNING AND PAVEMENT MARK-
	ING PLAN
3	MISCELLANEOUS DETAILS
4	TRAFFIC SIGNAL DETAILS
5	TRAFFIC SIGNAL PLAN
6-7	TYPICAL DETAILS
	(WHEELCHAIR RAMPS)
8-10	STANDARD (CATCH BASIN)
	DETAILS
11-25	STANDARD DETAILS

STATE OF HAWAII

DEPARTMENT OF TRANSPORTATION

HIGHWAYS DIVISION HONOLULU, HAWAII


"AS-BUILT"

PLANS FOR

CONSTRUCTION OF KUHIO HIGHWAY, EHA STREET AND WILCOX HOSPITAL INTERSECTION IMPROVEMENTS


PROJECT NO. 56A-01-85


DISTRICT OF LIHUE ISLAND OF KAUAI

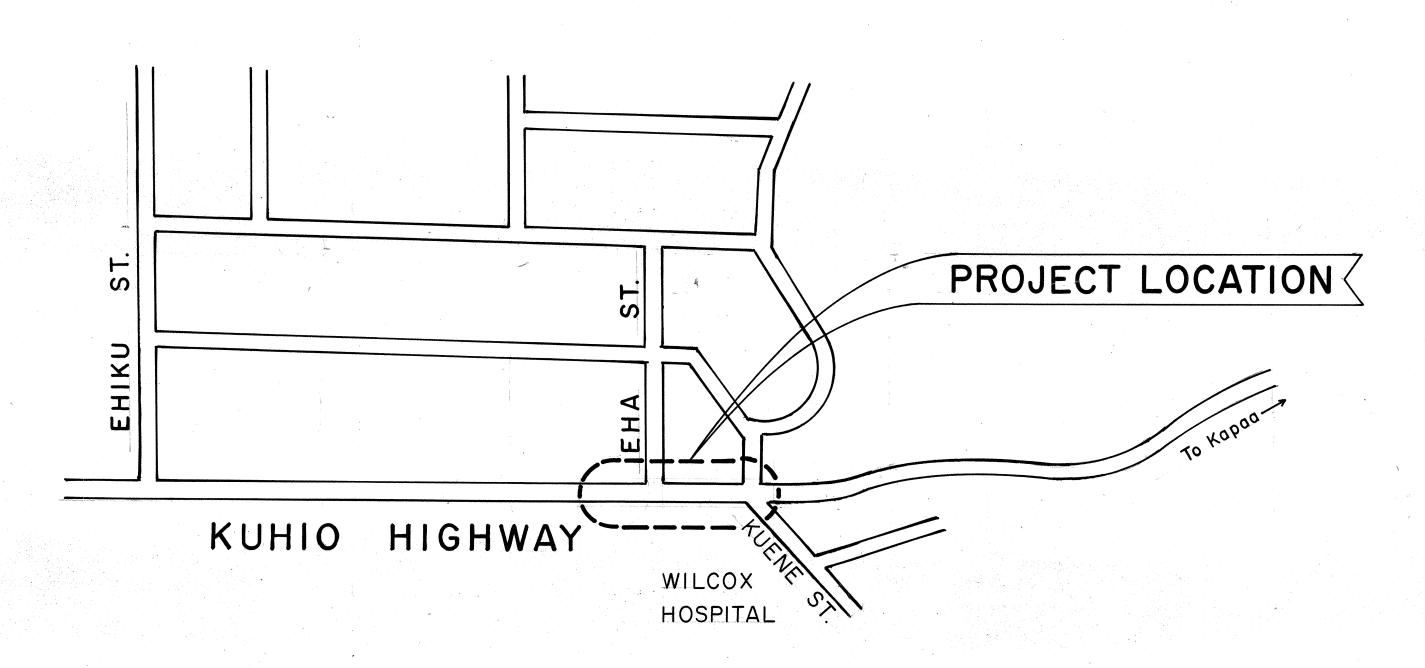

LAYOUT PROJECT SCALE IN FEET

FED. ROAD DIST. NO. FED. AID PROJ. NO. 56A-01-85

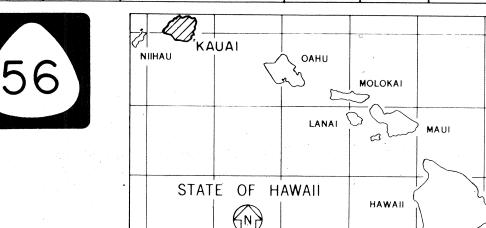

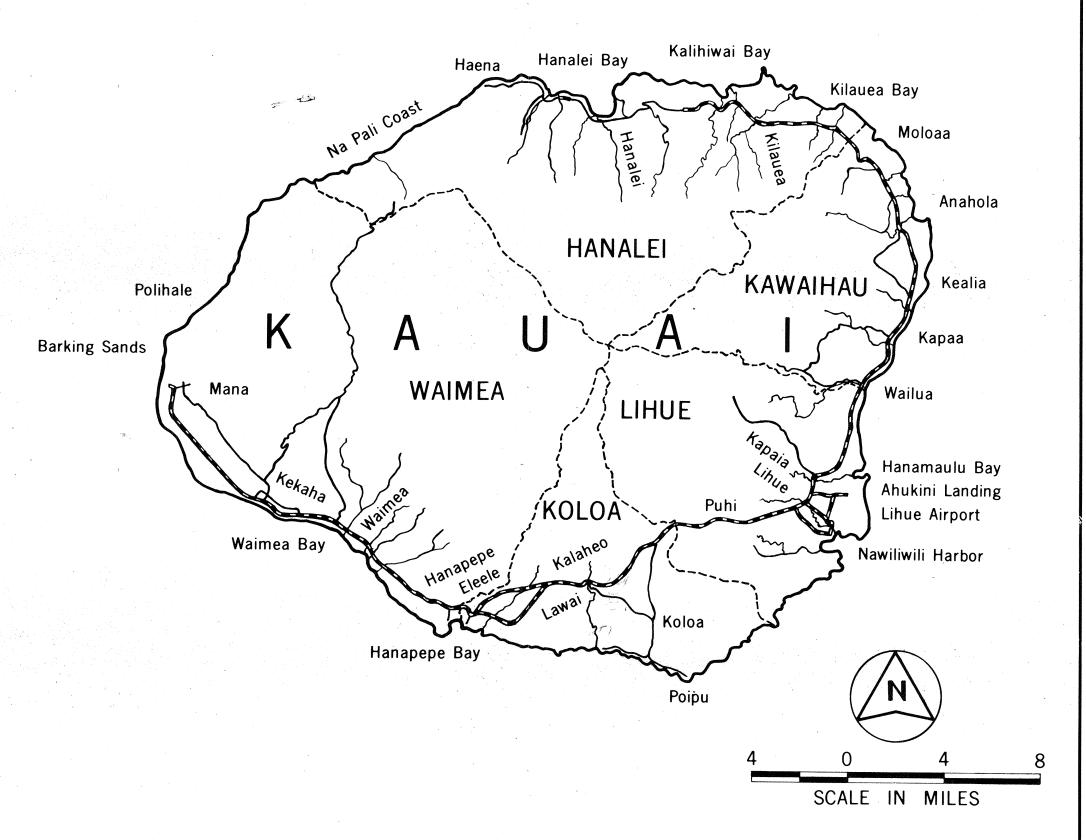

FEDERAL AID PROJECTS PREVIOUSLY CONSTRUCTED

OR UNDER CONSTRUCTION

CHANGES MADE DURING CONSTRUCTION HAVE BEEN INCORPORATED ON THESE PLANS EXCEPT CHANGES IN THE ORIGINAL THEORETICAL QUANTITIES. FOR ACTUAL QUANTITIES, REFER TO PROJECT LEDGER AND/OR COMPUTATION BOOK.

Danyl L. Maeda for RESIDENT ENGINEER

6/22/88 DATE

DEPARTMENT OF TRANSPORTATION STATE OF HAWAII APPROVED: Clieses D. Joan TarDIR. OF TRANSPORTATION 4/24/86

APRIL, 1986 DATE 548-4125 PHONE A. Yamaguchi P. S. & E. BY

DESIGN UNIT DESIGNED BY