	INDEX TO DRAWINGS
SHEET NO.	DESCRIPTION
1	TITLE SHEET
2	STANDARD PLAN SUMMARY
3	GENERAL NOTES &
	TYPICAL SECTIONS
4	PLAN & ESTIMATED
	QUANTITIES

548-7534 PHONE

KAUAI DISTRICT A. YAMAGUCHI DESIGNED BY P. S. & E. BY


STATE OF HAWAII

DEPARTMENT OF TRANSPORTATION HIGHWAYS DIVISION

"AS-BUILT"

PLAN FOR KUHIO HIGHWAY RESURFACING, PAPAA BRIDGE TO ALIOMANU

> PROJECT NO. 56C-01-88M DISTRICT OF KAWAIHAU ISLAND OF KAUAI

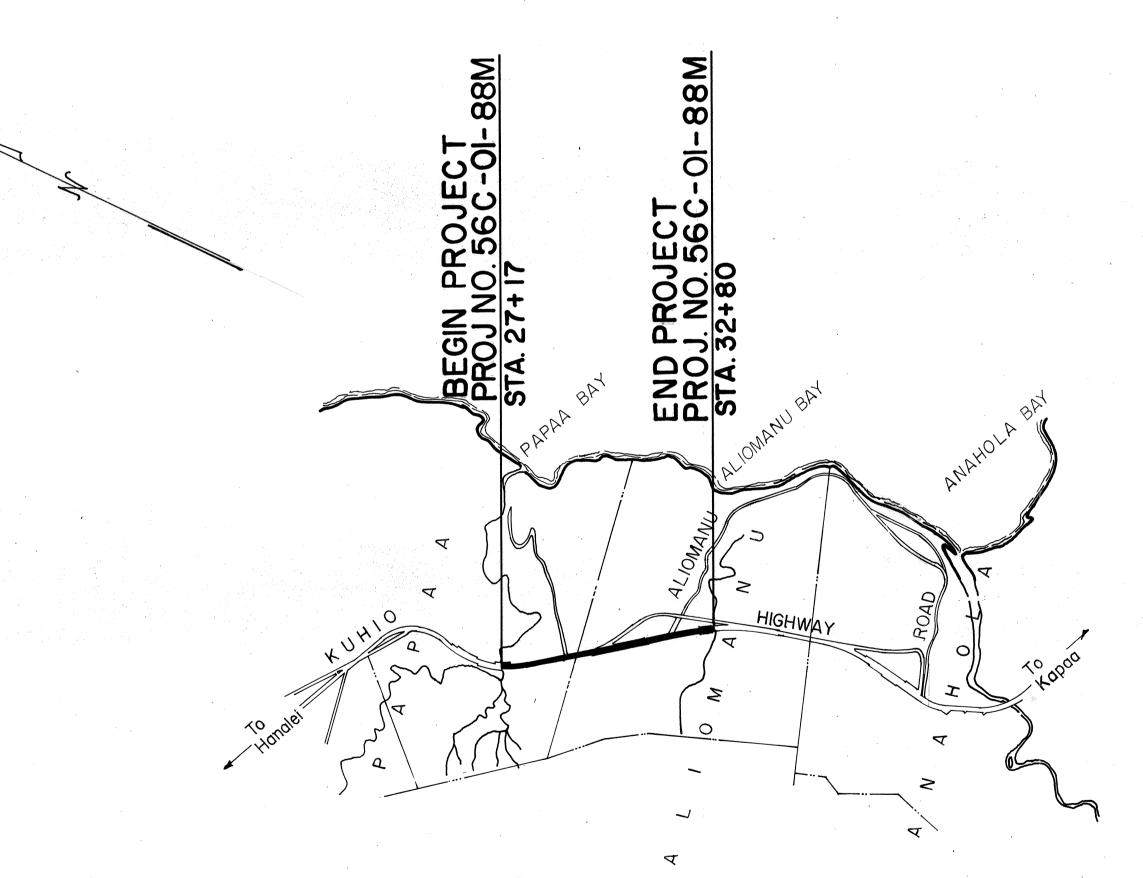



LENGTH OF PROJECT = 0.864 Mile.

LAYOUT OF PROJECT SCALE: I" = 2000.0

FED. ROAD DIST. NO. FISCAL SHEET YEAR NO. STATE PROJ. NO.



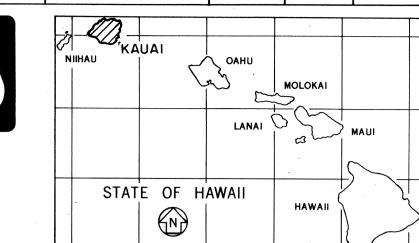

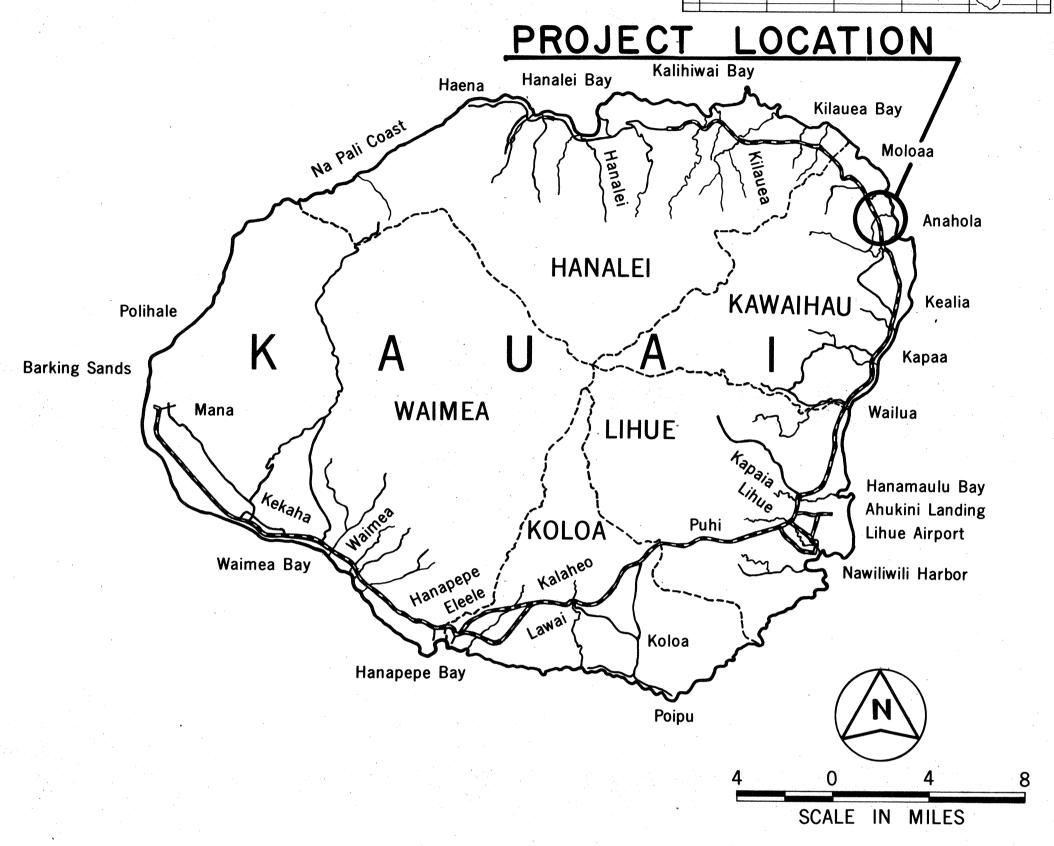

FEDERAL AID PROJECTS PREVIOUSLY CONSTRUCTED OR UNDER CONSTRUCTION

CHANGES MADE DURING CONSTRUCTION HAVE BEEN INCORPORATED ON THESE PLANS EXCEPT CHANGES IN THE ORIGINAL THEORETICAL QUANTITIES, FOR ACTUAL QUANTITIES, REFER TO PROJECT LEDGER AND/OR COMPUTATION BOOK.

RESIDENT ENGINEER

9/1/88

DATE

DEPARTMENT OF TRANSPORTATION STATE OF HAWAII APPROVED: