


FED. ROAD DIST. NO.	STATE	FED-AID PROJ. NO.	FISCAL YEAR	SHEET NO.	TOTAL SHEETS
HAWAII	HAW.	5GA-02-80	1980	7	13

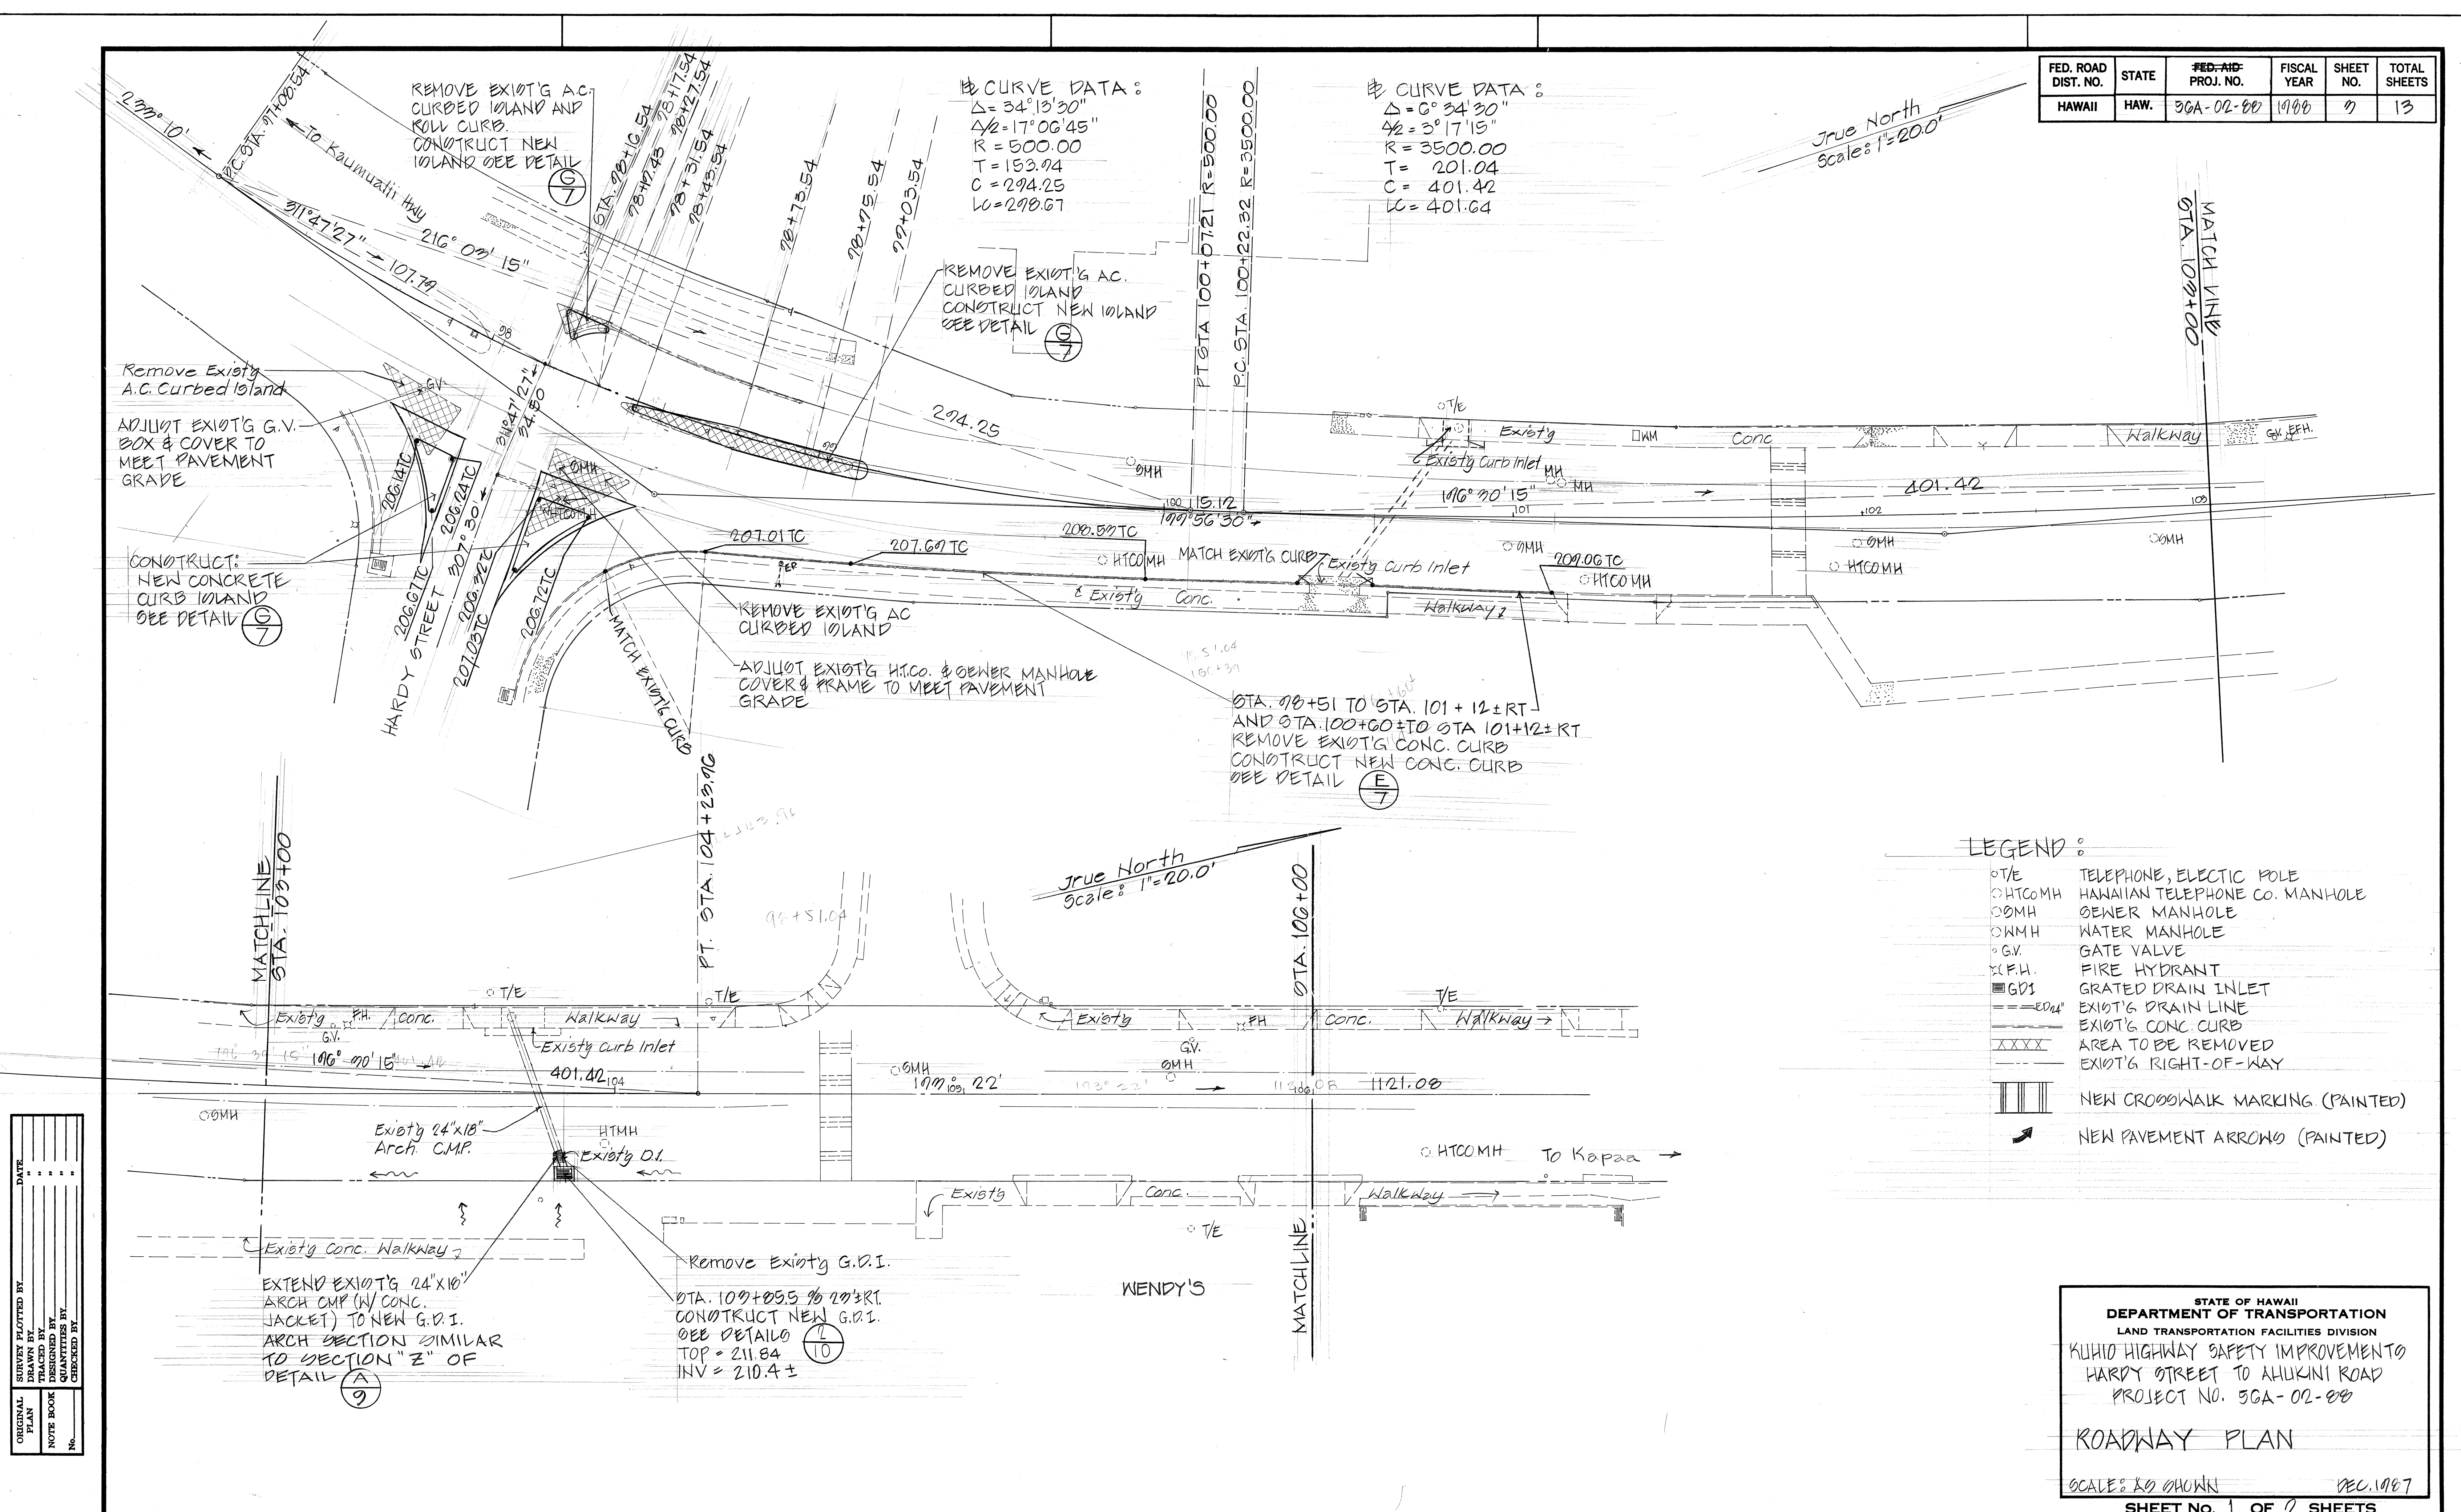

- LEGEND:
- T/E TELEPHONE, ELECTRIC POLE
 - HTCOMH HAWAIIAN TELEPHONE CO. MANHOLE
 - SMH SEWER MANHOLE
 - WMH WATER MANHOLE
 - GV GATE VALVE
 - F.H. FIRE HYDRANT
 - GDI GRATED DRAIN INLET
 - ED24" EXIST'G DRAIN LINE
 - EXIST'G CONC CURB
 - XXXX AREA TO BE REMOVED
 - EXIST'G RIGHT-OF-WAY
 - ||||| NEW CROSSWALK MARKING (PAINTED)
 - ➔ NEW PAVEMENT ARROWS (PAINTED)

STATE OF HAWAII
DEPARTMENT OF TRANSPORTATION
LAND TRANSPORTATION FACILITIES DIVISION
KUHIO HIGHWAY SAFETY IMPROVEMENTS
HARDY STREET TO AHUKINI ROAD
PROJECT NO. 5GA-02-80

ROADWAY PLAN

SCALE: AS SHOWN DEC. 1987

SHEET NO. 1 OF 2 SHEETS

DATE	_____
SURVEY PLOTTED BY	_____
DRAWN BY	_____
CHECKED BY	_____
NOTED BY	_____
NO.	_____

A horizontal number line is shown with tick marks at intervals of 1, labeled from 0 to 10. Below the number line, a circle contains the fraction $\frac{7}{10}$.

