


FED. ROAD DIST. NO.	STATE	FED. AID PROJ. NO.	FISCAL YEAR	SHEET NO.	TOTAL SHEETS
HAWAII	HAW.	96A-02-00	1990	5	13

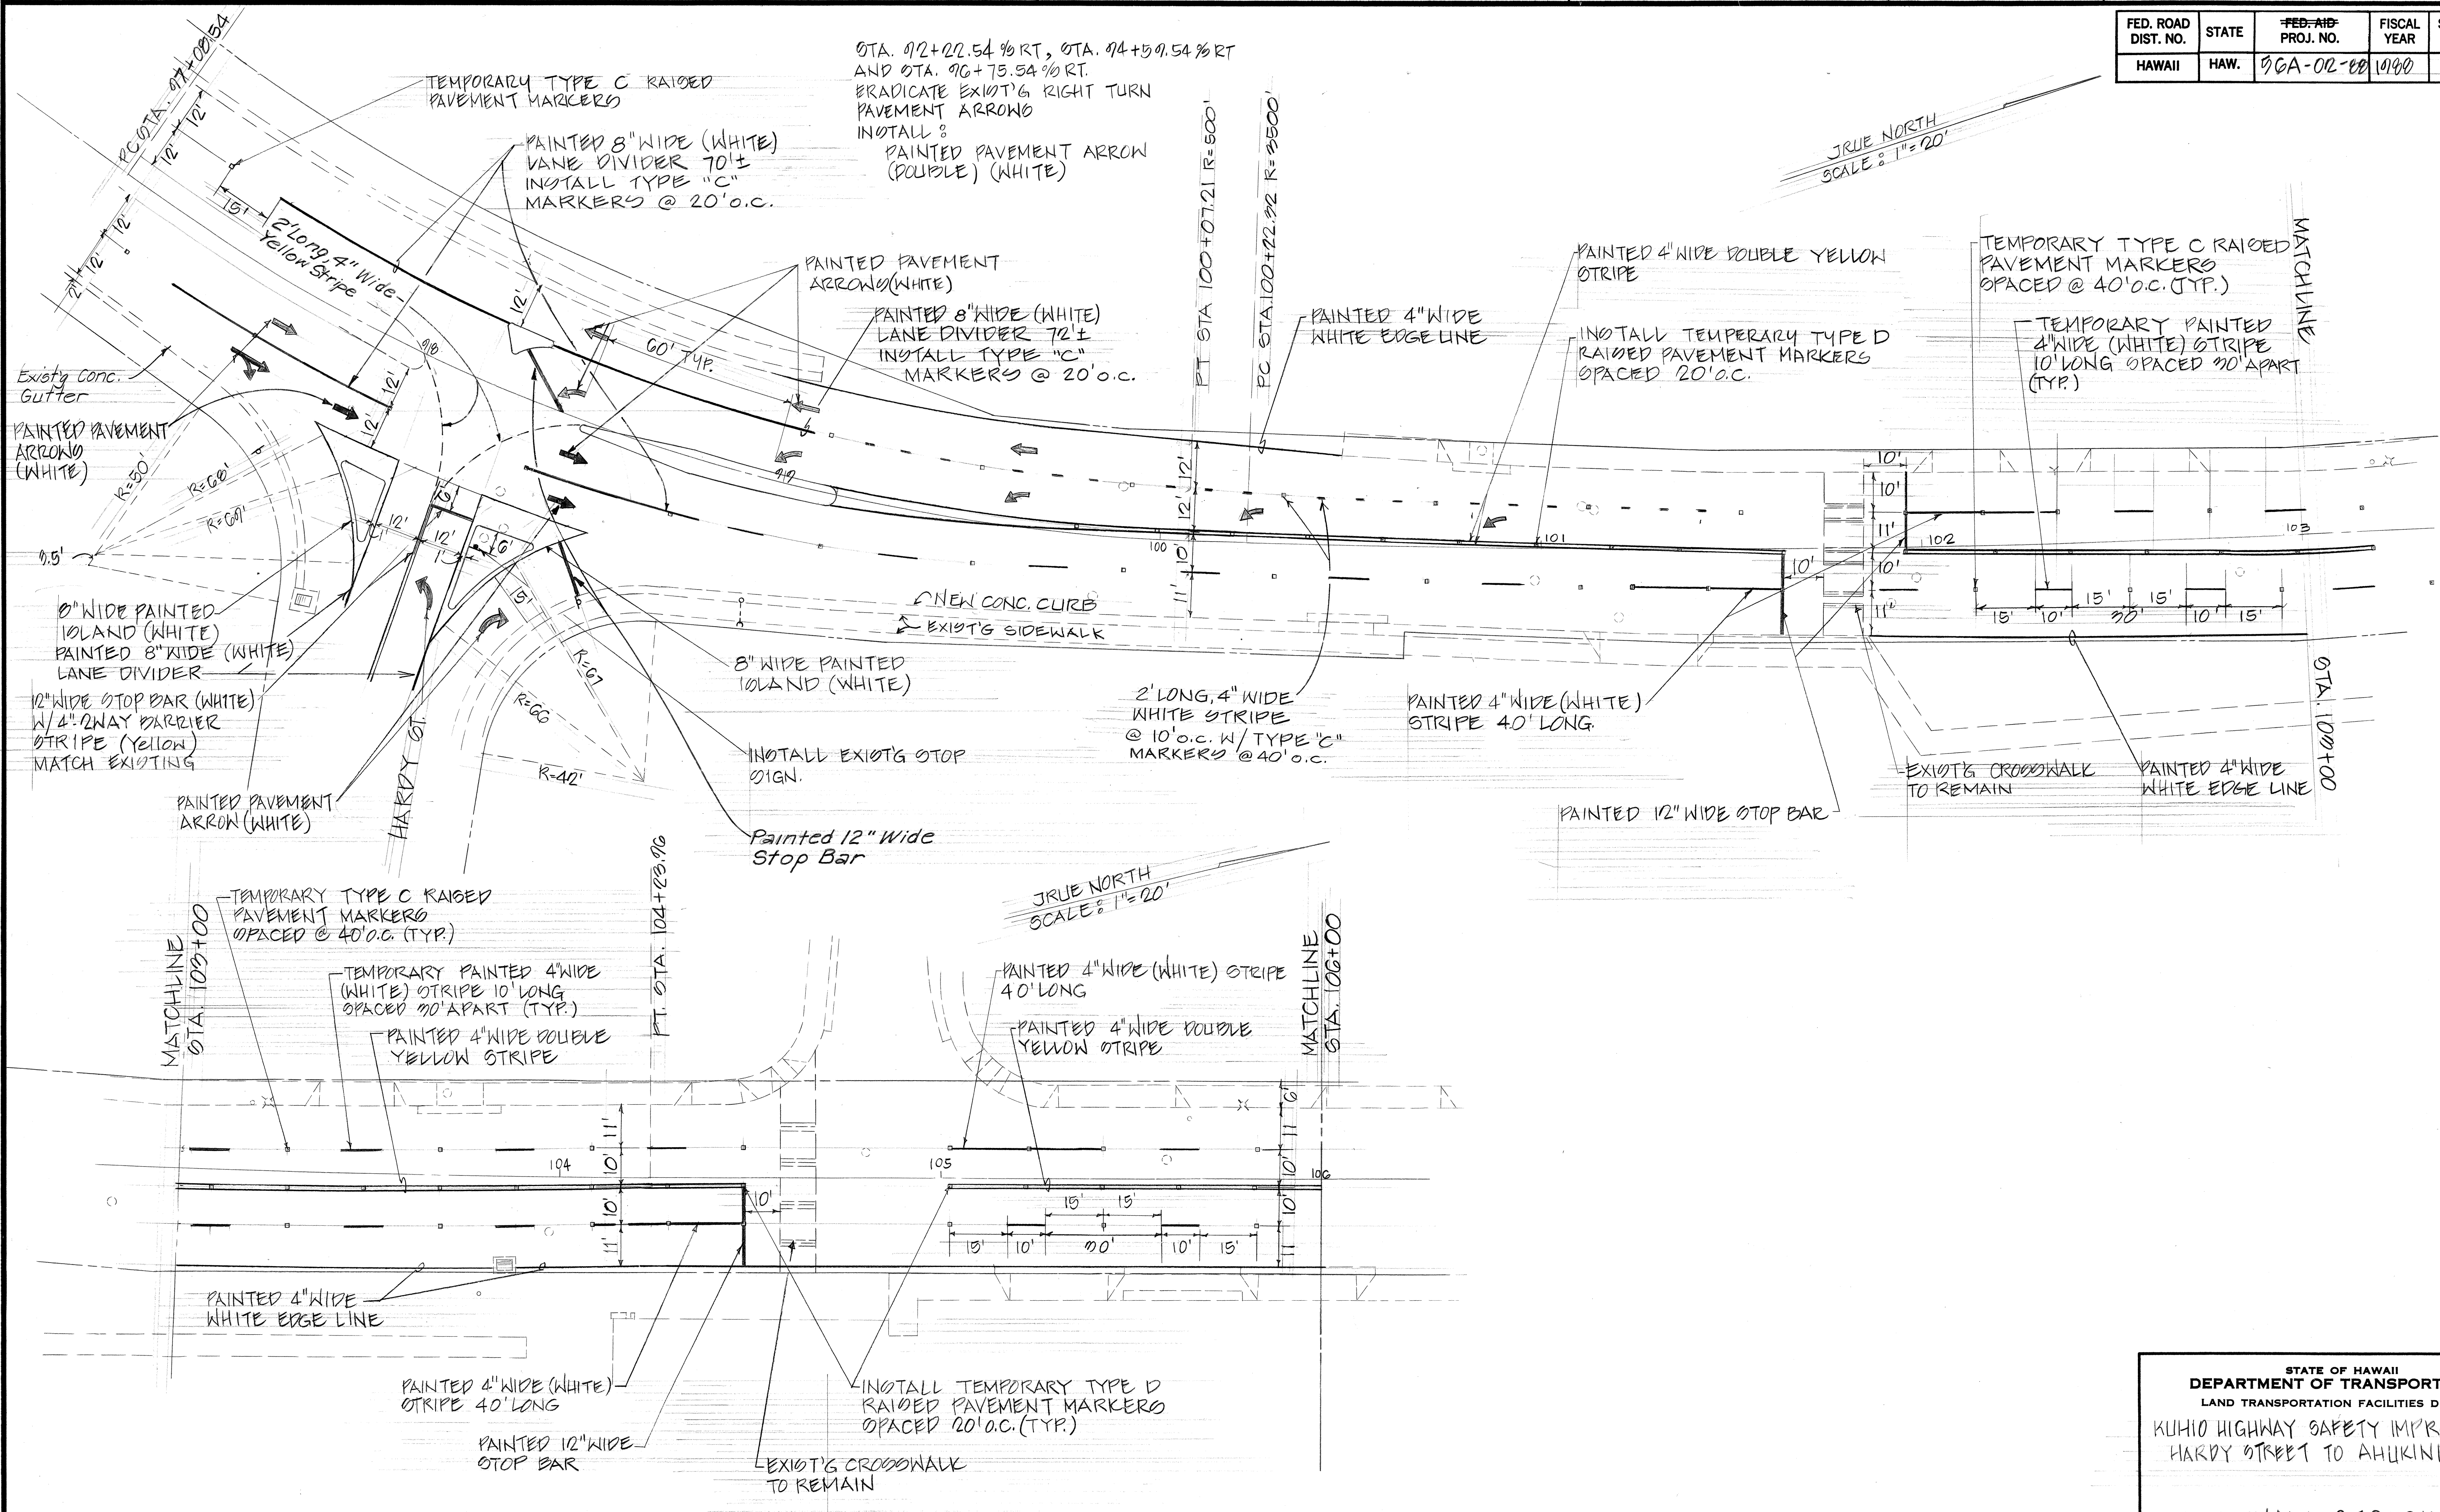

SURVEY PLOTTED BY	DATE
DRAWN BY	
DESIGNED BY	
QUANTITIES BY	
CHECKED BY	
ORIGINAL PLAN	
NOTE BOOK	
No.	

STATE OF HAWAII
DEPARTMENT OF TRANSPORTATION
LAND TRANSPORTATION FACILITIES DIVISION


KUHIO HIGHWAY SAFETY IMPROVEMENTS
HARDY STREET TO AHUKINI ROAD

ROADWAY STRIPING

SCALE: AS SHOWN DEC. 1987

SHEET NO. 1 OF 2 SHEETS

FED. ROAD DIST. NO.	STATE	FED-AID PROJ. NO.	FISCAL YEAR	SHEET NO.	TOTAL SHEETS
HAWAII	HAW.	50A-02-88	1988	6	13

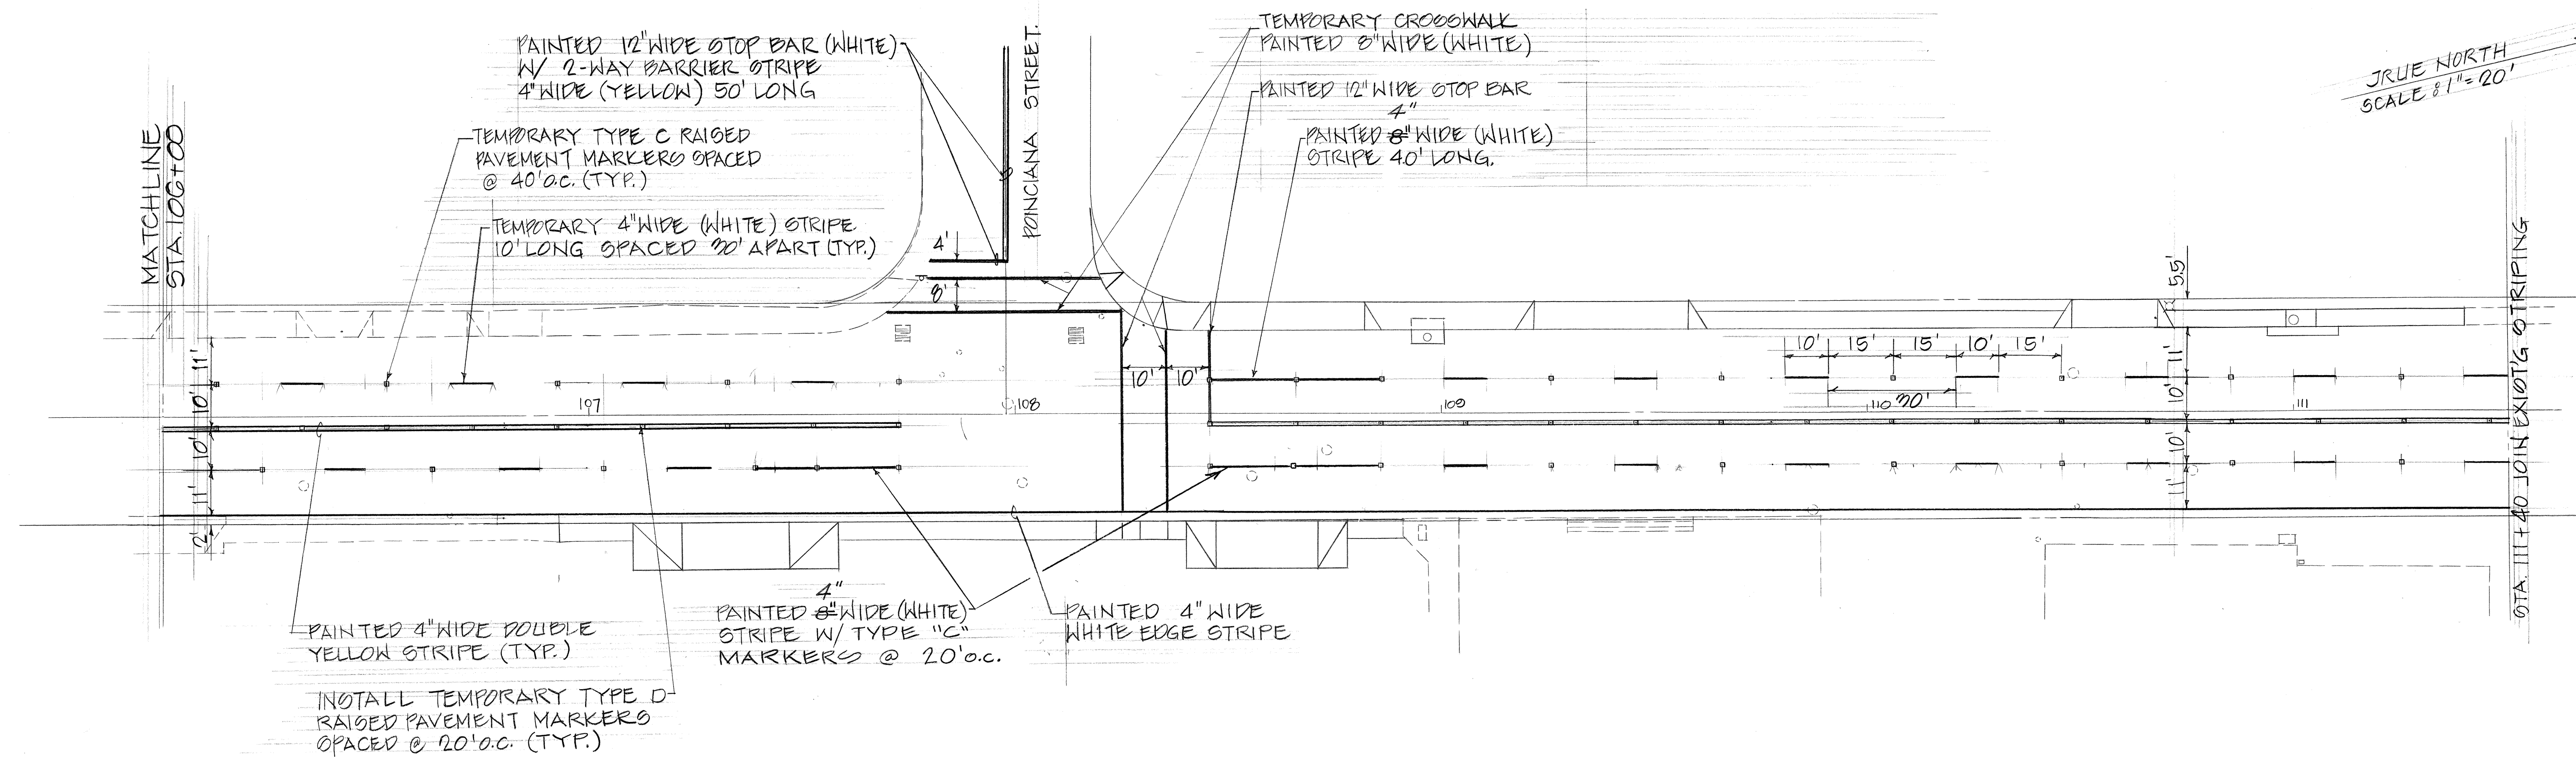

ORIGINAL PLAN	SURVEY PLOTTED BY	DATE
NOTE BOOK	DRAWN BY	
No.	TRACED BY	
	QUANTITIES BY	
	CHECKED BY	

STATE OF HAWAII
DEPARTMENT OF TRANSPORTATION
LAND TRANSPORTATION FACILITIES DIVISION

KUHIO HIGHWAY SAFETY IMPROVEMENTS
HARDY STREET TO AHUKINI ROAD
PROJECT NO. 50A-02-88

ROADWAY STRIPING

SCALE: AS SHOWN DEC, 1987

SHEET NO. 2 OF 2 SHEETS