	INDEX TO DRAWINGS
SHEET NO.	DESCRIPTION
	TITLE SHEET
2	NOTES AND TRAFFIC CONTROL
3,84	ROADWAY PLAN
586	ROADWAY STRIPING
7, 8,98 10	MISCELLANEOUS DETAILS
11 & 12	CROSS SECTIONS
IS - I	STANDARD PLANS SUMMARY
*** **********************************	
·	·

DEC. 87 DATE

548-4125 PHONE

R. TAKAESU P. S. & E. BY

KAUAI DISTRICT DESIGNED BY

STATE OF HAWAII


DEPARTMENT OF TRANSPORTATION HIGHWAYS DIVISION


"AS-BUILT"


## PLAN FOR:


KUHIO HIGHWAY SAFETY IMPROVEMENTS HARDY STREET TO AHUKINI ROAD

PROJECT NO. 56A-02-88
DISTRICT OF LIHUE
ISLAND OF KAUAI

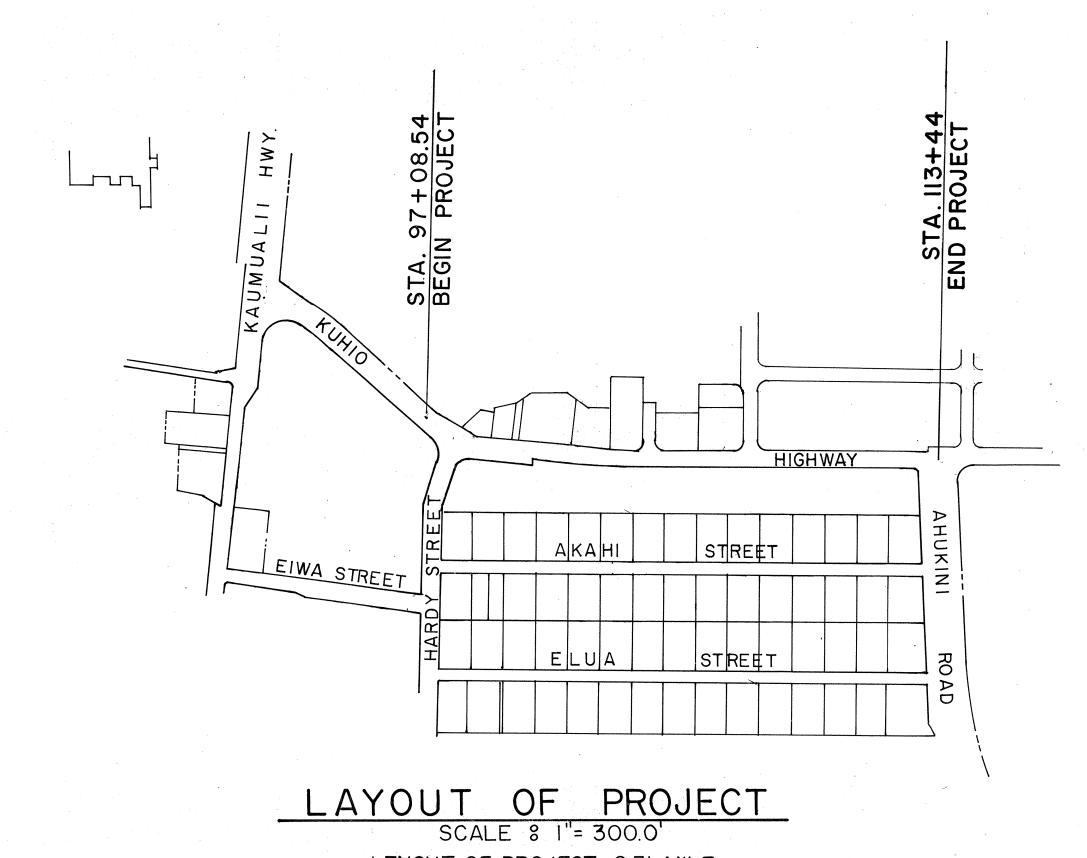

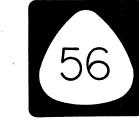

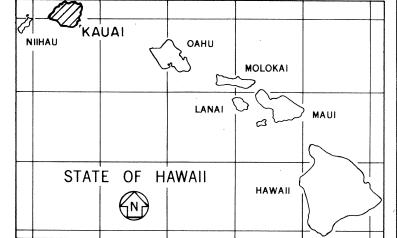

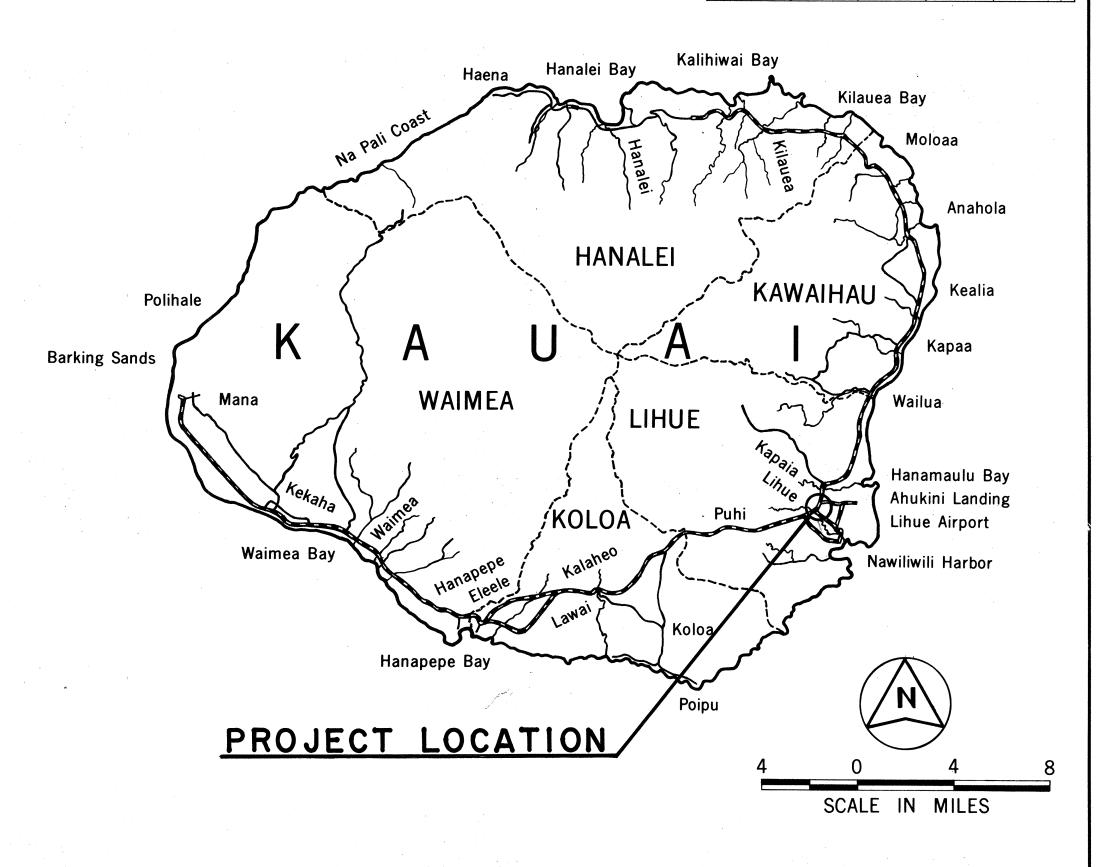

FEDERAL AID PROJECTS PREVIOUSLY CONSTRUCTED OR UNDER CONSTRUCTION

CHANGES MADE DURING CONSTRUCTION HAVE BEEN INCORPORATED ON THESE PLANS EXCEPT CHANGES IN THE ORIGINAL THEORETICAL QUANTITIES, REFER TO PROJECT LEDGER AND/OR COMPUTATION BOOK.

Donyl H. Maeda RESIDENT ENGINEER

1/4/91 DATE

DEPARTMENT OF TRANSPORTATION
STATE OF HAWAII

APPROVED:

Line 1/2/88

DIR. OF TRANSPORTATION

DATE

LENGHT OF PROJECT = 0.31 MILE