|           | INDEX TO DRAWINGS      |
|-----------|------------------------|
| SHEET NO. | DESCRIPTION            |
| 1         | TITLE SHEET            |
| 2         | STANDARD PLAN SUMMARY  |
| 3         | GENERAL NOTES, TYPICAL |
|           | SECTIONS, ESTIMATED    |
|           | QUANTITIES and         |
|           | MISCELLANEOUS DETAILS. |
| 4         | PLAN and PROFILE       |
|           |                        |
|           |                        |
|           | ·                      |
|           |                        |
|           |                        |
| -         |                        |
|           |                        |
| 1         |                        |
|           |                        |

FEB.,1989 DATE

548-7534 PHONE

KAUAI DISTRICT DESIGNED BY STATE OF HAWAII

DEPARTMENT OF TRANSPORTATION HIGHWAYS DIVISION


PLANS FOR "AS-BUILT"

## KUHIO HIGHWAY DRAINAGE IMPROVEMENTS BETWEEN COCONUT PLANTATION AND UHELEKAWAWA CANAL

PROJECT NO.56A-02-89

DISTRICT OF KAWAIHAU

ISLAND OF KAUAI

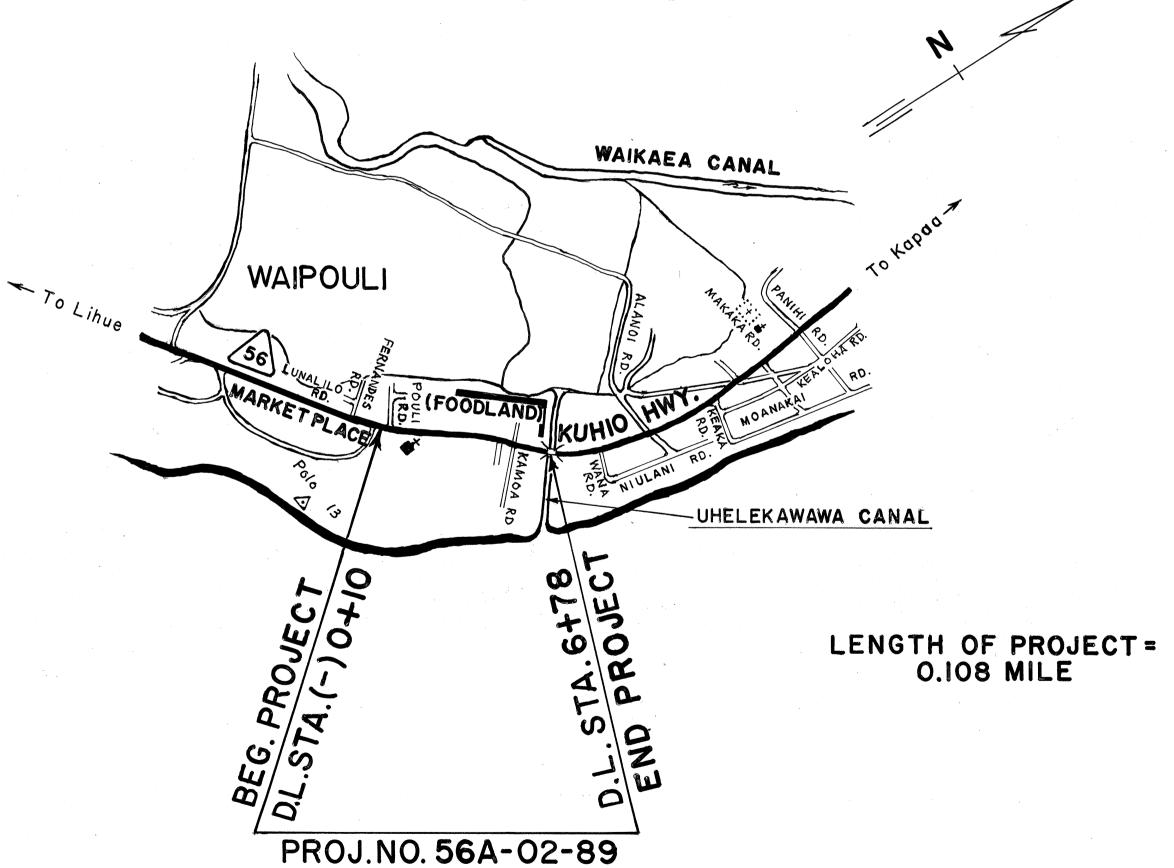

SCALE N.T.S.

FED. ROAD DIST. NO.

HAWAII


HAW.


FISCAL SHEET TOTAL YEAR NO.

SHEETS

1 4



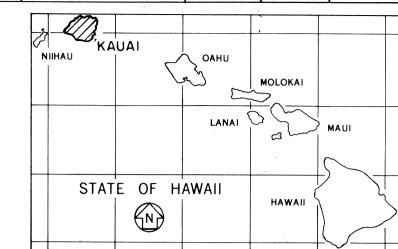

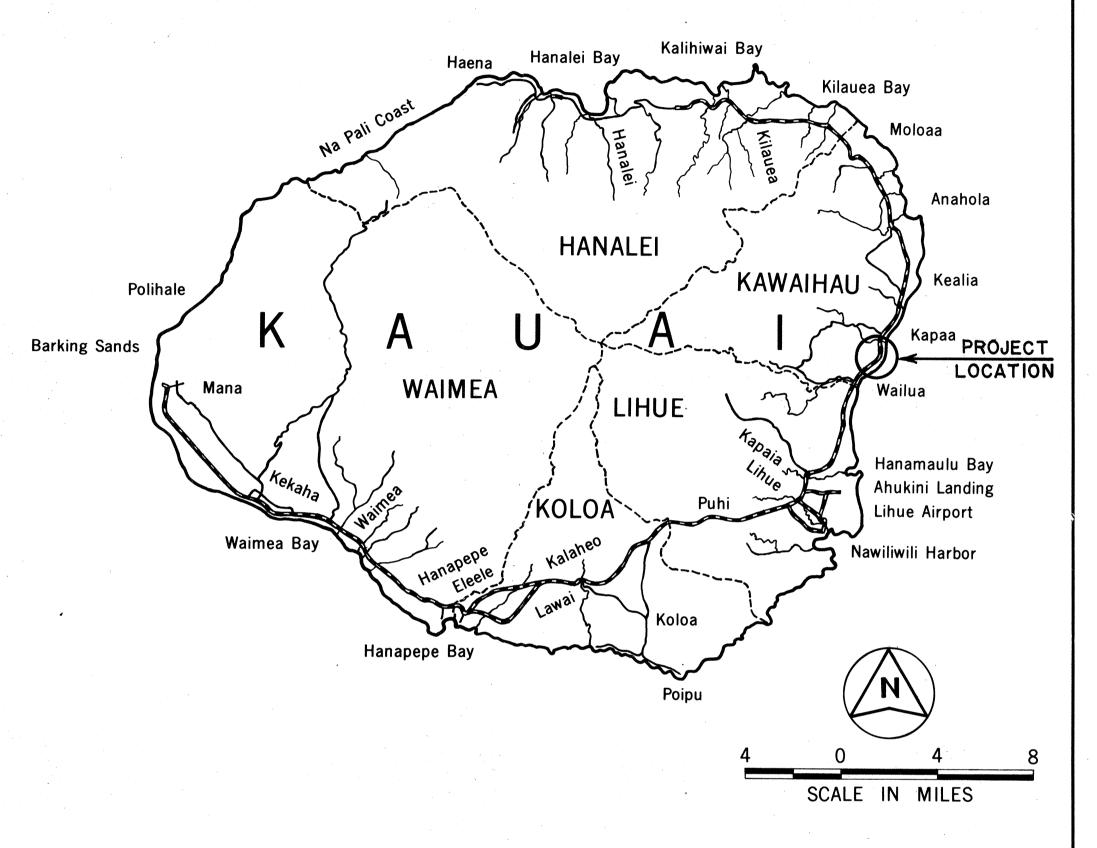

FEDERAL AID PROJECTS PREVIOUSLY CONSTRUCTED
OR UNDER CONSTRUCTION

CHANGES MADE DURING CONSTRUCTION HAVE BEEN NOTED ON THESE PLANS AND CHECKED BY:

RESIDENT ENGINEER

4/15/91 DATE

DEPARTMENT OF TRANSPORTATION
STATE OF HAWAII
APPROVED:

Edward forth