



[illegible]

FED. ROAD DIST. NO.	STATE	PROJ. NO.	FISCAL YEAR	SHEET NO.	TOTAL SHEETS
HAWAII	HAW.	56A-03-89	1990	1	6

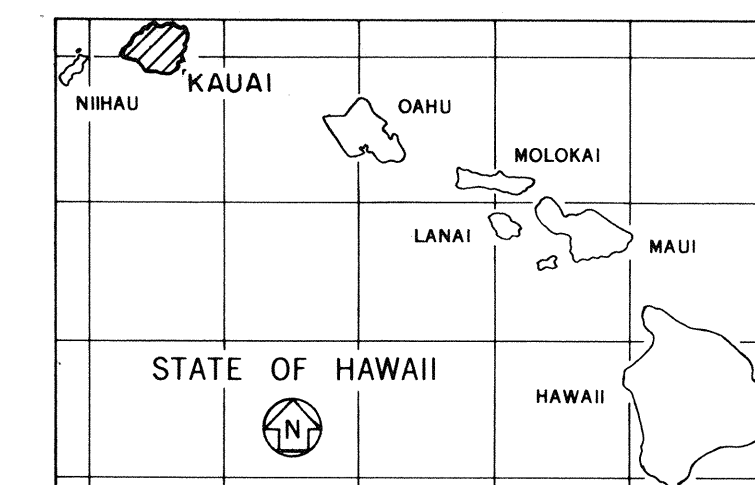

FEDERAL AID PROJECTS PREVIOUSLY CONSTRUCTED
OR UNDER CONSTRUCTION

Darryl H Maeda
RESIDENT ENGINEER

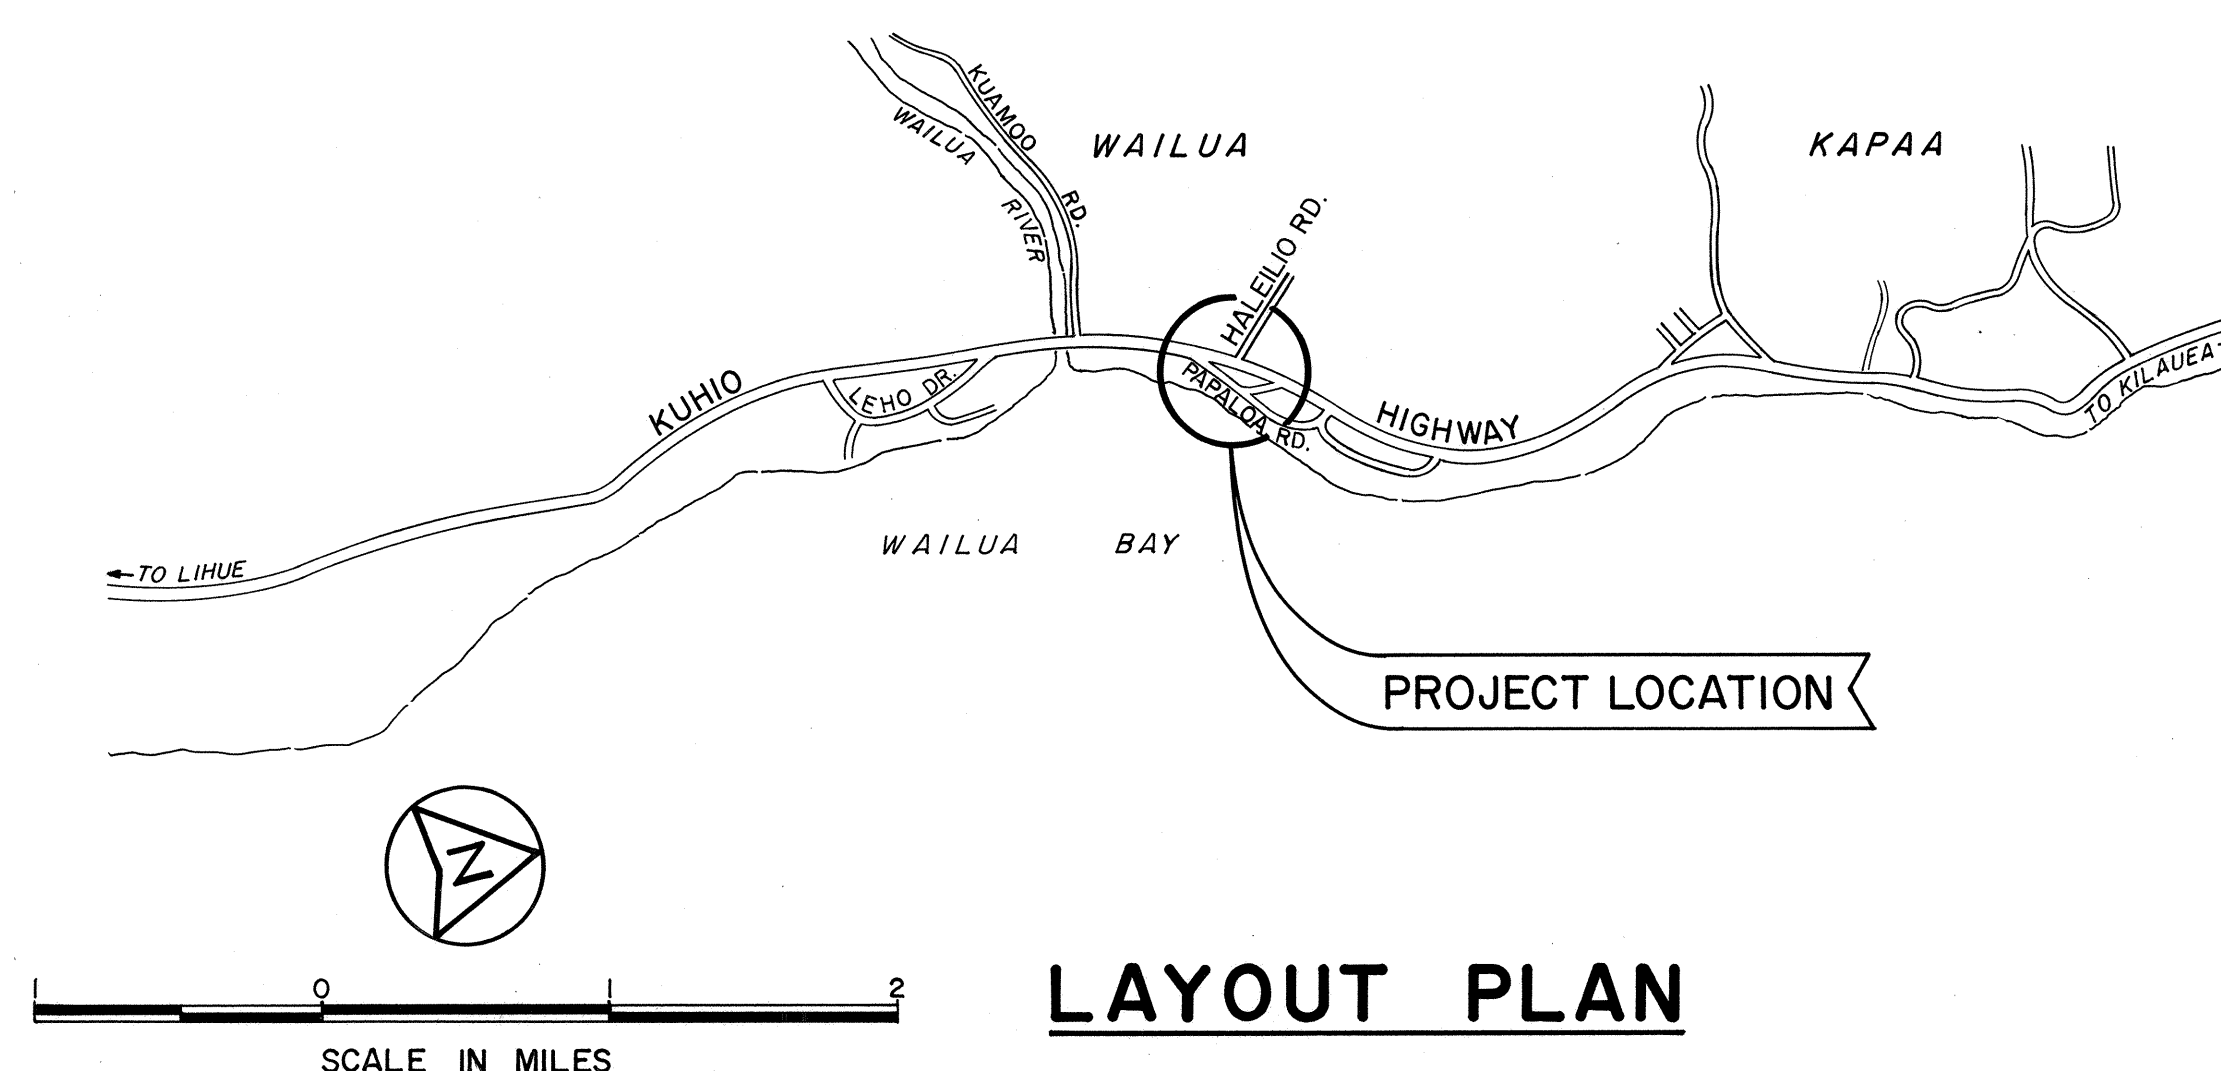

DEPARTMENT OF TRANSPORTATION
STATE OF HAWAII

APPROVED: _____

Edward J. Jank 4/3/88
DIR. OF TRANSPORTATION DAT