	INDEX TO DRAWINGS
SHEET NO.	DESCRIPTION
l	TITLE SHEET
2	STANDARD PLAN SUMMARY
3	GENERAL & PAVEMENT MARK'G
	NOTES, DETAILS & SECTIONS
485	PLANS
6	ESTIMATED QUANTITIES, NOTES
	& SECTIONS
	,

STATE OF HAWAII

DEPARTMENT OF TRANSPORTATION HIGHWAYS DIVISION HONOLULU, HAWAII

"AS-BUILT" PLANS FOR KUHIO HIGHWAY RESURFACING KAPAA TO KEALIA PROJECT NO. 56A - 03 - 90M

> DISTRICT OF KAWAIHAU ISLAND OF KAUAI


56A-03-90M 1990 STATE OF HAWAII

PROJ. NO.

FISCAL YEAR

PROJECT LOCATION $\stackrel{\textstyle ullet}{}$ PROJ. NO. 56A - 03 - 90M

FED. ROAD DIST. NO.

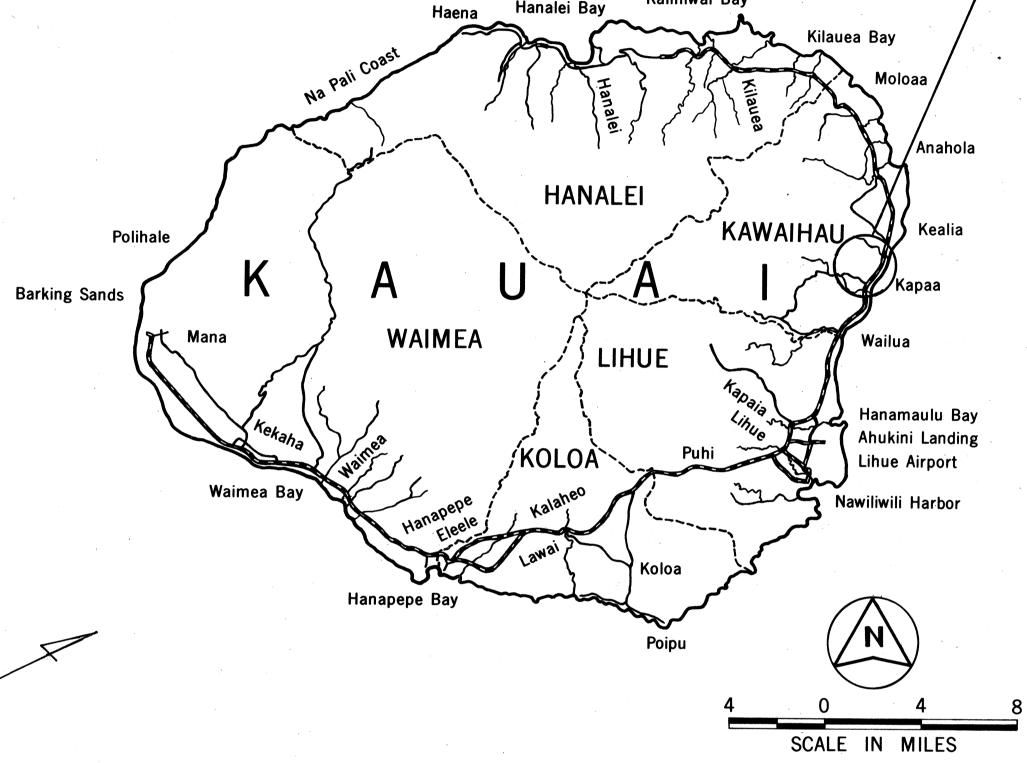

FEDERAL AID PROJECTS PREVIOUSLY CONSTRUCTED OR UNDER CONSTRUCTION

MILE POST <u>8.000</u> TO MILE POST <u>9.822</u>

CHANGES MADE DURING CONSTRUCTION HAVE BEEN INCORPORATED ON THESE PLANS EXCEPT CHANGES IN THE ORIGINAL THEORETICAL QUANTITIES. FOR ACTUAL QUANTITIES, REFER TO PROJECT LEDGER AND/OR COMPUTATION BOOK.

RESIDENT ENGINEER

DATE

DEPARTMENT OF TRANSPORTATION STATE OF HAWAII APPROVED:

DIR. OF TRANSPORTATION DATE

LENGTH OF PROJECT = 1.819 Mi.

LAYOUT OF PROJECT

KAUAI DISTRIC DESIGNED BY

548-7534 PHONE