
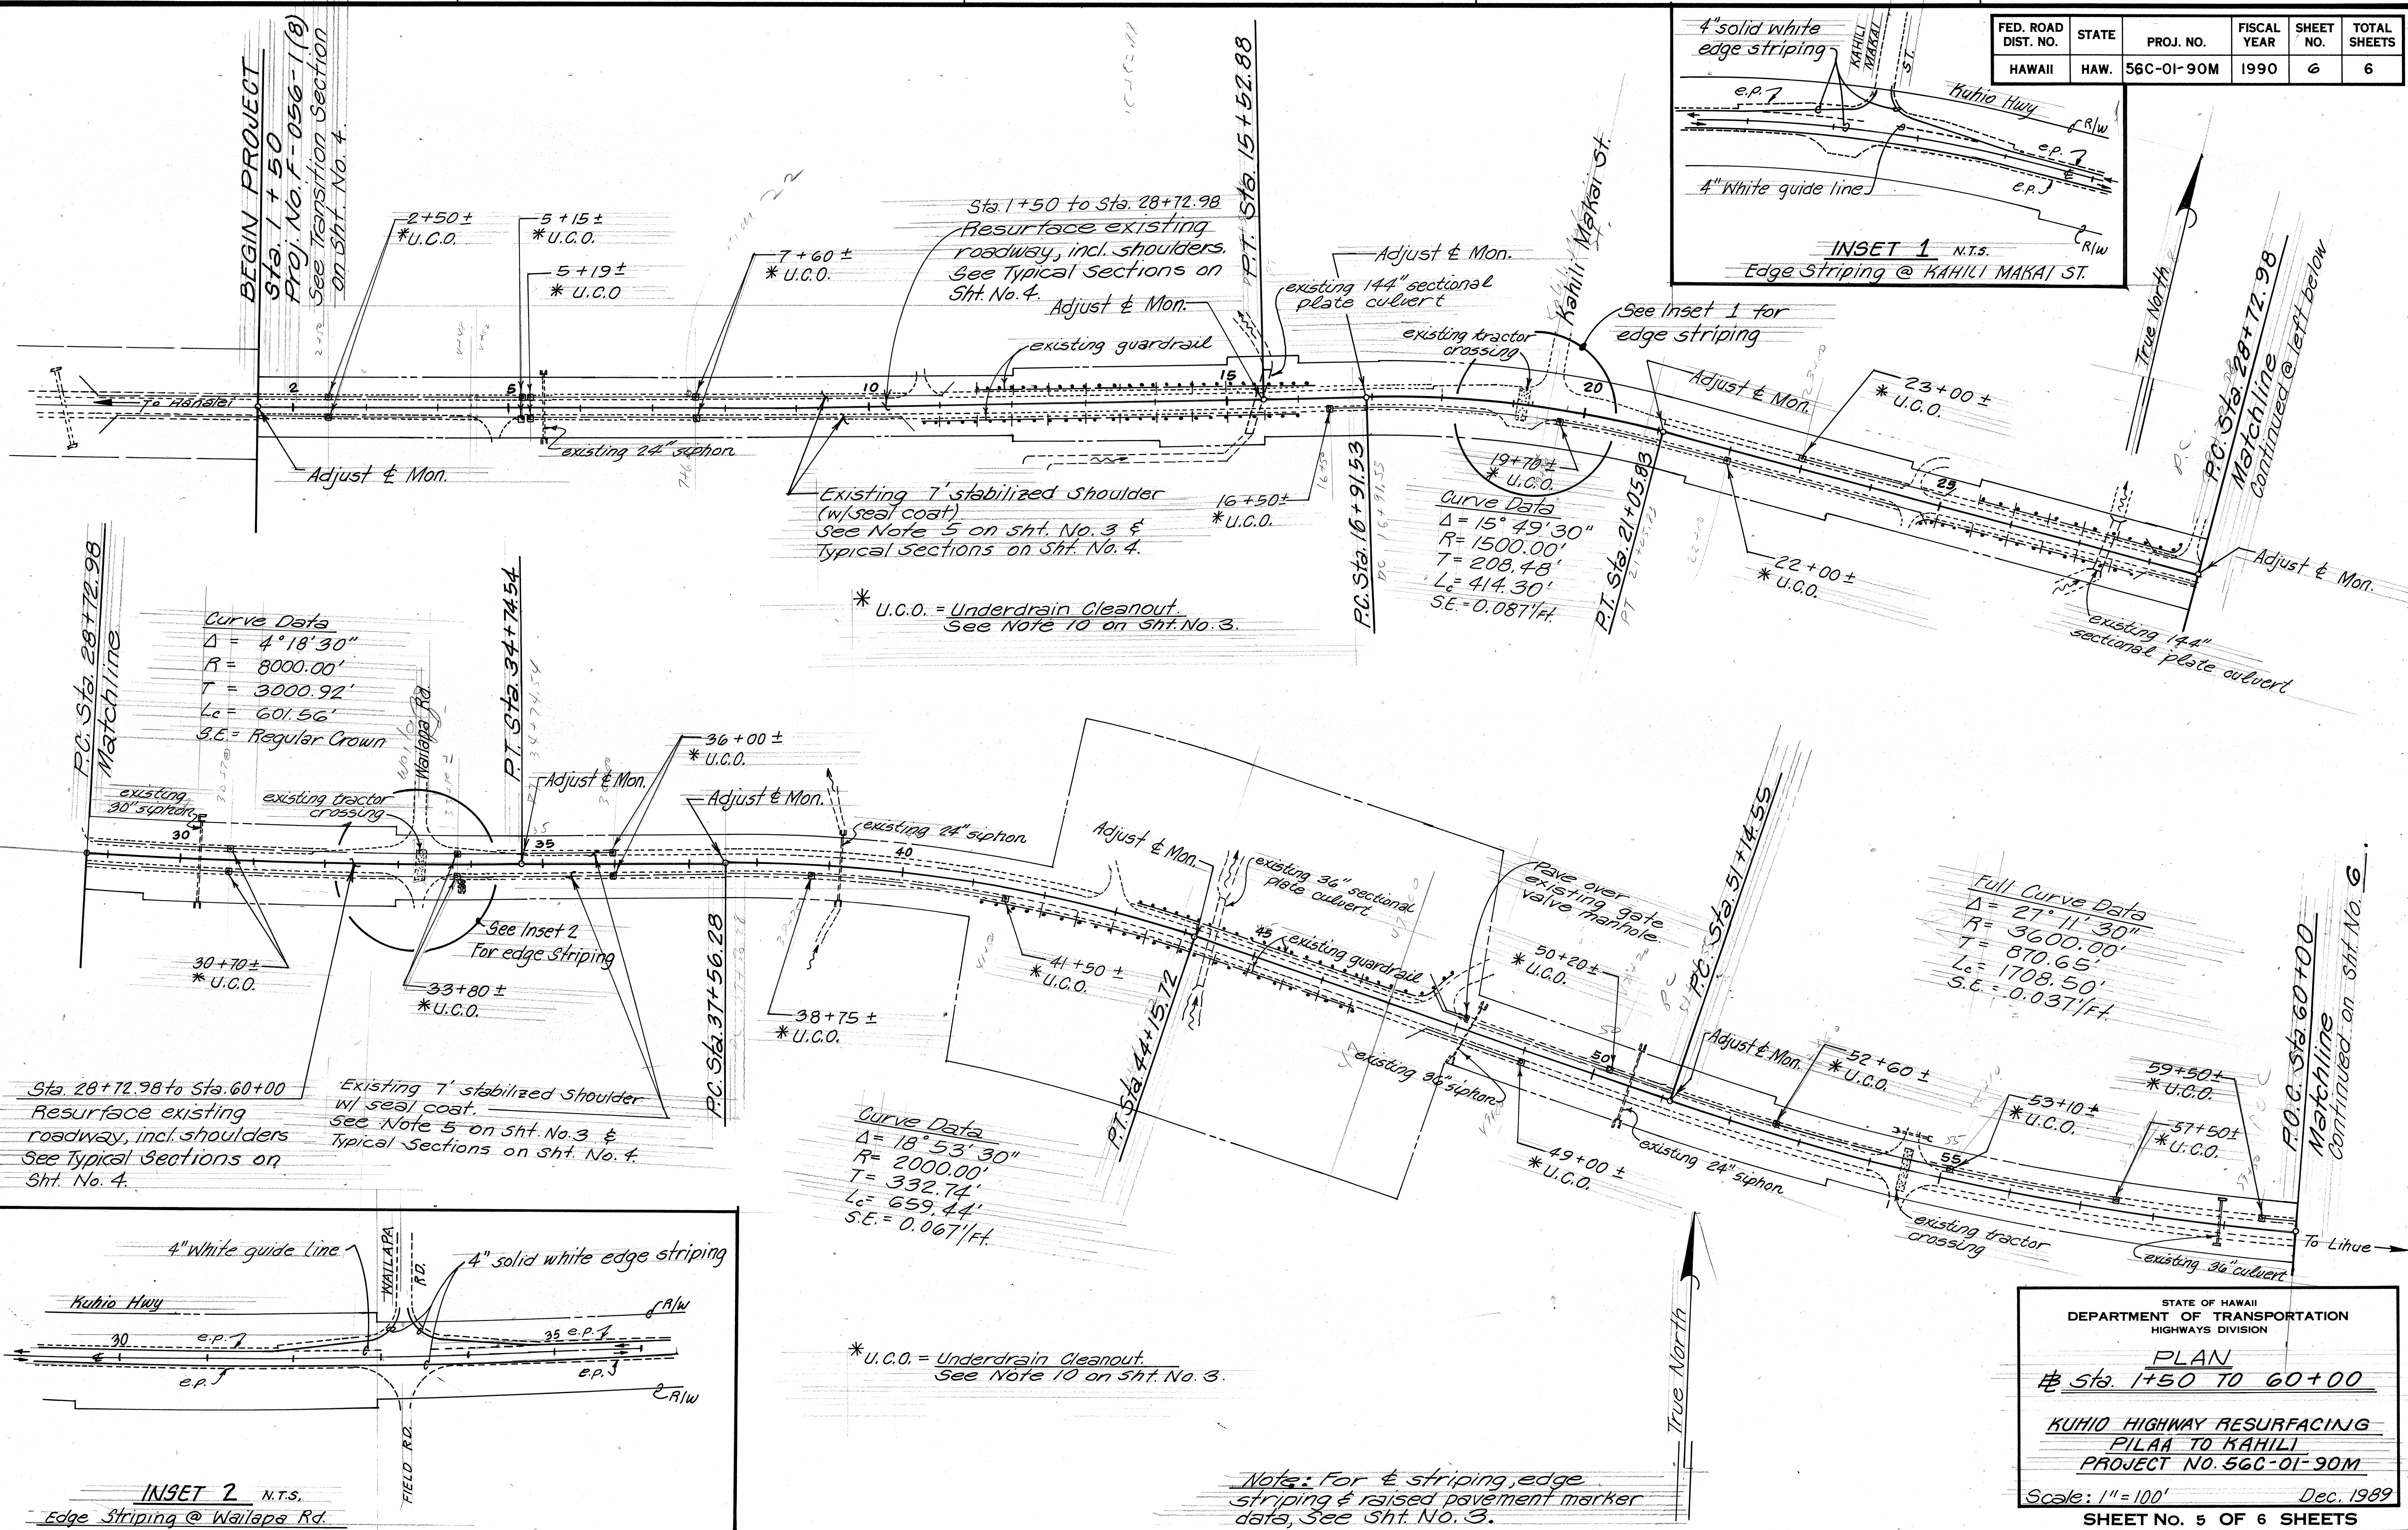


FED. ROAD DIST. NO.	STATE	PROJ. NO.	FISCAL YEAR	SHEET NO.	TOTAL SHEETS
HAWAII	HAW.	56C-01-90M	1990	6	6

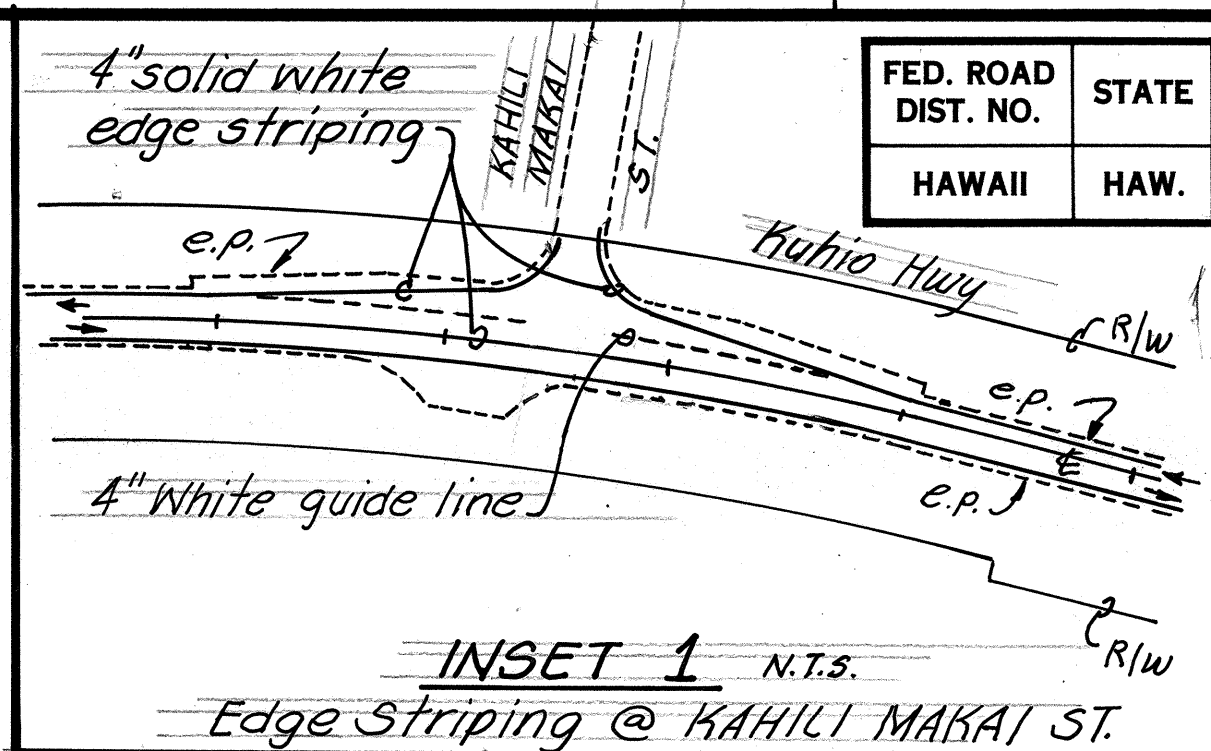

DATE	
SURVEY PLOTTED BY	
DRAWN BY	
DESIGNED BY	
QUANTITIES BY	
CHECKED BY	
NO.	

STATE OF HAWAII
DEPARTMENT OF TRANSPORTATION
HIGHWAYS DIVISION


PLAN
Sta. 1+50 TO 60+00

**KUHIO HIGHWAY RESURFACING
PILAA TO KAHILI
PROJECT NO. 56C-01-90M**


Scale: 1"=100' Dec. 1989

SHEET No. 5 OF 6 SHEETS

FED. ROAD DIST. NO.	STATE	PROJ. NO.	FISCAL YEAR	SHEET NO.	TOTAL SHEETS
HAWAII	HAW.	56C-01-90M	1990	6	6

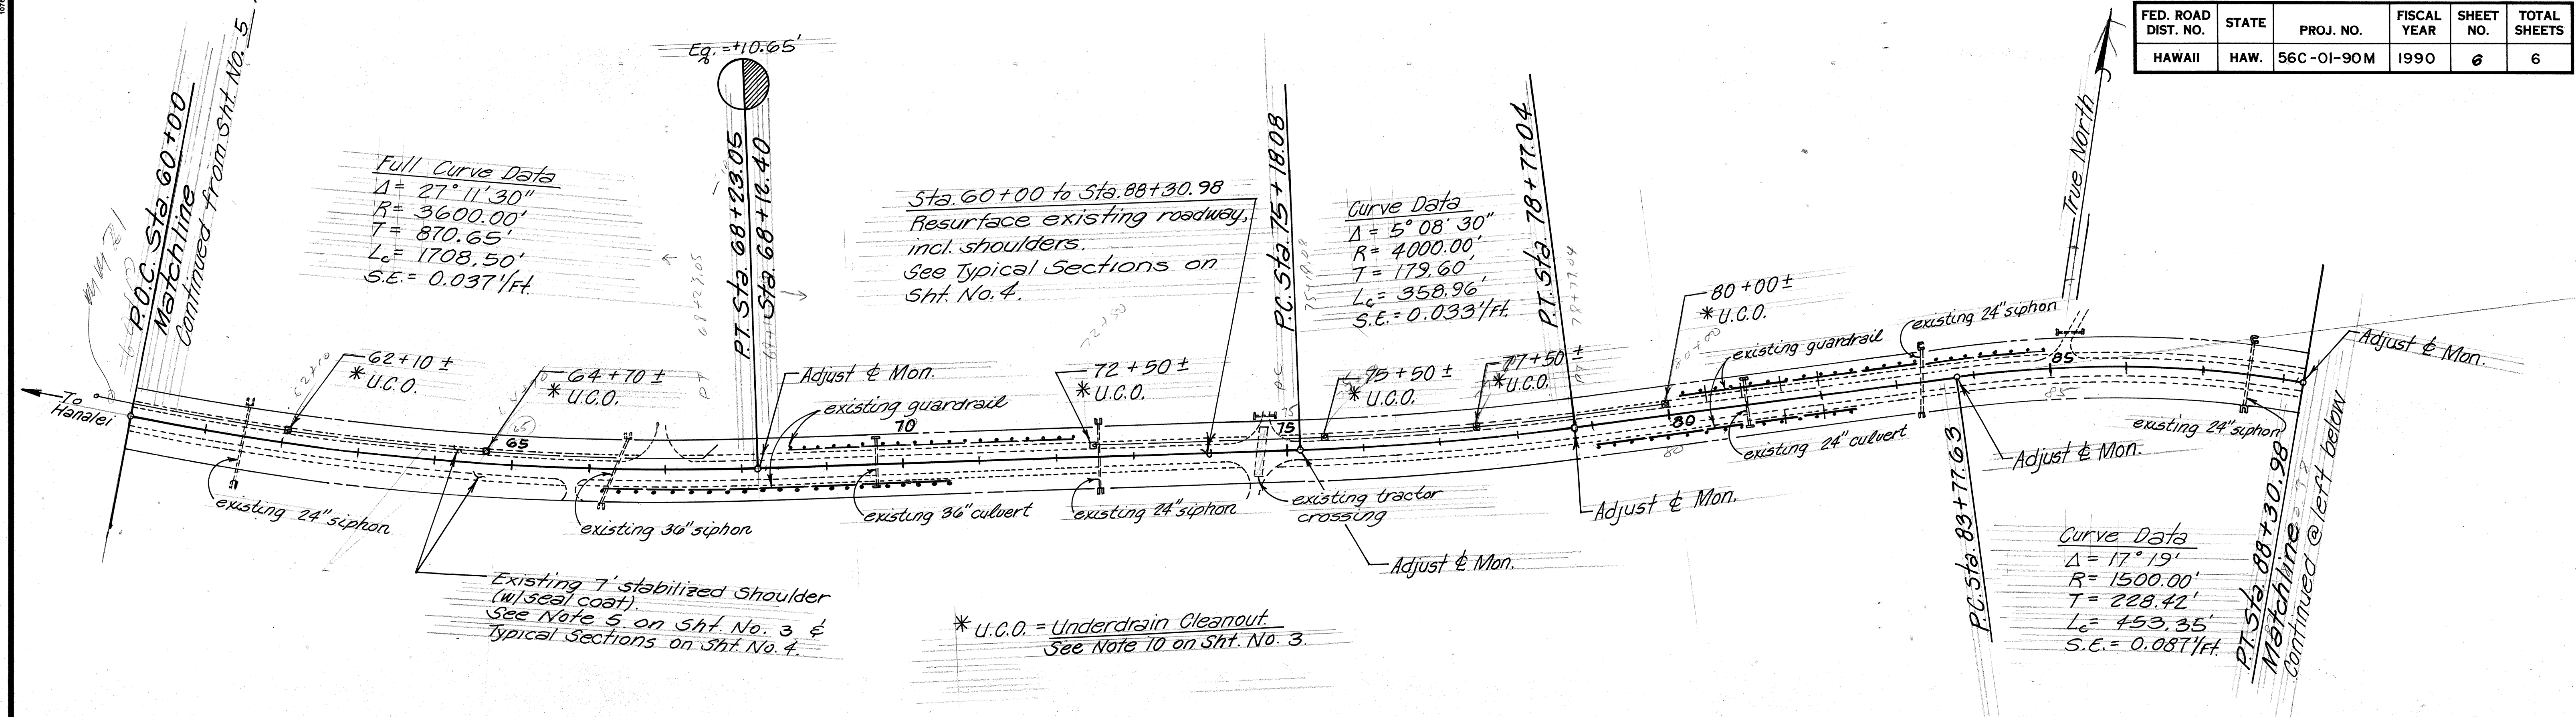

Sta. 88+30.98 to Sta. 108+02.44
Resurface existing roadway,
incl. shoulders.
See Typical Sections on
Sht. No. 4.

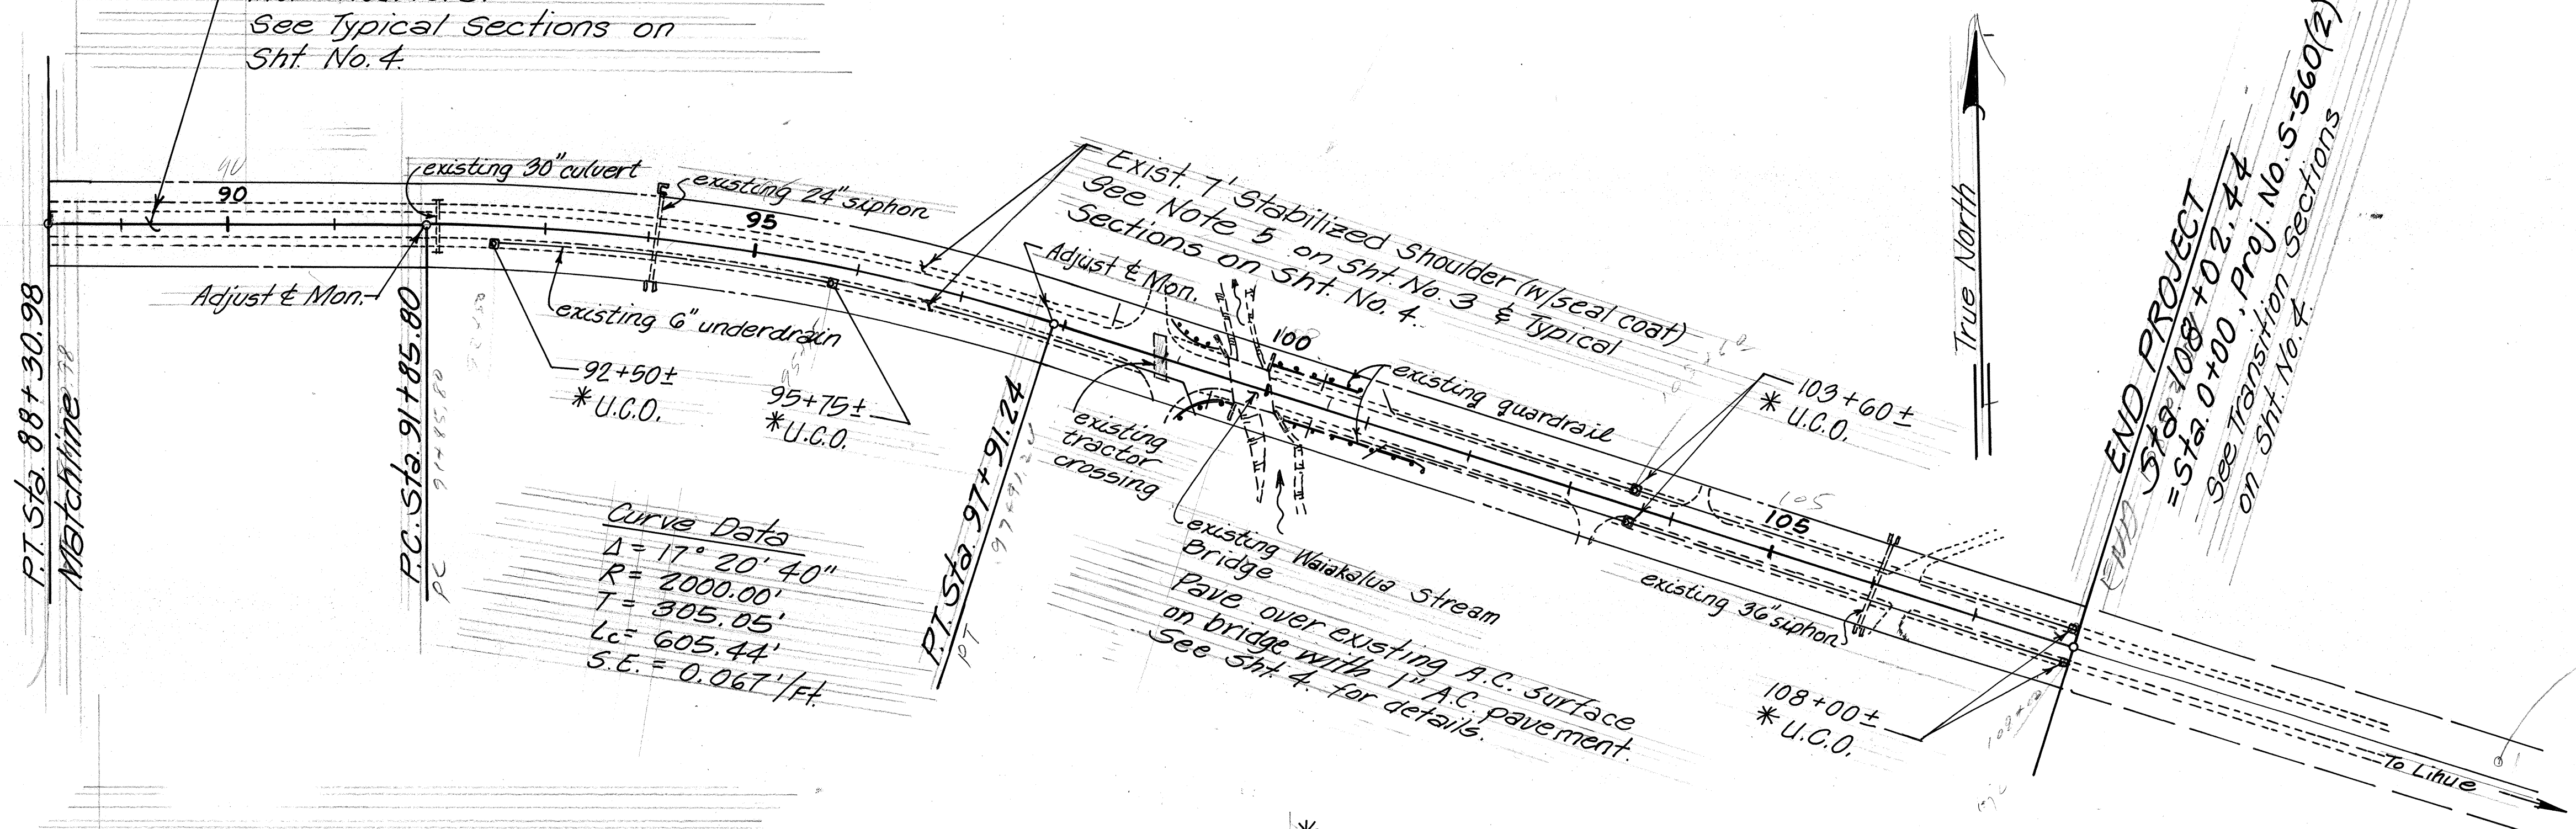

Estimated Quantities
(Sta. 1+50 to Sta. 108+02.44)

A.C. Pavement, Marshall Mix	= 4158.15 Ton
Adjusting & Monuments	= 16 Each
* Pavement Striping (Paint)	= 10.5 Gal.
Pavement Striping (Tape)	= 81.3 L.F.
Cold Plane Existing Pavement	= 135 S.Y.

* 105 Gal. White; 30 Gal. Yellow
Note:
1. For raised pavement markers & striping
See Sht. No. 3.
2. SS-1 Tack Coat shall not be
measured and/or paid for
separately, but shall be
considered incidental to A.C.
pavement, Marshall Mix.

STATE OF HAWAII
DEPARTMENT OF TRANSPORTATION
HIGHWAYS DIVISION

PLAN
Sta. 60+00 TO 108+02.44

KUHIO HIGHWAY RESURFACING
PILAA TO KAHILI
PROJECT NO. 56C-01-90M
Scale: 1"=100' Dec. 1989
SHEET No. 6 OF 6 SHEETS

ORIGINAL PLAN	DATE
SURVEY PLOTTED BY	
DRAWN BY	
DESIGNED BY	
QUANTITIES BY	
CHECKED BY	

Note: For & striping, edge striping, &
raised pavement marker data,
See Sht. No. 3.