

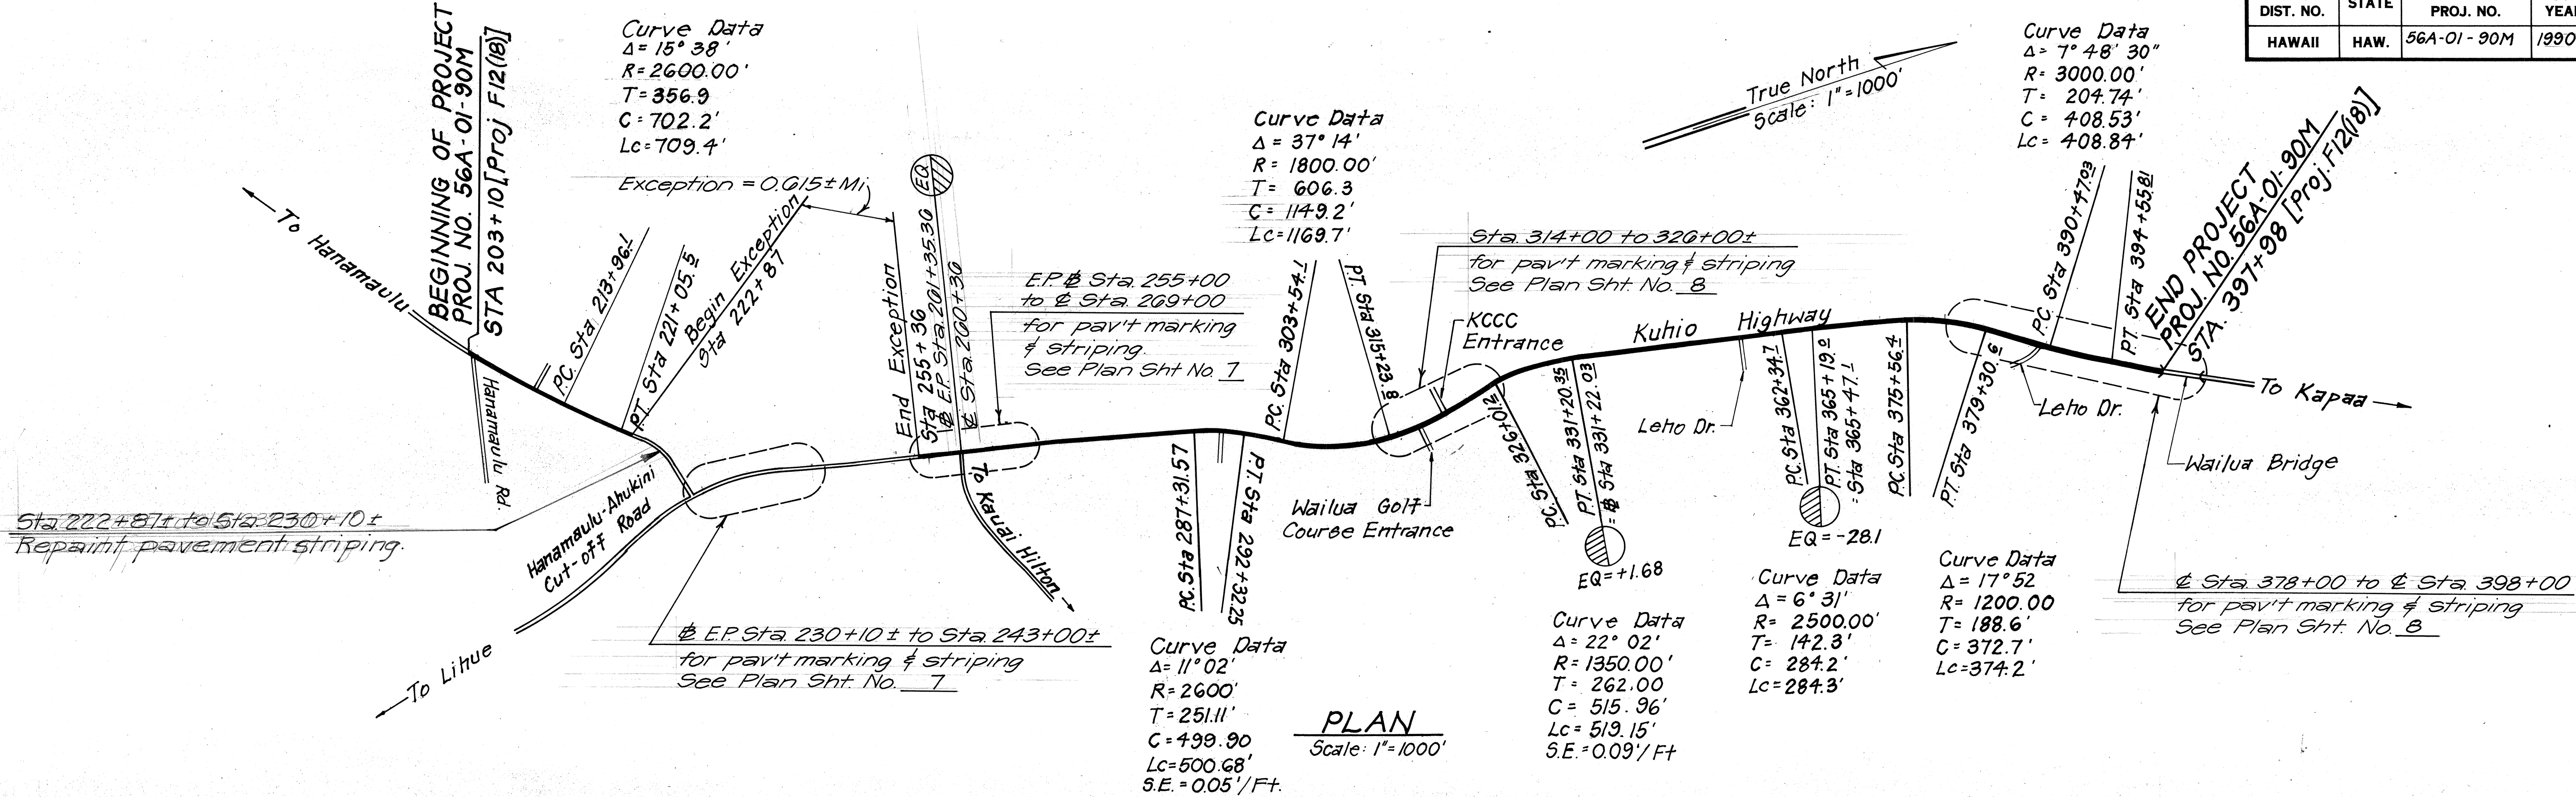


| FED. ROAD DIST. NO. | STATE | PROJ. NO.  | FISCAL YEAR | SHEET NO. | TOTAL SHEETS |
|---------------------|-------|------------|-------------|-----------|--------------|
| HAWAII              | HAW.  | 56A-01-90M | 1990        | 4         | 8            |

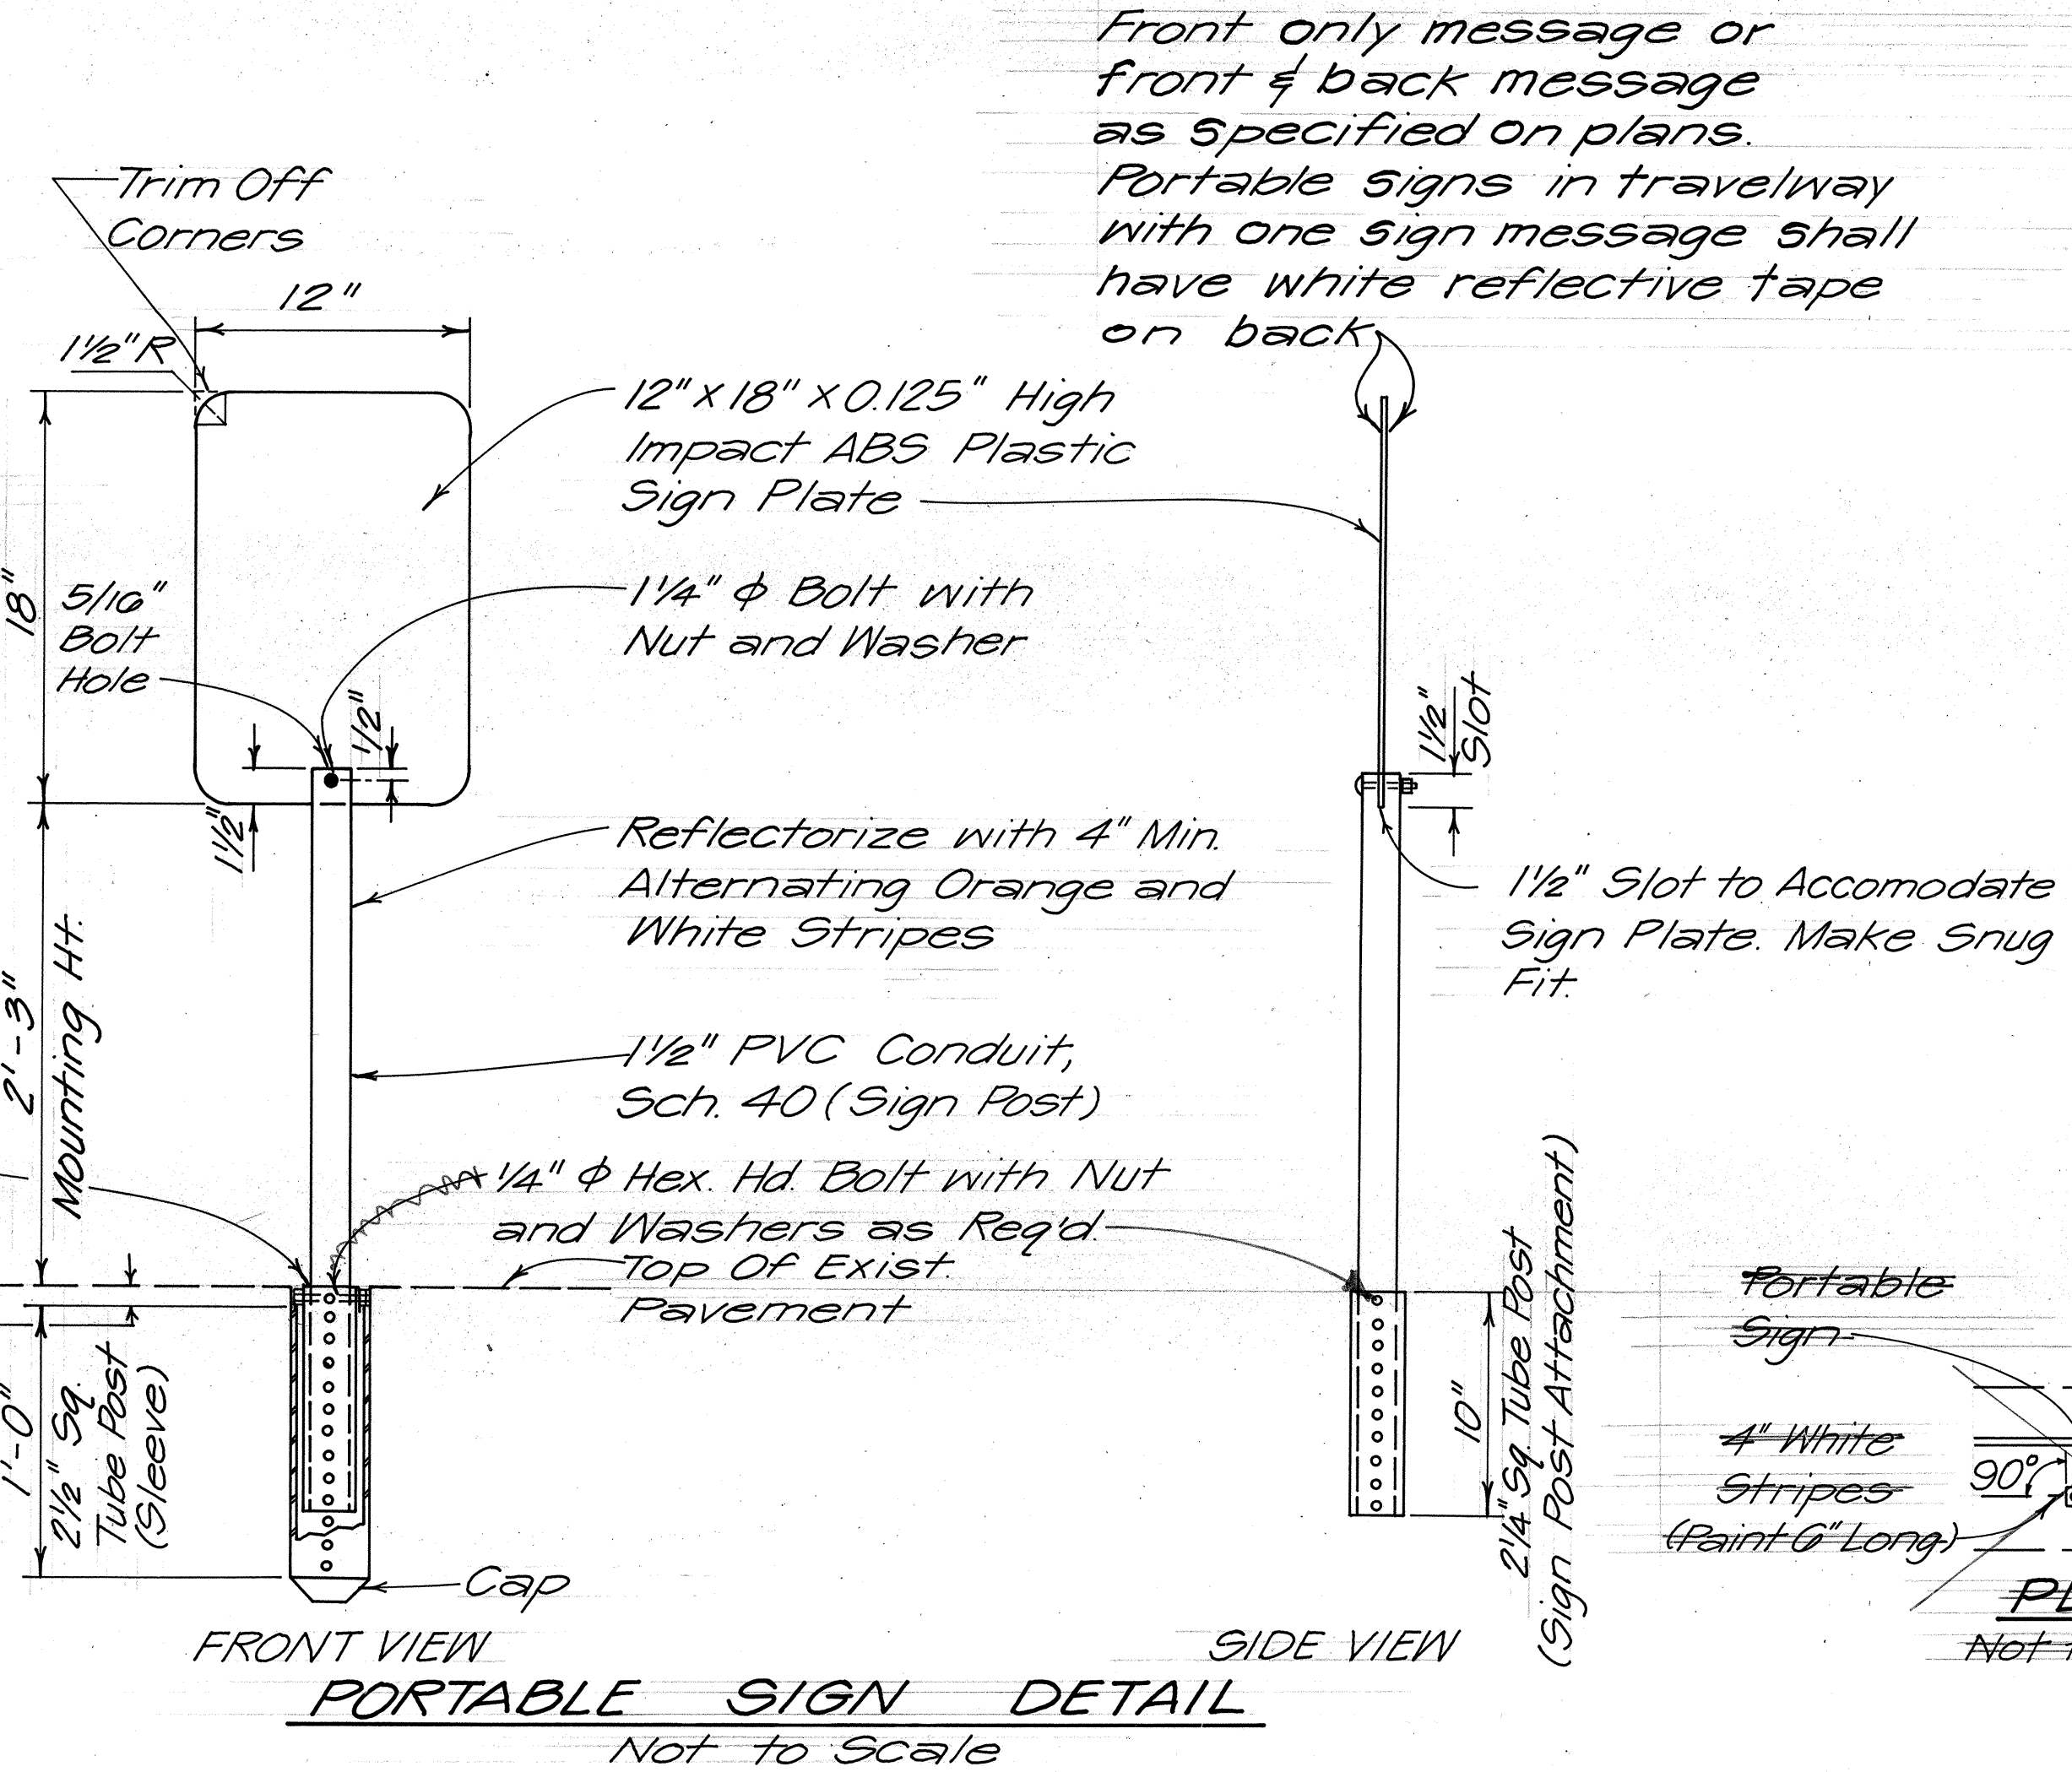

- NOTES:
1. All permanent sign posts shall be constructed in accordance with Dept. of Transportation, Highways Division "Standard Plan TE-03."
  2. Except where noted, portable signs shall conform to plans & specifications for regulatory & warning signs.
  3. Portable sign plates shall be 0.125" thick, high impact ABS plastic.
  4. Drill 5/16" φ bolt holes as shown on mounting detail this sheet.
  5. Word messages & symbols shall be visually centered.
  6. Sleeves for portable sign posts shall be incidental to Item 621.8000 - Portable Signs with Posts.

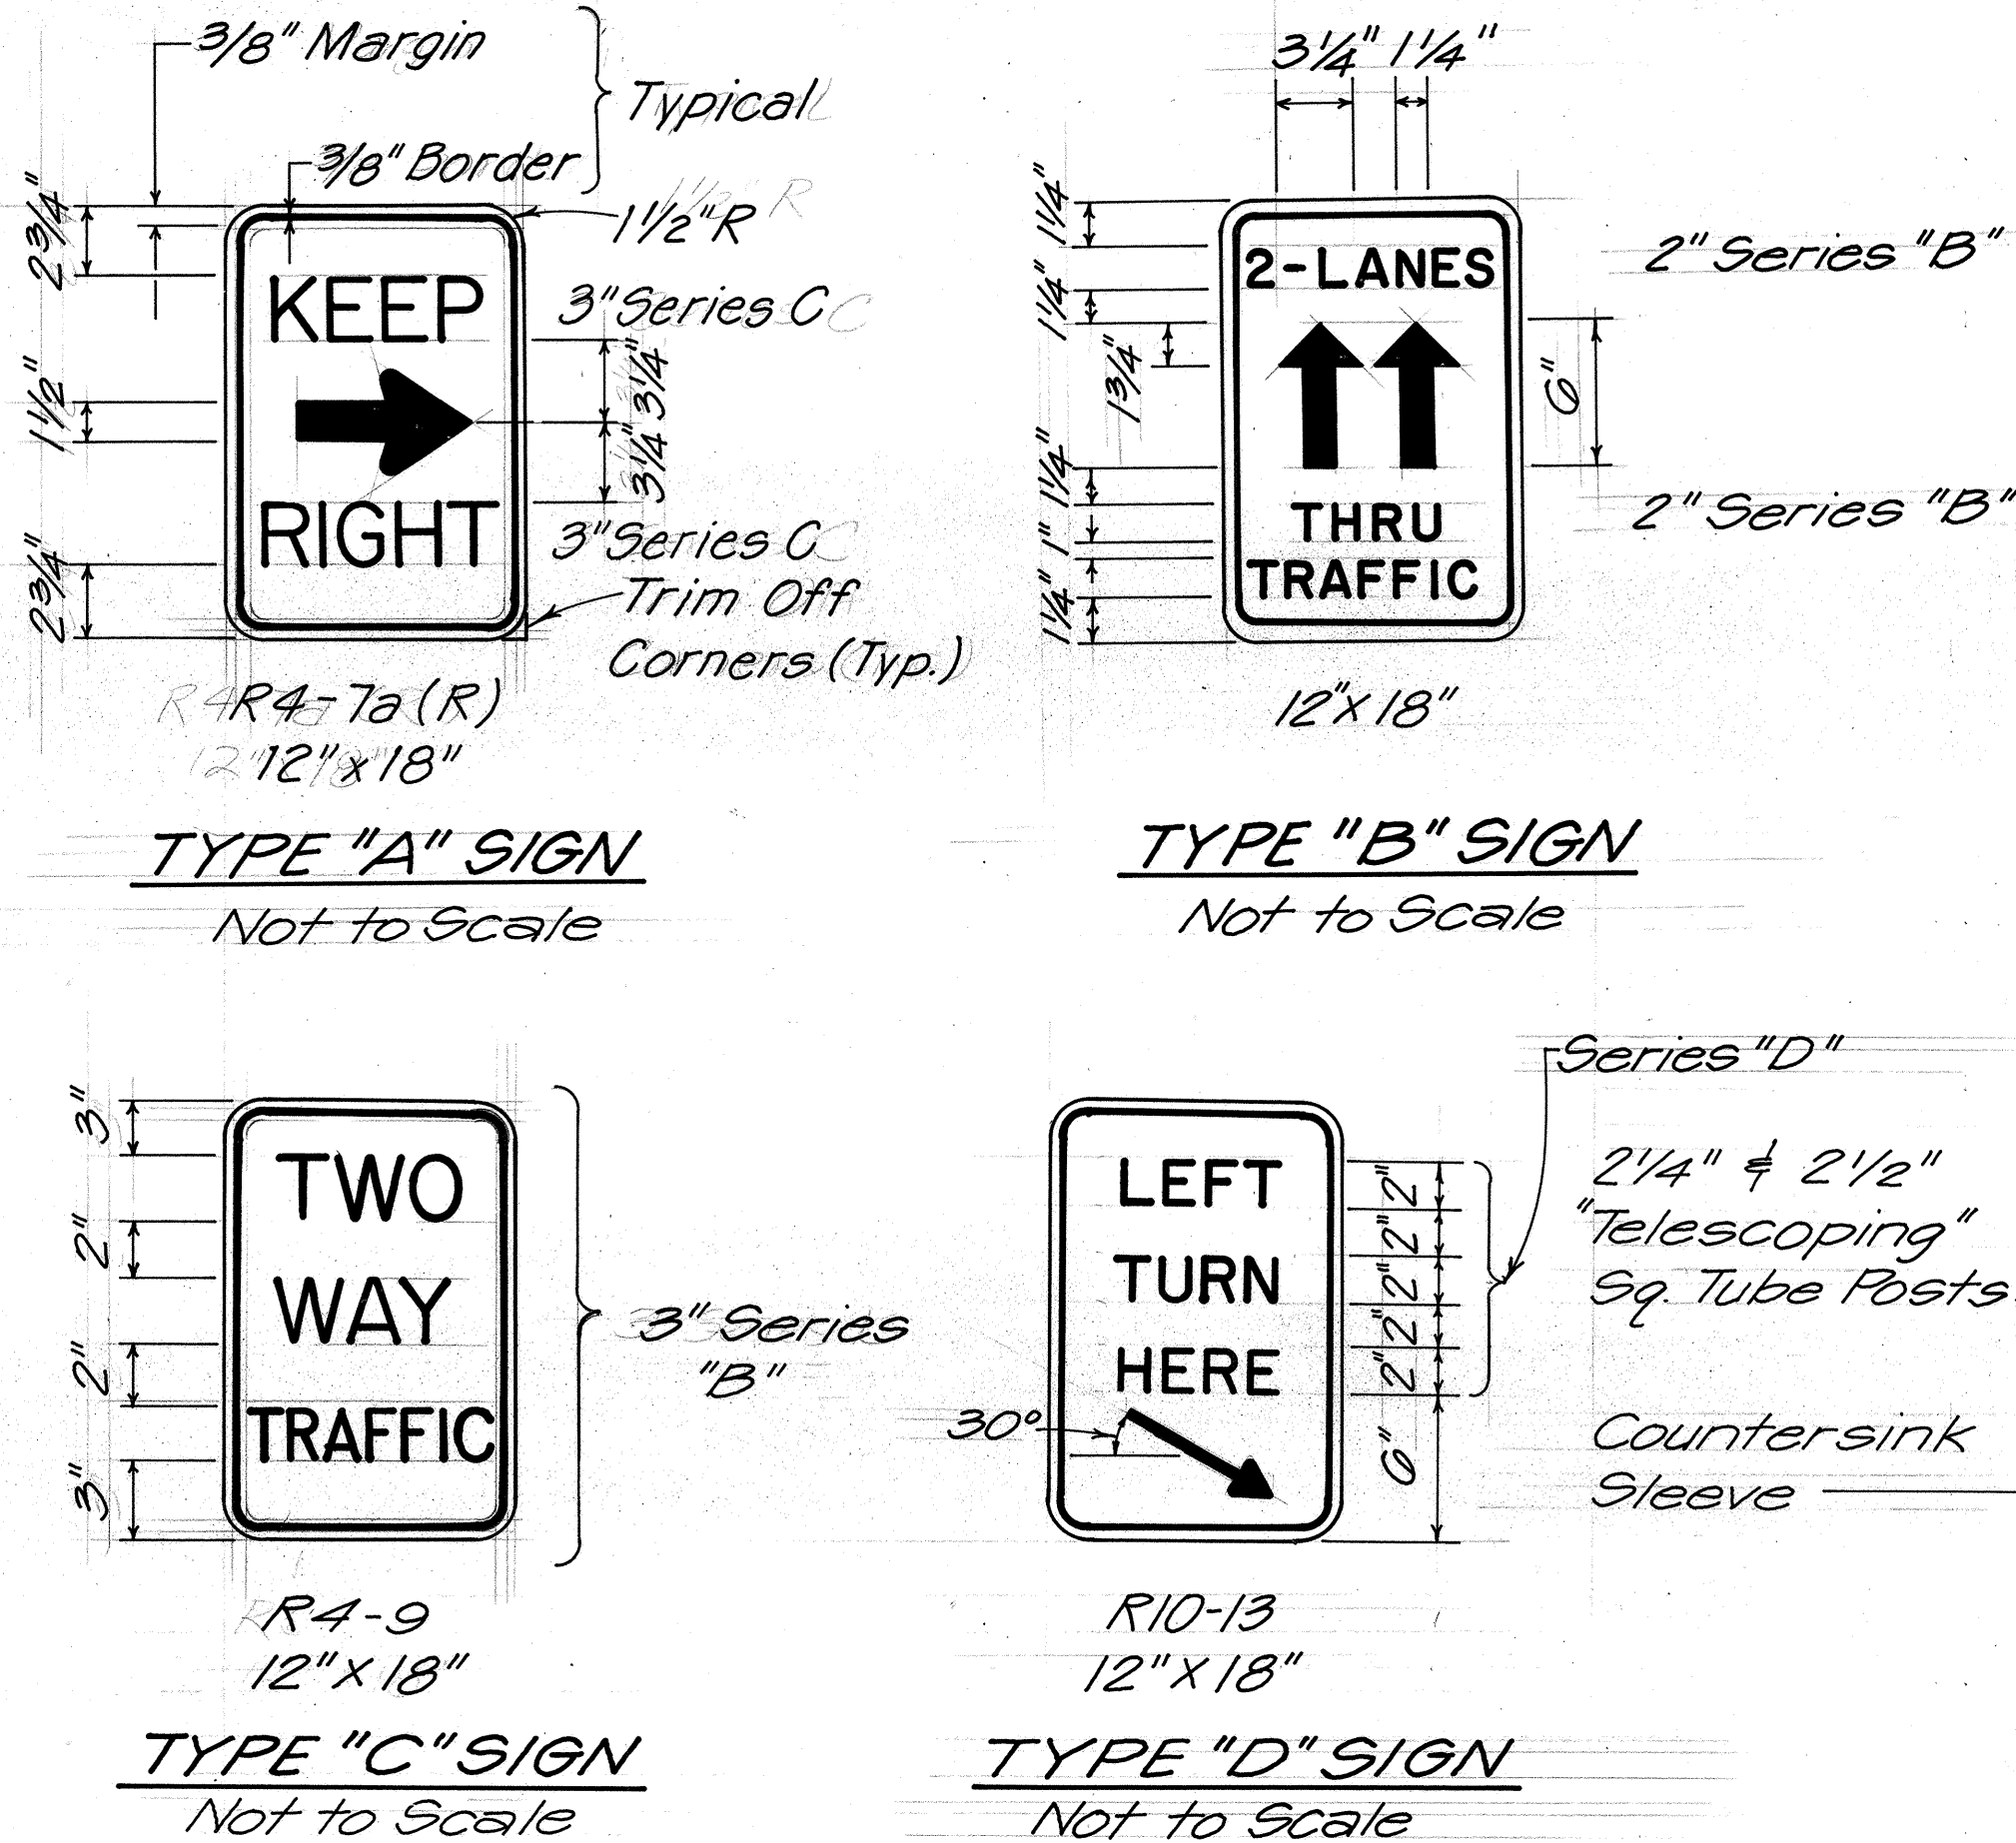

STATE OF HAWAII  
DEPARTMENT OF TRANSPORTATION  
HIGHWAYS DIVISION

PLAN & DETAIL

KUHIO HWY. RESURFACING  
HANAMAULU TO WAILUA BR.  
PROJ. NO. 56A-01-90M

Scale: As Noted Date: Jan 1990

SHEET NO. 1 OF 1 SHEETS