	INDEX TO DRAWINGS
SHEET NO.	DESCRIPTION
	TITLE SHEET
2	GENERAL NOTES
3 4	CULVERT DETAILS
4	CHANNEL IMPROVEMENTS
5-6	CHANNEL IMPROVEMENTS &
	MISCELLANEOUS DETAILS
7	STANDARD PLAN SUMMARY
	· · · · · · · · · · · · · · · · · · ·
and the second of the second o	
	<i>*</i>
,	
,	And the second s

STATE OF HAWAII

DEPARTMENT OF TRANSPORTATION
HIGHWAYS DIVISION
HONOLULU, HAWAII


KUHIO HIGHWAY

STORM DAMAGE RECONSTRUCTION

VICINITY OF M.P. 13.9 OUTBOUND

PROJECT NO. 56C-01-93M


DISTRICT OF KAWAIHAU
ISLAND OF KAUAI

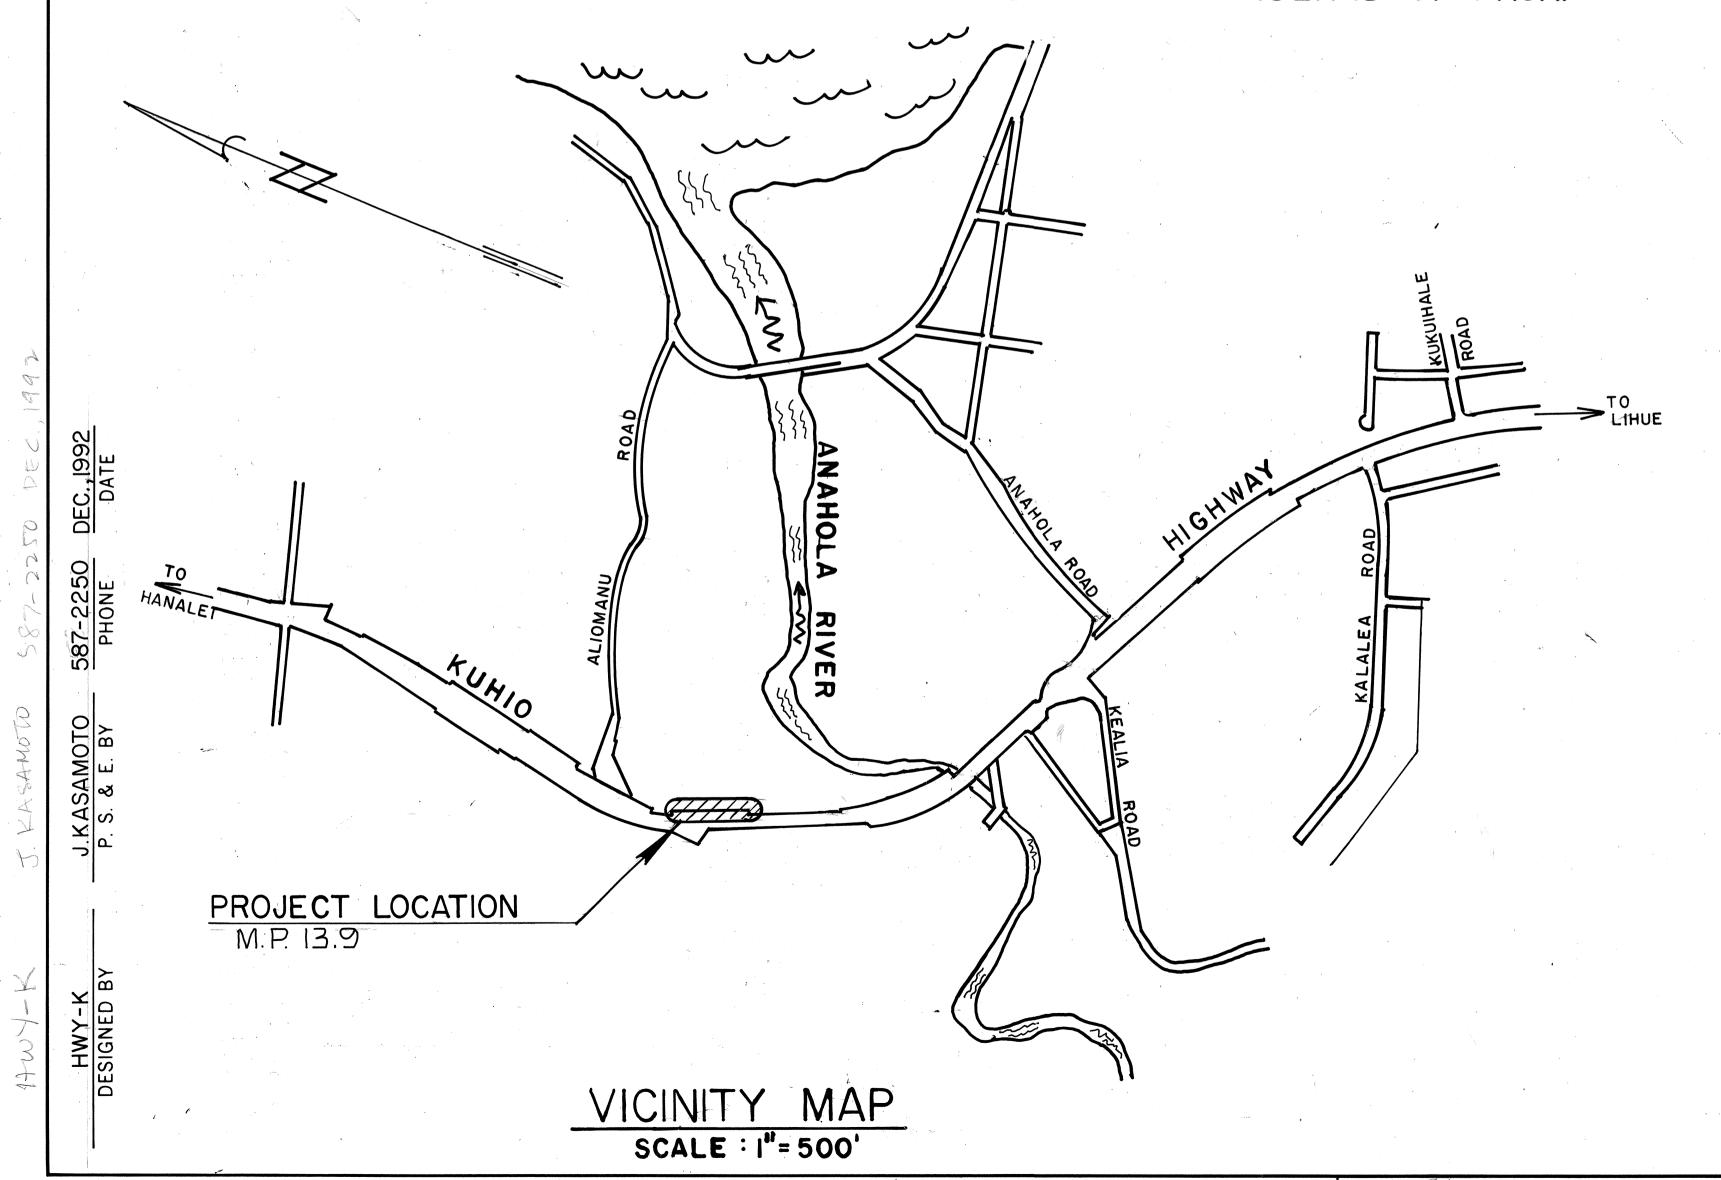


FED. ROAD DIST. NO. STATE PROJ. NO. FISCAL SHEET NO. SHEETS

HAWAII HAW. 56C-01-93M 1993 1 7



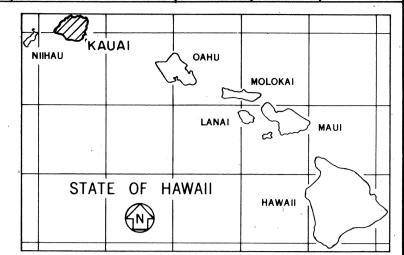

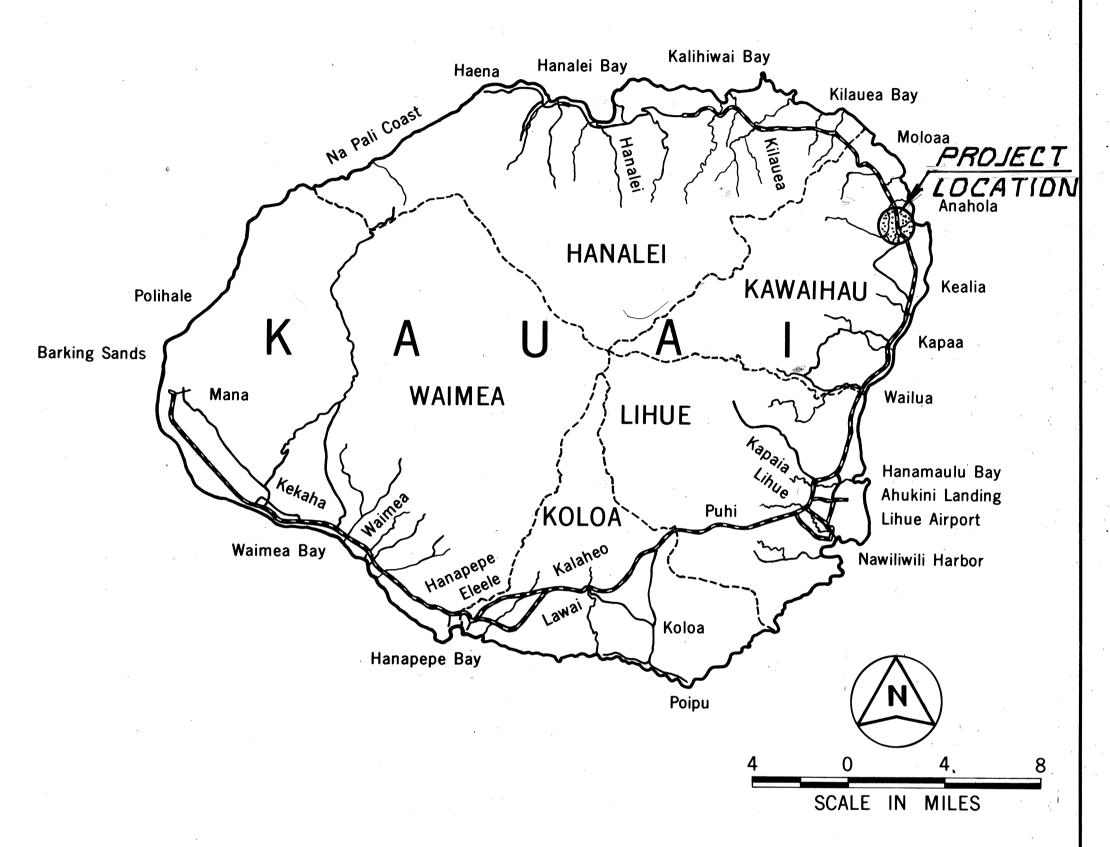

FEDERAL AID PROJECTS PREVIOUSLY CONSTRUCTED
OR UNDER CONSTRUCTION

MILE POST 13.9

CHANGES MADE DURING CONSTRUCTION HAVE BEEN INCORPORATED ON THESE PLANS EXCEPT CHANGES IN THE ORIGINAL THEORETICAL QUANTITIES, FOR ACTUAL QUANTITIES, REFER TO PROJECT LEDGER AND/OR COMPUTATION BOOK.

RESIDENT ENGINEER JUMPS

1-24-95 DATE

DEPARTMENT OF TRANSPORTATION
STATE OF HAWAII

APPROVED:

APPROVED:

DIR. OF TRANSPORTATION

DATE