


FED. ROAD DIST. NO.	STATE	PROJ. NO.	FISCAL YEAR	SHEET NO.	TOTAL SHEETS
HAWAII	HAW.	56A-02-93	1994	7	15


Notes:

1. Electrical/telephone facilities to be relocated by others.
2. For roadway improvement work, see Plan Sht. No. 6.
3. For water facilities relocation work, see Plan Sht. No. 6.
4. For legend, see Plan Sht. No. 3.
5. For traffic signal plans, see Plan Sht. Nos. 12-15.

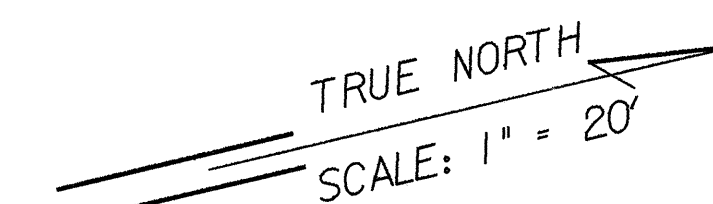

**LEGEND FOR
AS-BUILT POSTINGS**

	Squiggly line for as-built deletion
	Double line for as-built deletion
Roadway	Text for as-built posting

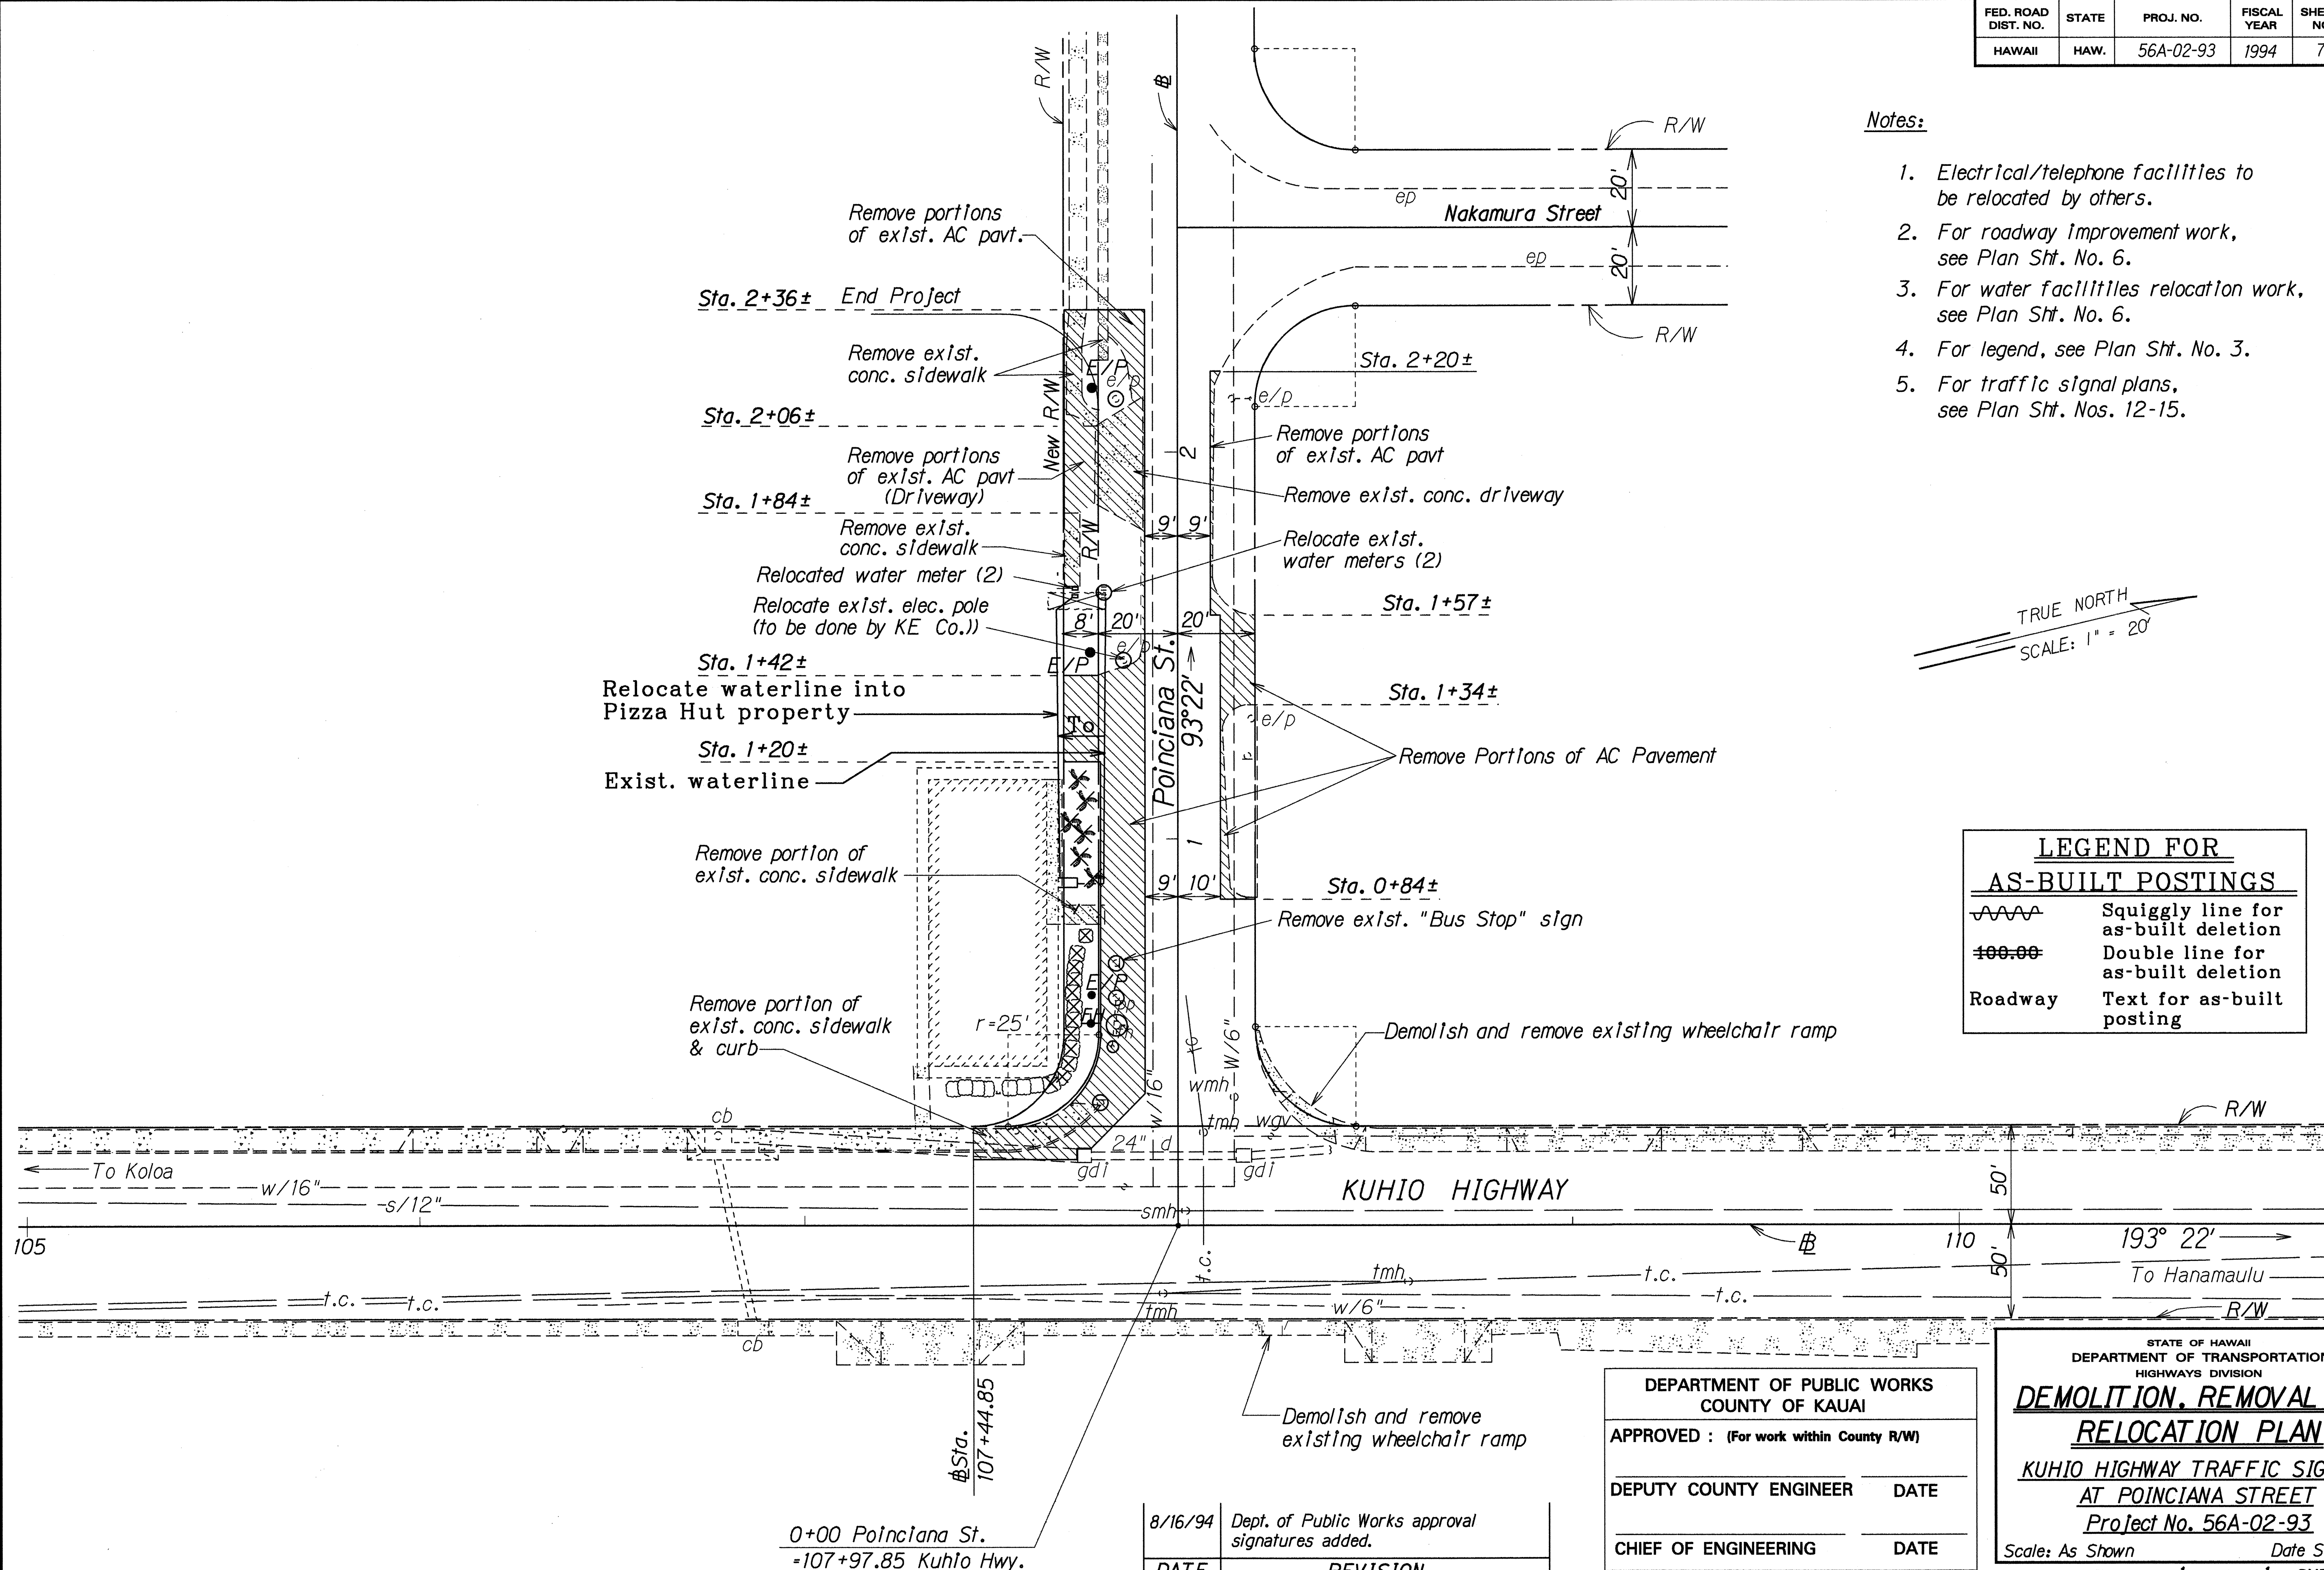

ORIGINAL PLAN	DATE
SURVEY LOCATED BY	8/12/94
DRAWN BY	
NOTED BY	
DESIGNED BY	
CHECKED BY	
QUANTITIES BY	
APPROVED BY	

0+00 Poinciana St.
=107+97.85 Kuhio Hwy.

8/16/94	Dept. of Public Works approval signatures added.
DATE	REVISION

DEPARTMENT OF PUBLIC WORKS COUNTY OF KAUAI	
APPROVED : (For work within County R/W)	
DEPUTY COUNTY ENGINEER	DATE
CHIEF OF ENGINEERING	DATE

STATE OF HAWAII DEPARTMENT OF TRANSPORTATION HIGHWAYS DIVISION	
DEMOLITION, REMOVAL AND RELOCATION PLAN	
KUHIOW HIGHWAY TRAFFIC SIGNALS AT POINCIANA STREET	
Project No. 56A-02-93	
Scale: As Shown	Date: Sept., 1993
SHEET No. 1 OF 1 SHEETS	

"AS-BUILT" 7R