



FED. ROAD DIST. NO.	STATE	PROJ. NO.	FISCAL YEAR	SHEET NO.	TOTAL SHEETS
HAWAII	HAW.	56A-02-93	1994	12	15

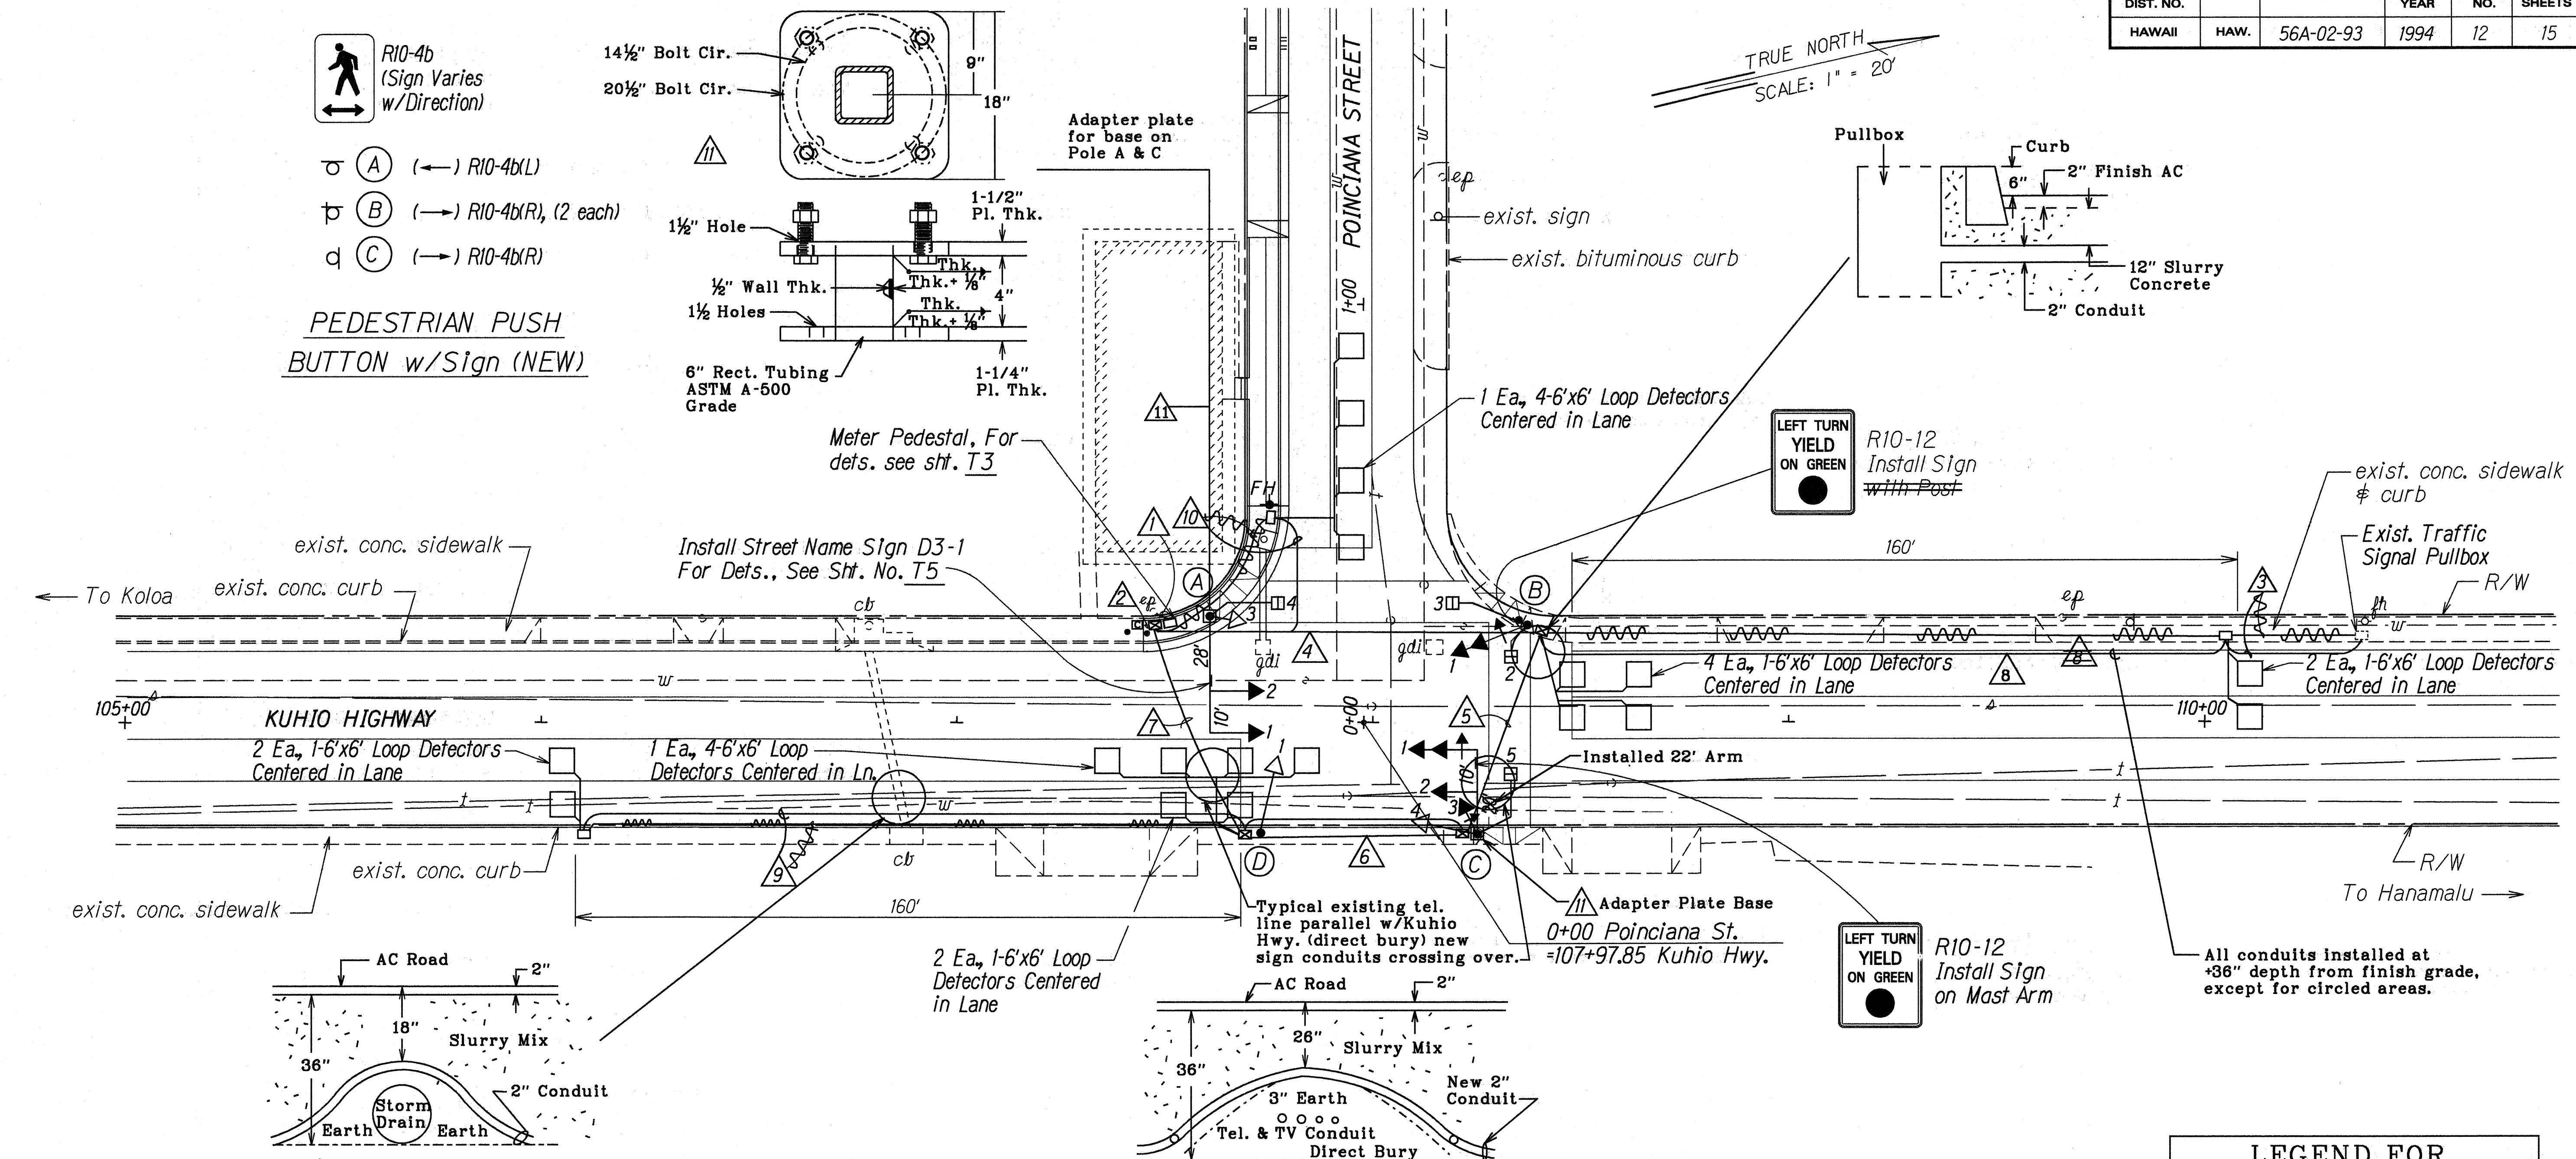

DESIGNED BY	DATE	1/94
CHECKED BY		
NOTED BY		
TRACED BY		
DESIGNED BY		
CHECKED BY		
NOTED BY		
TRACED BY		

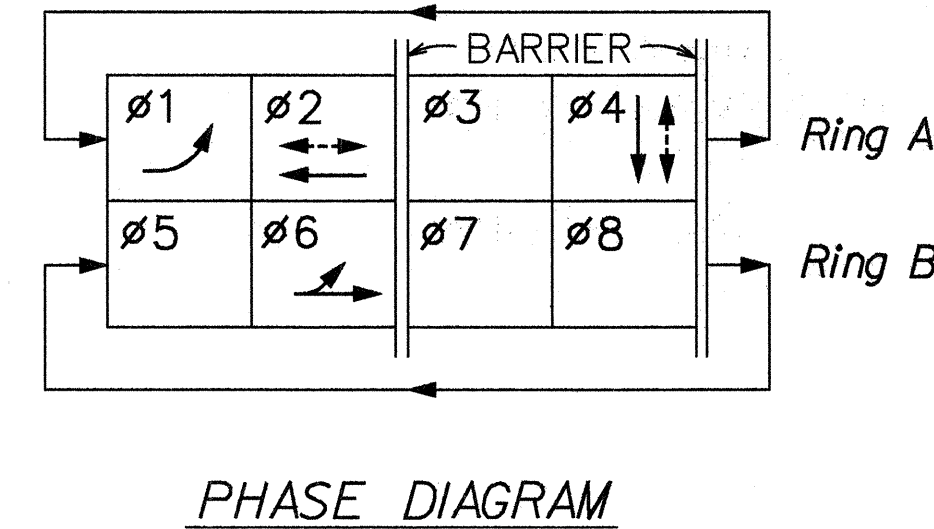

LEGEND FOR AS-BUILT POSTINGS

	Squiggly line for as-built deletion
	Double line for as-built deletion
	Text for as-built posting

STATE OF HAWAII
DEPARTMENT OF TRANSPORTATION
HIGHWAYS DIVISION

TRAFFIC SIGNAL PLAN

Kuhio Highway Traffic Signals
At Poinciana Street
Project No. 56A-02-93

Scale: As Shown Date May, 1994

SHEET No. T4 OF 7 SHEETS

6/7/94	Revised Traffic Signal Plan.
DATE	REVISION