

INDEX TO DRAWINGS	
SHEET NO.	DESCRIPTION
1	TITLE SHEET
2	DRAINAGE PLAN & DETAILS

STATE OF HAWAII

DEPARTMENT OF TRANSPORTATION

HIGHWAYS DIVISION

HONOLULU, HAWAII

"AS-BUILT"

PLANS FOR

KUHIO HIGHWAY

DRAINAGE REPAIRS


M.P. 24.52 AND M.P. 24.68

PROJECT NO. 56D-01-95M




DISTRICT OF HANAIEI

ISLAND OF KAUAI


FED. ROAD DIST. NO.	STATE	PROJ. NO.	FISCAL YEAR	SHEET NO.	TOTAL SHEETS
HAWAII	HAW.	56D-01-95M	1995	1	2

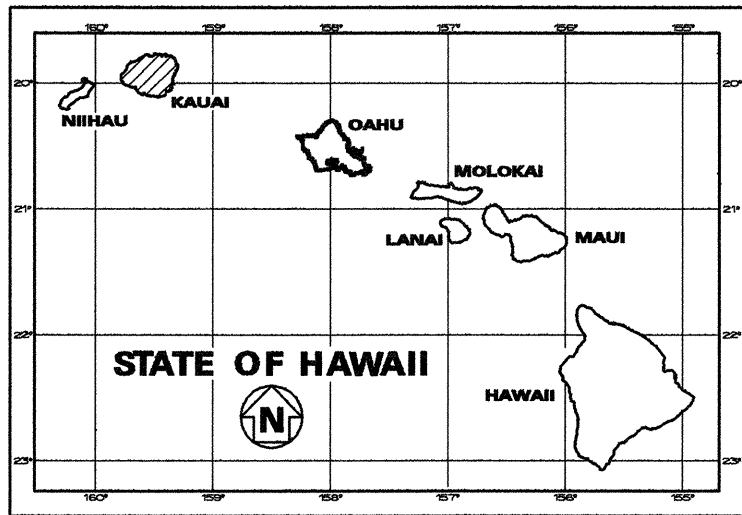

LOCATION  
OF PROJECT

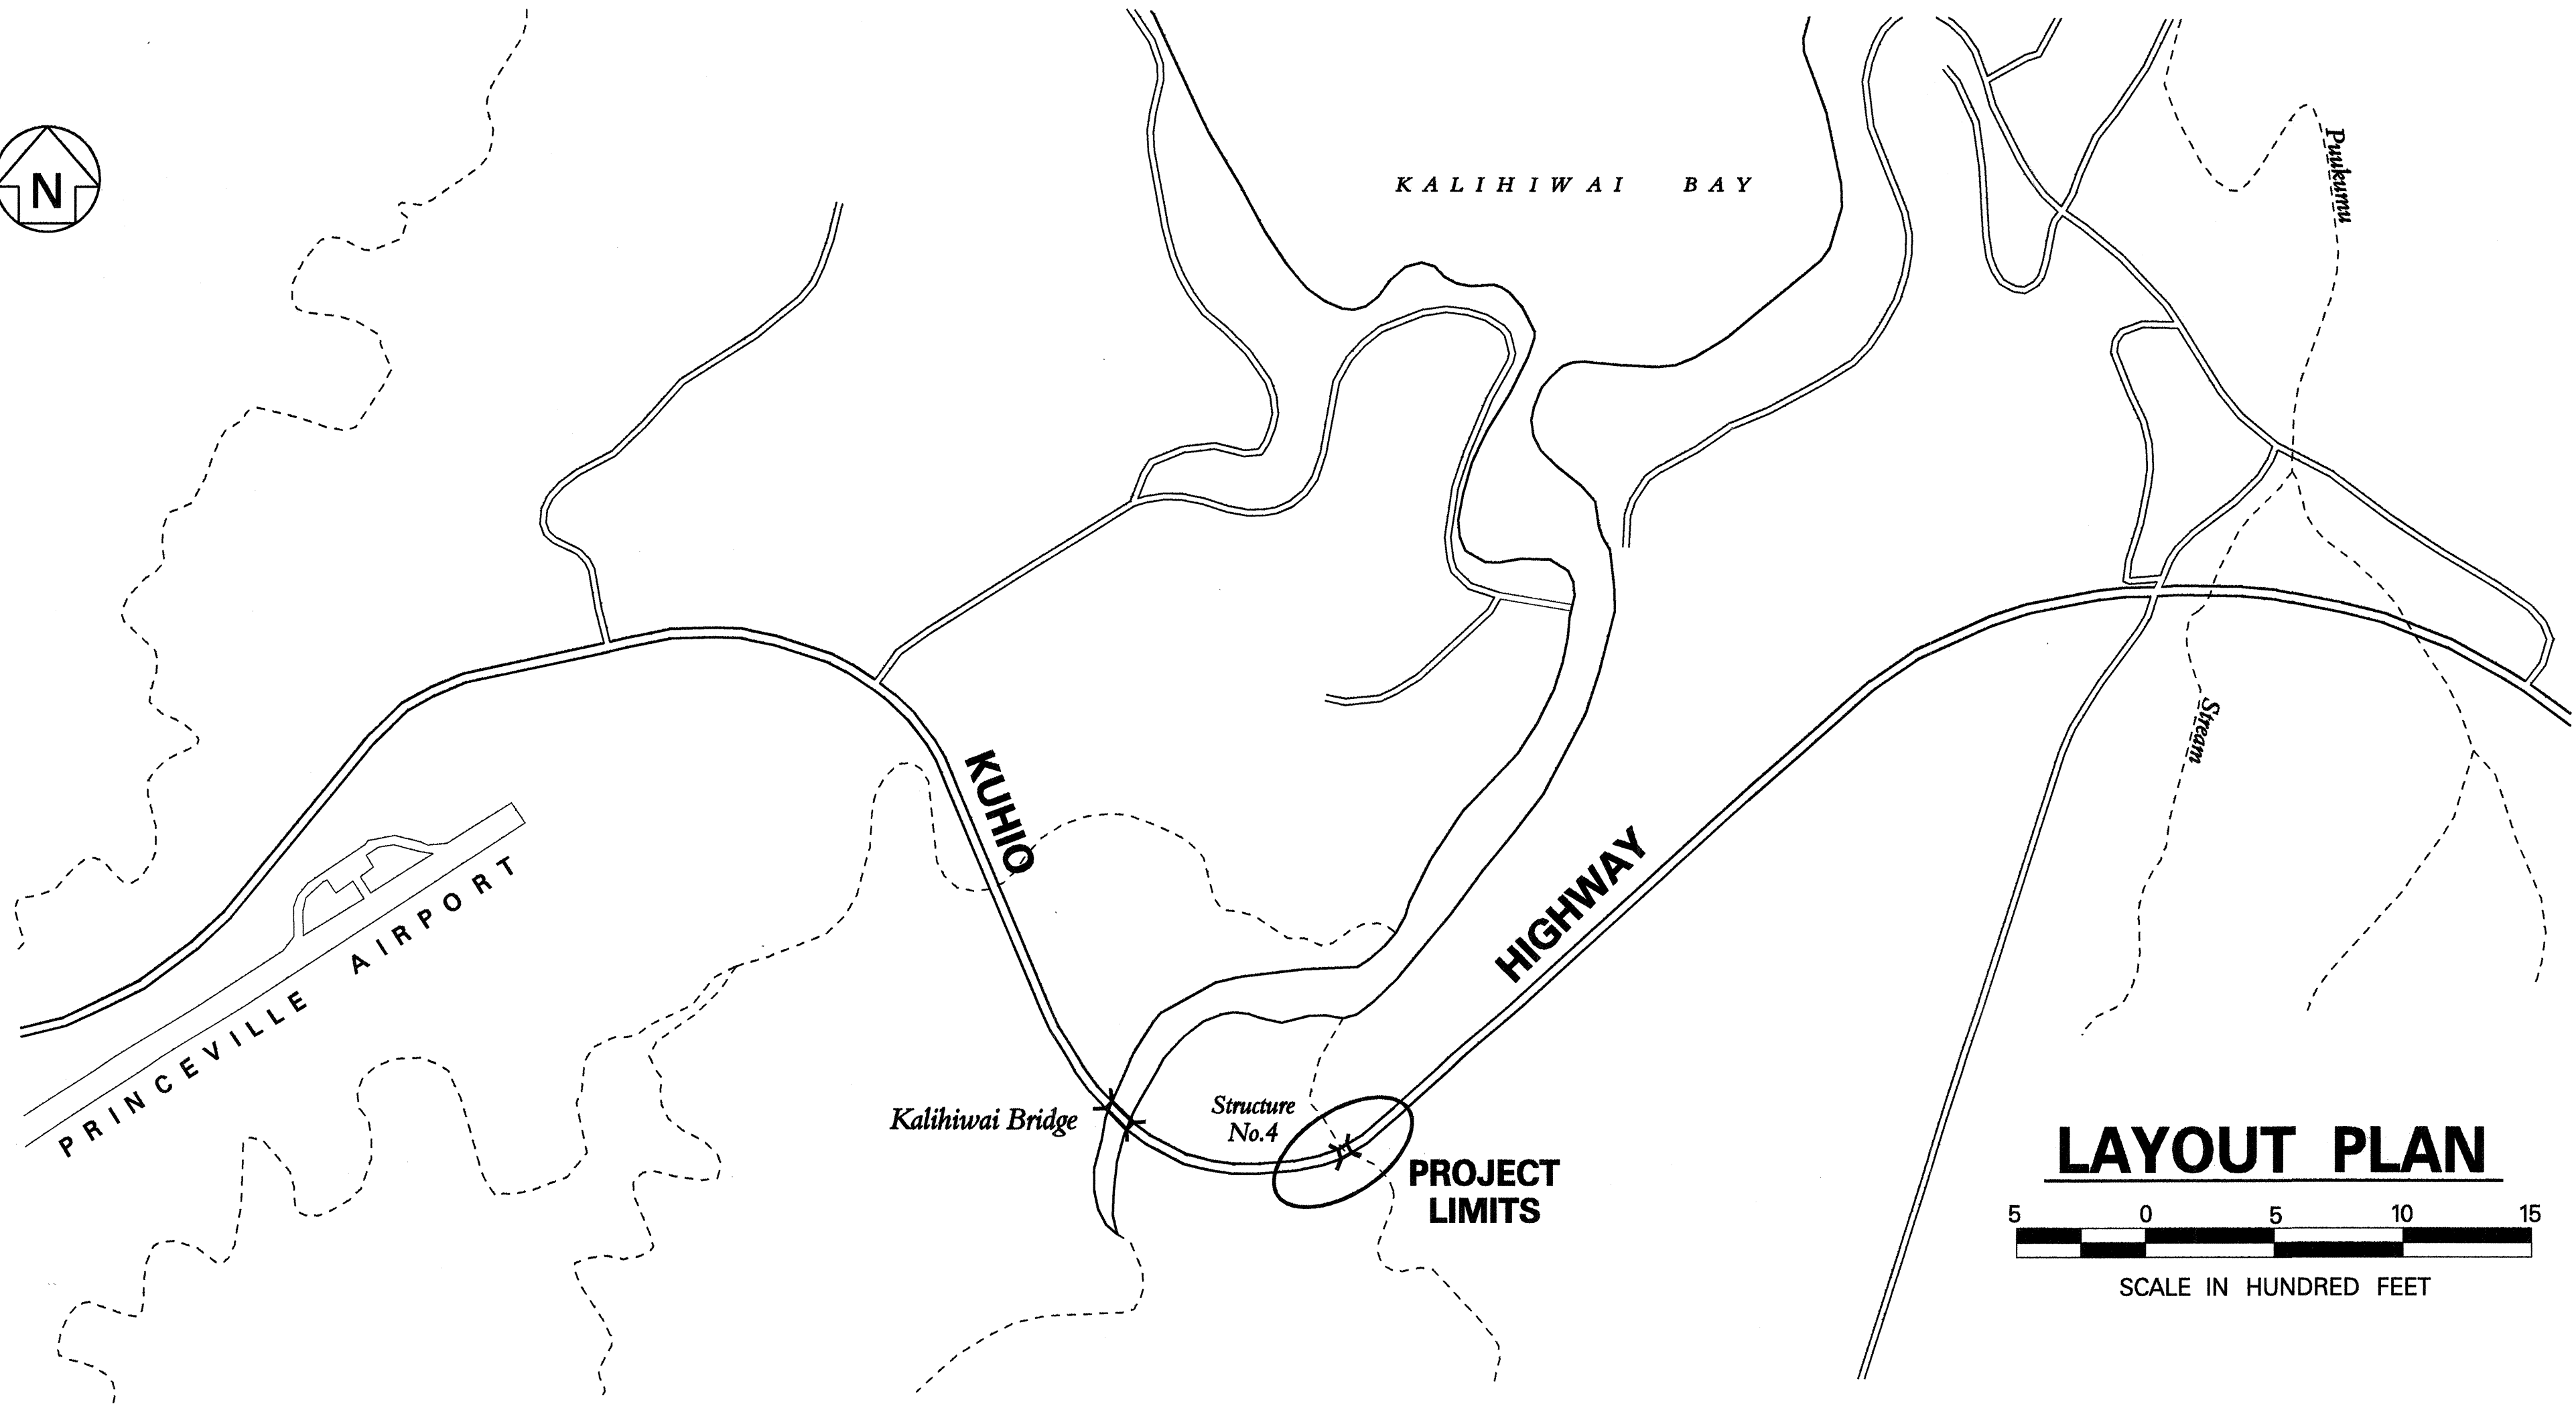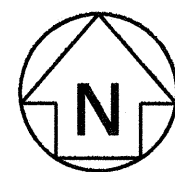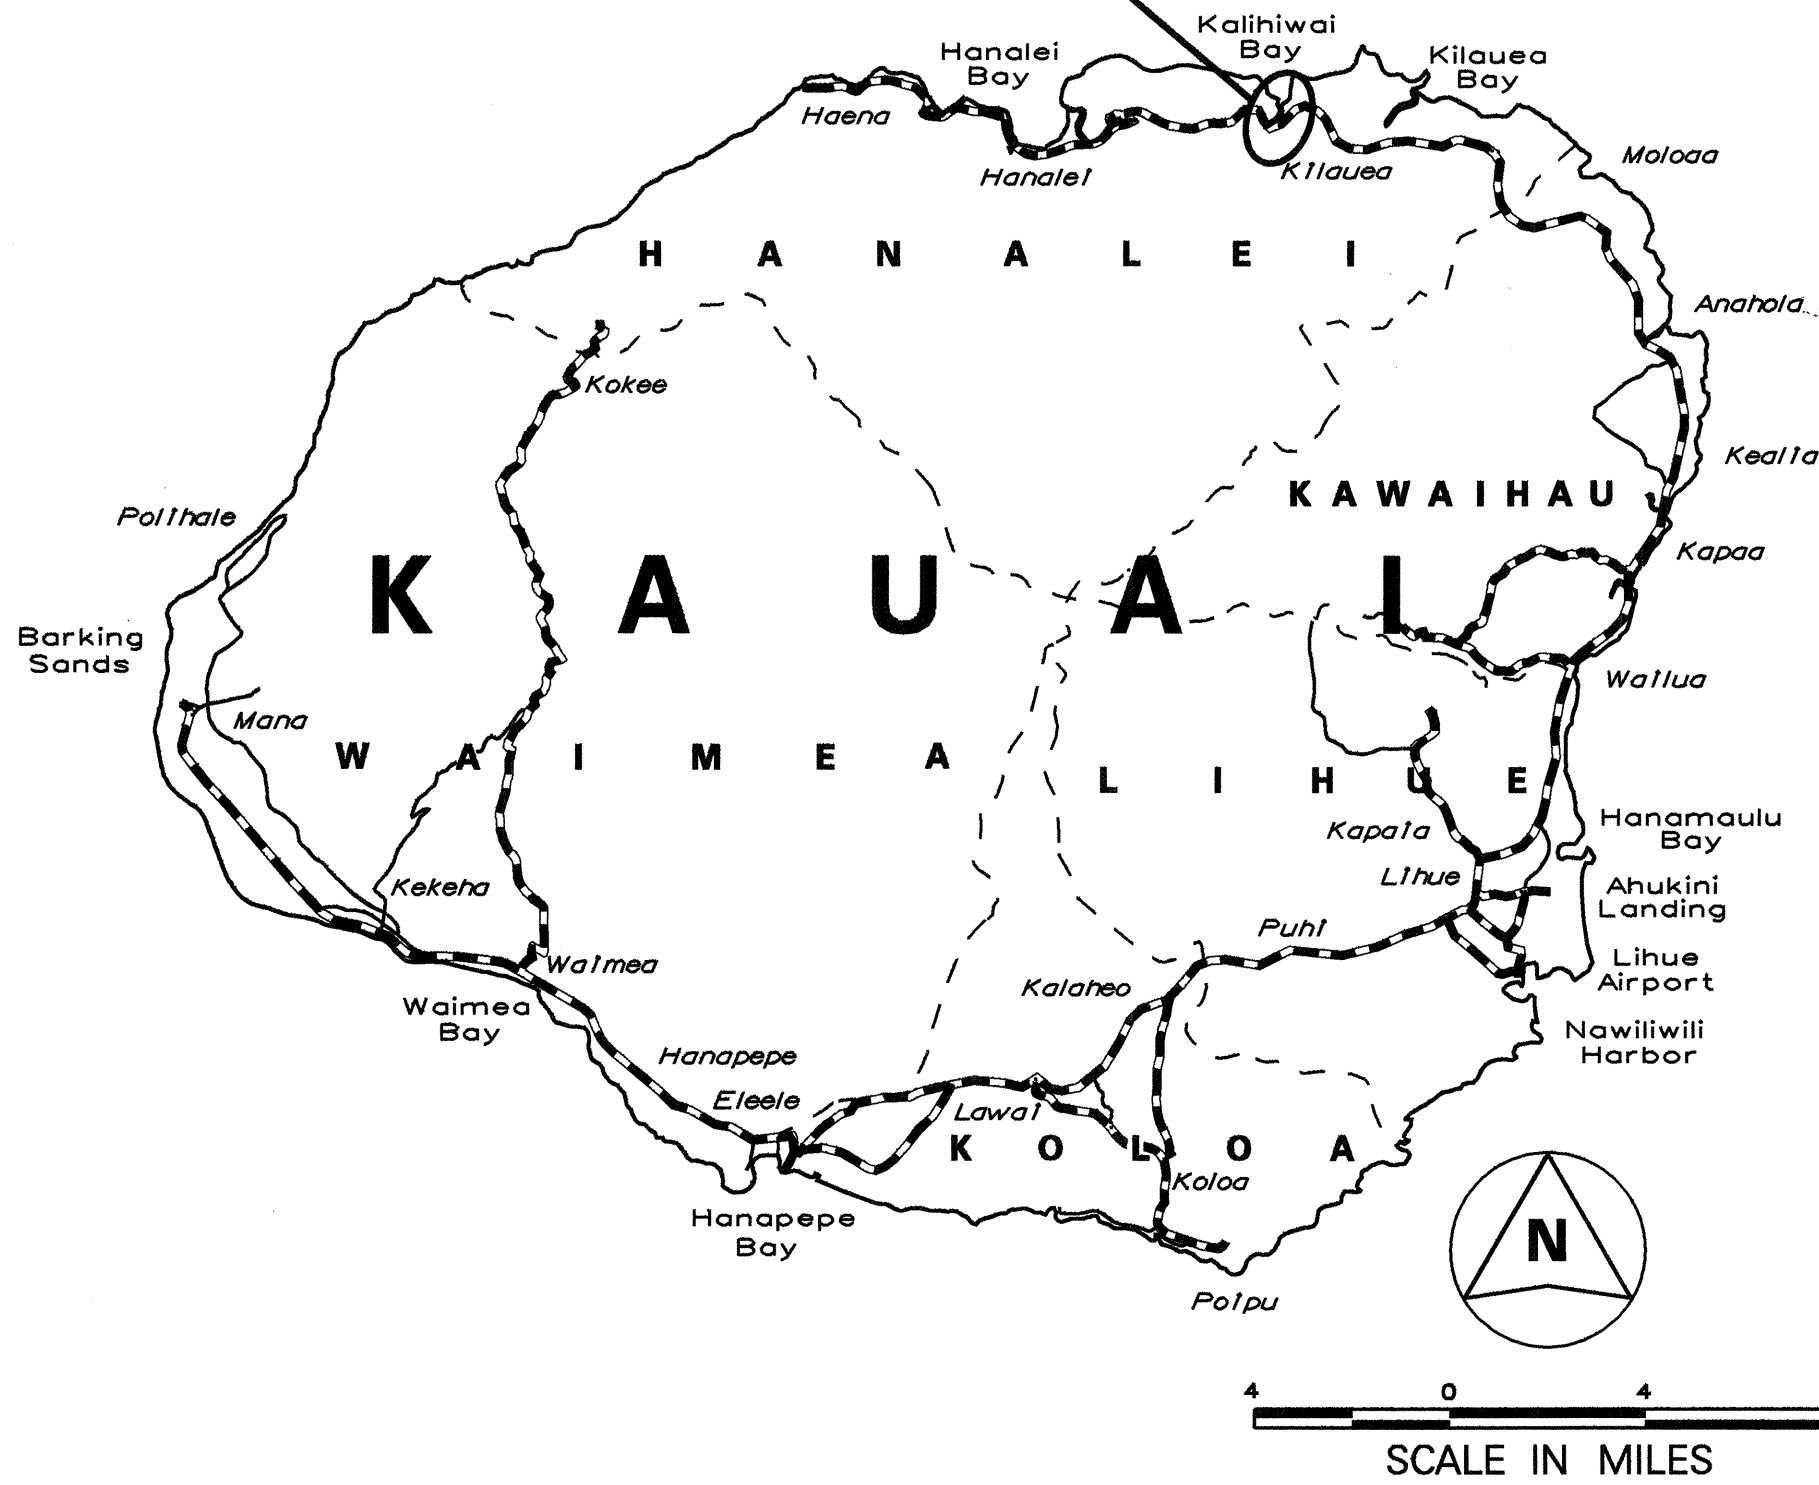

LAYOUT PLAN

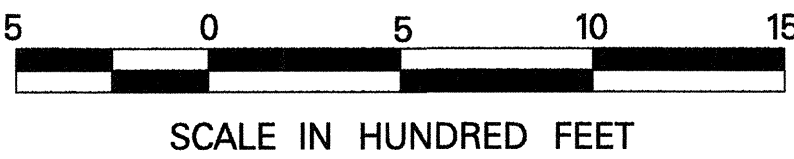

— FEDERAL AID PROJECTS PREVIOUSLY CONSTRUCTED  
OR UNDER CONSTRUCTION

MILE POST 24.52 AND MILE POST 24.68

NO SIGNIFICANT CHANGES WERE MADE DURING  
CONSTRUCTION ON THESE PLANS. FOR ACTUAL  
QUANTITIES, REFER TO PROJECT LEDGER AND/OR  
COMPUTATION BOOK.

*Demetrius A. Torres*  
RESIDENT ENGINEER

12/27/95  
DATE

DEPARTMENT OF TRANSPORTATION STATE OF HAWAII	
APPROVED:	
<i>Dezign Skye</i>	4/20/95
DIR. OF TRANSPORTATION	DATE

DESIGN UNIT "C"  
DESIGNED BY

R. HIRONAKA  
P.S. & E. BY

587-2250  
PHONE

MARCH, 1995  
DATE