
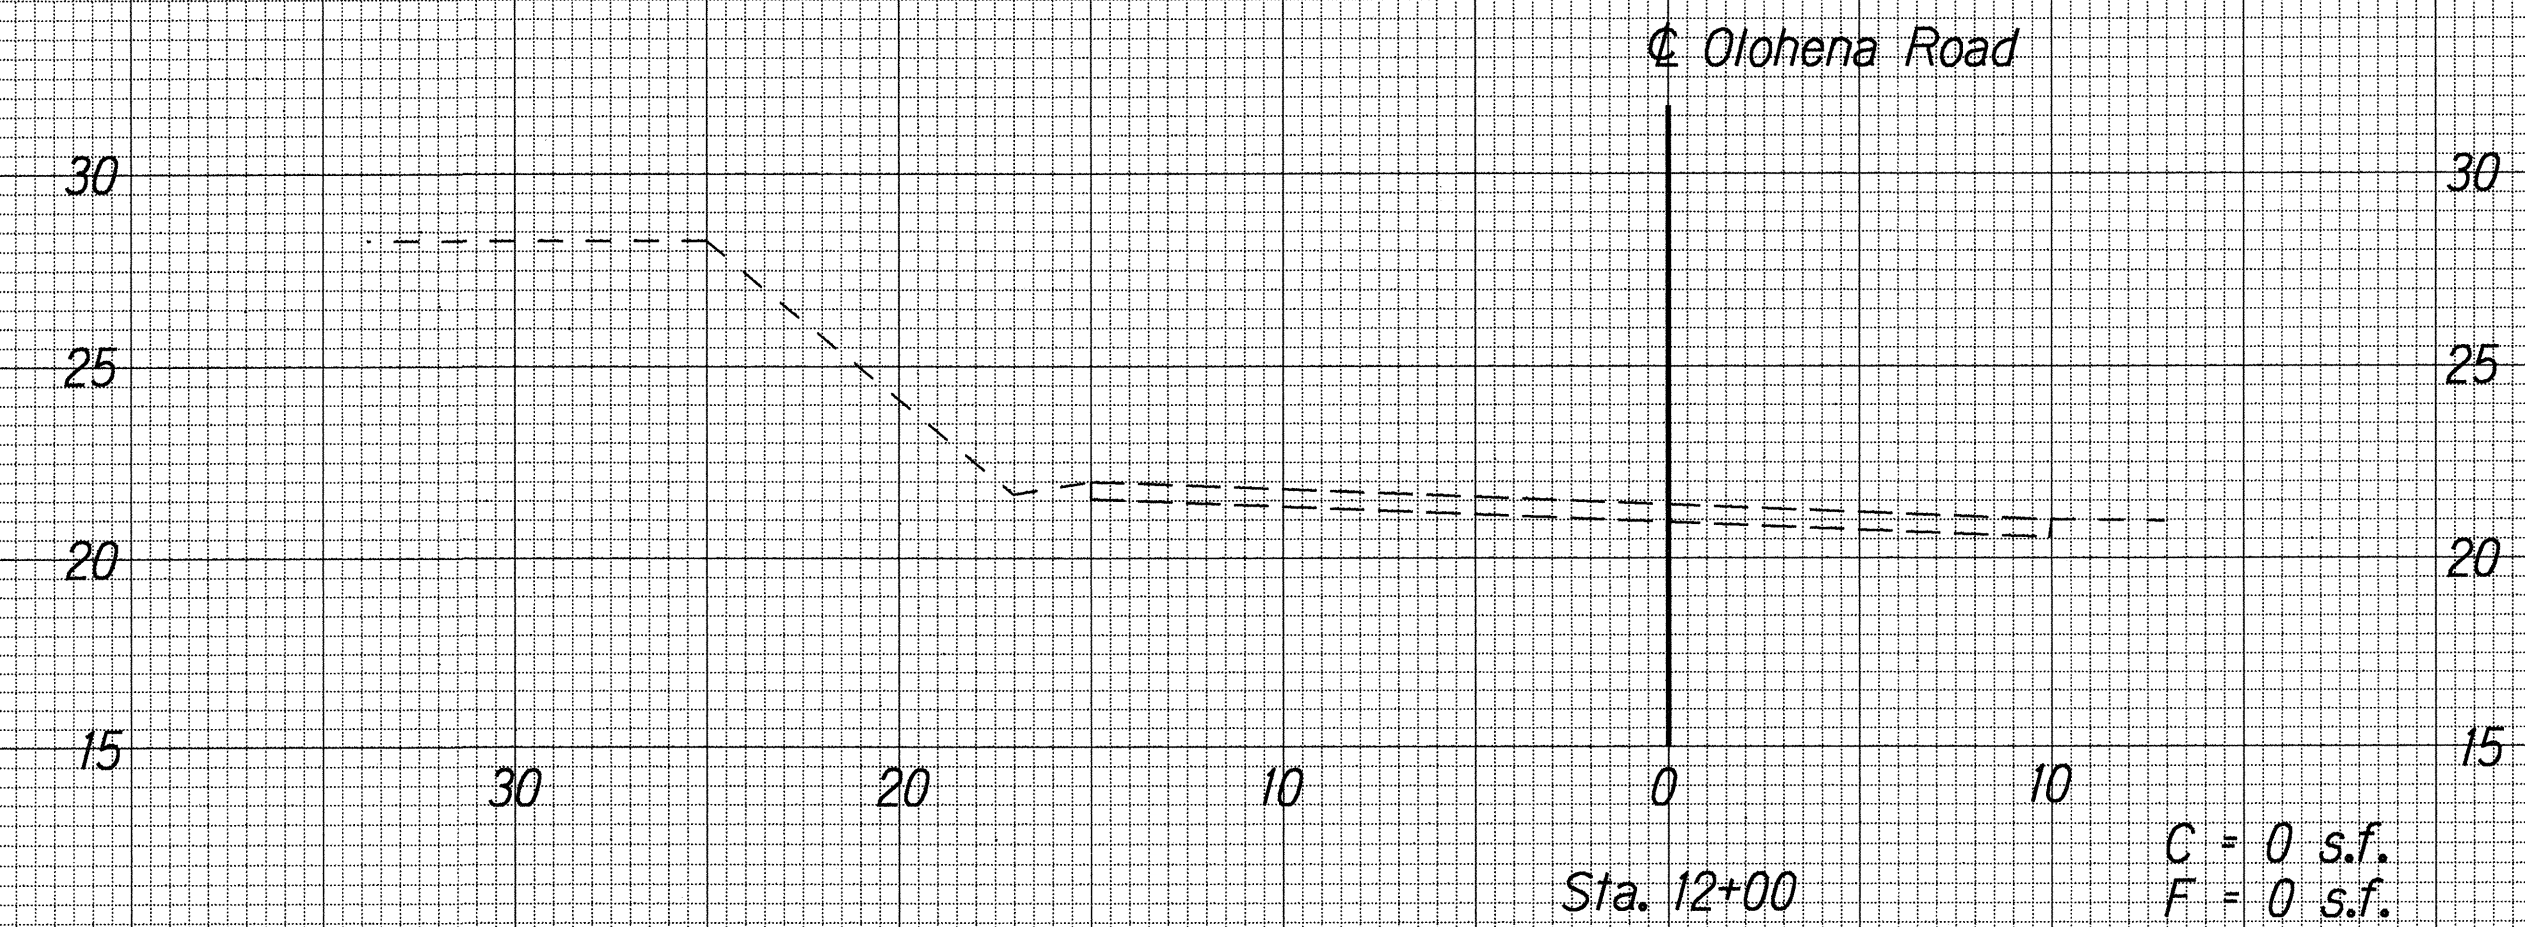
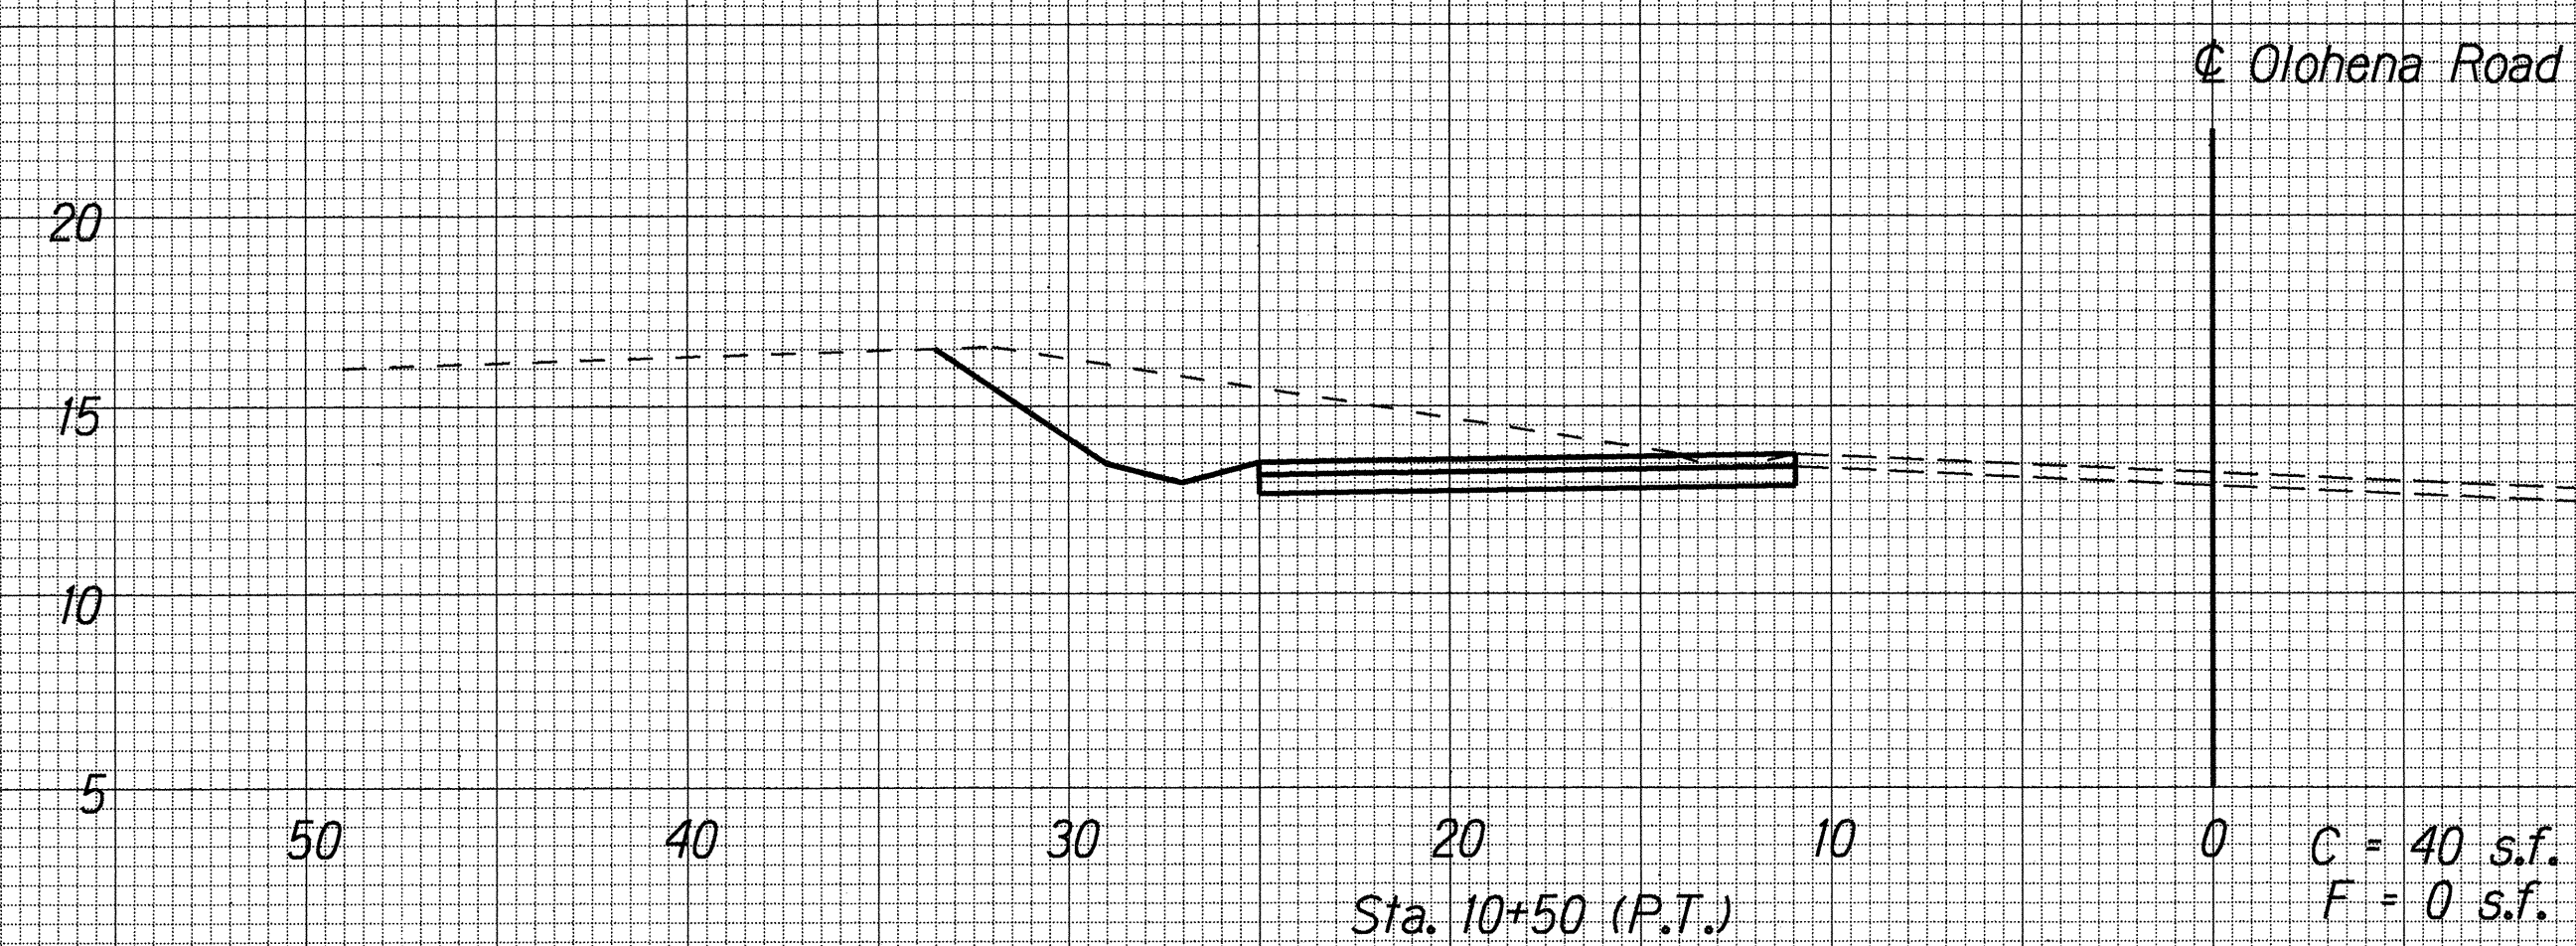
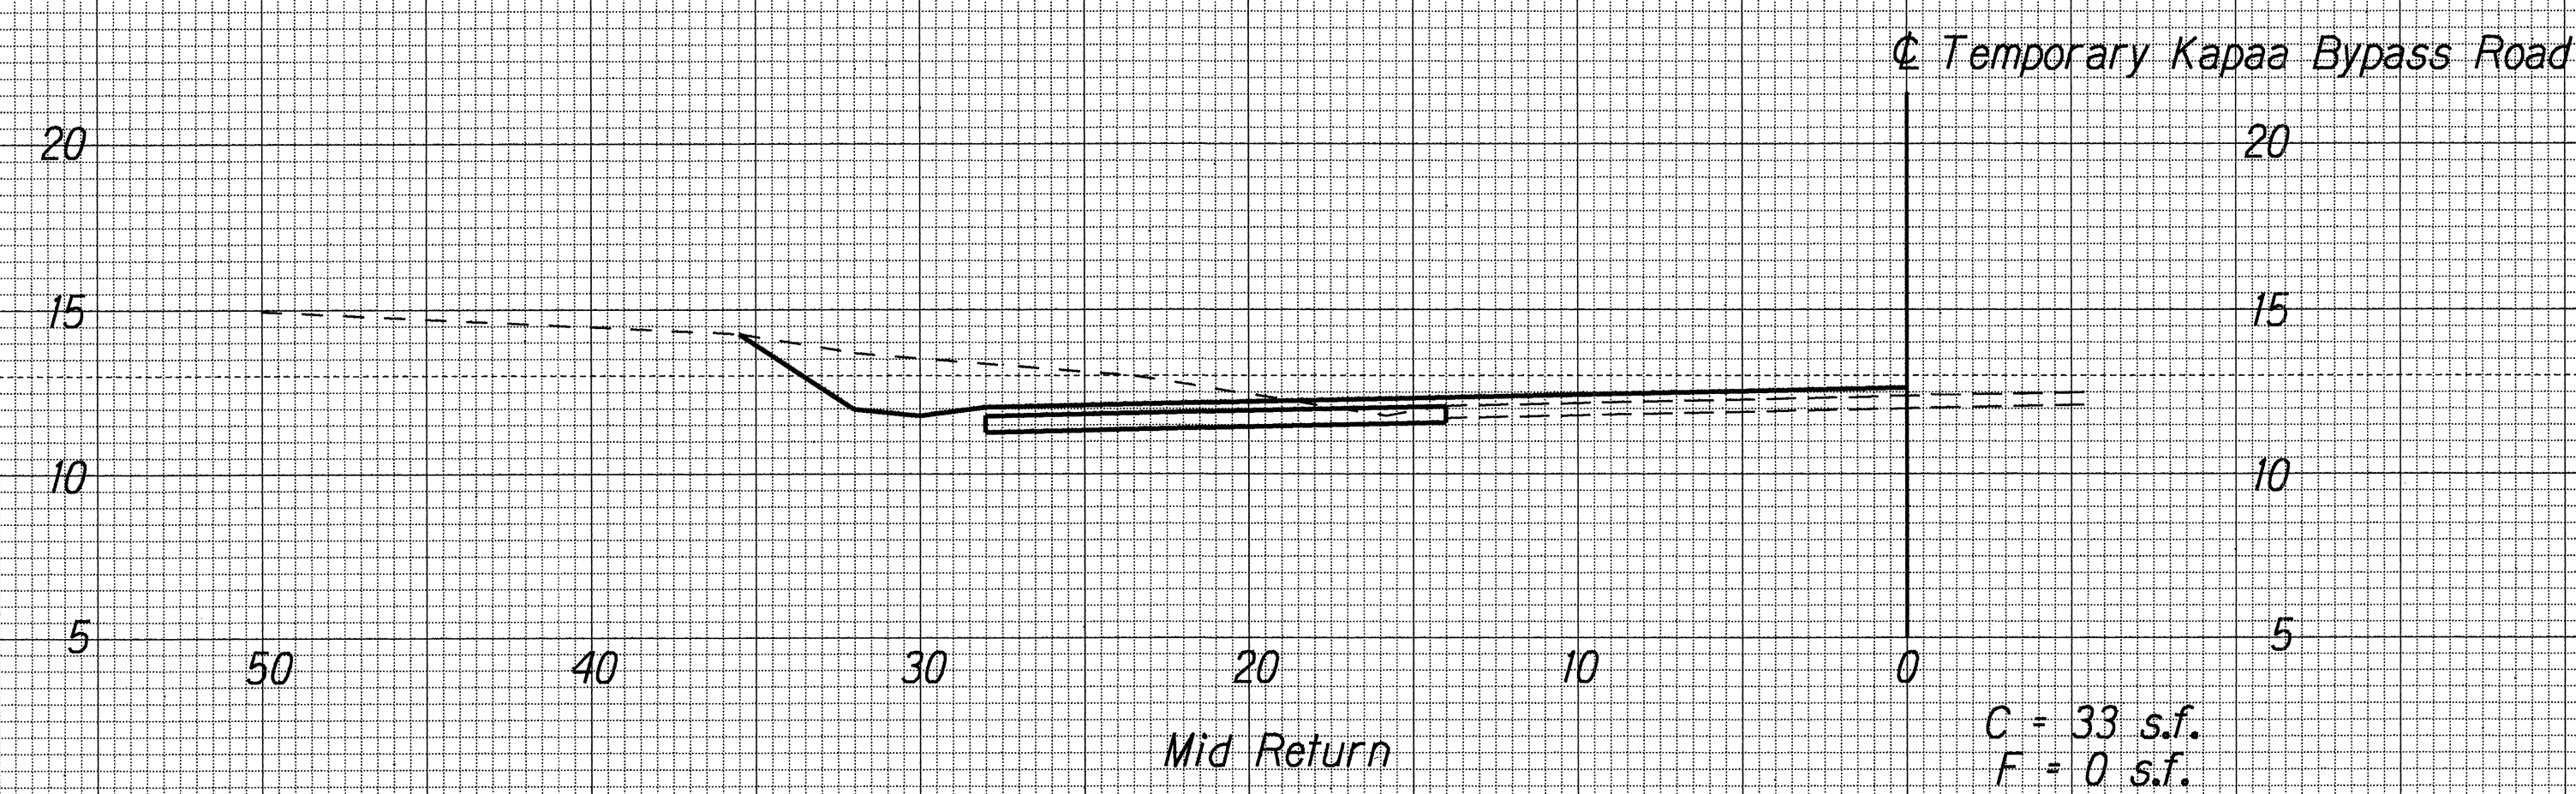
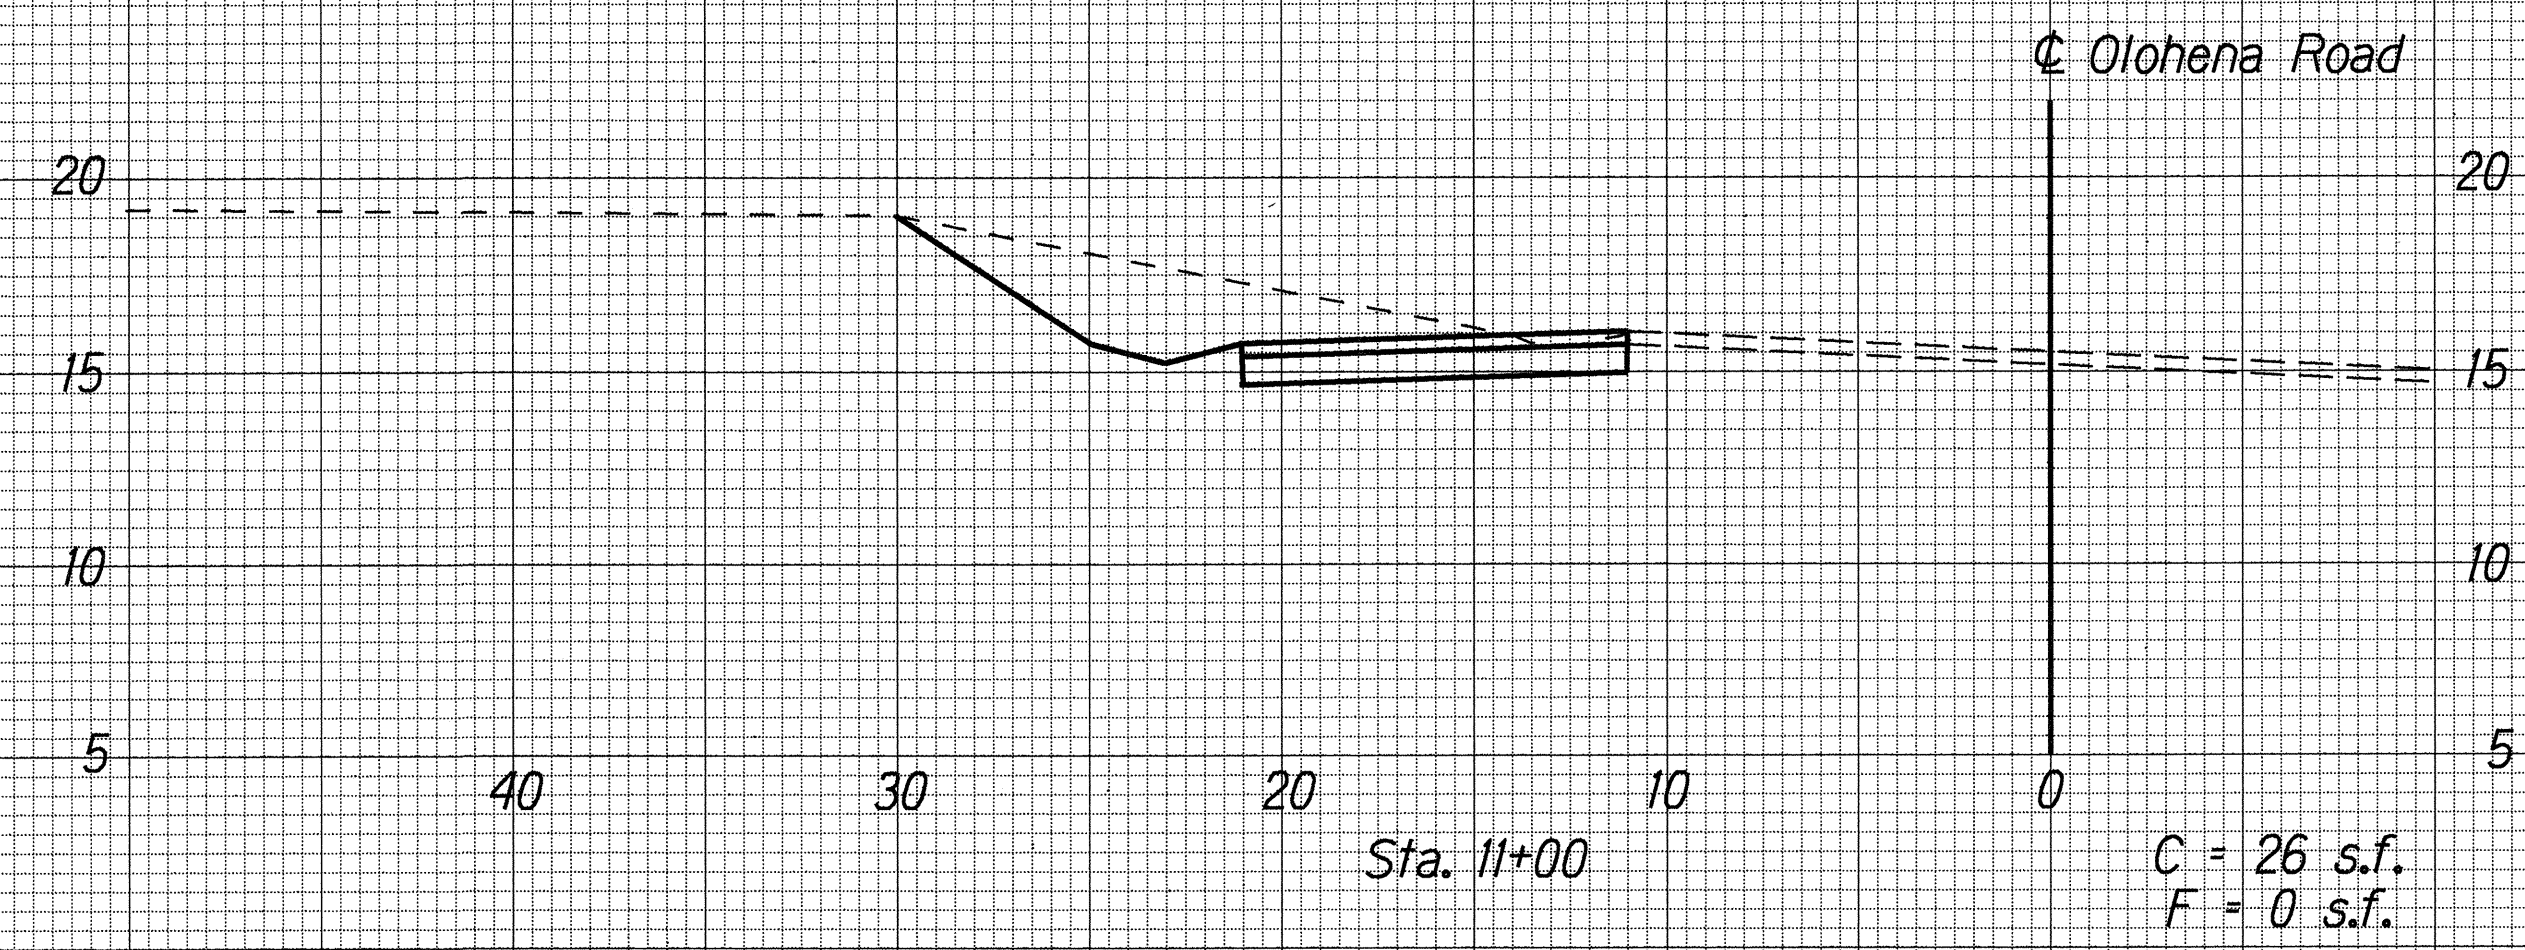


FED. ROAD DIST. NO.	STATE	PROJ. NO.	FISCAL YEAR	SHEET NO.	TOTAL SHEETS
HAWAII	HAW.	56A-02-95	1995	38	38

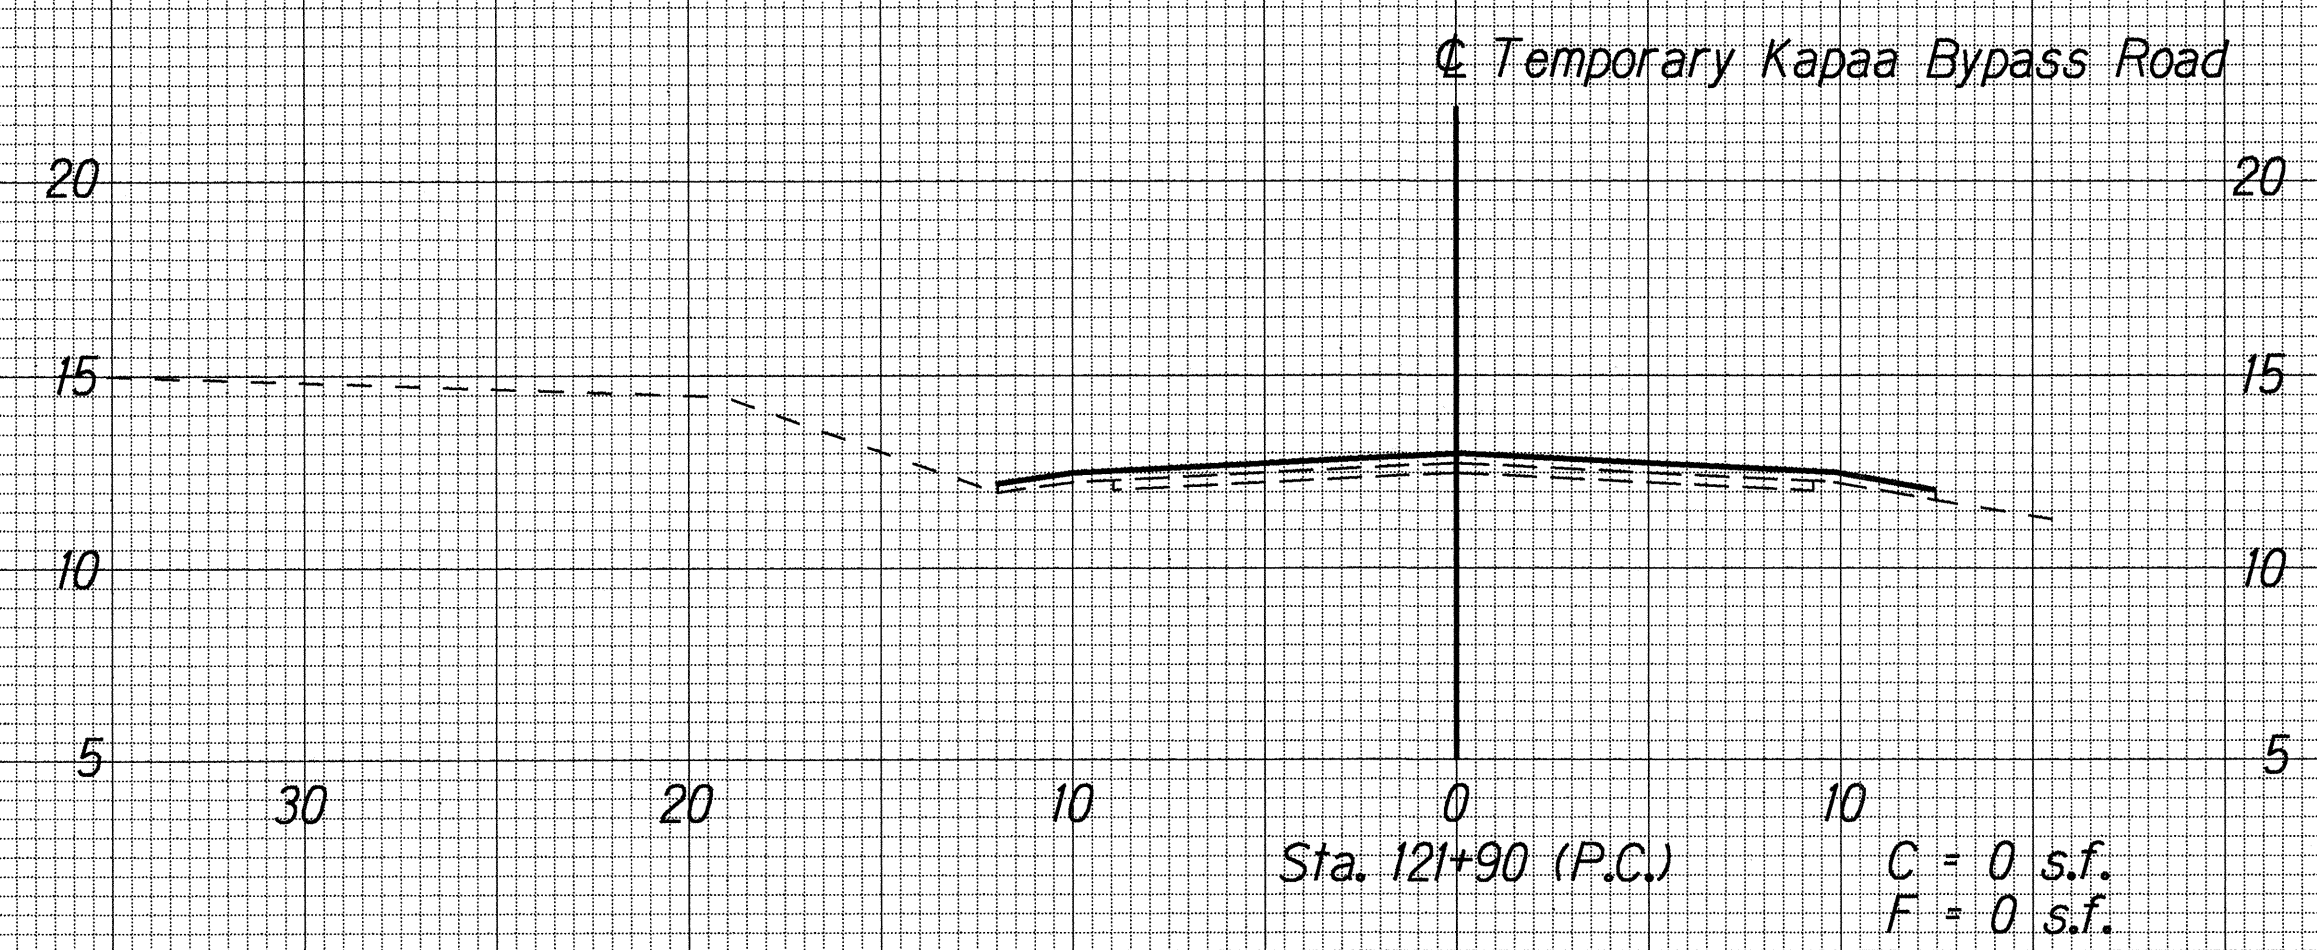

ORIGINAL PLAN	SURVEY PLOTTED BY	DATE
NOTE BOOK	DRAWN BY	7/95
RE-1 Gary	DESIGNED BY	
QUANTITIES BY	CHECKED BY	

Scale: 1" = 5' Horizontal
1" = 5' Vertical