



FED. ROAD DIST. NO.	STATE	PROJ. NO.	FISCAL YEAR	SHEET NO.	TOTAL SHEETS
HAWAII	HAW.	56A-02-95	1995	11	38

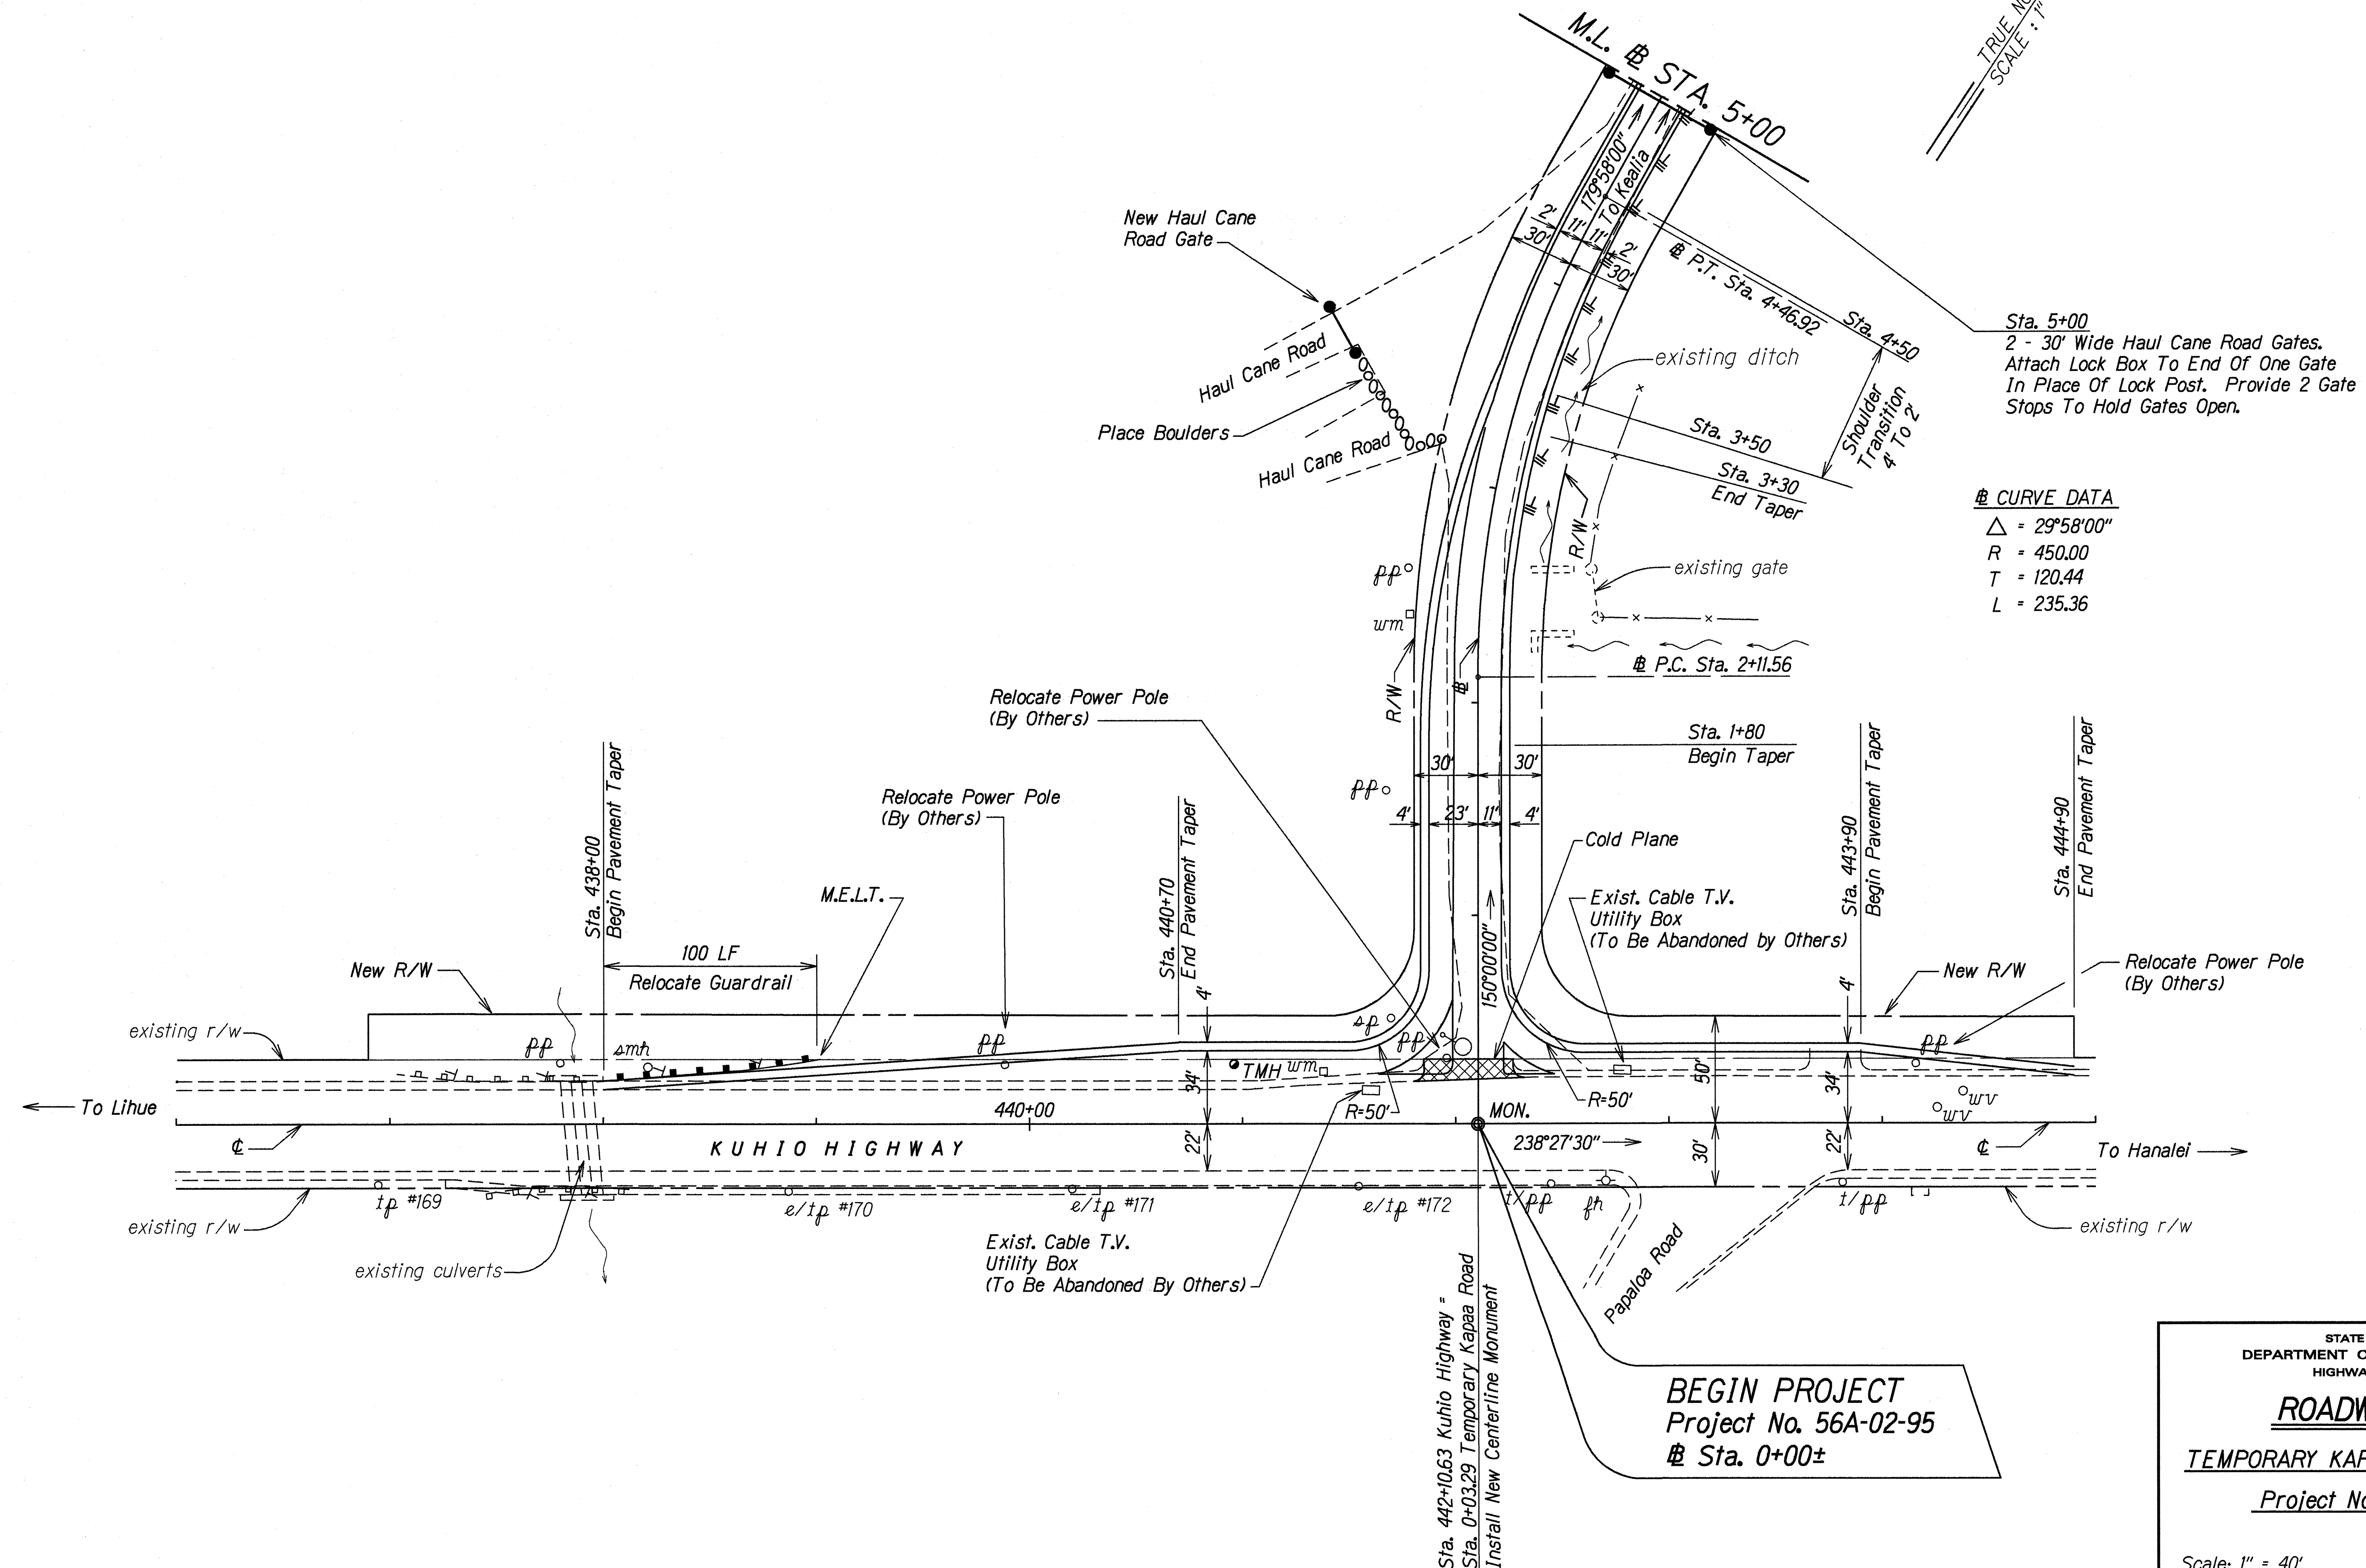

ORIGINAL PLAN	DATE	1/95
SURVEY PLOTTED BY	DESIGNED BY	THP/CK
DESIGNED BY	QUANTITIES BY	RE-1 Gary
CHECKED BY		NA/02/02/95

FED. ROAD DIST. NO.	STATE	PROJ. NO.	FISCAL YEAR	SHEET NO.	TOTAL SHEETS
HAWAII	HAW.	56A-02-95	1995	12	38

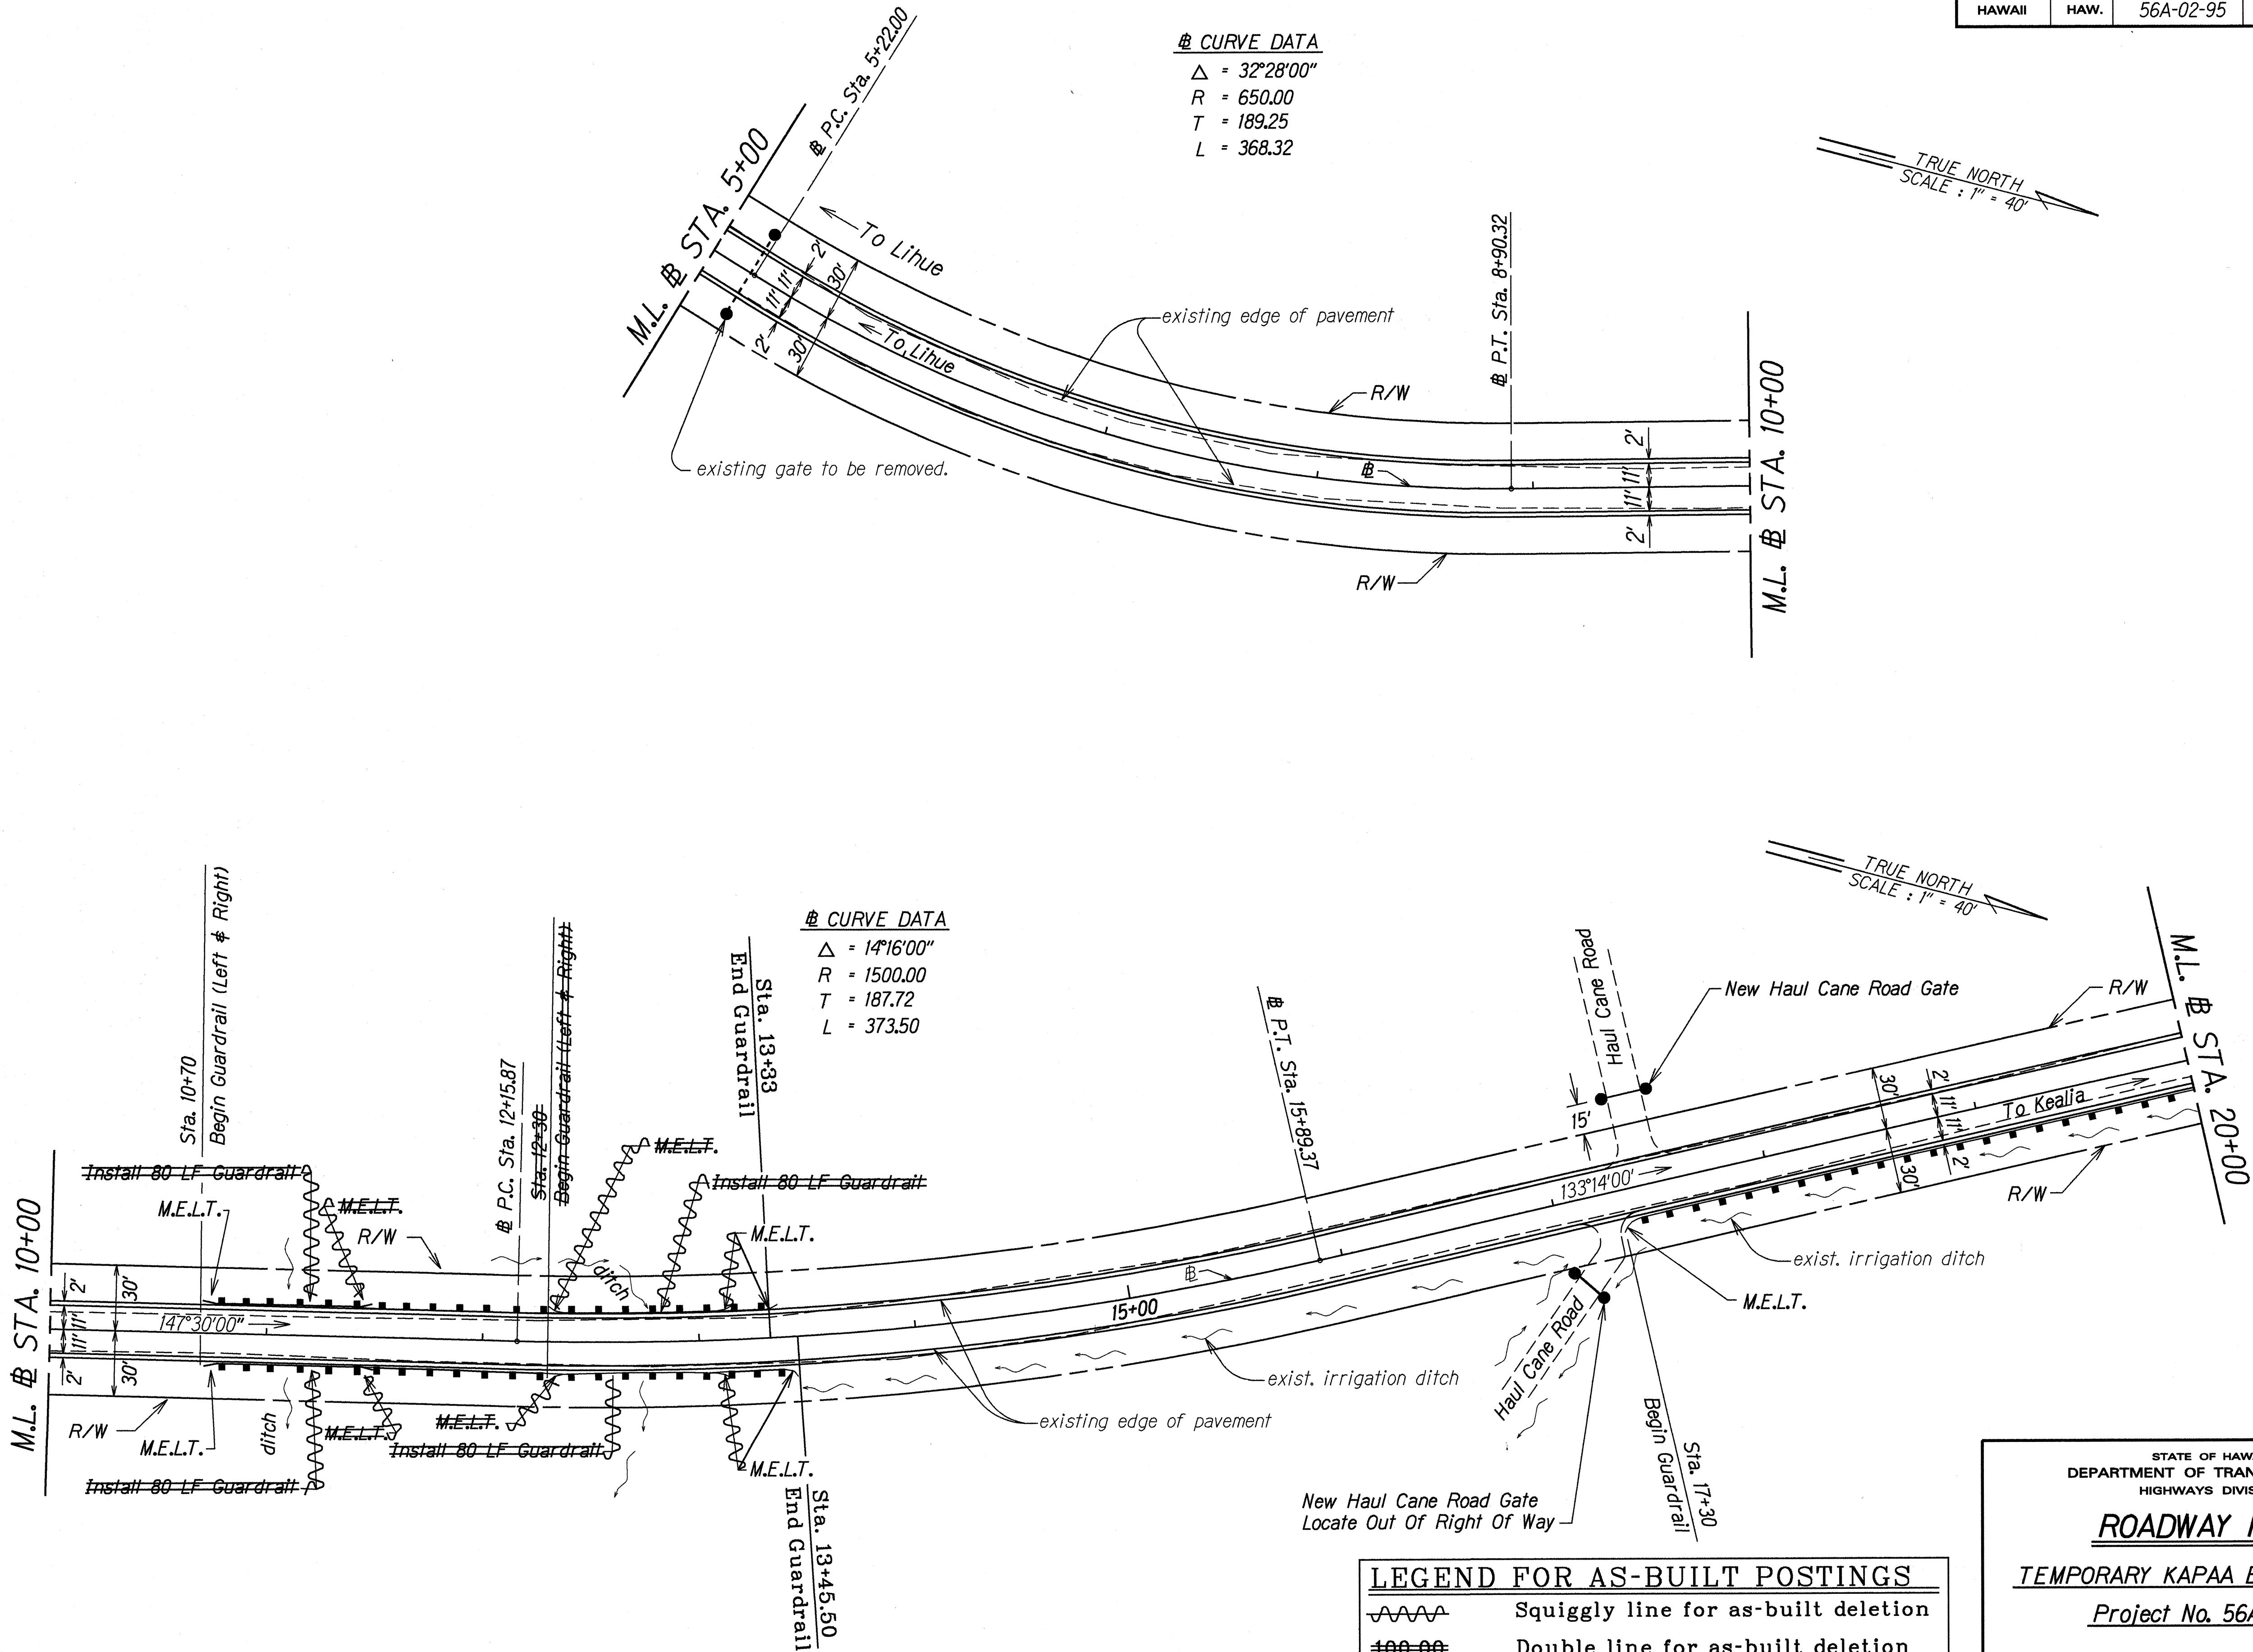

ORIGINAL PLAN	DATE
SURVEY PLOTTED BY	1995
DRAWN BY	
TRACED BY	
NOTED BY	
REVIEWED BY	
CHECKED BY	

"AS-BUILT"


STATE OF HAWAII
DEPARTMENT OF TRANSPORTATION
HIGHWAYS DIVISION

ROADWAY PLAN
TEMPORARY KAPAA BYPASS ROAD
Project No. 56A-02-95

Scale: 1" = 40'
Date: Feb, 1995

SHEET No. 2 OF 8 SHEETS

FED. ROAD DIST. NO.	STATE	PROJ. NO.	FISCAL YEAR	SHEET NO.	TOTAL SHEETS
HAWAII	HAW.	56A-02-95	1995	13	38

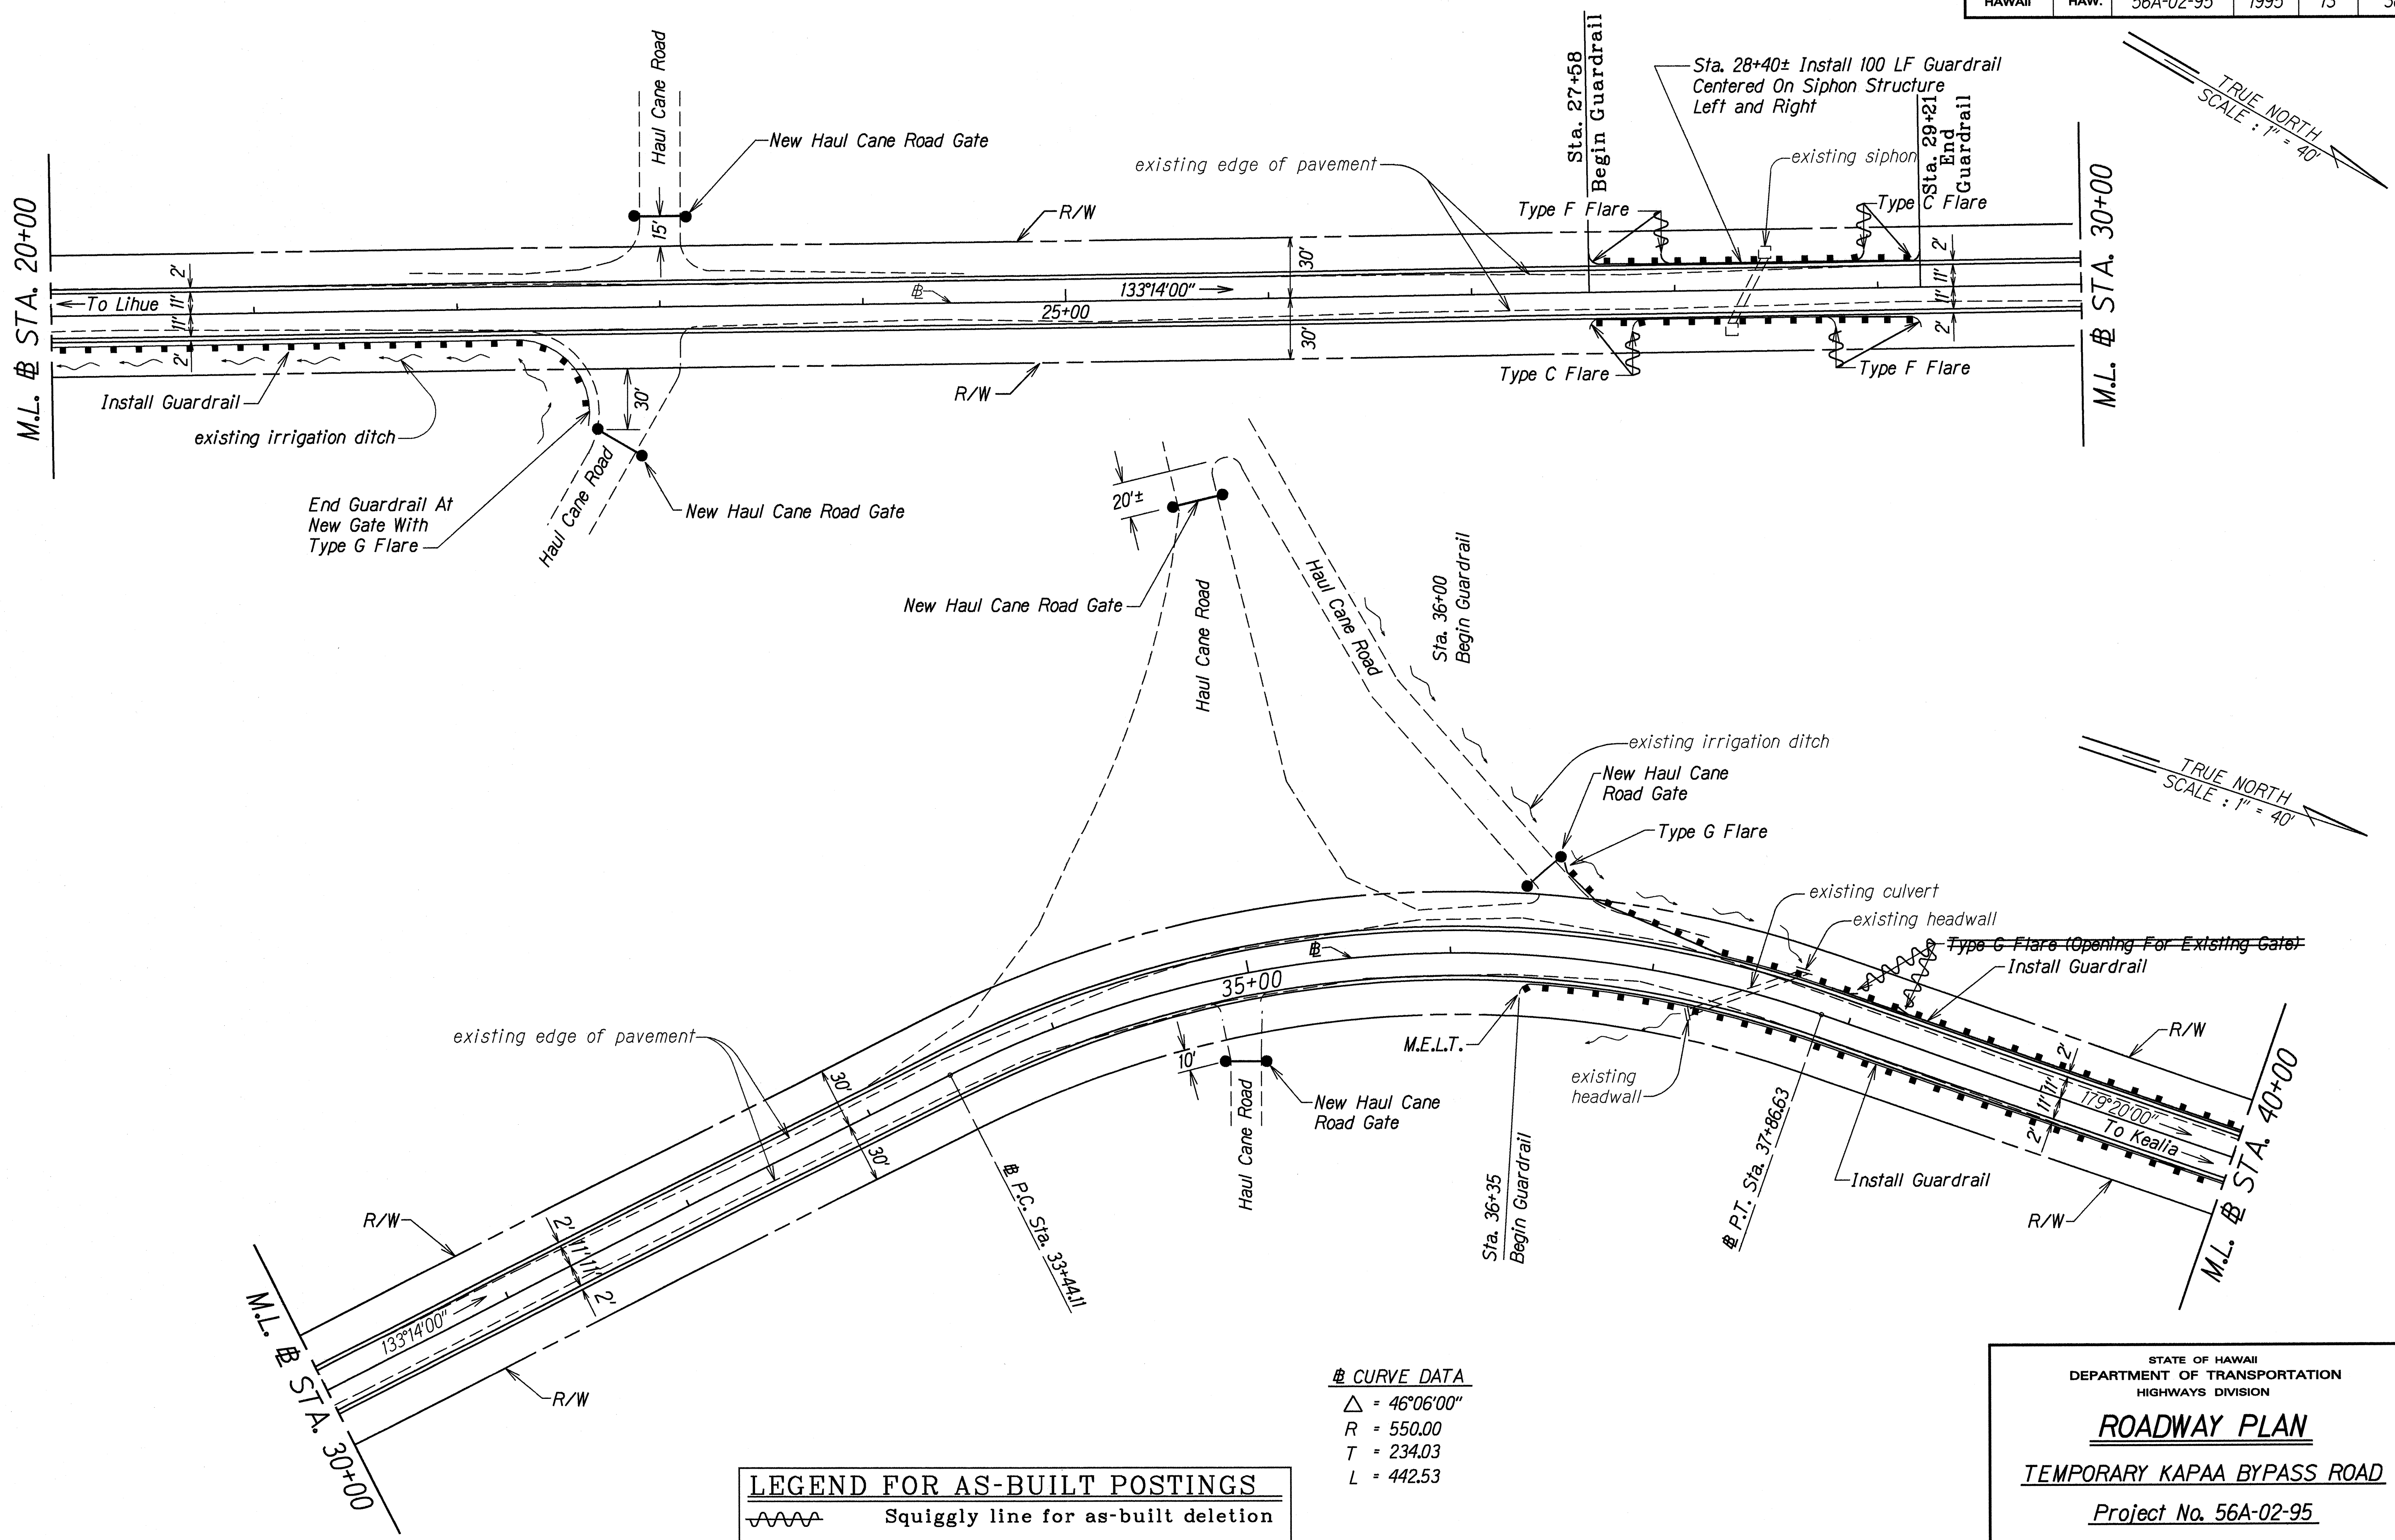

ORIGINAL PLAN	SURVEY PLOTTED BY	DATE
NOTE BOOK	DRAWN BY	1995
Ke-1 Gary	TRACED BY	
5/1/95	DESIGNED BY	
	CHECKED BY	

LEGEND FOR AS-BUILT POSTINGS	
	Squiggly line for as-built deletion
	Double line for as-built deletion
Roadway	Text for as-built posting

CURVE DATA	
Δ	= 46°06'00"
R	= 550.00
T	= 234.03
L	= 442.53

STATE OF HAWAII
DEPARTMENT OF TRANSPORTATION
HIGHWAYS DIVISION

ROADWAY PLAN

TEMPORARY KAPAA BYPASS ROAD



Project No. 56A-02-95

Scale: 1" = 40'
Date: Feb, 1995

SHEET No. 3 OF 8 SHEETS

"AS-BUILT"

FED. ROAD DIST. NO.	STATE	PROJ. NO.	FISCAL YEAR	SHEET NO.	TOTAL SHEETS
HAWAII	HAW.	56A-02-95	1995	14	38

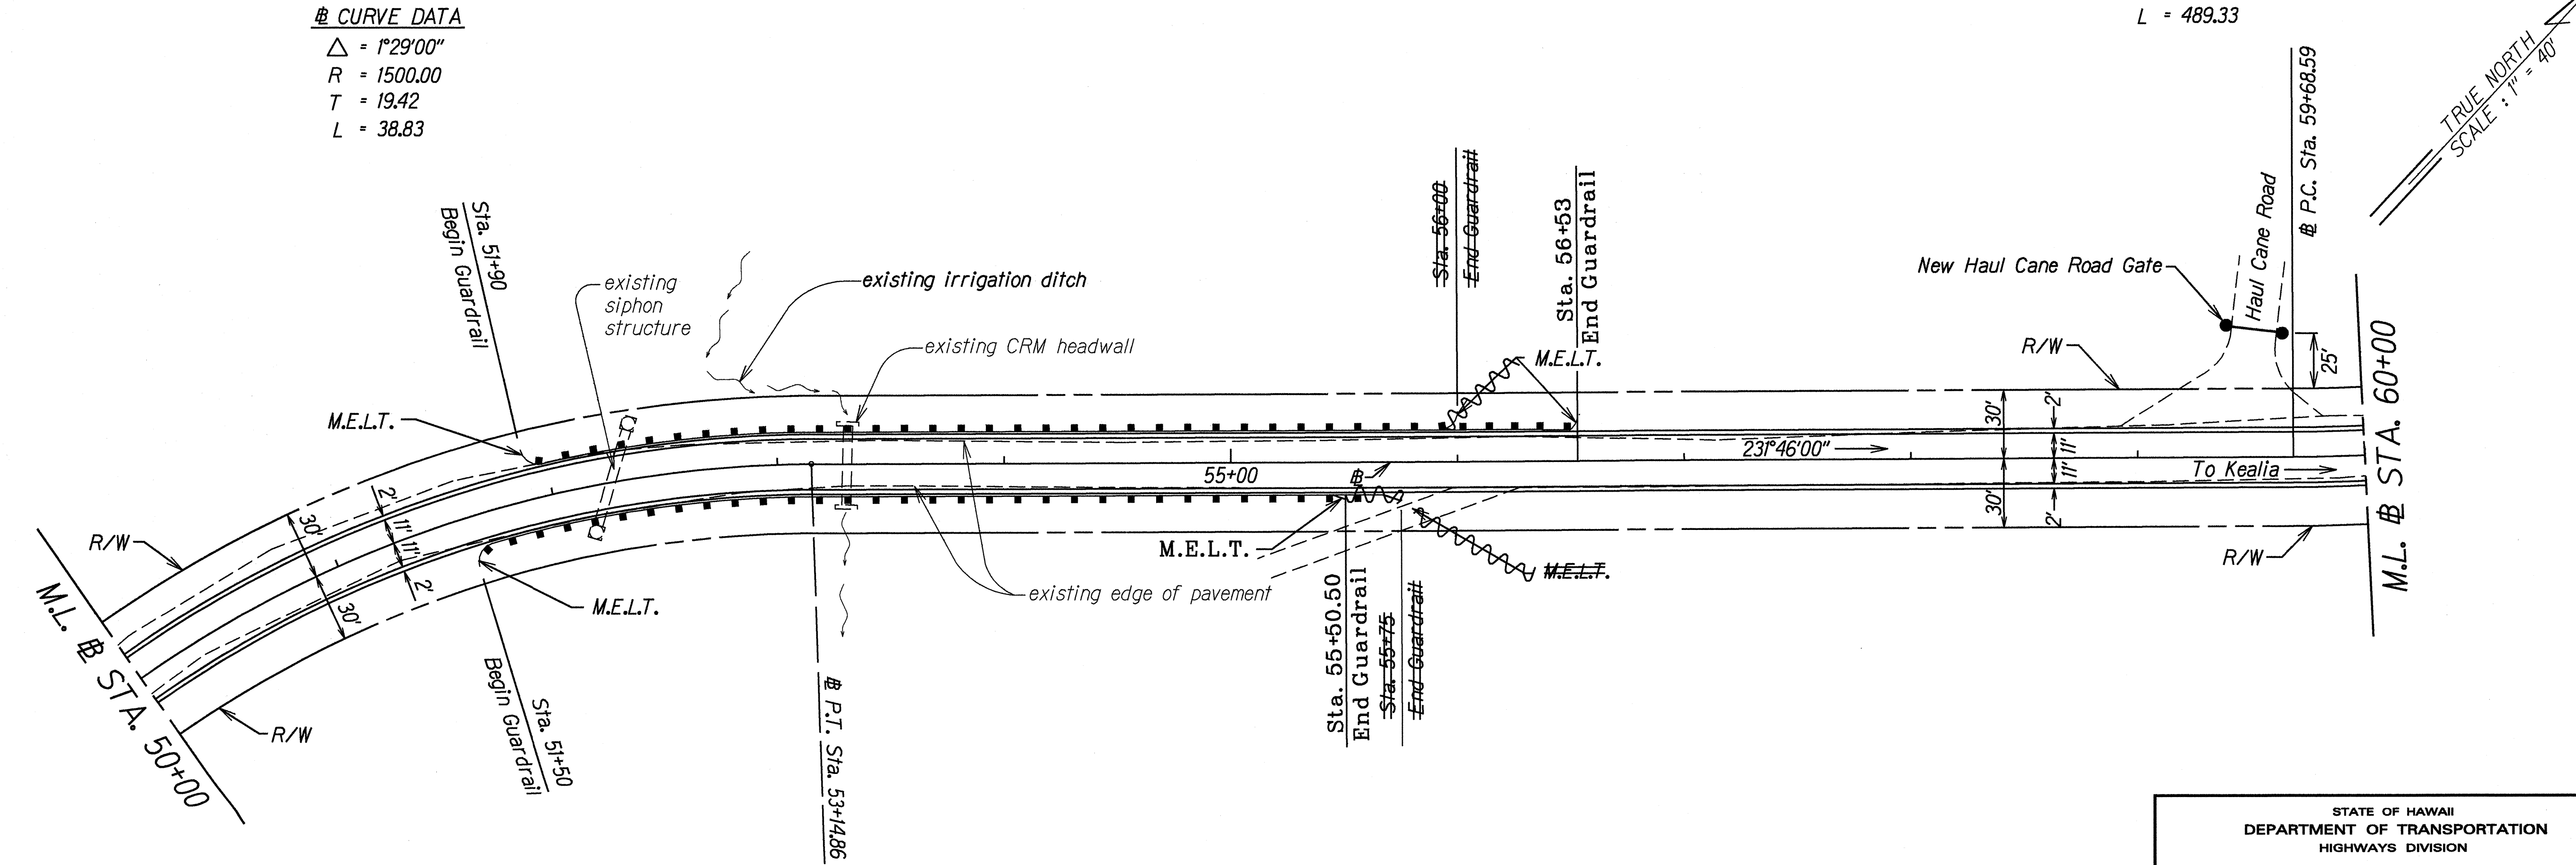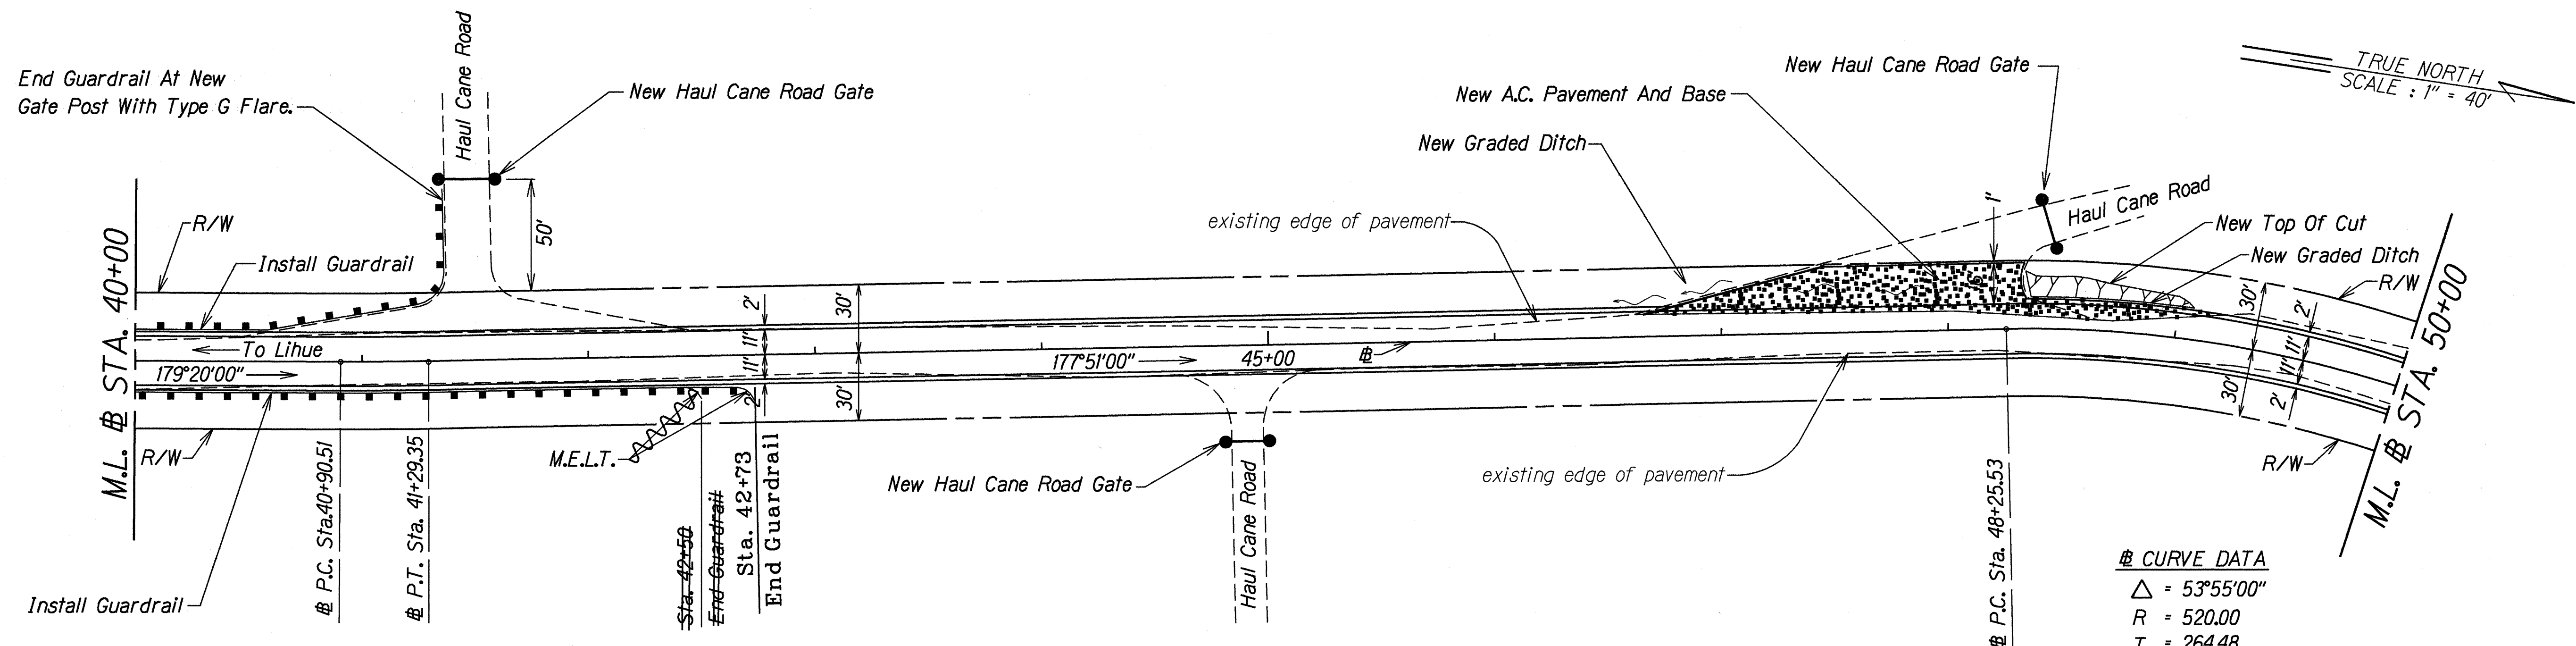

ORIGINAL PLAN	DATE	BY
NOTED BOOK	DATE	BY
KE-1 Gary	DATE	BY
QUANTITIES BY	DATE	BY
CHECKED BY	DATE	BY

LEGEND FOR AS-BUILT POSTINGS	
	Squiggly line for as-built deletion
	Double line for as-built deletion
Roadway	Text for as-built posting

STATE OF HAWAII
DEPARTMENT OF TRANSPORTATION
HIGHWAYS DIVISION

ROADWAY PLAN

TEMPORARY KAPAA BYPASS ROAD

Project No. 56A-02-95



Scale: 1" = 40'

Date: Feb, 1995

SHEET No. 4 OF 8 SHEETS

"AS-BUILT"

FED. ROAD DIST. NO.	STATE	PROJ. NO.	FISCAL YEAR	SHEET NO.	TOTAL SHEETS
HAWAII	HAW.	56A-02-95	1995	15	38

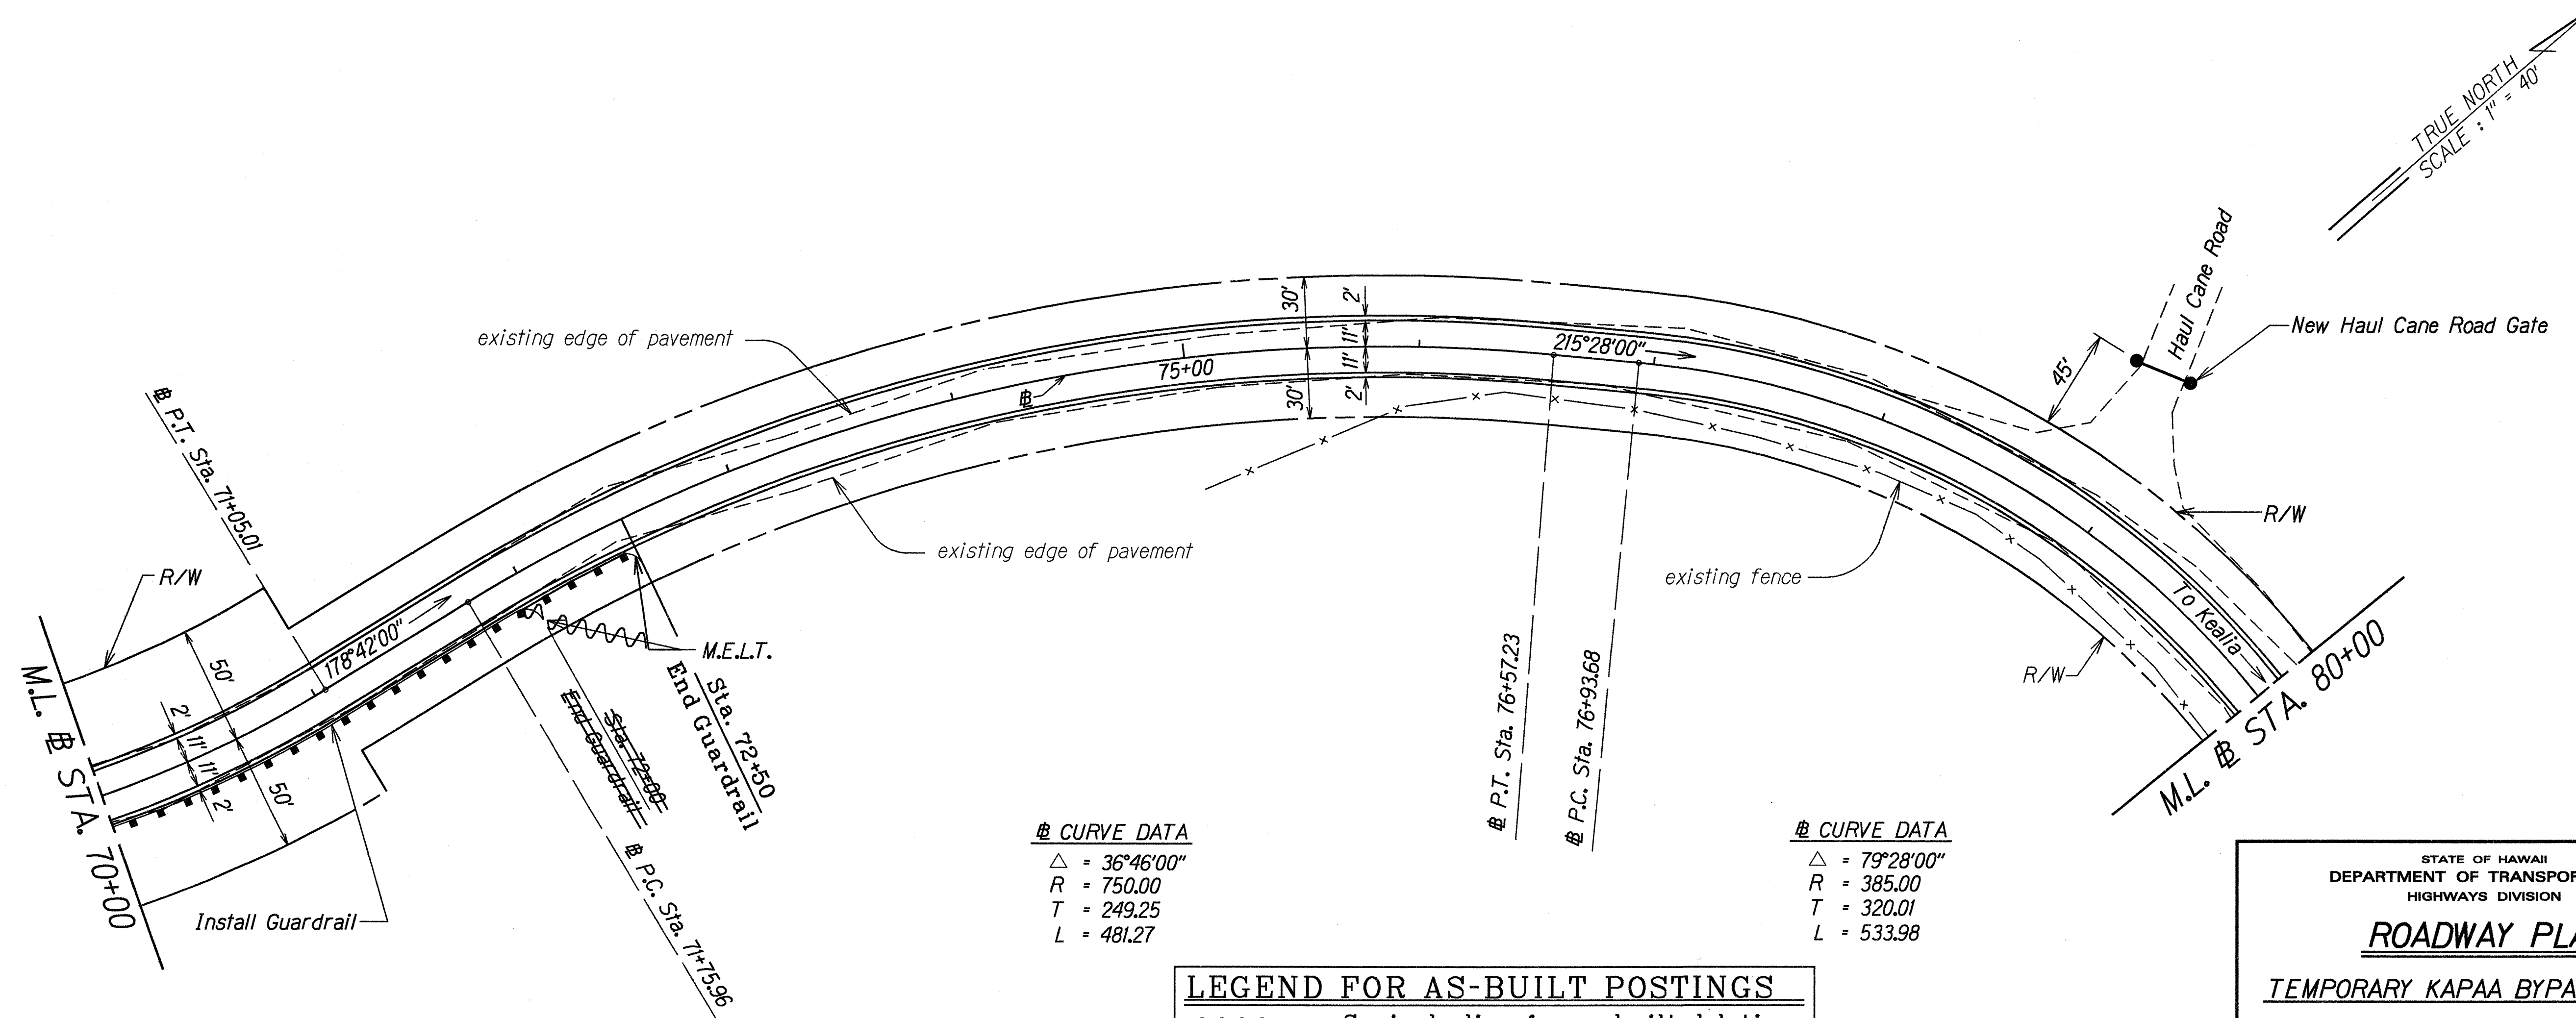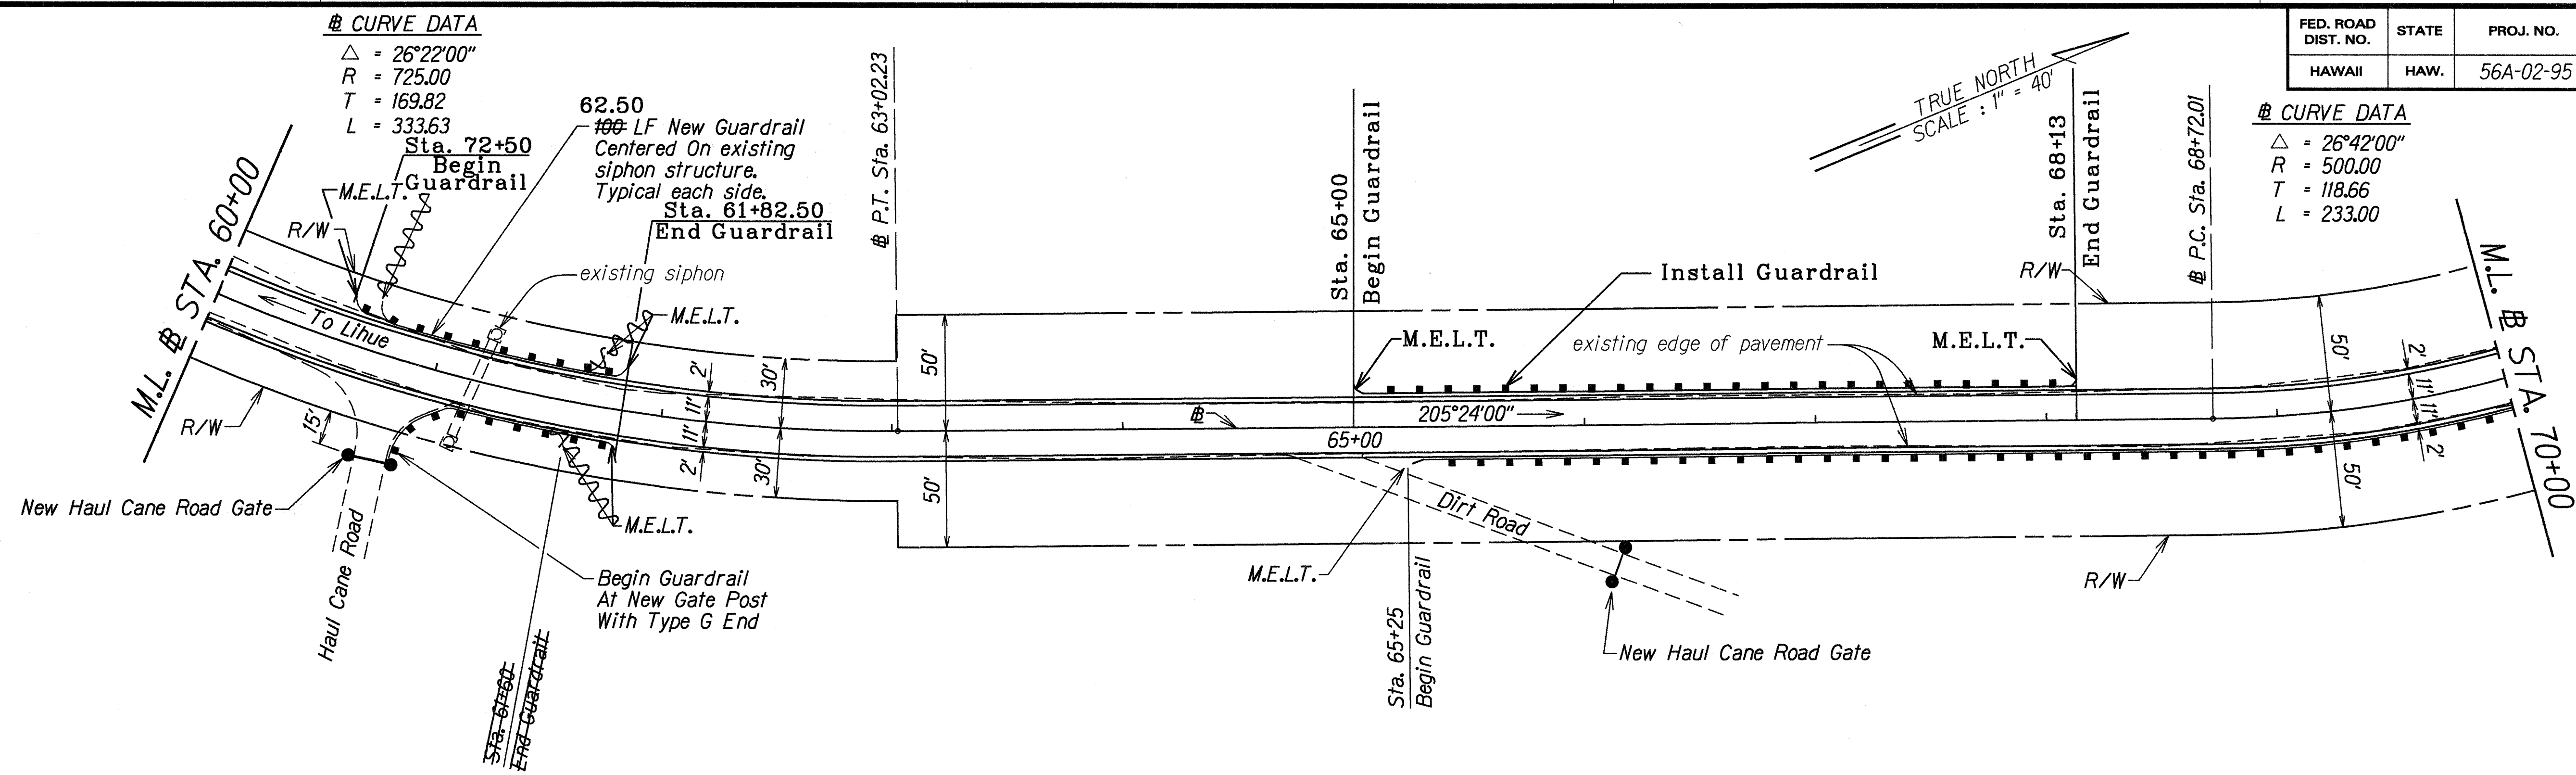

Δ CURVE DATA
 $\Delta = 36^{\circ}46'00''$
 $R = 750.00$
 $T = 249.25$
 $L = 481.27$

Δ CURVE DATA
 $\Delta = 79^{\circ}28'00''$
 $R = 385.00$
 $T = 320.01$
 $L = 533.98$

LEGEND FOR AS-BUILT POSTINGS	
	Squiggly line for as-built deletion
	Double line for as-built deletion
Roadway	Text for as-built posting

SURVEY PLOTTED BY	DATE
DRAWN BY	
TRACED BY	
NOTED BY	
CHECKED BY	

STATE OF HAWAII
DEPARTMENT OF TRANSPORTATION
HIGHWAYS DIVISION

ROADWAY PLAN


TEMPORARY KAPAA BYPASS ROAD

Project No. 56A-02-95

Scale: 1" = 40' Date: Feb, 1995

SHEET No. 5 OF 8 SHEETS

FED. ROAD DIST. NO.	STATE	PROJ. NO.	FISCAL YEAR	SHEET NO.	TOTAL SHEETS
HAWAII	HAW.	56A-02-95	1995	16	38

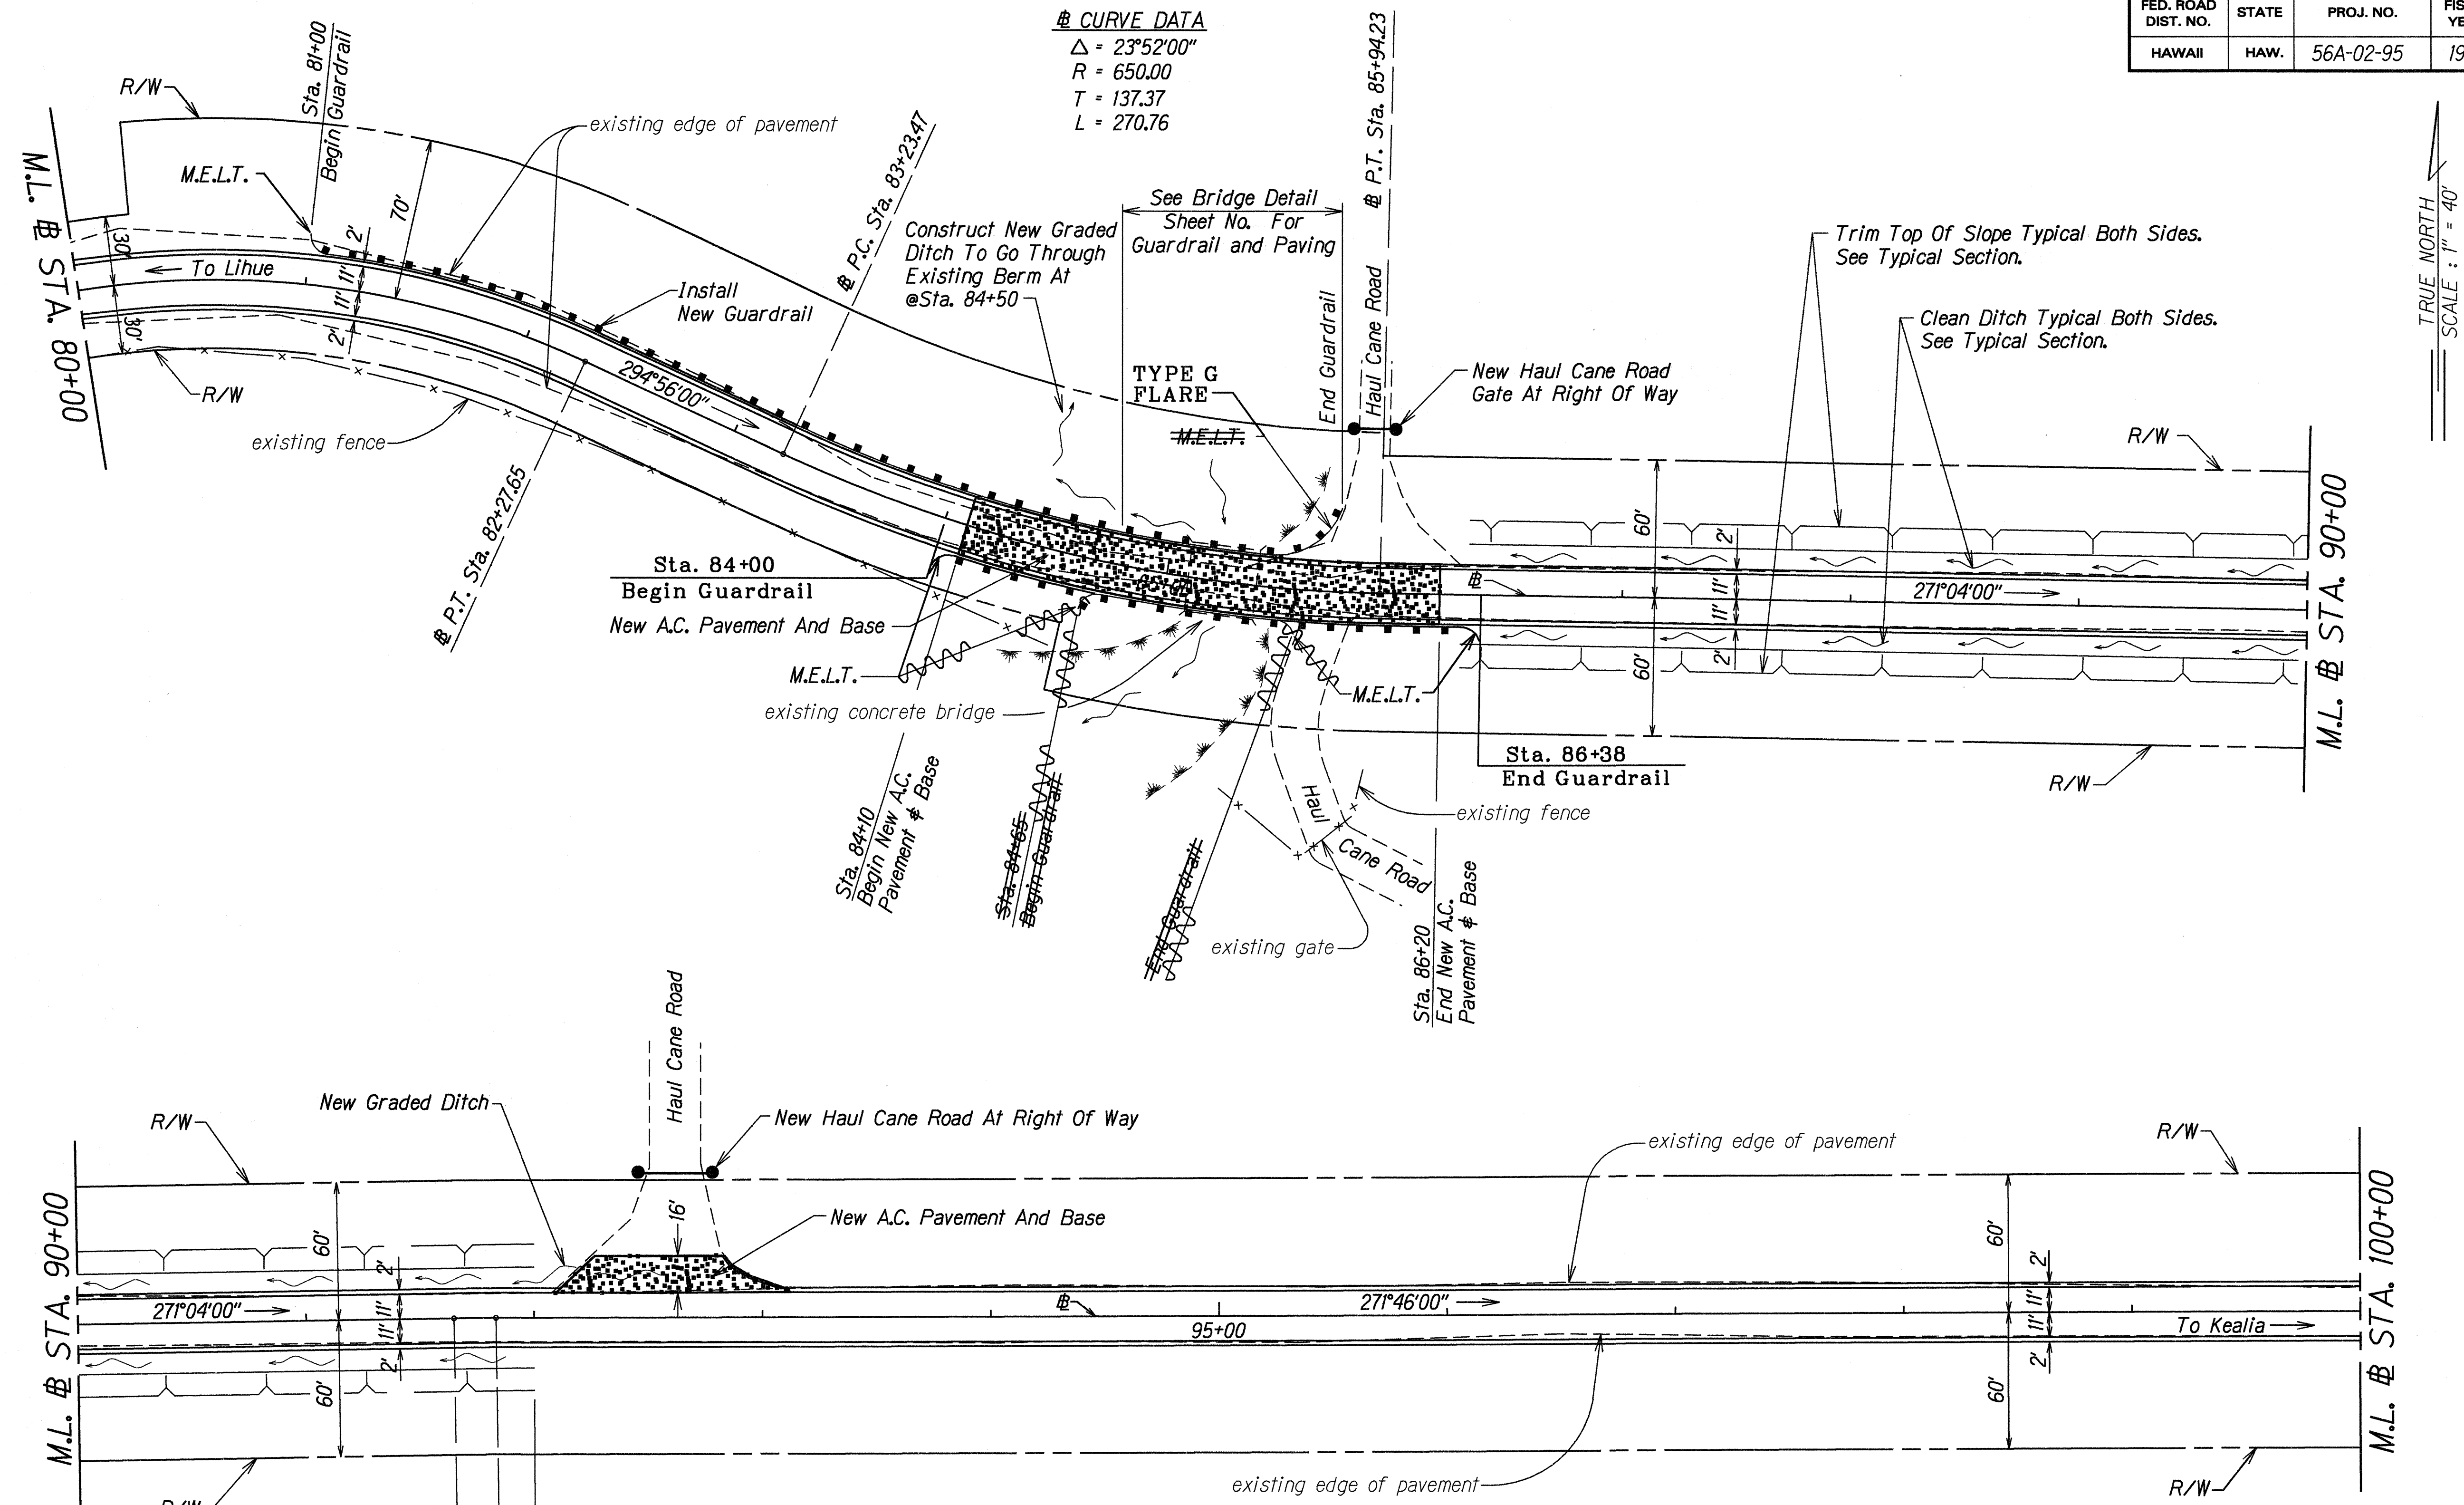

CURVE DATA
 $\Delta = 23^\circ 52' 00''$
 $R = 650.00$
 $T = 137.37$
 $L = 270.76$

CURVE DATA
 $\Delta = 0^\circ 42' 00''$
 $R = 1500.00$
 $T = 9.16$
 $L = 18.33$

LEGEND FOR AS-BUILT POSTINGS	
	Squiggly line for as-built deletion
	Double line for as-built deletion
Roadway	Text for as-built posting

STATE OF HAWAII
DEPARTMENT OF TRANSPORTATION
HIGHWAYS DIVISION

ROADWAY PLAN

TEMPORARY KAPAA BYPASS ROAD



Project No. 56A-02-95

Scale: 1" = 40' Date: Feb, 1995

SHEET No. 6 OF 8 SHEETS

ORIGINAL PLAN	DATE
SURVEY PLOTTED BY	
DRAWN BY	
TRACED BY	
CHECKED BY	
NOTED BY	
DATE	

FED. ROAD DIST. NO.	STATE	PROJ. NO.	FISCAL YEAR	SHEET NO.	TOTAL SHEETS
HAWAII	HAW.	56A-02-95	1995	18	38

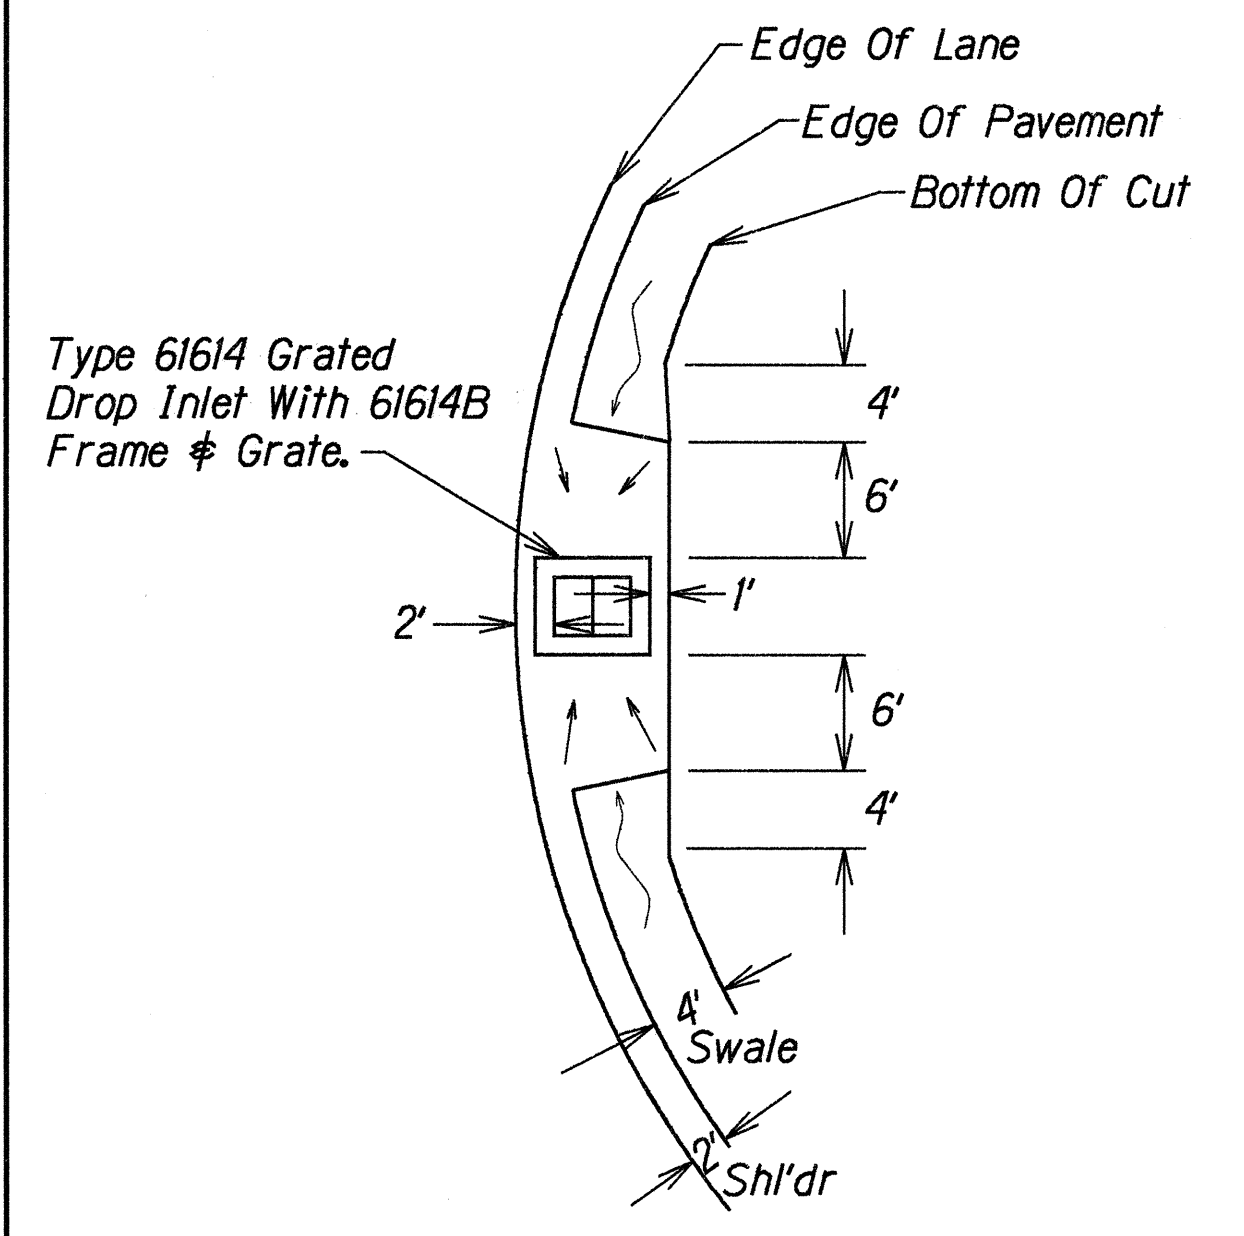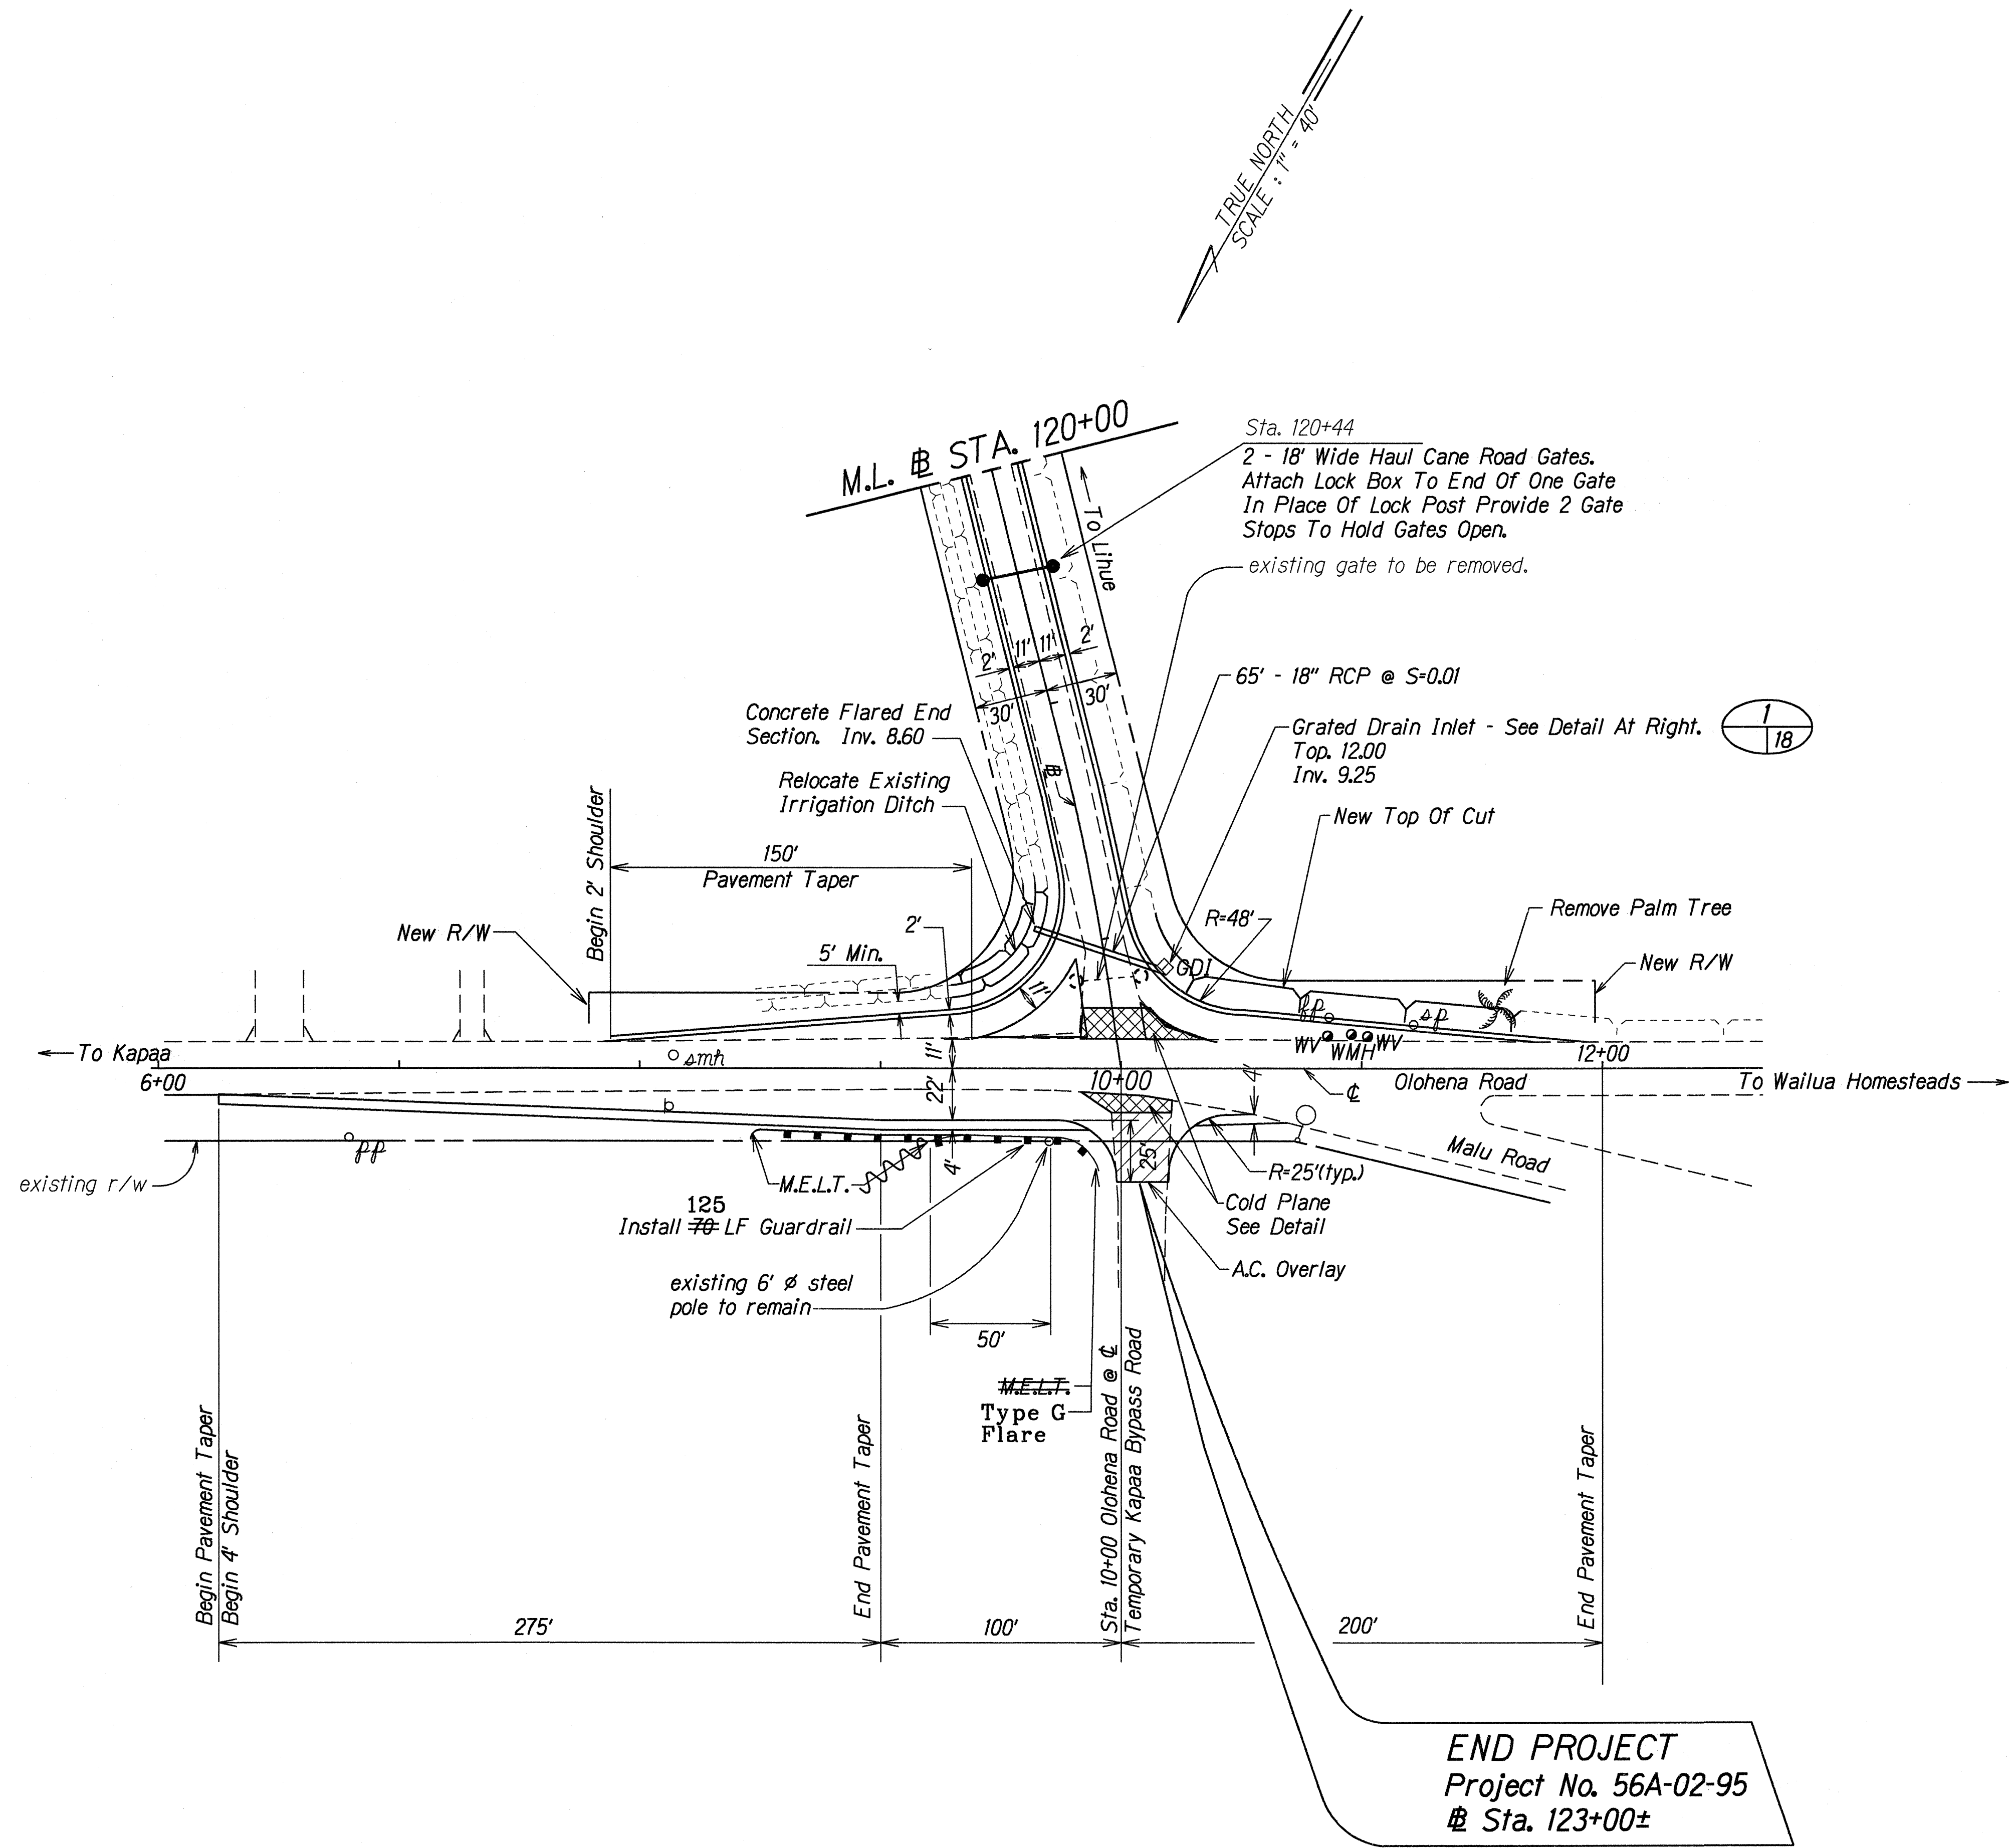

LEGEND FOR AS-BUILT POSTINGS	
	Squiggly line for as-built deletion
	Double line for as-built deletion
Roadway	Text for as-built posting

STATE OF HAWAII
DEPARTMENT OF TRANSPORTATION
HIGHWAYS DIVISION

ROADWAY PLAN

TEMPORARY KAPAA BYPASS ROAD

Project No. 56A-02-95

Scale: 1" = 40' Date: Feb, 1995

SHEET No. 8 OF 8 SHEETS

END PROJECT
Project No. 56A-02-95
Sta. 123+00±

ORIGINAL PLAN	SURVEY PLOTTED BY	DATE
NOTE BOOK	DRAWN BY	1/35
KE-1 Gary	TRACED BY	
AKB001.dgn	QUANTITIES BY	
	CHECKED BY	