


FED. ROAD DIST. NO.	STATE	PROJ. NO.	FISCAL YEAR	SHEET NO.	TOTAL SHEETS
HAWAII	HAW.	56A-02-95	1995	34	38



R8-3a
24"x24"


R8-3a-A
24"x18"

NO PARKING SIGNS
Not To Scale

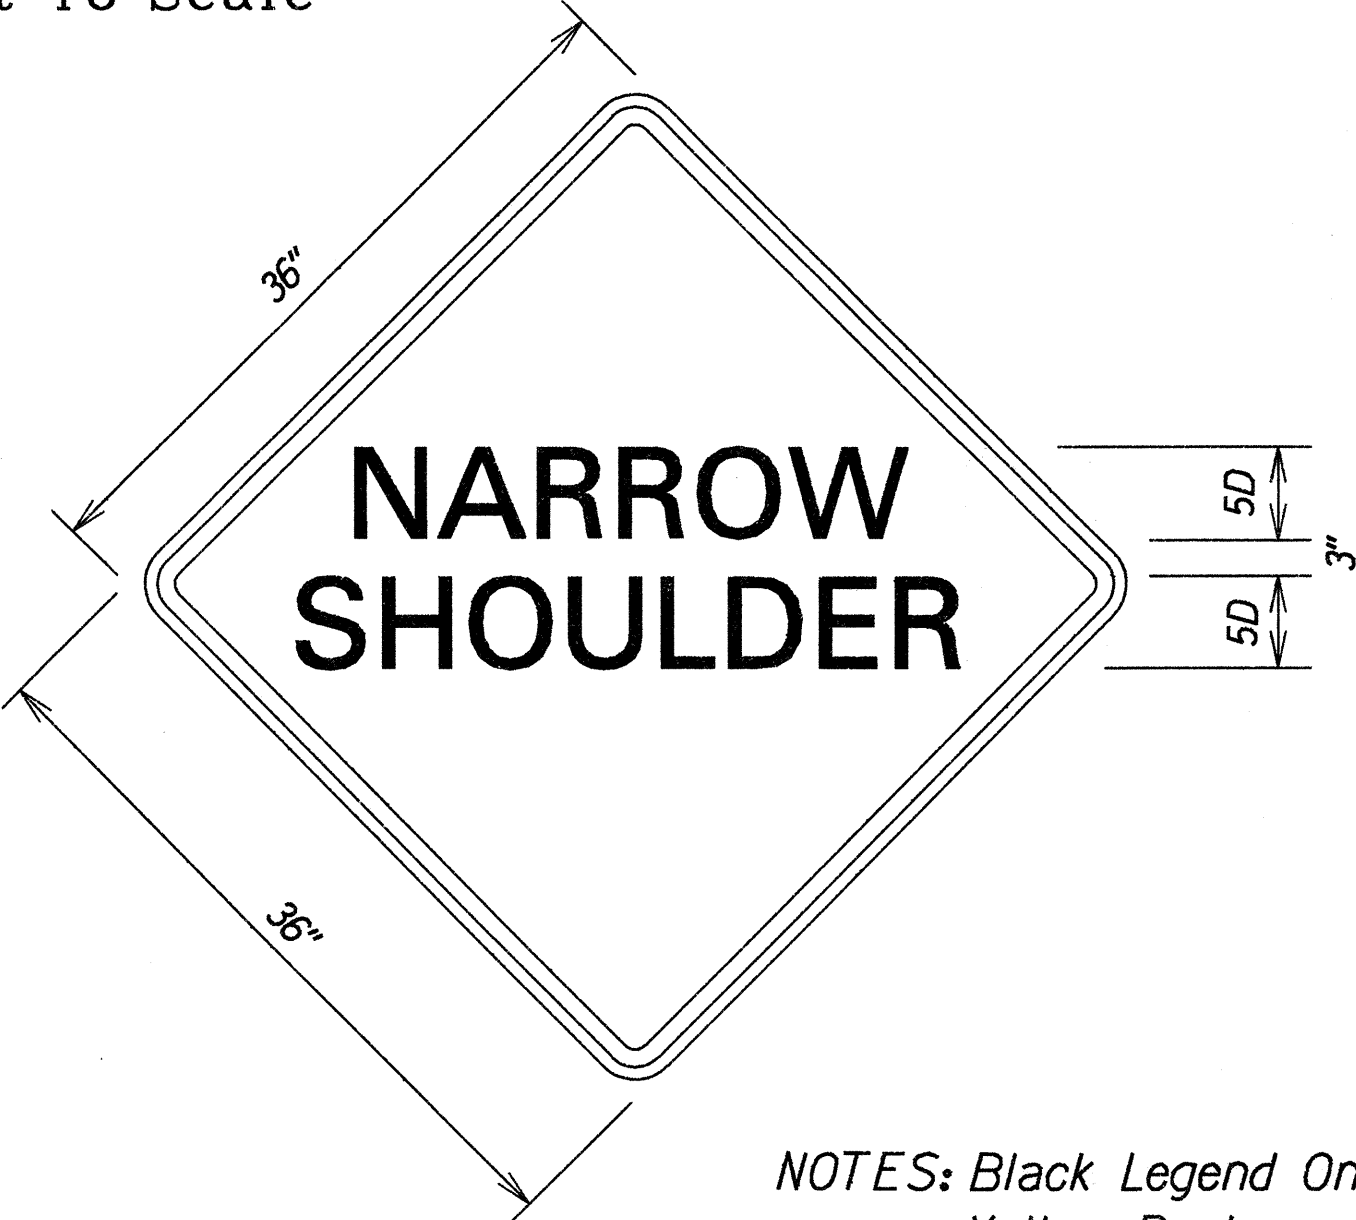


NOTES: Black Legend On
Yellow Background.


W5-4
Not To Scale

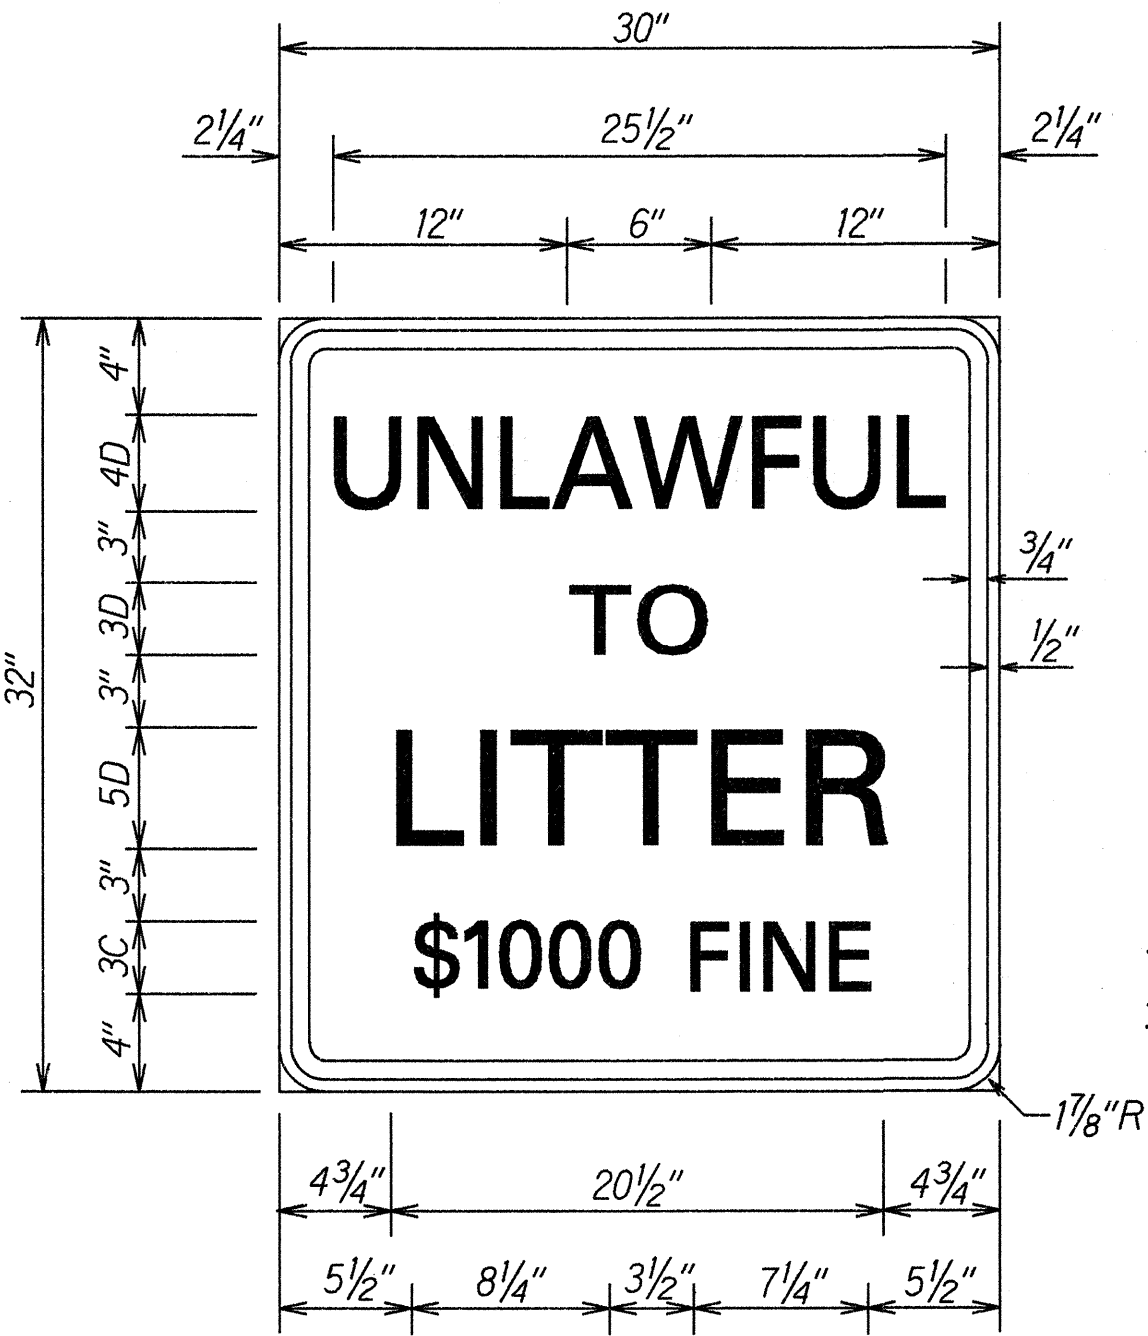

R15-1
Not To Scale

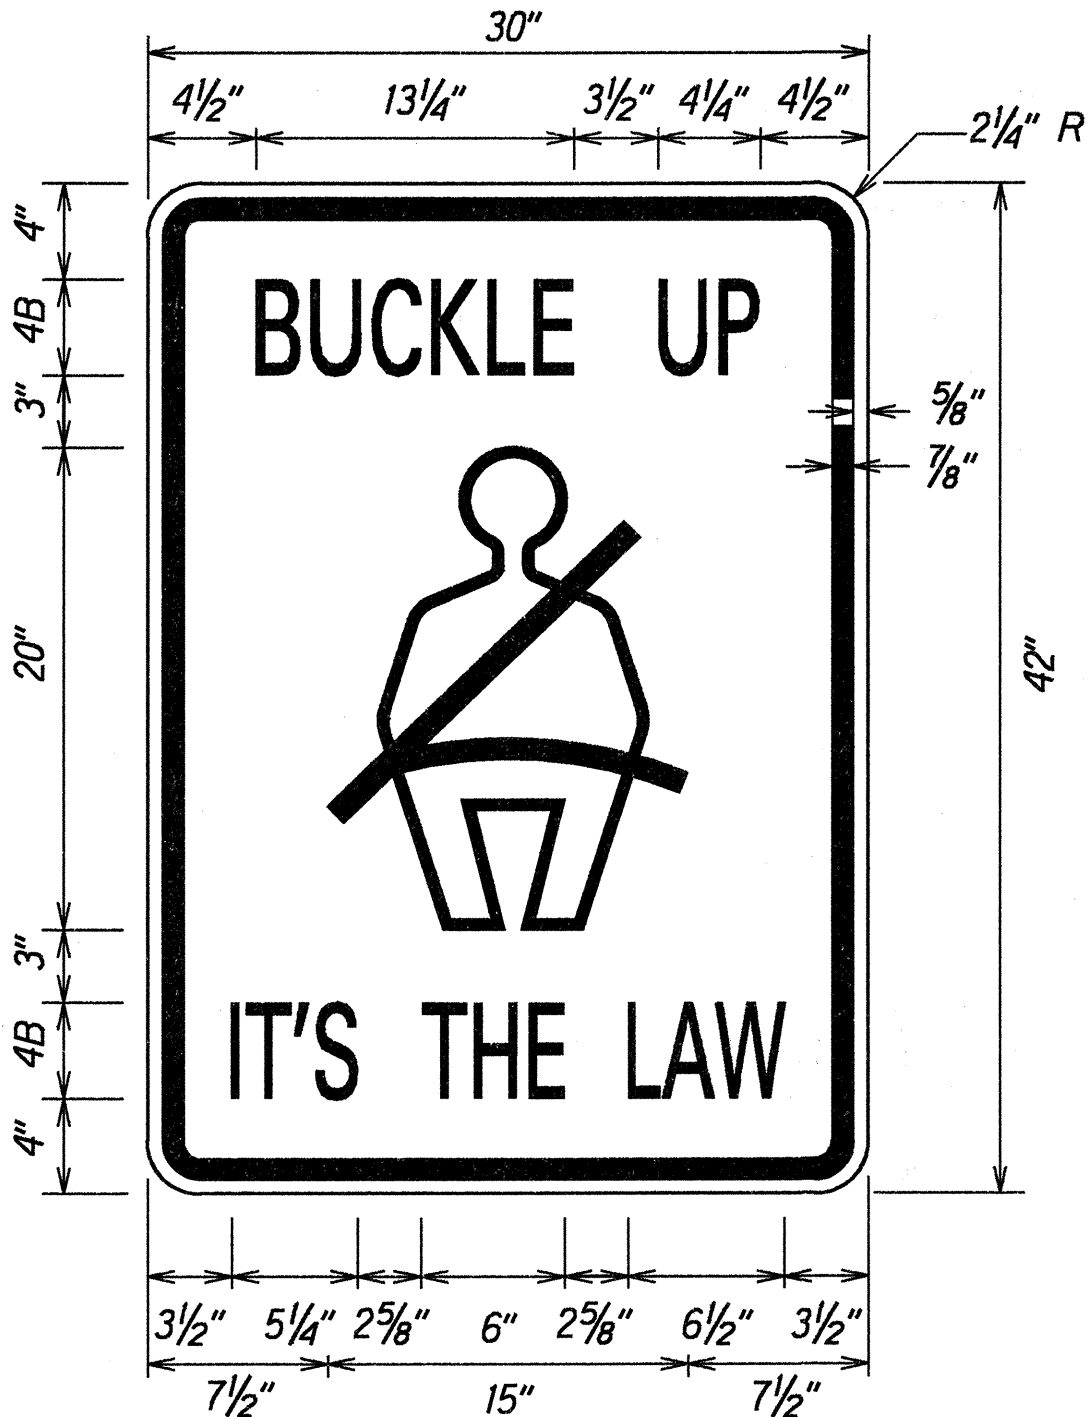

R16-1
Not To Scale

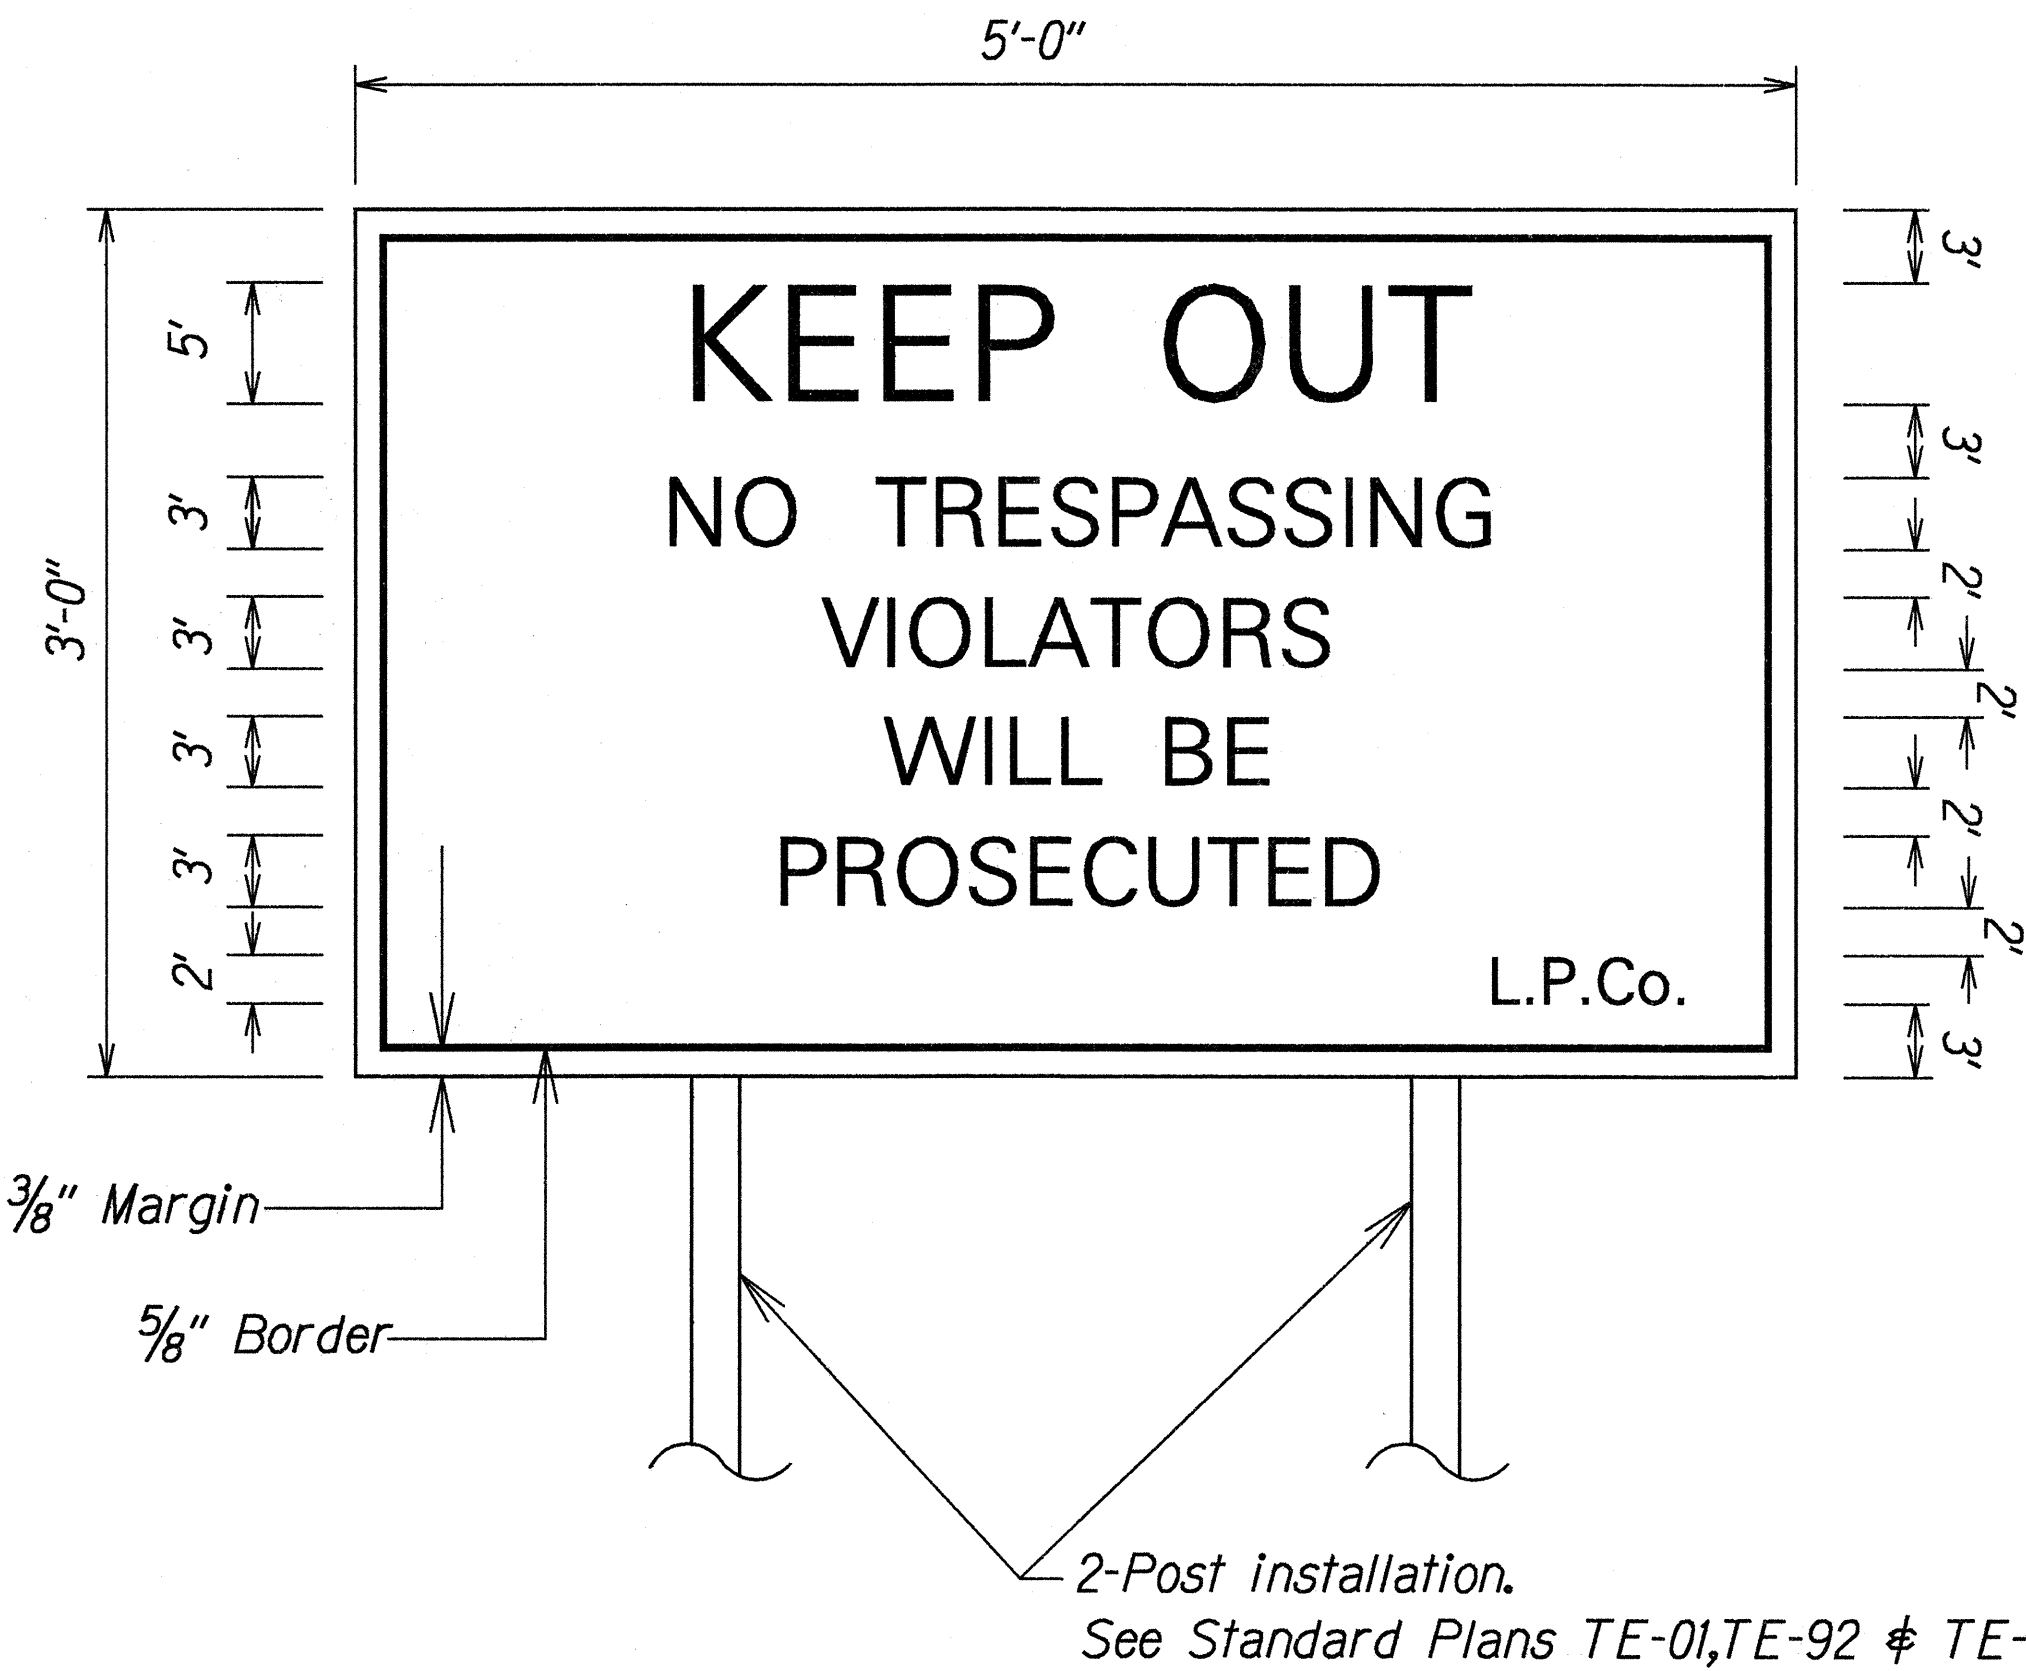

- NOTES: 1. All lettering series "D"
2. White legend & border on red background.
3. Locate 1 sign per cane road adjacent to gate.

D-7 HAUL CANE ROAD SIGN DETAIL
Scale: 1 1/2" = 1'

LEGEND FOR AS-BUILT POSTINGS	
	Squiggly line for as-built deletion
	Double line for as-built deletion
Roadway	Text for as-built posting

ORIGINAL PLAN	SURVEY PLOTTED BY	DATE
NOTE BOOK	DRAWN BY	1995
NE-1 Gary	TRACED BY	
Submittal	CHECKED BY	


STATE OF HAWAII
DEPARTMENT OF TRANSPORTATION
HIGHWAYS DIVISION

SIGN DETAILS
TEMPORARY KAPAA BYPASS ROAD
Project No. 56A-02-95


Scale: As Shown
Date: Feb, 1995

SHEET No. 1 OF 2 SHEETS

FED. ROAD DIST. NO.	STATE	PROJ. NO.	FISCAL YEAR	SHEET NO.	TOTAL SHEETS
HAWAII	HAW.	56A-02-95	1995	35	38

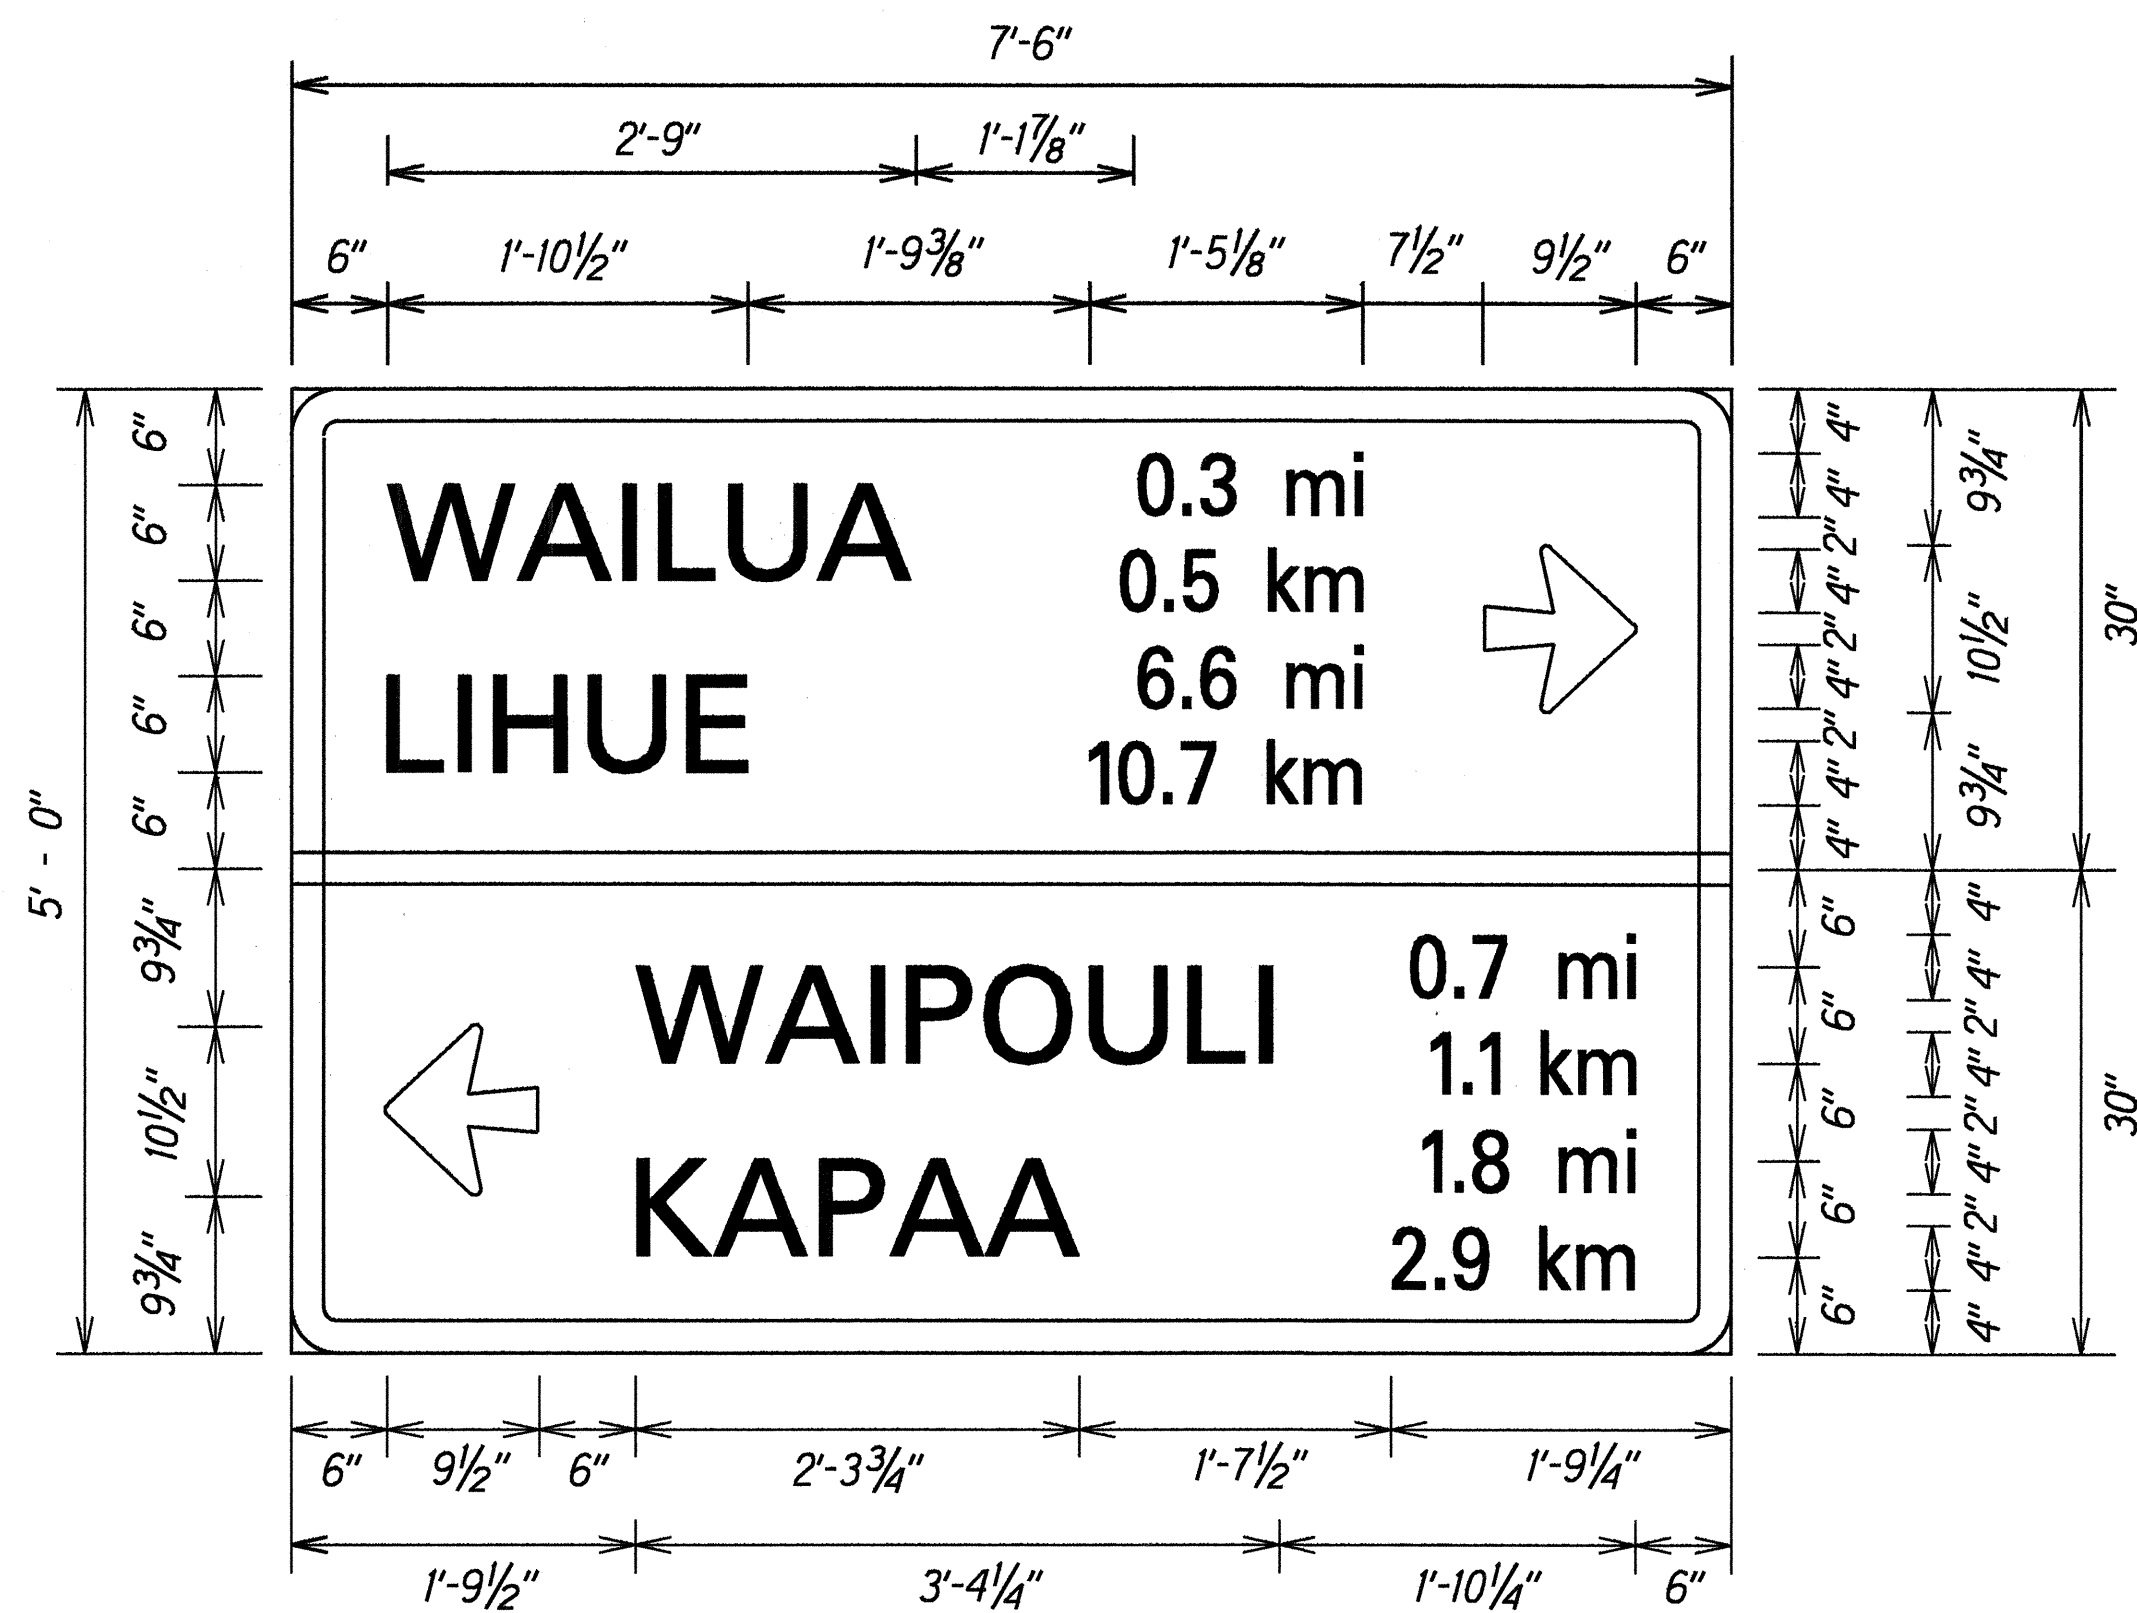

D-1
Not To Scale

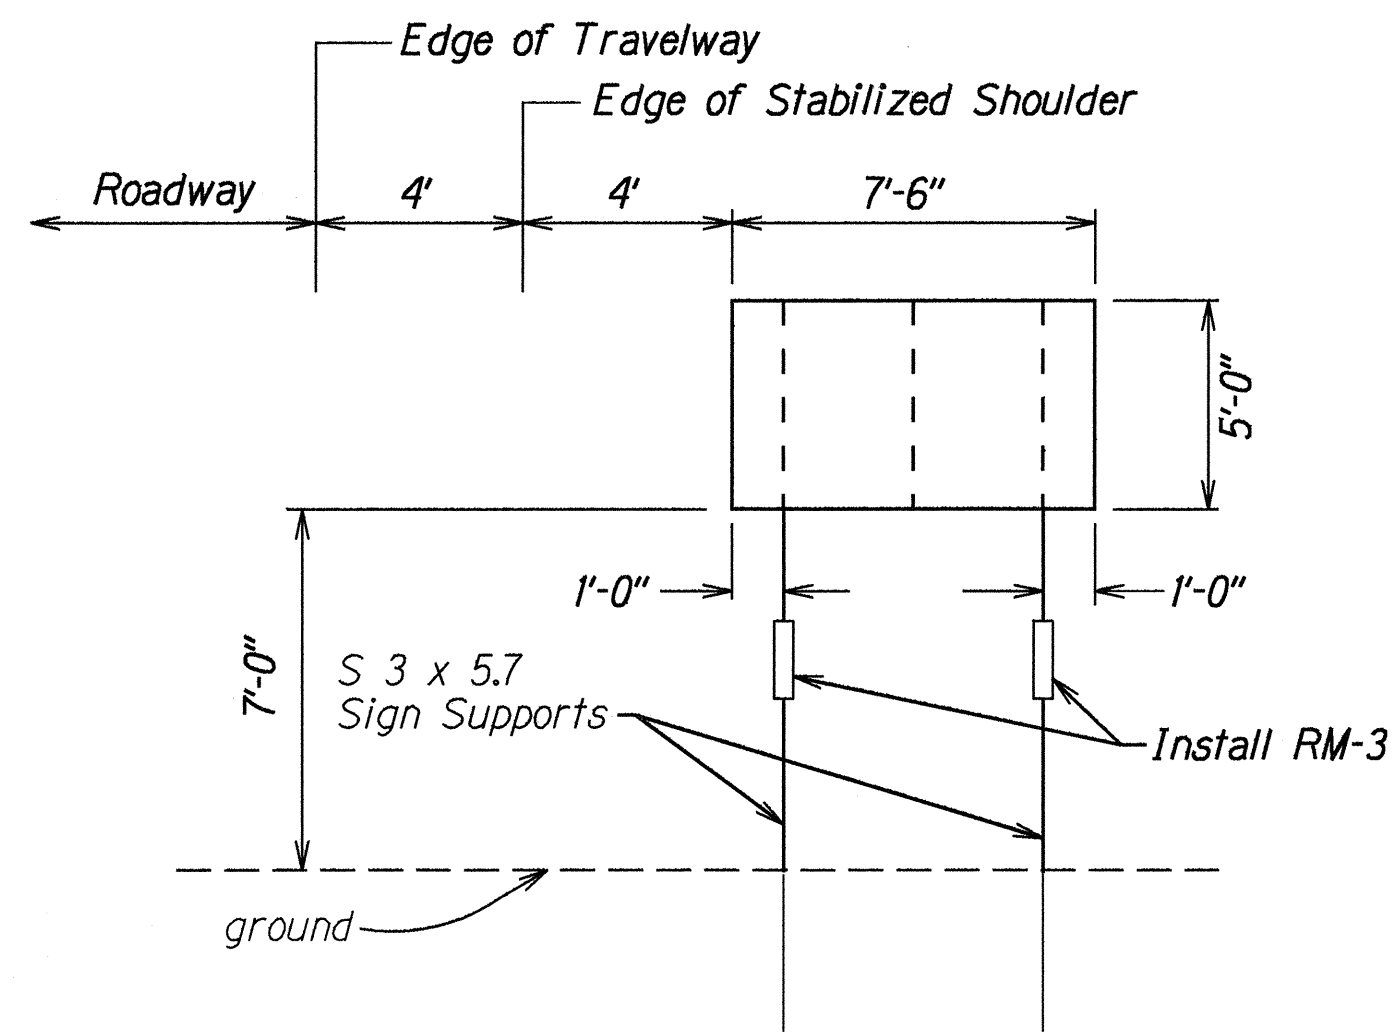


D-1 - DETAIL FRAME LAYOUT
Not To Scale




- NOTE:
1. All letters are series D.
 2. Blank legend and border on white background.


D-8
Not To Scale

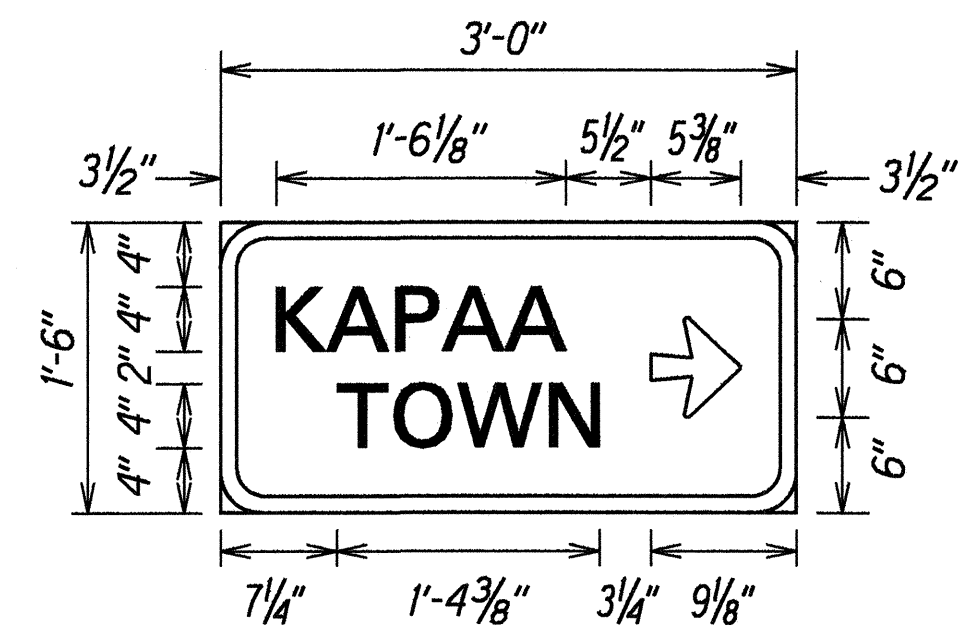


D-2
Not To Scale

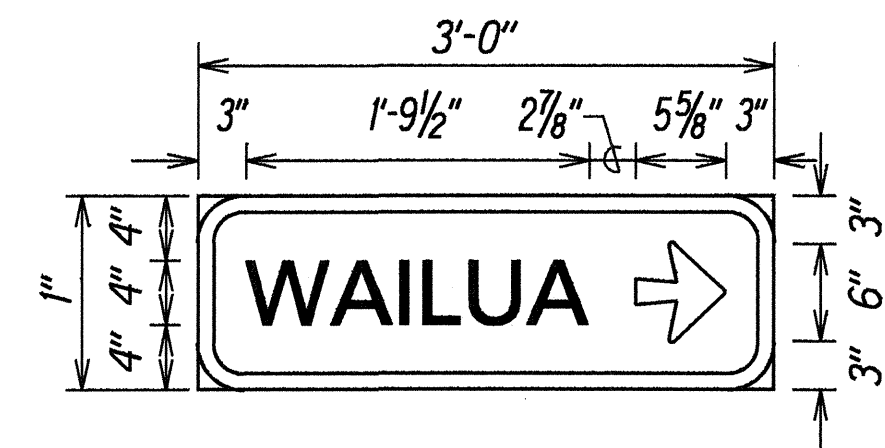


D-4
Not To Scale

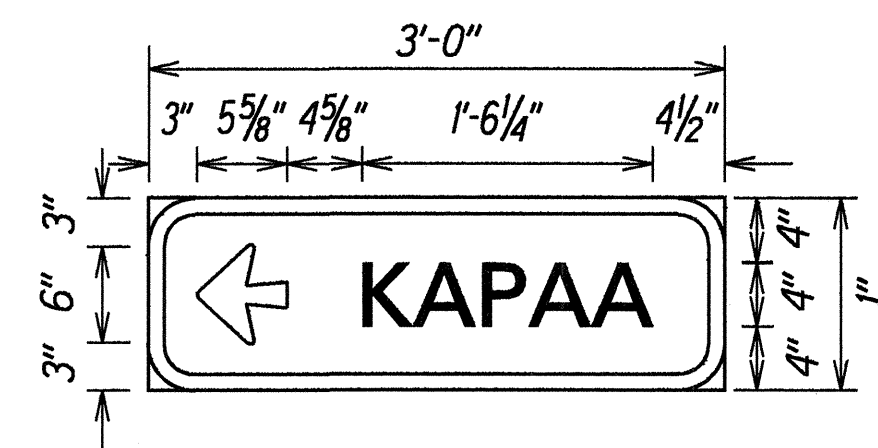


D-6
Not To Scale

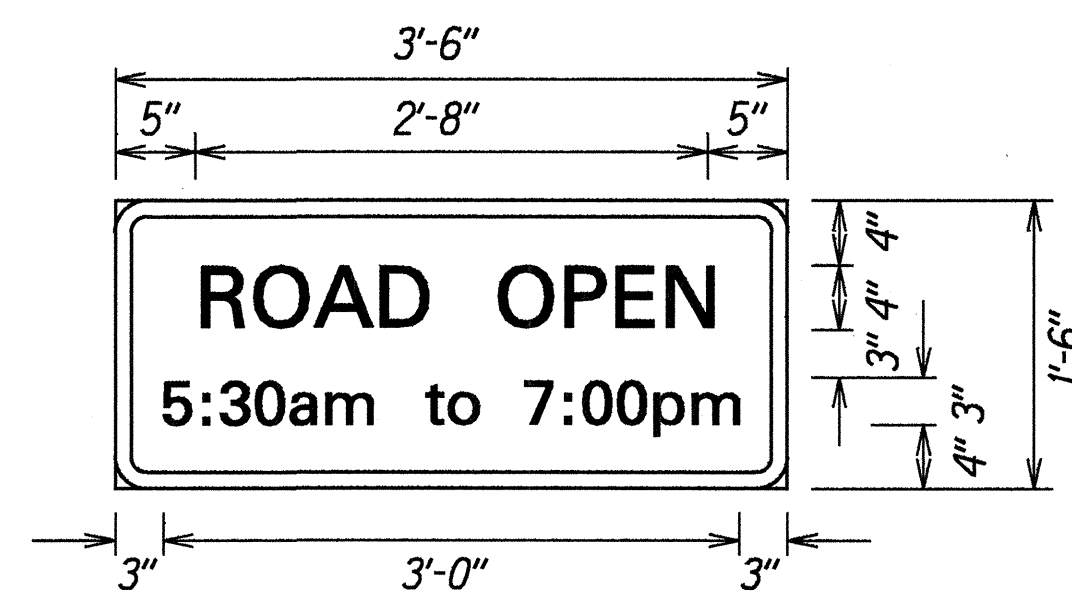


D-9
Not To Scale

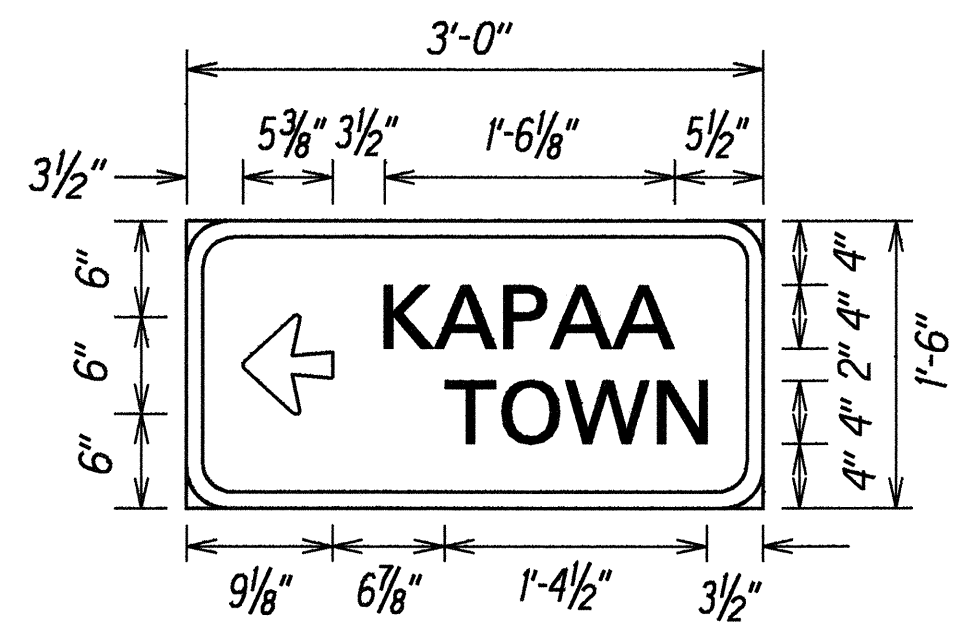

D-3
Not To Scale

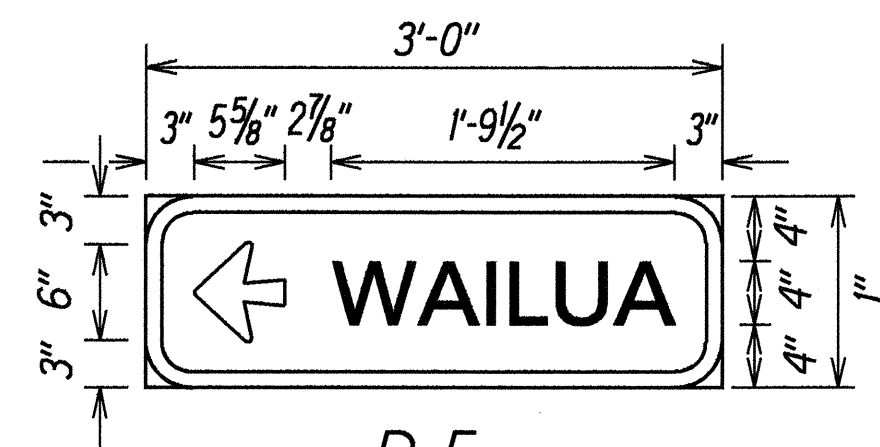

D-5
Not To Scale

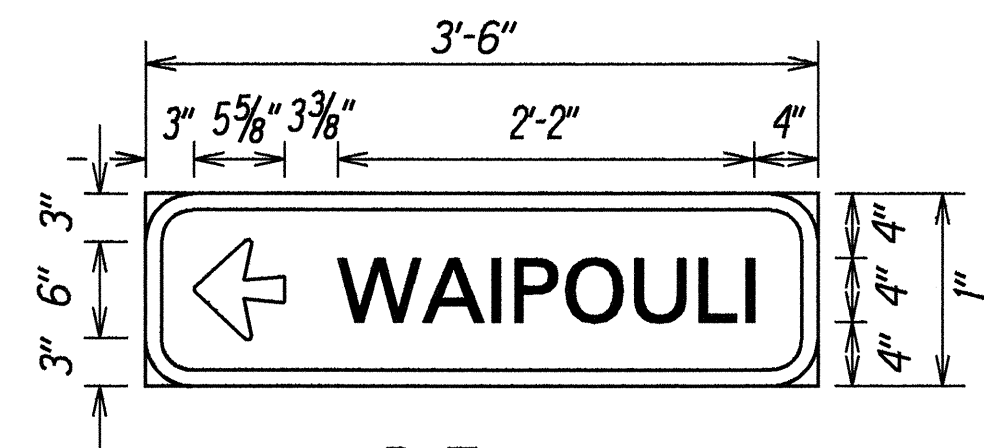

D-7
Not To Scale

STATE OF HAWAII
DEPARTMENT OF TRANSPORTATION
HIGHWAYS DIVISION

SIGN DETAILS
TEMPORARY KAPAA BYPASS ROAD
Project No. 56A-02-95

Scale: As Shown
Date: Feb., 1995