	INDEX TO DRAWINGS
SHEET NO.	DESCRIPTION
1	TITLE SHEET
2	STANDARD PLANS SUMMARY
3	GENERAL & REPAIR NOTES
4	PLAN AND DETAILS-CULVERT REPAIRS AT M.P. 24.20
5	PLAN AND DETAILS-CULVERT REPAIRS AT M.P. 25.30
MA Annation combined, anticorder of Annation Balance Annation Annation Constituted to a desired and annation of	
And the color was the contract of the color	
	· ·

STATE OF HAWAII


## DEPARTMENT OF TRANSPORTATION

HIGHWAYS DIVISION HONOLULU, HAWAII

AS-BUILT PLANS FOR


## KUHIO HIGHWAY REPAIR BOX CULVERTS AT MILE POST 24.20 AND MILE POST 25.30 PROJECT NO. 56D-02-95M

DISTRICT OF HANALEI ISLAND OF KAUAI

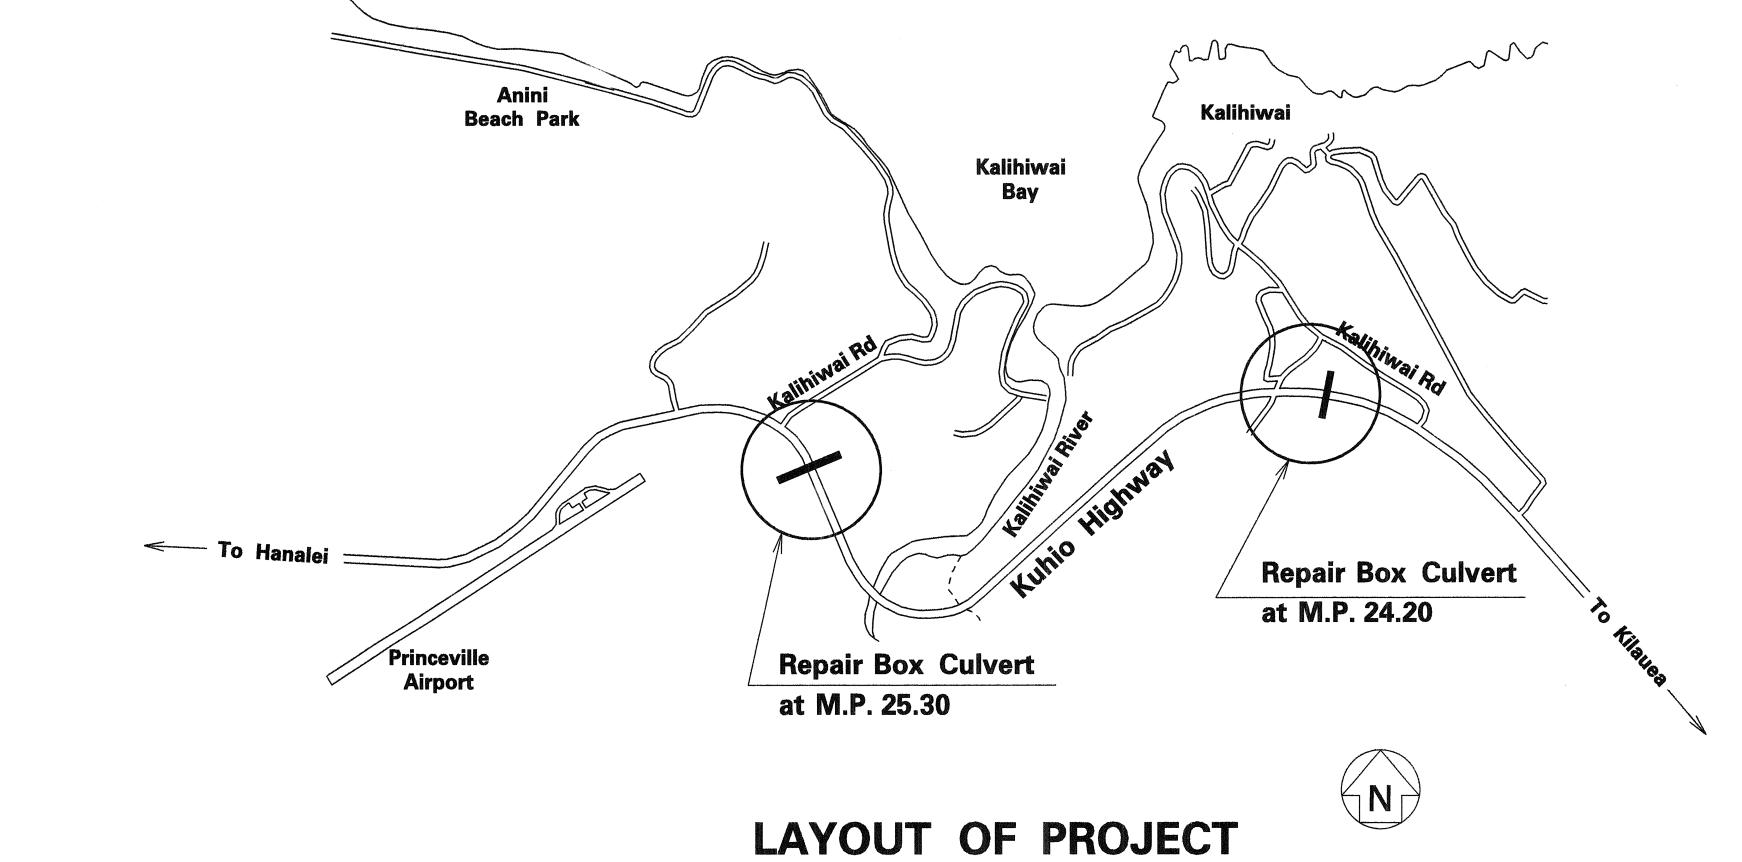


**SCALE: 1"=1500'** 

FED. ROAD<br/>DIST. NO.STATEPROJ. NO.FISCAL<br/>YEARSHEET<br/>NO.TOTAL<br/>SHEETSHAWAIIHAW.56D-02-95M199515

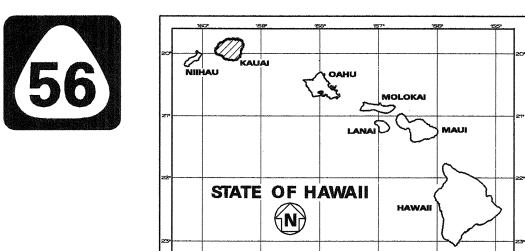

PROJECT LOCATION

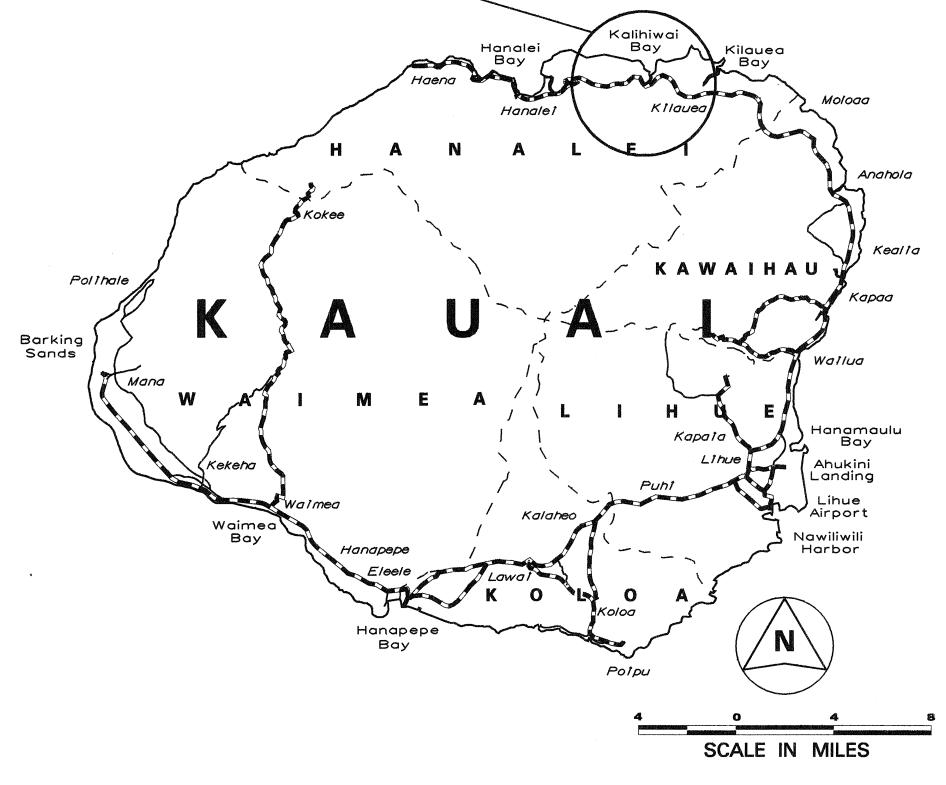

FEDERAL AID PROJECTS PREVIOUSLY CONSTRUCTED OR UNDER CONSTRUCTION

CULVERT REPAIR AT M.P. 24.20 CULVERT REPAIR AT M.P. 25.30

NO SIGNIFICANT CHANGES WERE MADE DURING CONSTRUCTION ON THESE PLANS EXCEPT CHANGES IN THE ORIGINAL THEORETICAL QUANTITIES.

RESIDENT ENGINEER

1/2/96 DATE

DEPARTMENT OF TRANSPORTATION STATE OF HAWAII APPROVED:

DIR. OF TRANSPORTATION

2)/1/95 TION DATE