

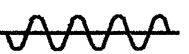
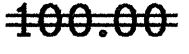
FED. ROAD DIST. NO.	STATE	FED. AID PROJ. NO.	FISCAL YEAR	SHEET NO.	TOTAL SHEETS
HAWAII	HAW.	56A-01-95M	1995	10	10

SPALL REPAIR SUMMARY (SQ. FT.)

LOCATION		PIER SPANS								Totals
		0-1	1-2	2-3	3-4	4-5	5-6	6-7	7-8	
BOTTOM OF DECK (INCLUD STRUTS)		6	9	30	85	90 <del>15</del>	294 <del>46</del>	146 <del>43</del>	90 <del>9</del>	620 <del>243</del>
GIRDER 1	OUTSIDE FACE	11	0	0	5	12 <del>4</del>	193 <del>75</del>	95 <del>21</del>	76 <del>66</del>	376 <del>182</del>
	BOTTOM	28	33	0	70	30 <del>60</del>	100 <del>80</del>	40	35 <del>36</del>	205 <del>347</del>
	INSIDE FACE	36	118	120	48	64 <del>80</del>	163 <del>54</del>	102 <del>25</del>	42 <del>33</del>	371 <del>514</del>
GIRDER 2	OUTSIDE FACE	15	15	21	89	28 <del>80</del>	183 <del>11</del>	74 <del>0</del>	25 <del>10</del>	310 <del>241</del>
	BOTTOM	36	48	85	100	28 <del>100</del>	100 <del>40</del>	40 <del>32</del>	25 <del>22</del>	193 <del>463</del>
	INSIDE FACE	36	63	69	23	64 <del>24</del>	155 <del>0</del>	96 <del>87</del>	53 <del>10</del>	368 <del>312</del>
TOTALS		168	286	325	420	*316 <del>363</del>	1188 <del>306</del>	593 <del>248</del>	346 <del>186</del>	2443 <del>2302</del>

\*Repair work on Span (4-5) is partially completed.

ORIGINAL PLAN	DESIGNED BY HAWAII	DATE 7-5-95
NOTED BY HAWAII	DESIGNED BY HAWAII	DATE 7-5-95
CHECKED BY HAWAII	DESIGNED BY HAWAII	DATE 7-5-95

LEGEND FOR AS-BUILT POSTINGS	
	Squiggly line for as-built deletion
	Double line for as-built deletion
Roadway	Text for as-built posting

STATE OF HAWAII DEPARTMENT OF TRANSPORTATION HIGHWAYS DIVISION
<b>SPALL REPAIR SUMMARY</b>
KUHIO HIGHWAY, REPAIR SPALLS ON WAILUA (PLANTATION) BRIDGE
Project No. 56A-01-95M
Date: Mar, 1995