


FED. ROAD DIST. NO.	STATE	FED. AID PROJ. NO.	FISCAL YEAR	SHEET NO.	TOTAL SHEETS
HAWAII	HAW.	56A-01-95M	1995	5	10

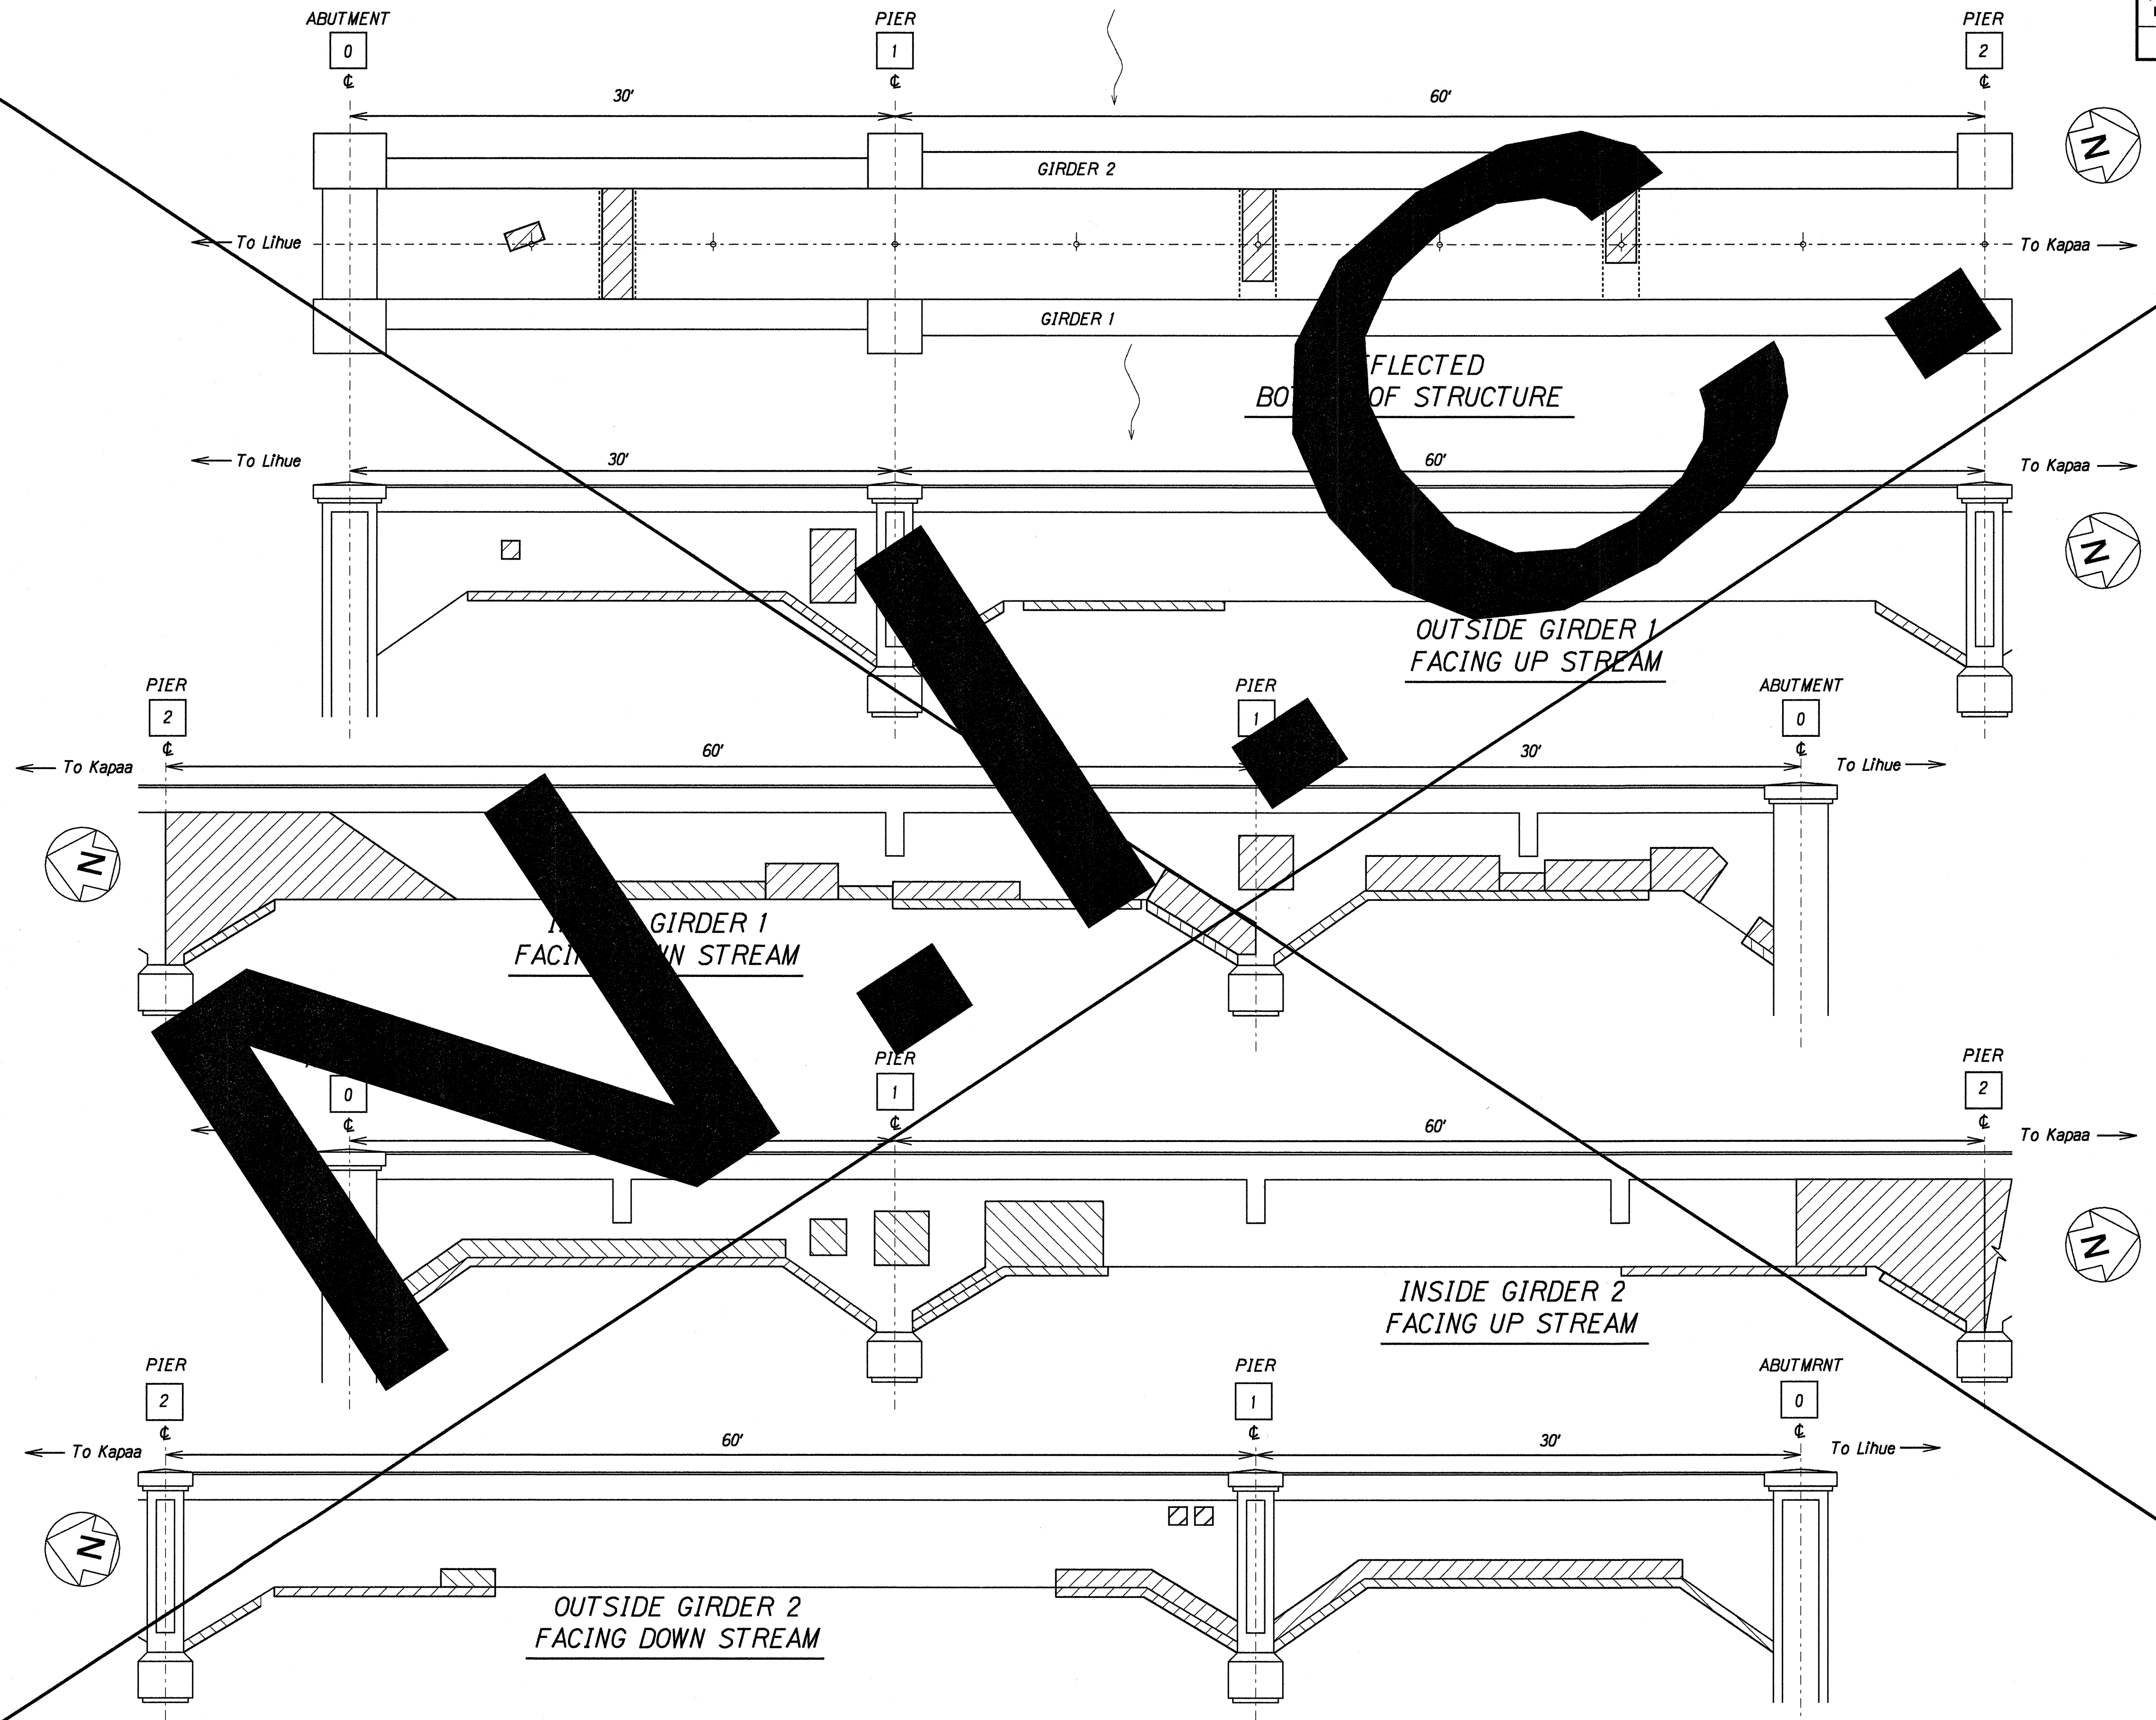

ORIGINAL PLAN	DATE	1995
SURVEY PLOTTED BY		
DRAWN BY		
CHECKED BY		
NOTED BY		
QUANTITIES BY		
CHECKED BY		

WAILUA (PLANTATION) BRIDGE REPAIR
Scale: 1"=5'

STATE OF HAWAII
DEPARTMENT OF TRANSPORTATION
HIGHWAYS DIVISION

STRUCTURE REPAIR


KUHIO HIGHWAY, REPAIR SPALLS
ON WAILUA (PLANTATION) BRIDGE

Project No. 56A-01-95M

Scale: 1" = 5' Date: Jan, 1995

SHEET No. 1 OF 4 SHEETS

FED. ROAD DIST. NO.	STATE	PROJ. NO.	FISCAL YEAR	SHEET NO.	TOTAL SHEETS
HAWAII	HAW.	56A-01-95M	1995	6	10

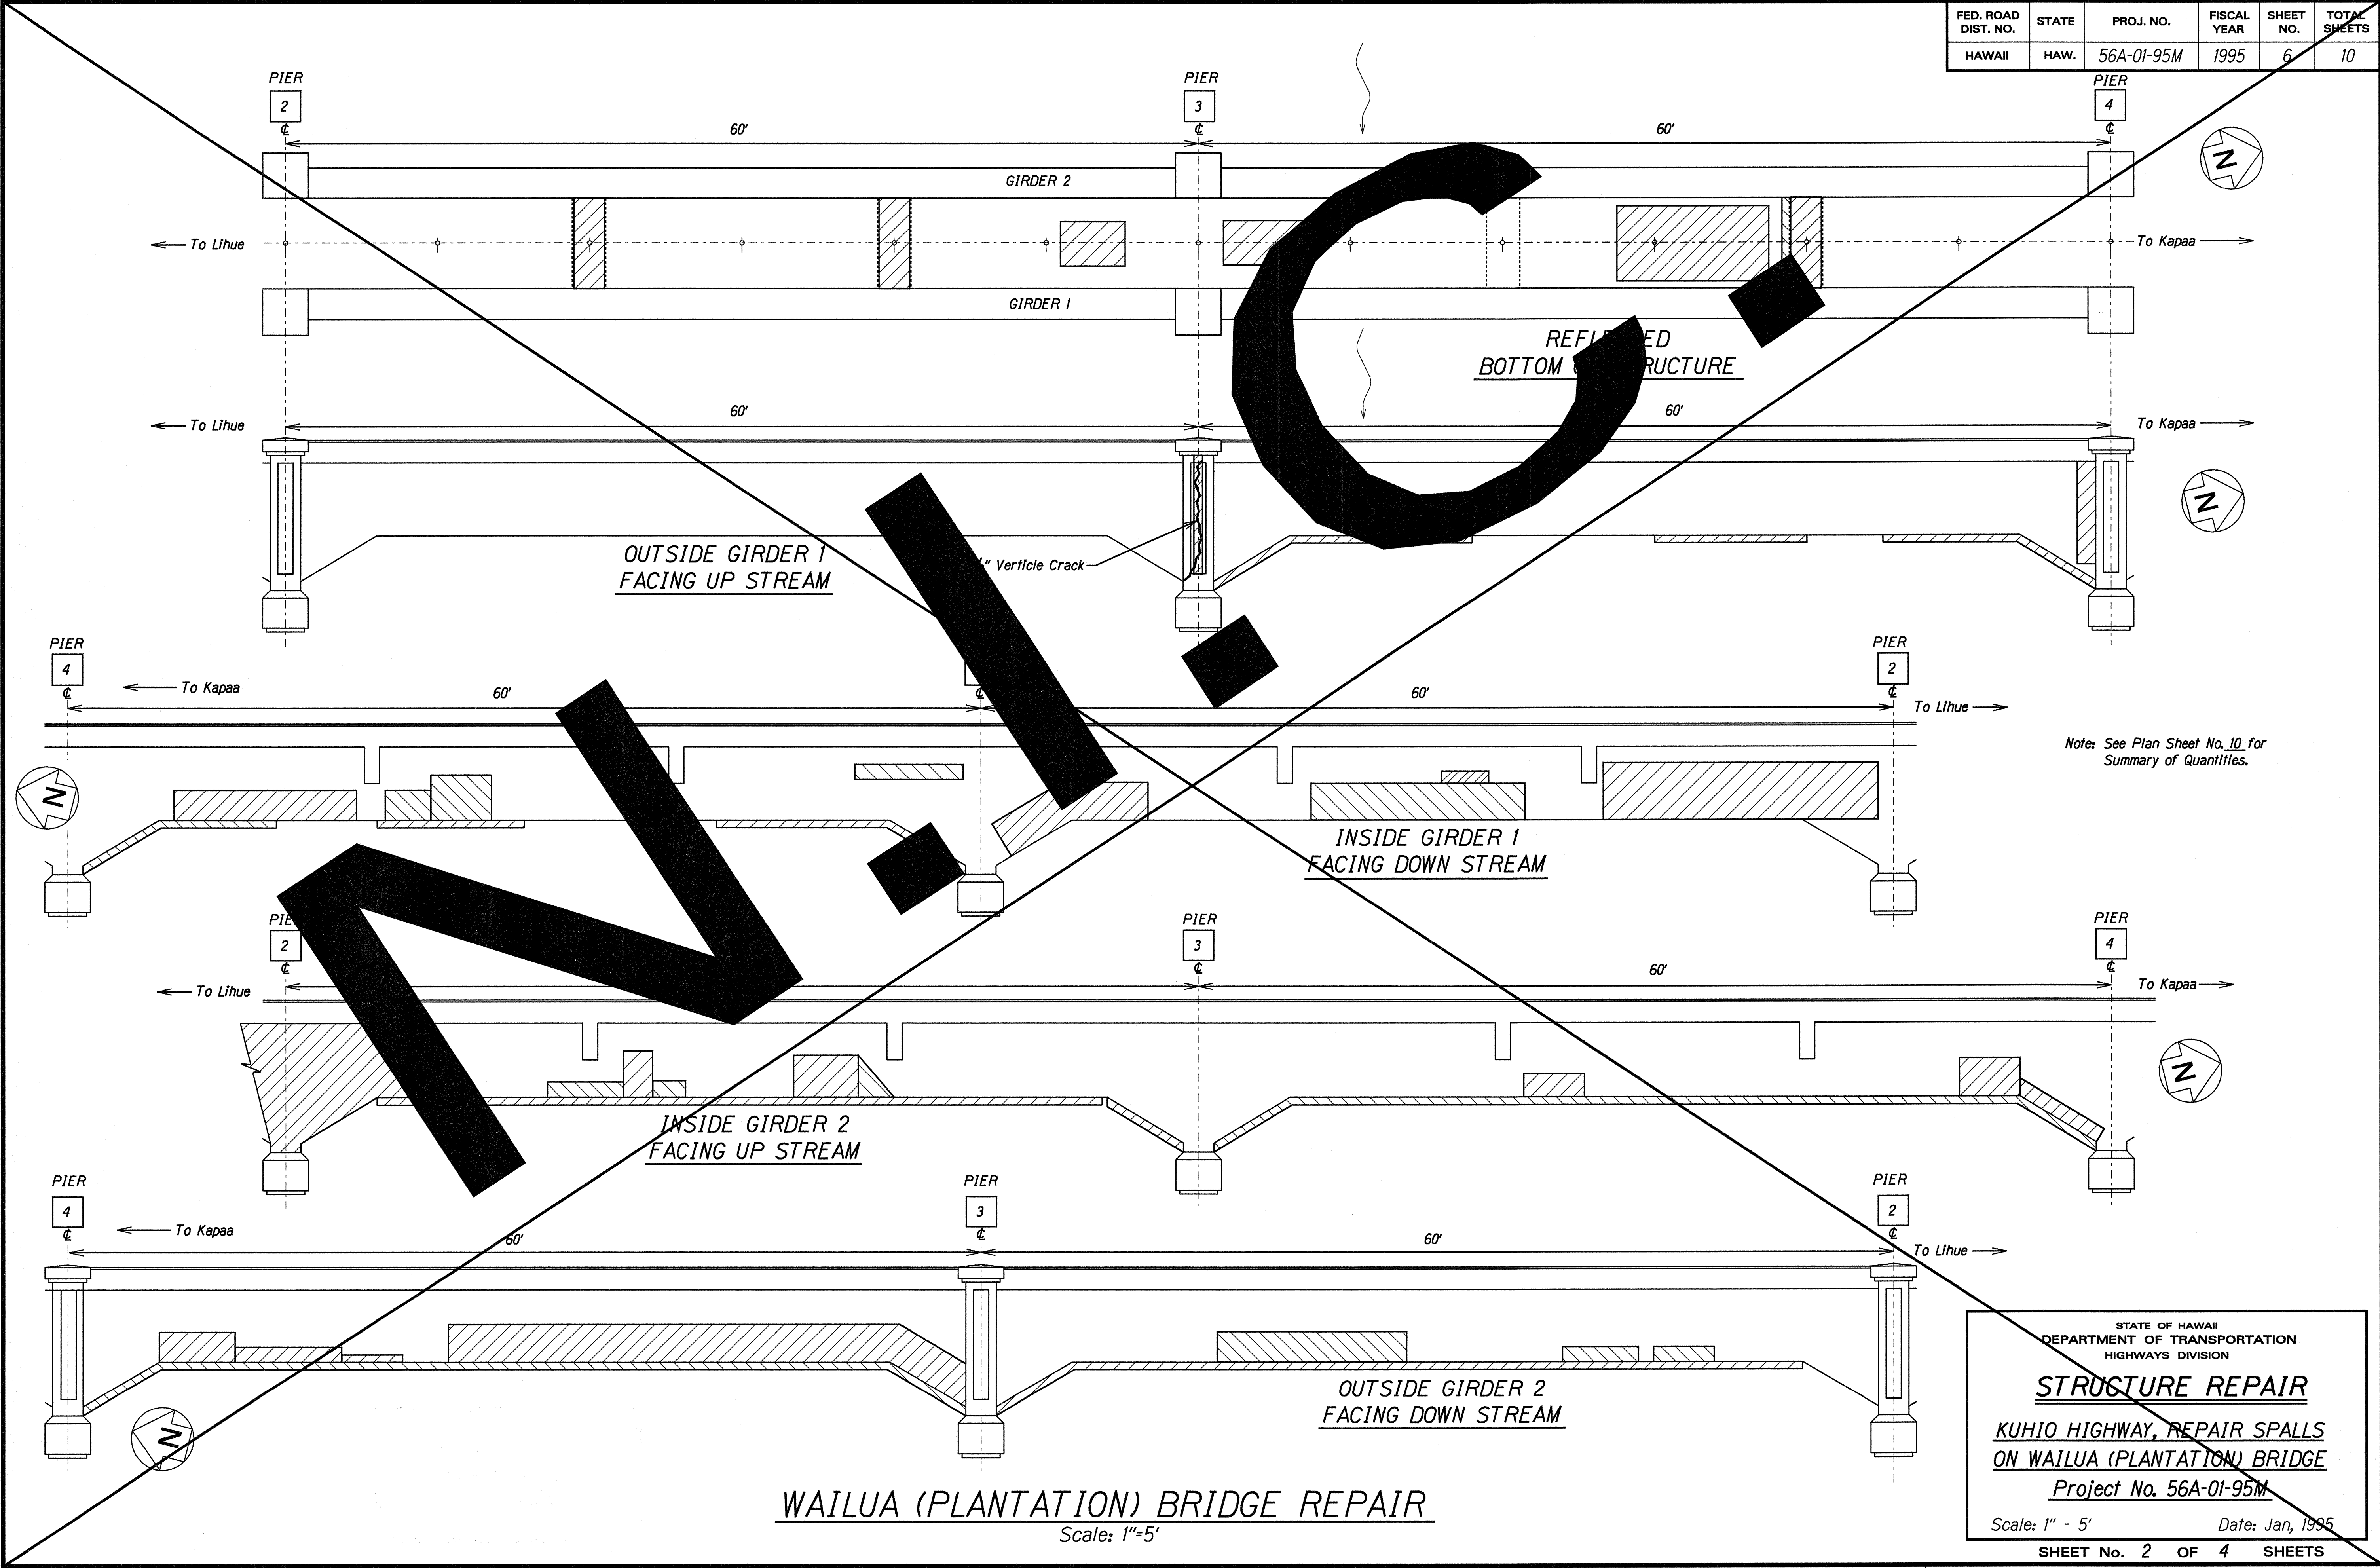

ORIGINAL PLAN	DATE	1995
DESIGNED BY	Y	
NOTES BOOK	444/6500	
CHECKED BY	AK/KUH002	1-5-95

STATE OF HAWAII
DEPARTMENT OF TRANSPORTATION
HIGHWAYS DIVISION


STRUCTURE REPAIR

KUHIO HIGHWAY, REPAIR SPALLS
ON WAILUA (PLANTATION) BRIDGE
Project No. 56A-01-95M

Scale: 1" = 5'
Date: Jan, 1995

SHEET No. 2 OF 4 SHEETS

FED. ROAD DIST. NO.	STATE	PROJ. NO.	FISCAL YEAR	SHEET NO.	TOTAL SHEETS
HAWAII	HAW.	56A-01-95M	1995	7	10

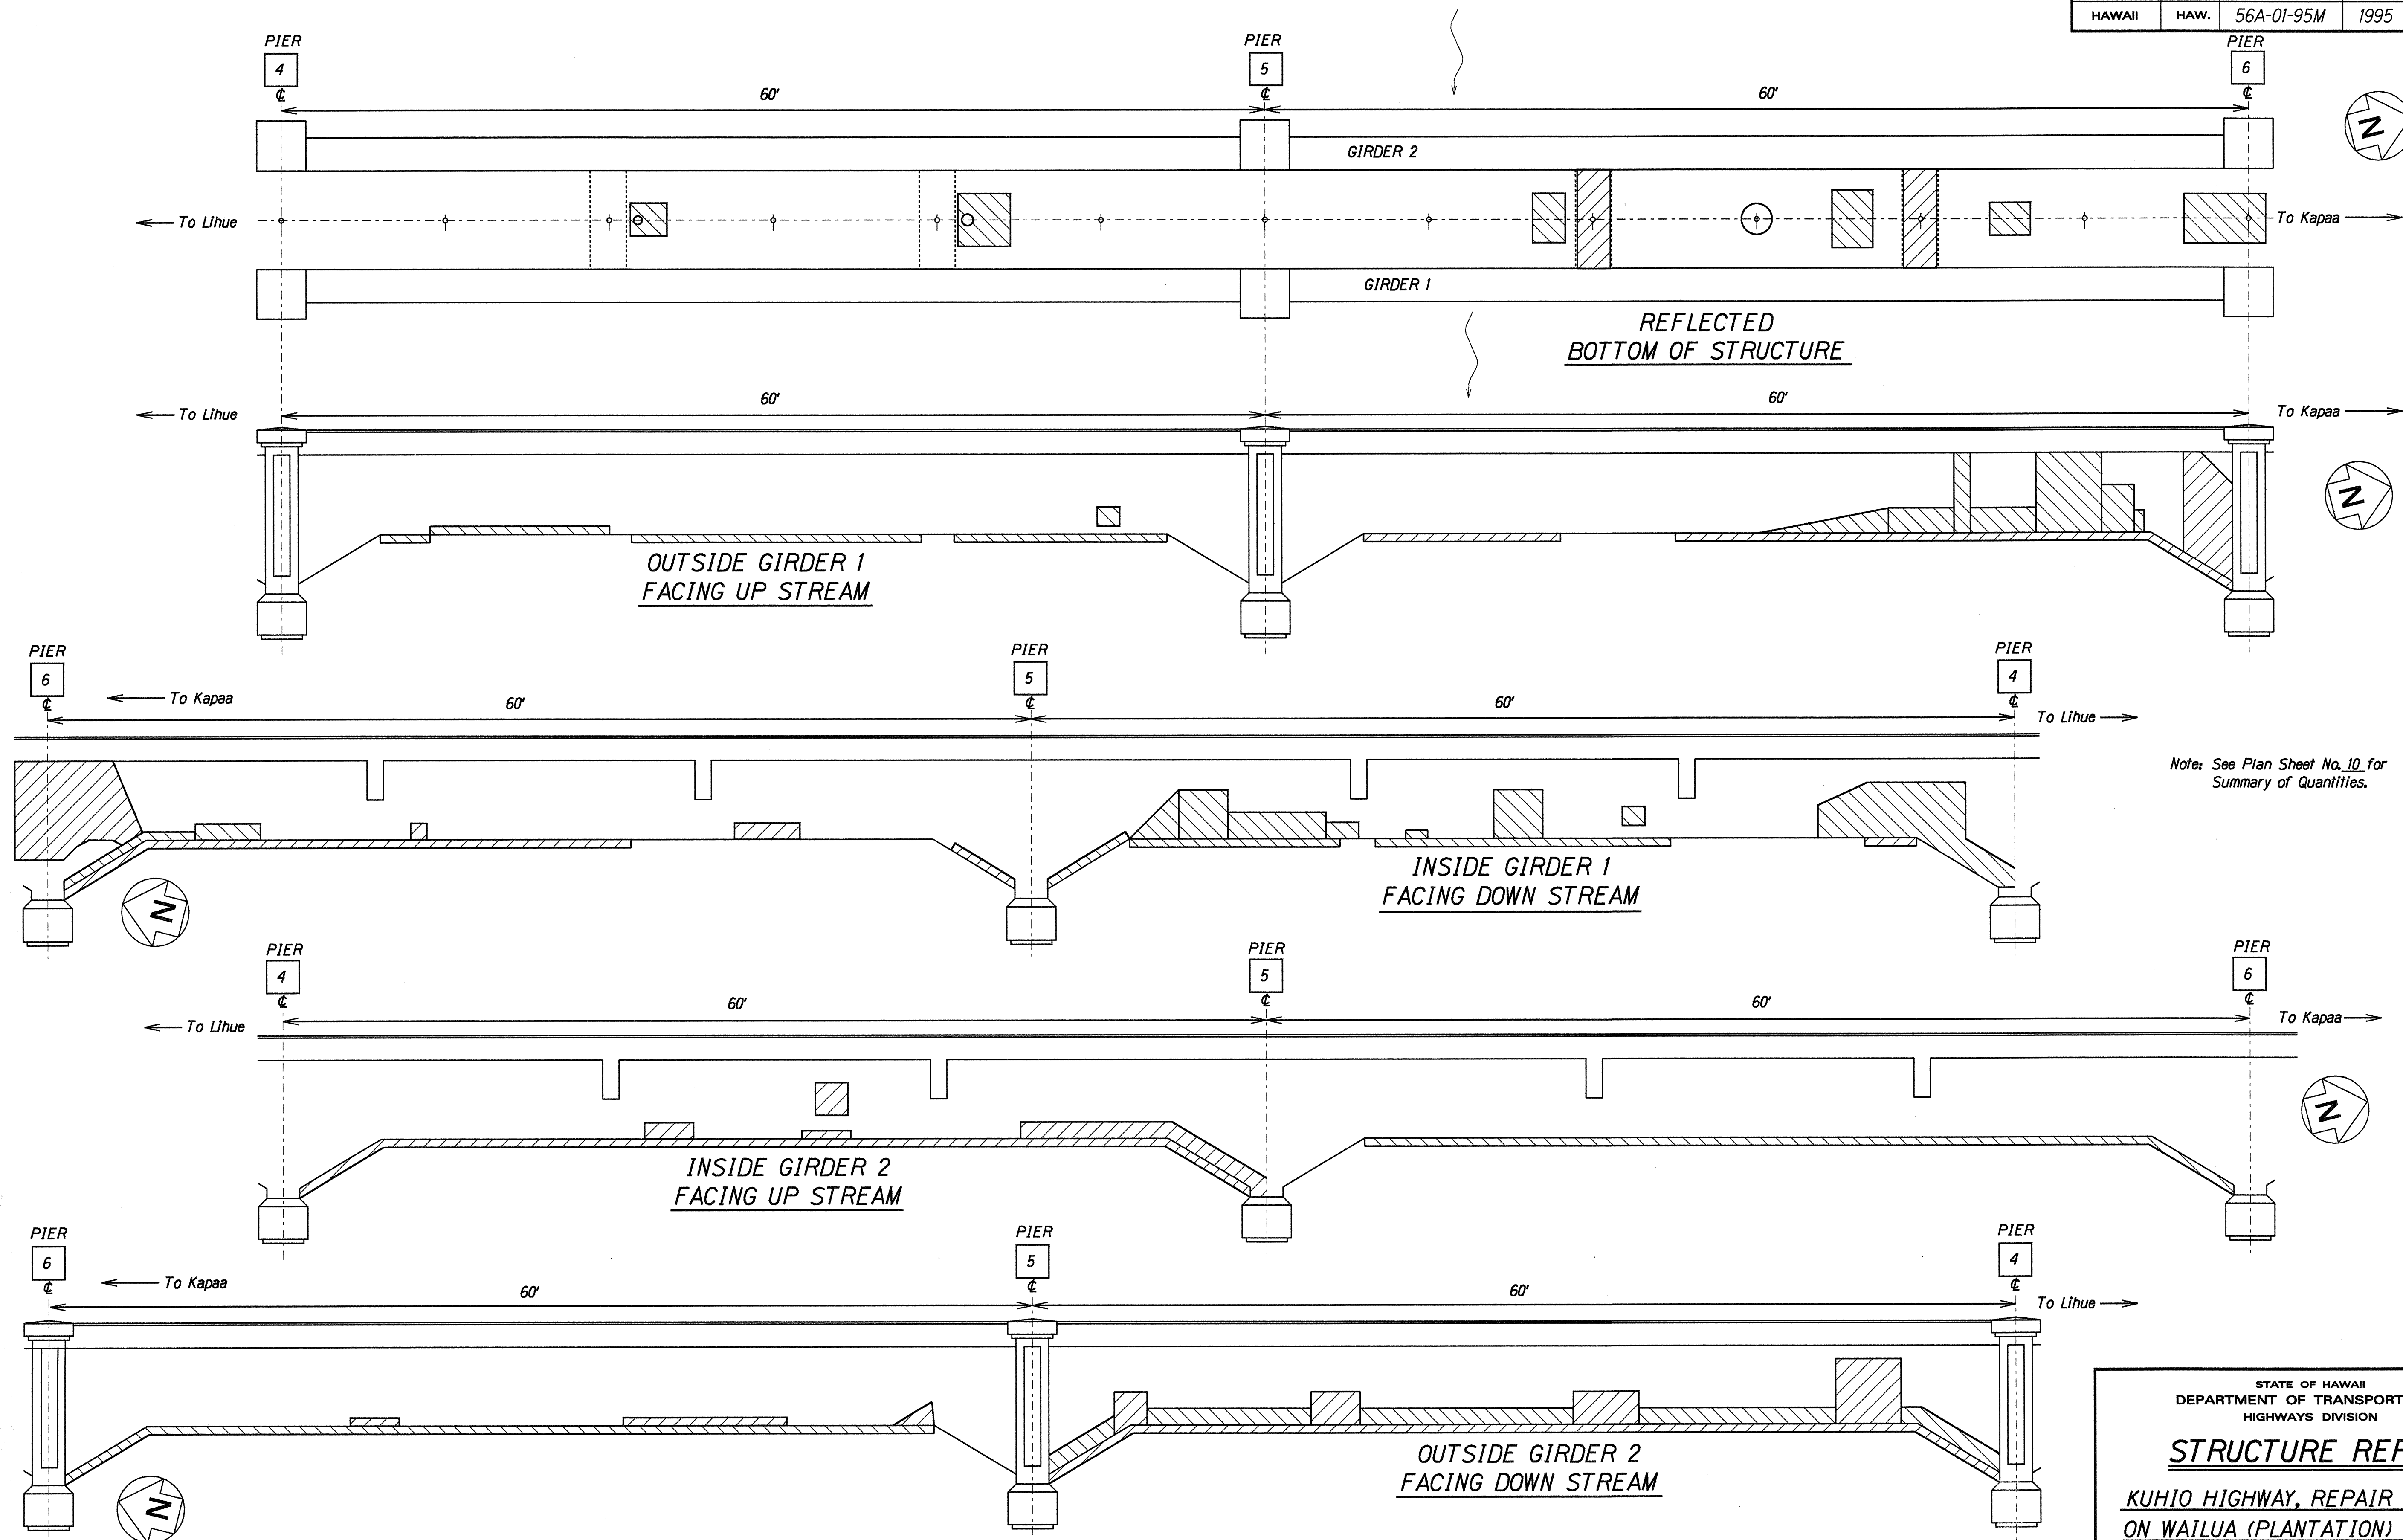


SURVEY PLOTTED BY: _____ DATE: 1995
 DRAWN BY: Maunaloa
 TRACED BY: _____
 DESIGNED BY: _____
 CHECKED BY: _____
 NOTED BY: _____
 PROJECT NO.: 56A-01-95M

WAILUA (PLANTATION) BRIDGE REPAIR
 Scale: 1"=5'

STATE OF HAWAII
 DEPARTMENT OF TRANSPORTATION
 HIGHWAYS DIVISION

STRUCTURE REPAIR
 KUHIO HIGHWAY, REPAIR SPALLS
 ON WAILUA (PLANTATION) BRIDGE
 Project No. 56A-01-95M
 Scale: 1" = 5' Date: Jan, 1995
 SHEET No. 3 OF 4 SHEETS

FED. ROAD DIST. NO.	STATE	PROJ. NO.	FISCAL YEAR	SHEET NO.	TOTAL SHEETS
HAWAII	HAW.	56A-01-95M	1995	8	10

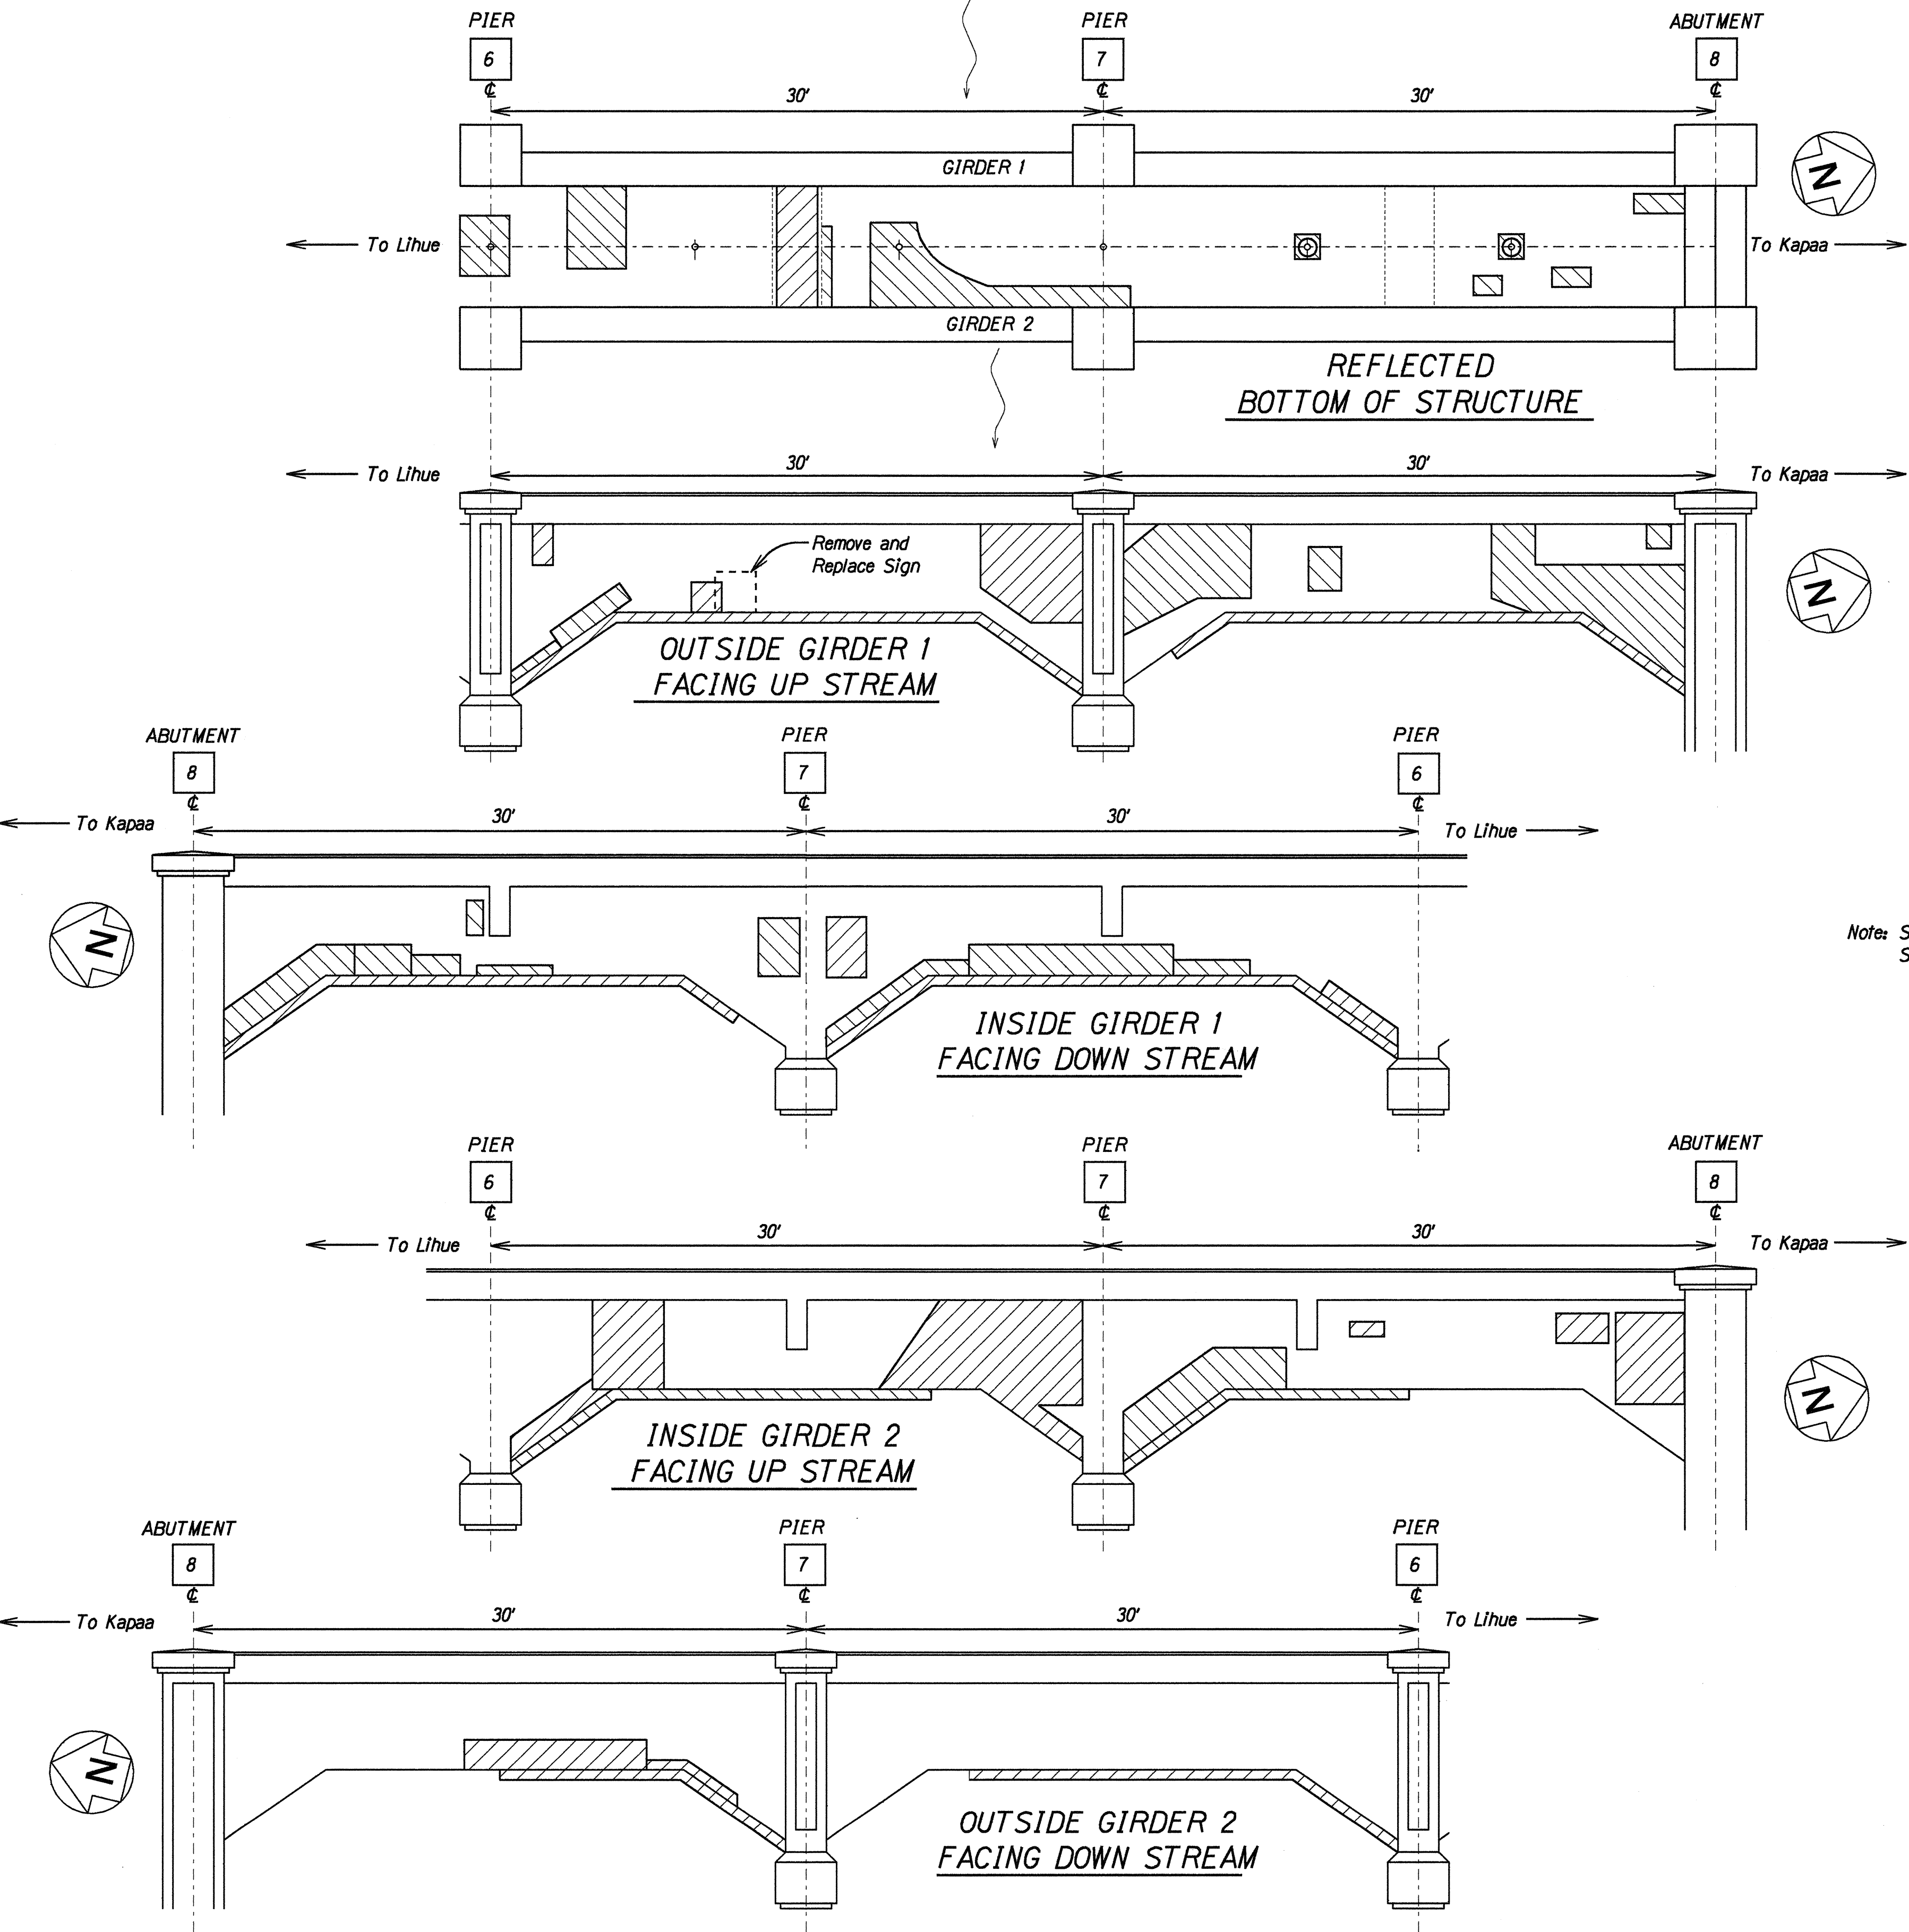

Note: See Plan Sheet No. 10 for
Summary of Quantities.

SURVEY PLOTTED BY	DATE
DRAWN BY	1995
NOTES BOOK	
CHECKED BY	
ORIGINAL PLAN	
NOTES BOOK	
CHECKED BY	

WAILUA (PLANTATION) BRIDGE REPAIR
Scale: 1"=5'

STATE OF HAWAII
DEPARTMENT OF TRANSPORTATION
HIGHWAYS DIVISION

STRUCTURE REPAIR
**KUHIO HIGHWAY, REPAIR SPALLS
ON WAILUA (PLANTATION) BRIDGE**
Project No. 56A-01-95M
Scale: 1" = 5' Date: Jan, 1995

SHEET No. 4 OF 4 SHEETS