	INDEX TO DRAWINGS				
SHEET NO.	DESCRIPTION				
1	TITLE SHEET				
2	STANDARD PLAN SUMMARY				
3	GENERAL NOTES & LEGEND				
4	DETAILS				
* 5-8	STRUCTURE REPAIR				
9	TYPICAL SECTION				
10	SPALL REPAIR SUMMARY				

PLAN SHEET NOS. 5 AND 6 ARE DELETED FROM THE CONTRACT PLANS.

NEW TOTAL = 8

STATE OF HAWAII

DEPARTMENT OF TRANSPORTATION


HIGHWAYS DIVISION
HONOLULU, HAWAII
"AS-BUILT"

PLANS FOR

KUHIO HIGHWAY


REPAIR SPALLS ON WAILUA (PLANTATION) BRIDGE PROJECT NO. 56A-01-95M


DISTRICT OF KAWAIHAU
ISLAND OF KAUAI

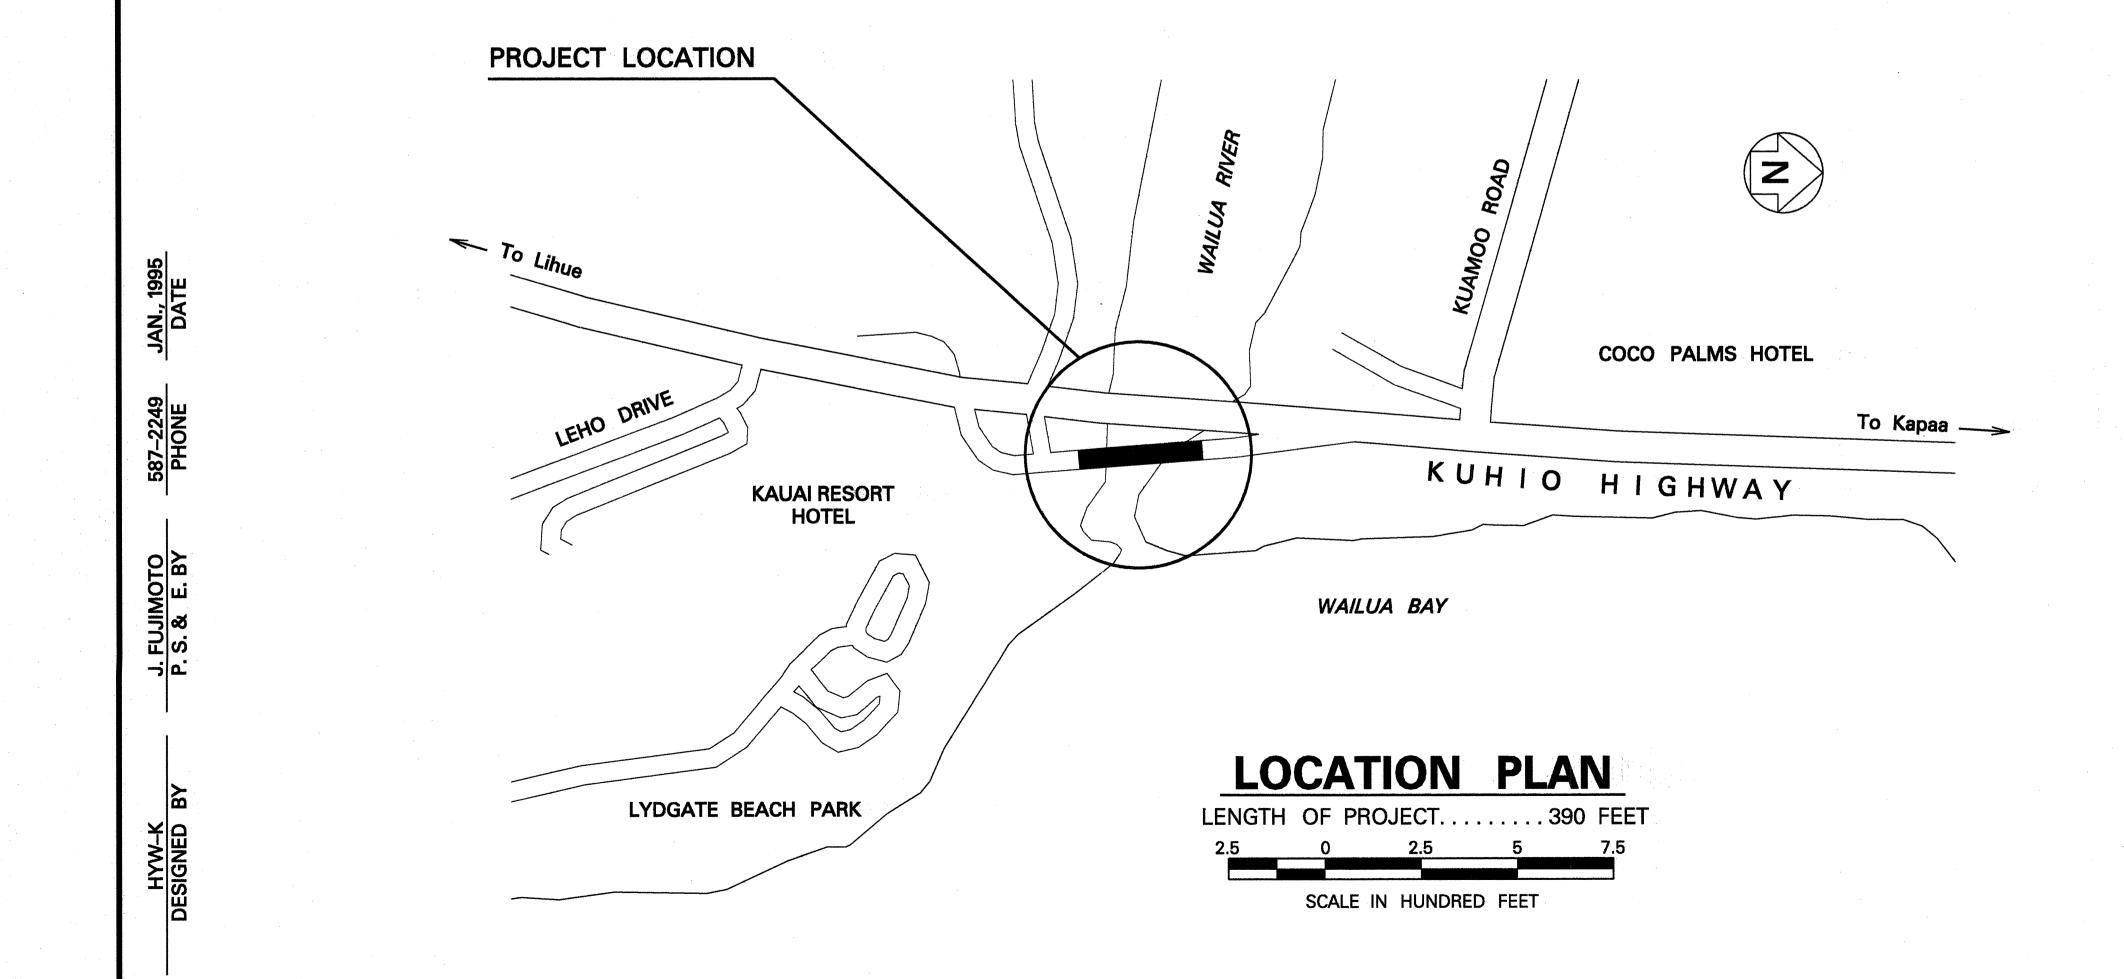

FED. ROAD DIST. NO.	STATE	PROJ. NO.	FISCAL YEAR	SHEET NO.	TOTAL SHEETS	
HAWAII	HAW.	56A-01-95M	1995	1 1	10	



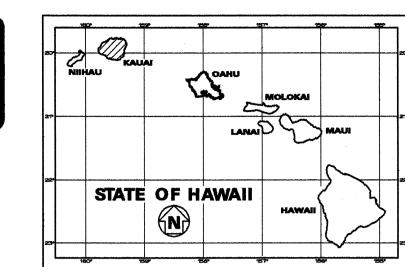

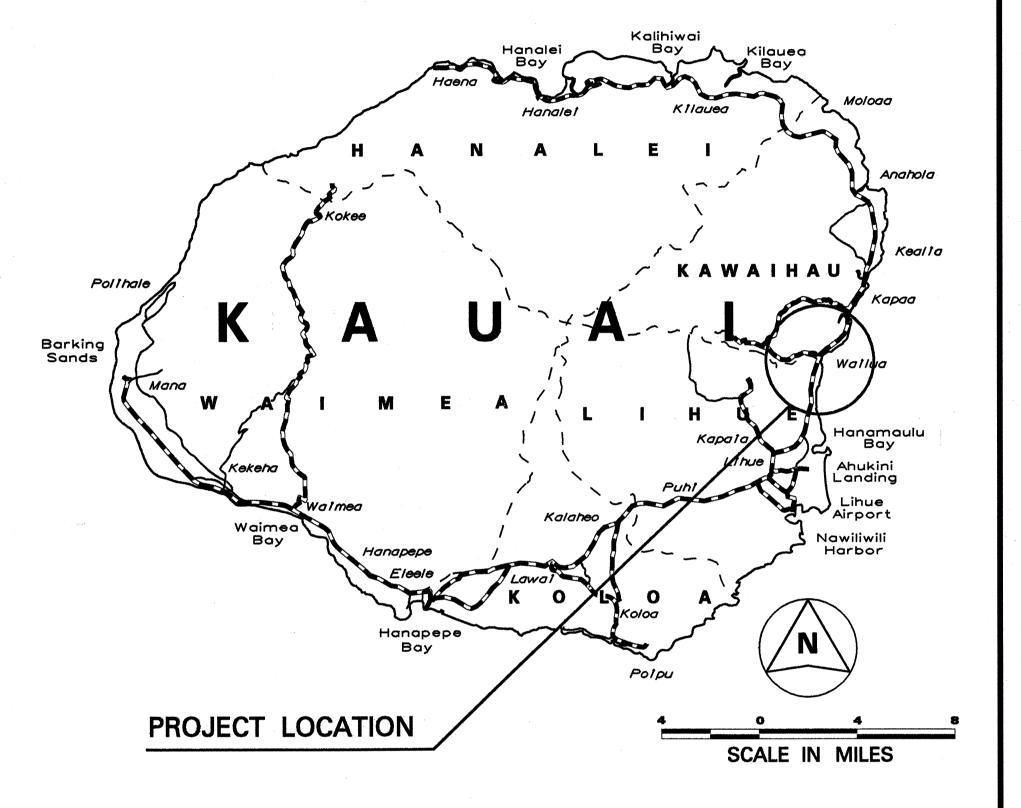

FEDERAL AID PROJECTS PREVIOUSLY CONSTRUCTED OR UNDER CONSTRUCTION

MILE POST <u>5.83</u>

CHANGES MADE DURING CONSTRUCTION HAVE BEEN NOTED ON THESE PLANS AND CHECKED BY:

D. Maeda by: HAMPS RESIDENT ENGINEER

9-22-97 DATE

DEPARTMENT OF TRANSPORT STATE OF HAWAII	TATION
APPROVED:	
amCallex	5-11-95
DIR. OF TRANSPORTATION	DATE