



| FED. ROAD DIST. NO. | STATE | FED. AID PROJ. NO. | FISCAL YEAR | SHEET NO. | TOTAL SHEETS |
|---------------------|-------|--------------------|-------------|-----------|--------------|
| HAWAII              | HAW.  | 56A-01-95M         | 1995        | 9         | 10           |

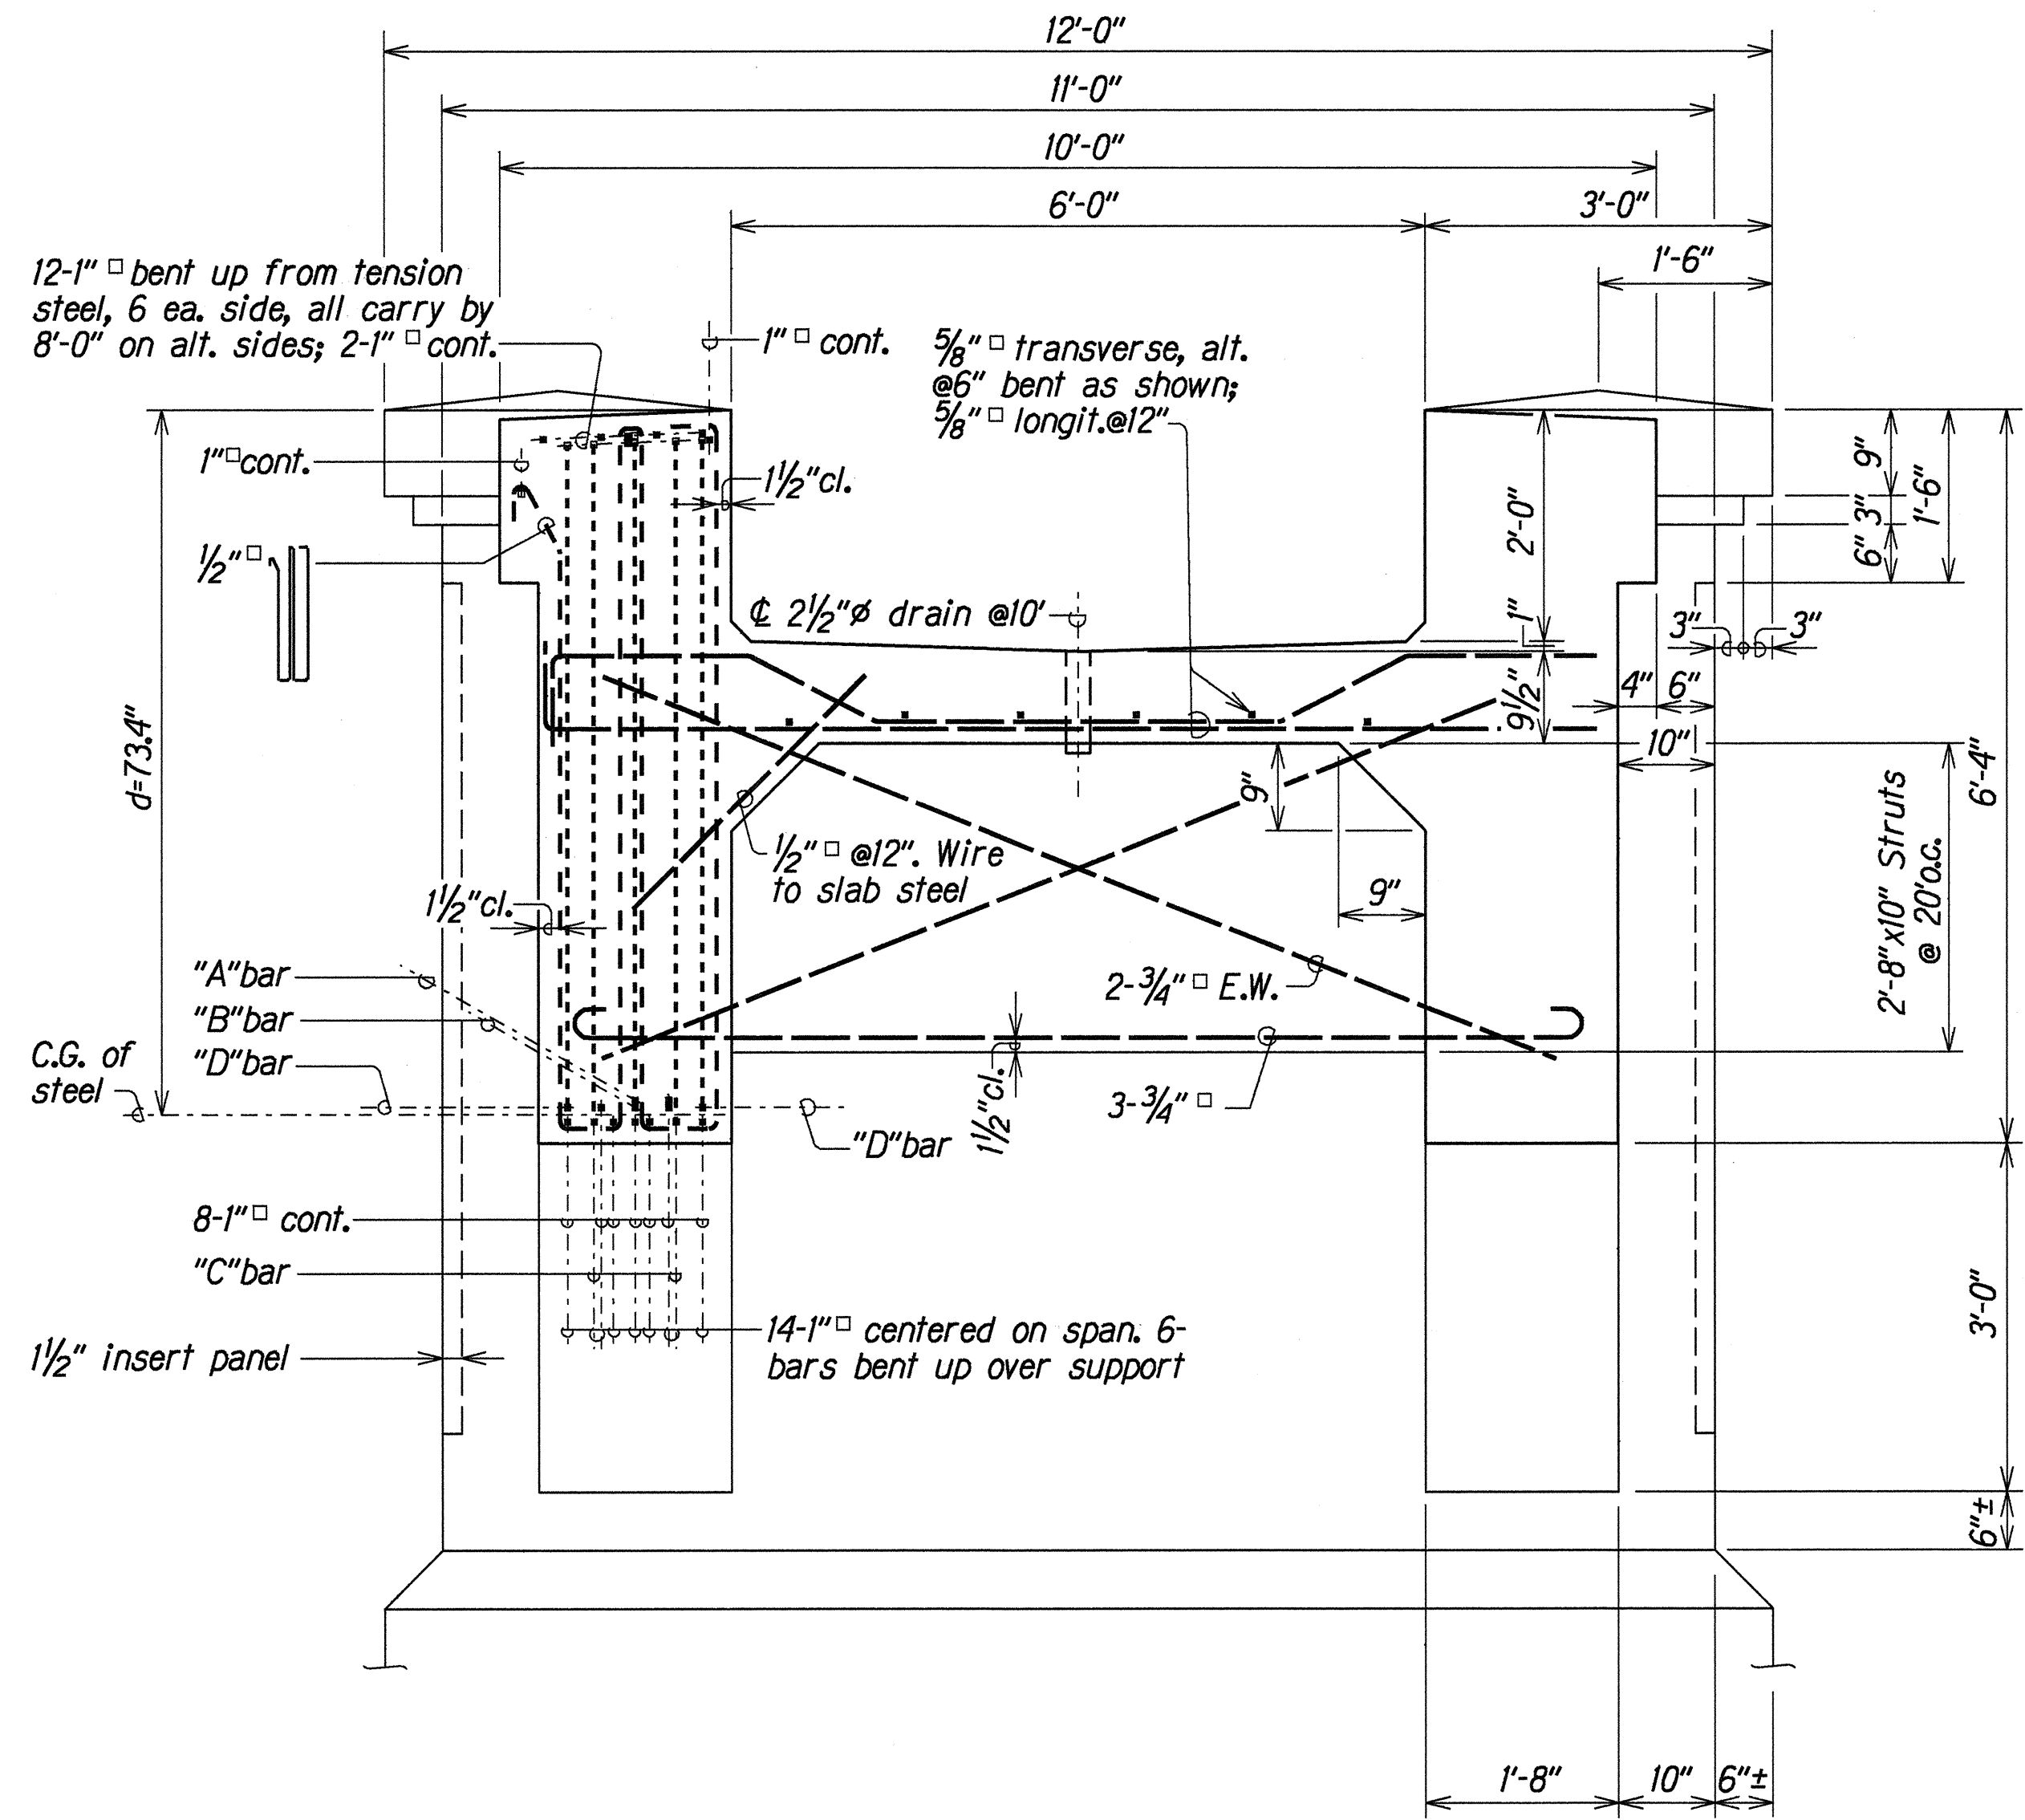

AT 60' SPAN

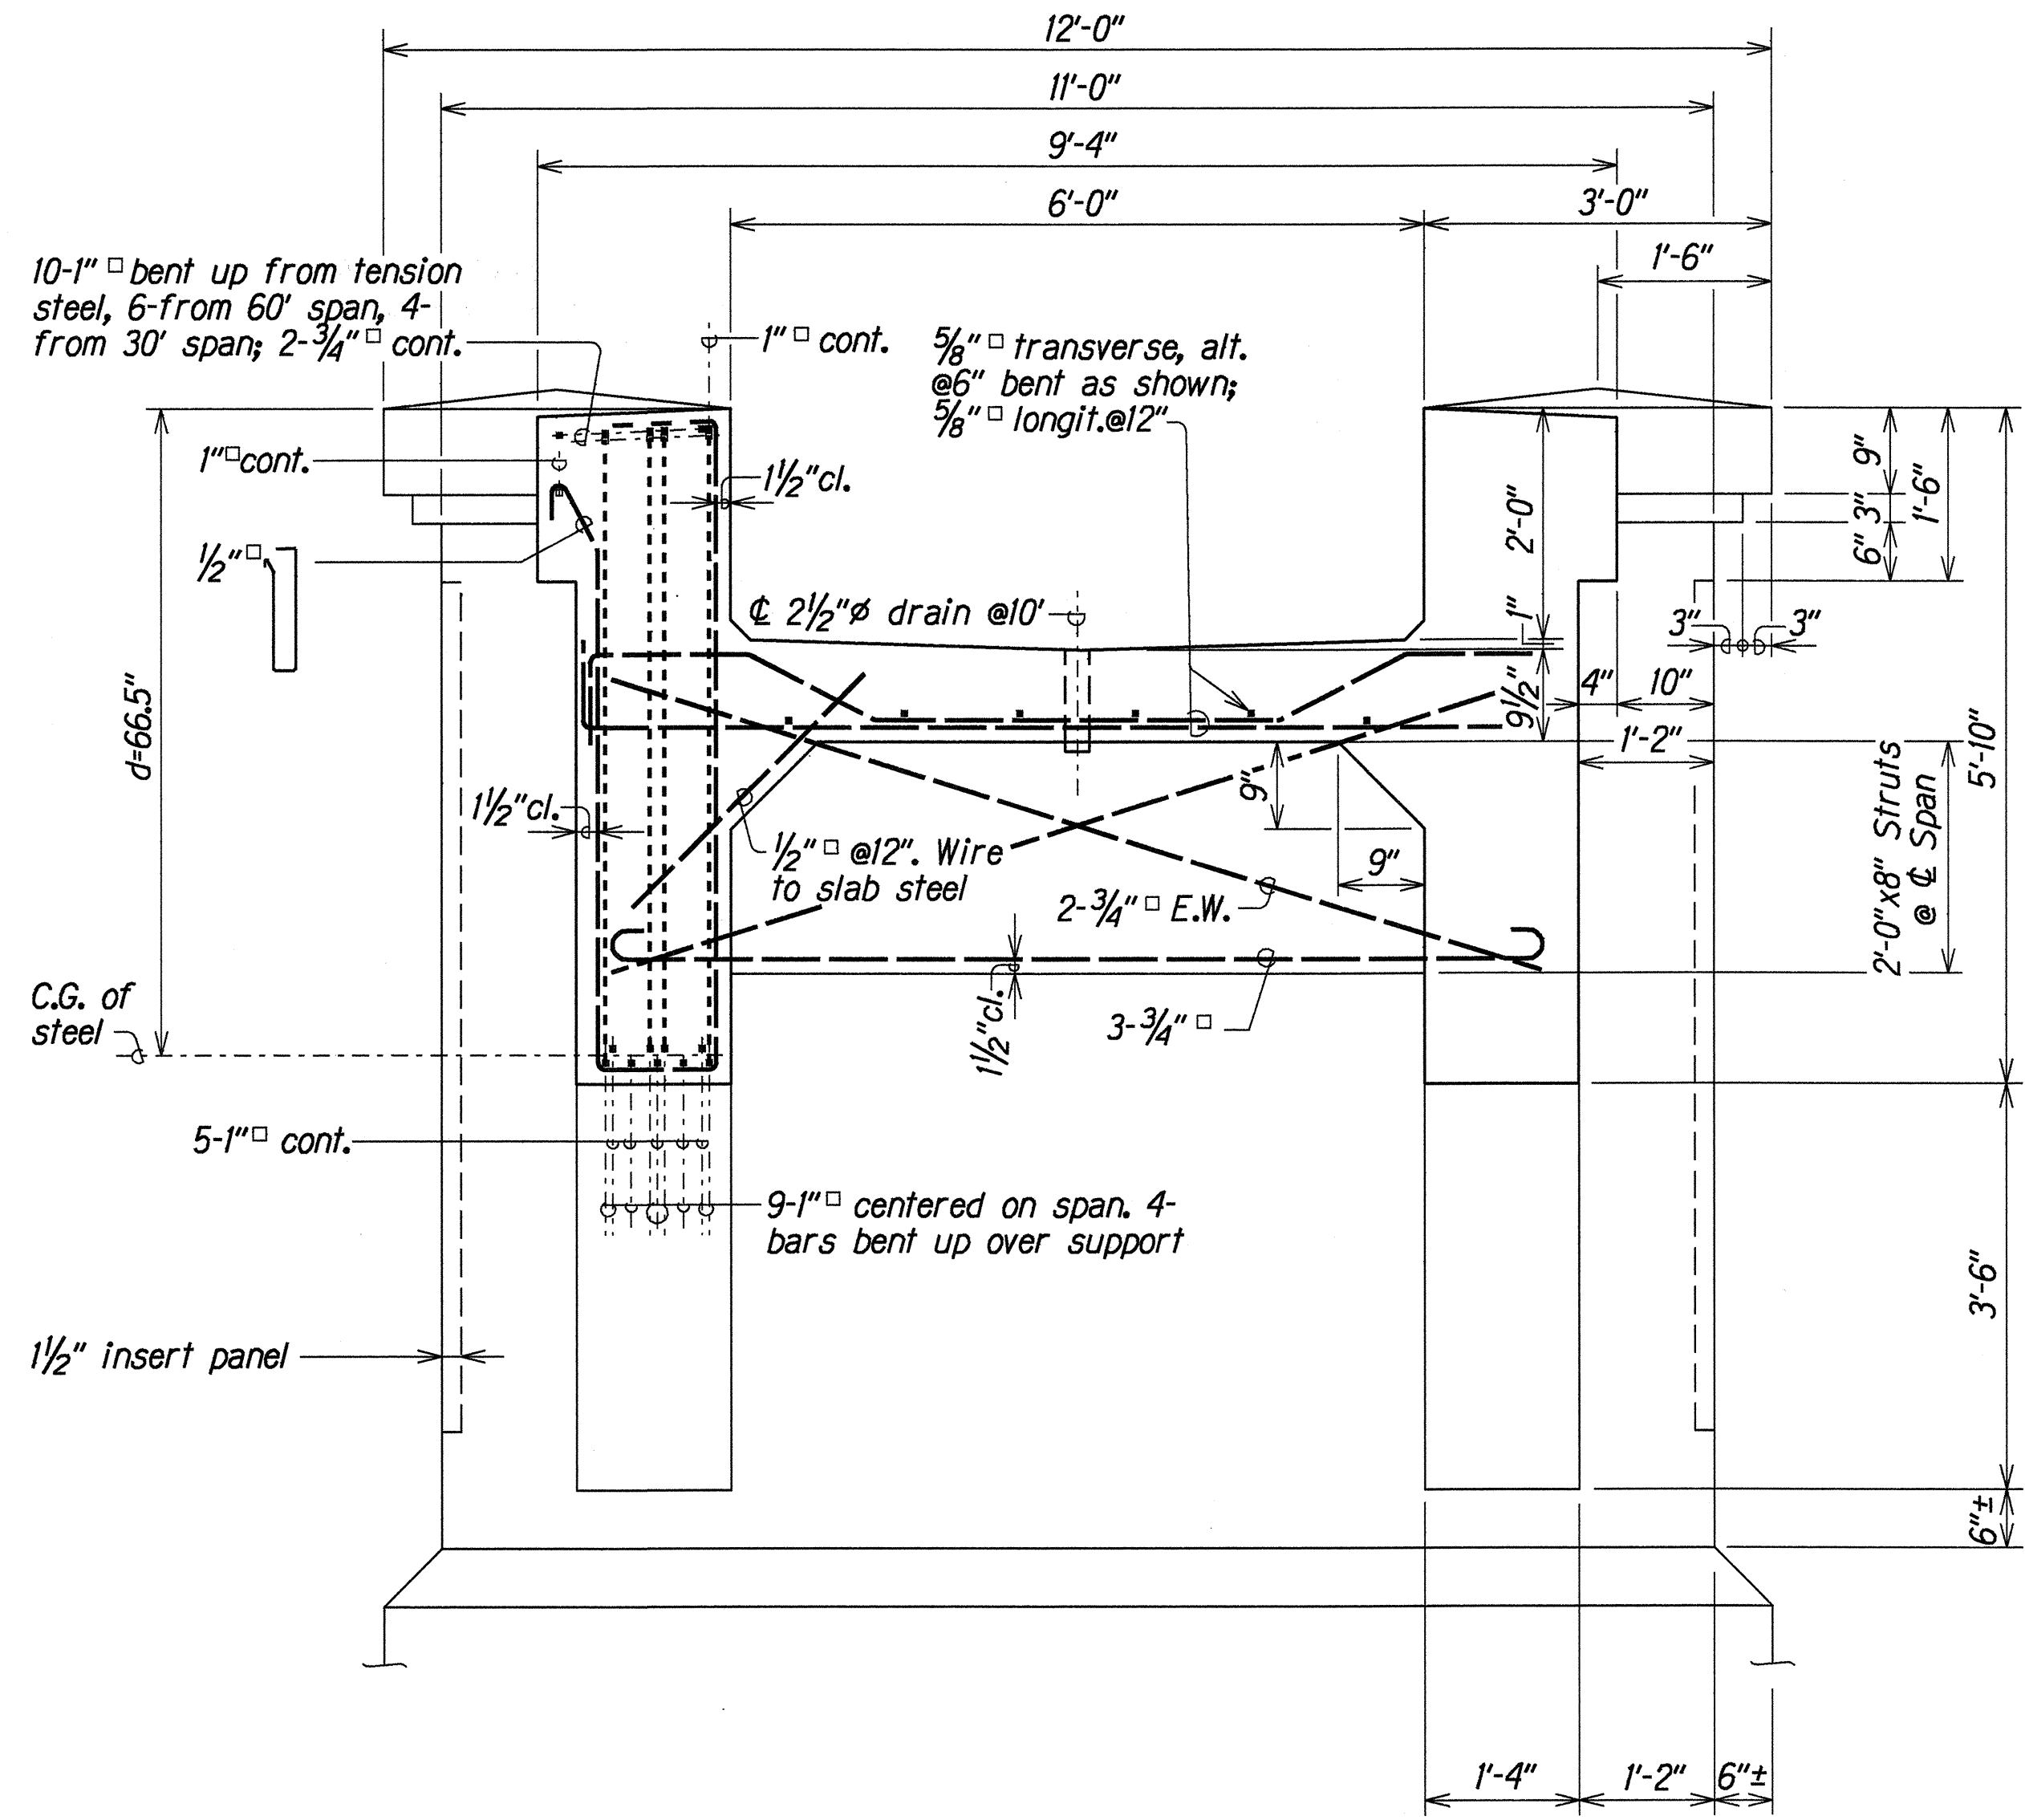

AT 30' SPAN

### TYPICAL SECTION

Scale: 3/4" = 1'-0"

NOTE: Typical Sections are based on original construction plans and are shown for information only.

|               |                   |         |
|---------------|-------------------|---------|
| ORIGINAL PLAN | SURVEY PLOTTED BY | DATE    |
| NOTED         | DRAWN BY          | 1       |
| DESIGNED BY   | CHECKED BY        | 75-5-95 |
| DATE          |                   |         |

STATE OF HAWAII  
DEPARTMENT OF TRANSPORTATION  
HIGHWAYS DIVISION

**TYPICAL SECTION**  
**KUHIO HIGHWAY, REPAIR SPALLS**  
**ON WAILUA (PLANTATION) BRIDGE**  
**Project No. 56A-01-95M**

Scale: As Noted  
Date: Jan, 1995

SHEET No. 1 OF 1 SHEETS