


FED. ROAD DIST. NO.	STATE	PROJ. NO.	FISCAL YEAR	SHEET NO.	TOTAL SHEETS
HAWAII	HAW.	56A-02-05	2009	9	39

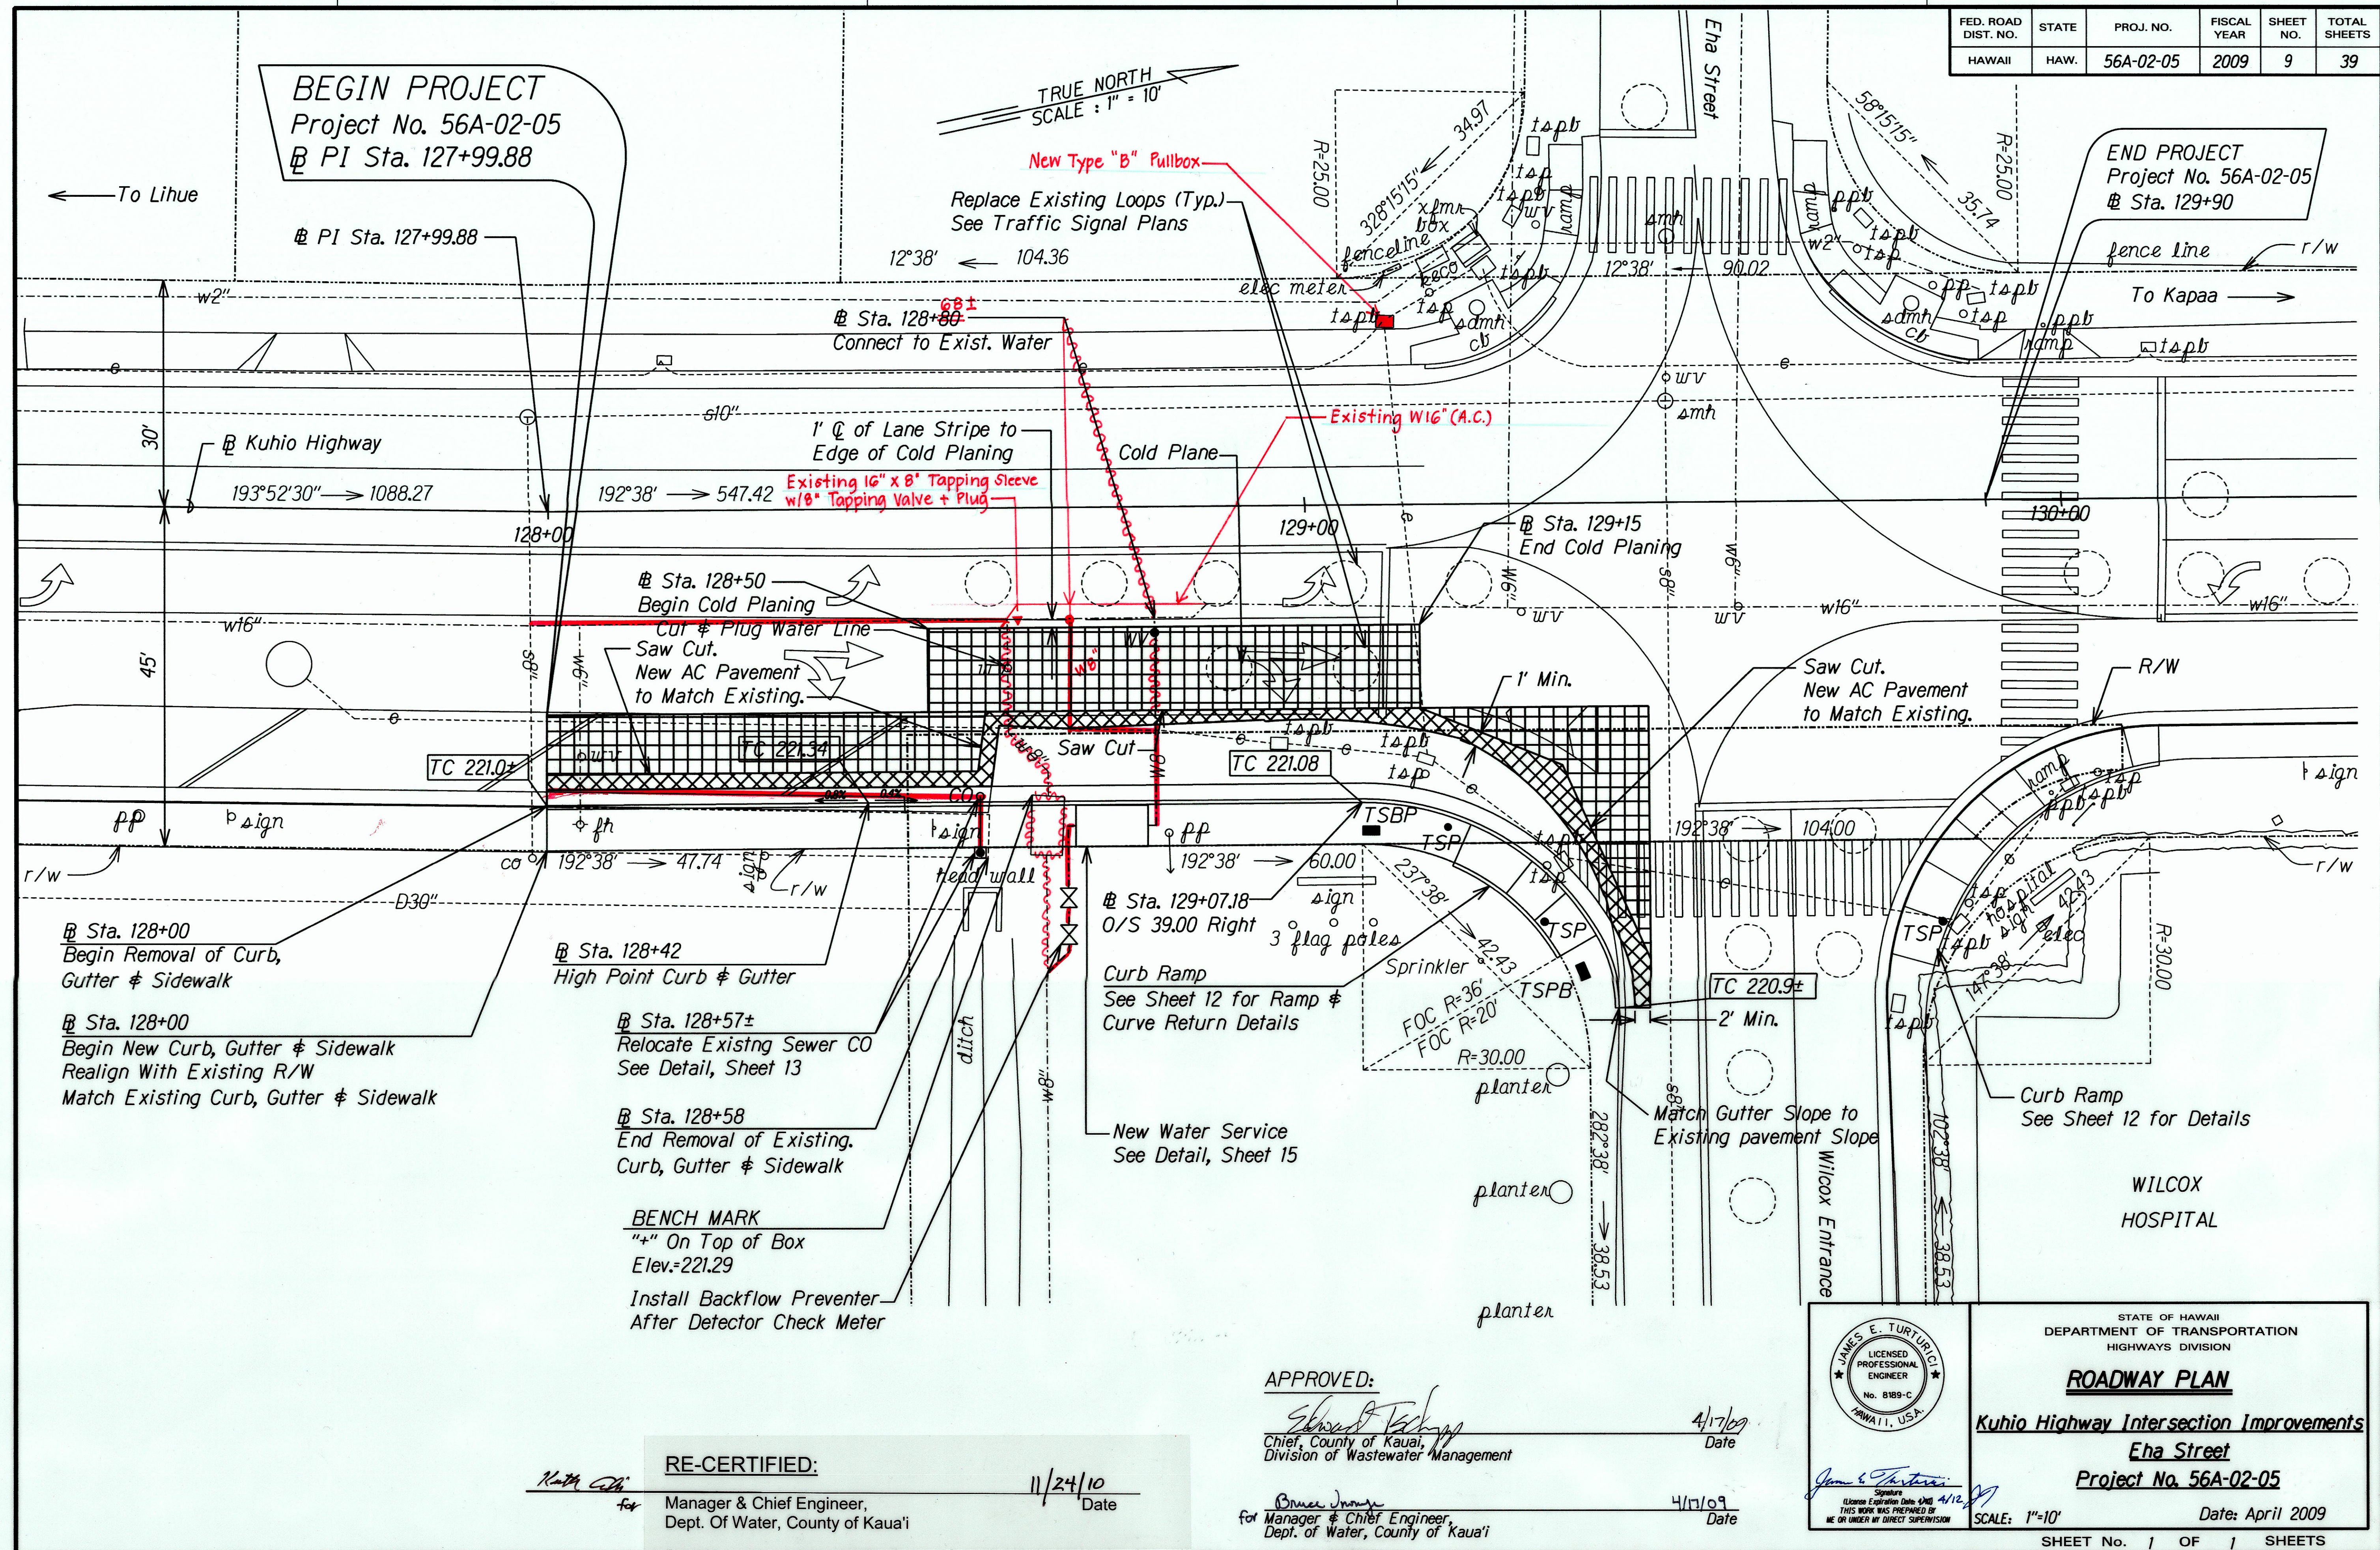

DESIGNED BY	DATE
DRAWN BY	
CHECKED BY	
IN CHARGE	
NOTED BY	
REVISIONS	

North

RE-CERTIFIED:

Manager & Chief Engineer,
Dept. of Water, County of Kauai

11/24/10
Date


APPROVED:

Shirley K. K...
Chief, County of Kauai,
Division of Wastewater Management

4/17/09
Date

Bruce Jones
for Manager & Chief Engineer,
Dept. of Water, County of Kauai

4/17/09
Date

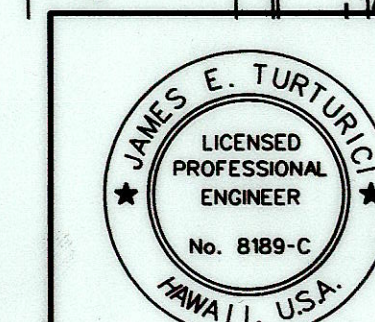

STATE OF HAWAII
DEPARTMENT OF TRANSPORTATION
HIGHWAYS DIVISION

ROADWAY PLAN

Kuhio Highway Intersection Improvements

Eha Street

Project No. 56A-02-05

Date: April 2009

SCALE: 1"=10'

SHEET No. 1 OF 1 SHEETS

"AS-BUILT"

10