
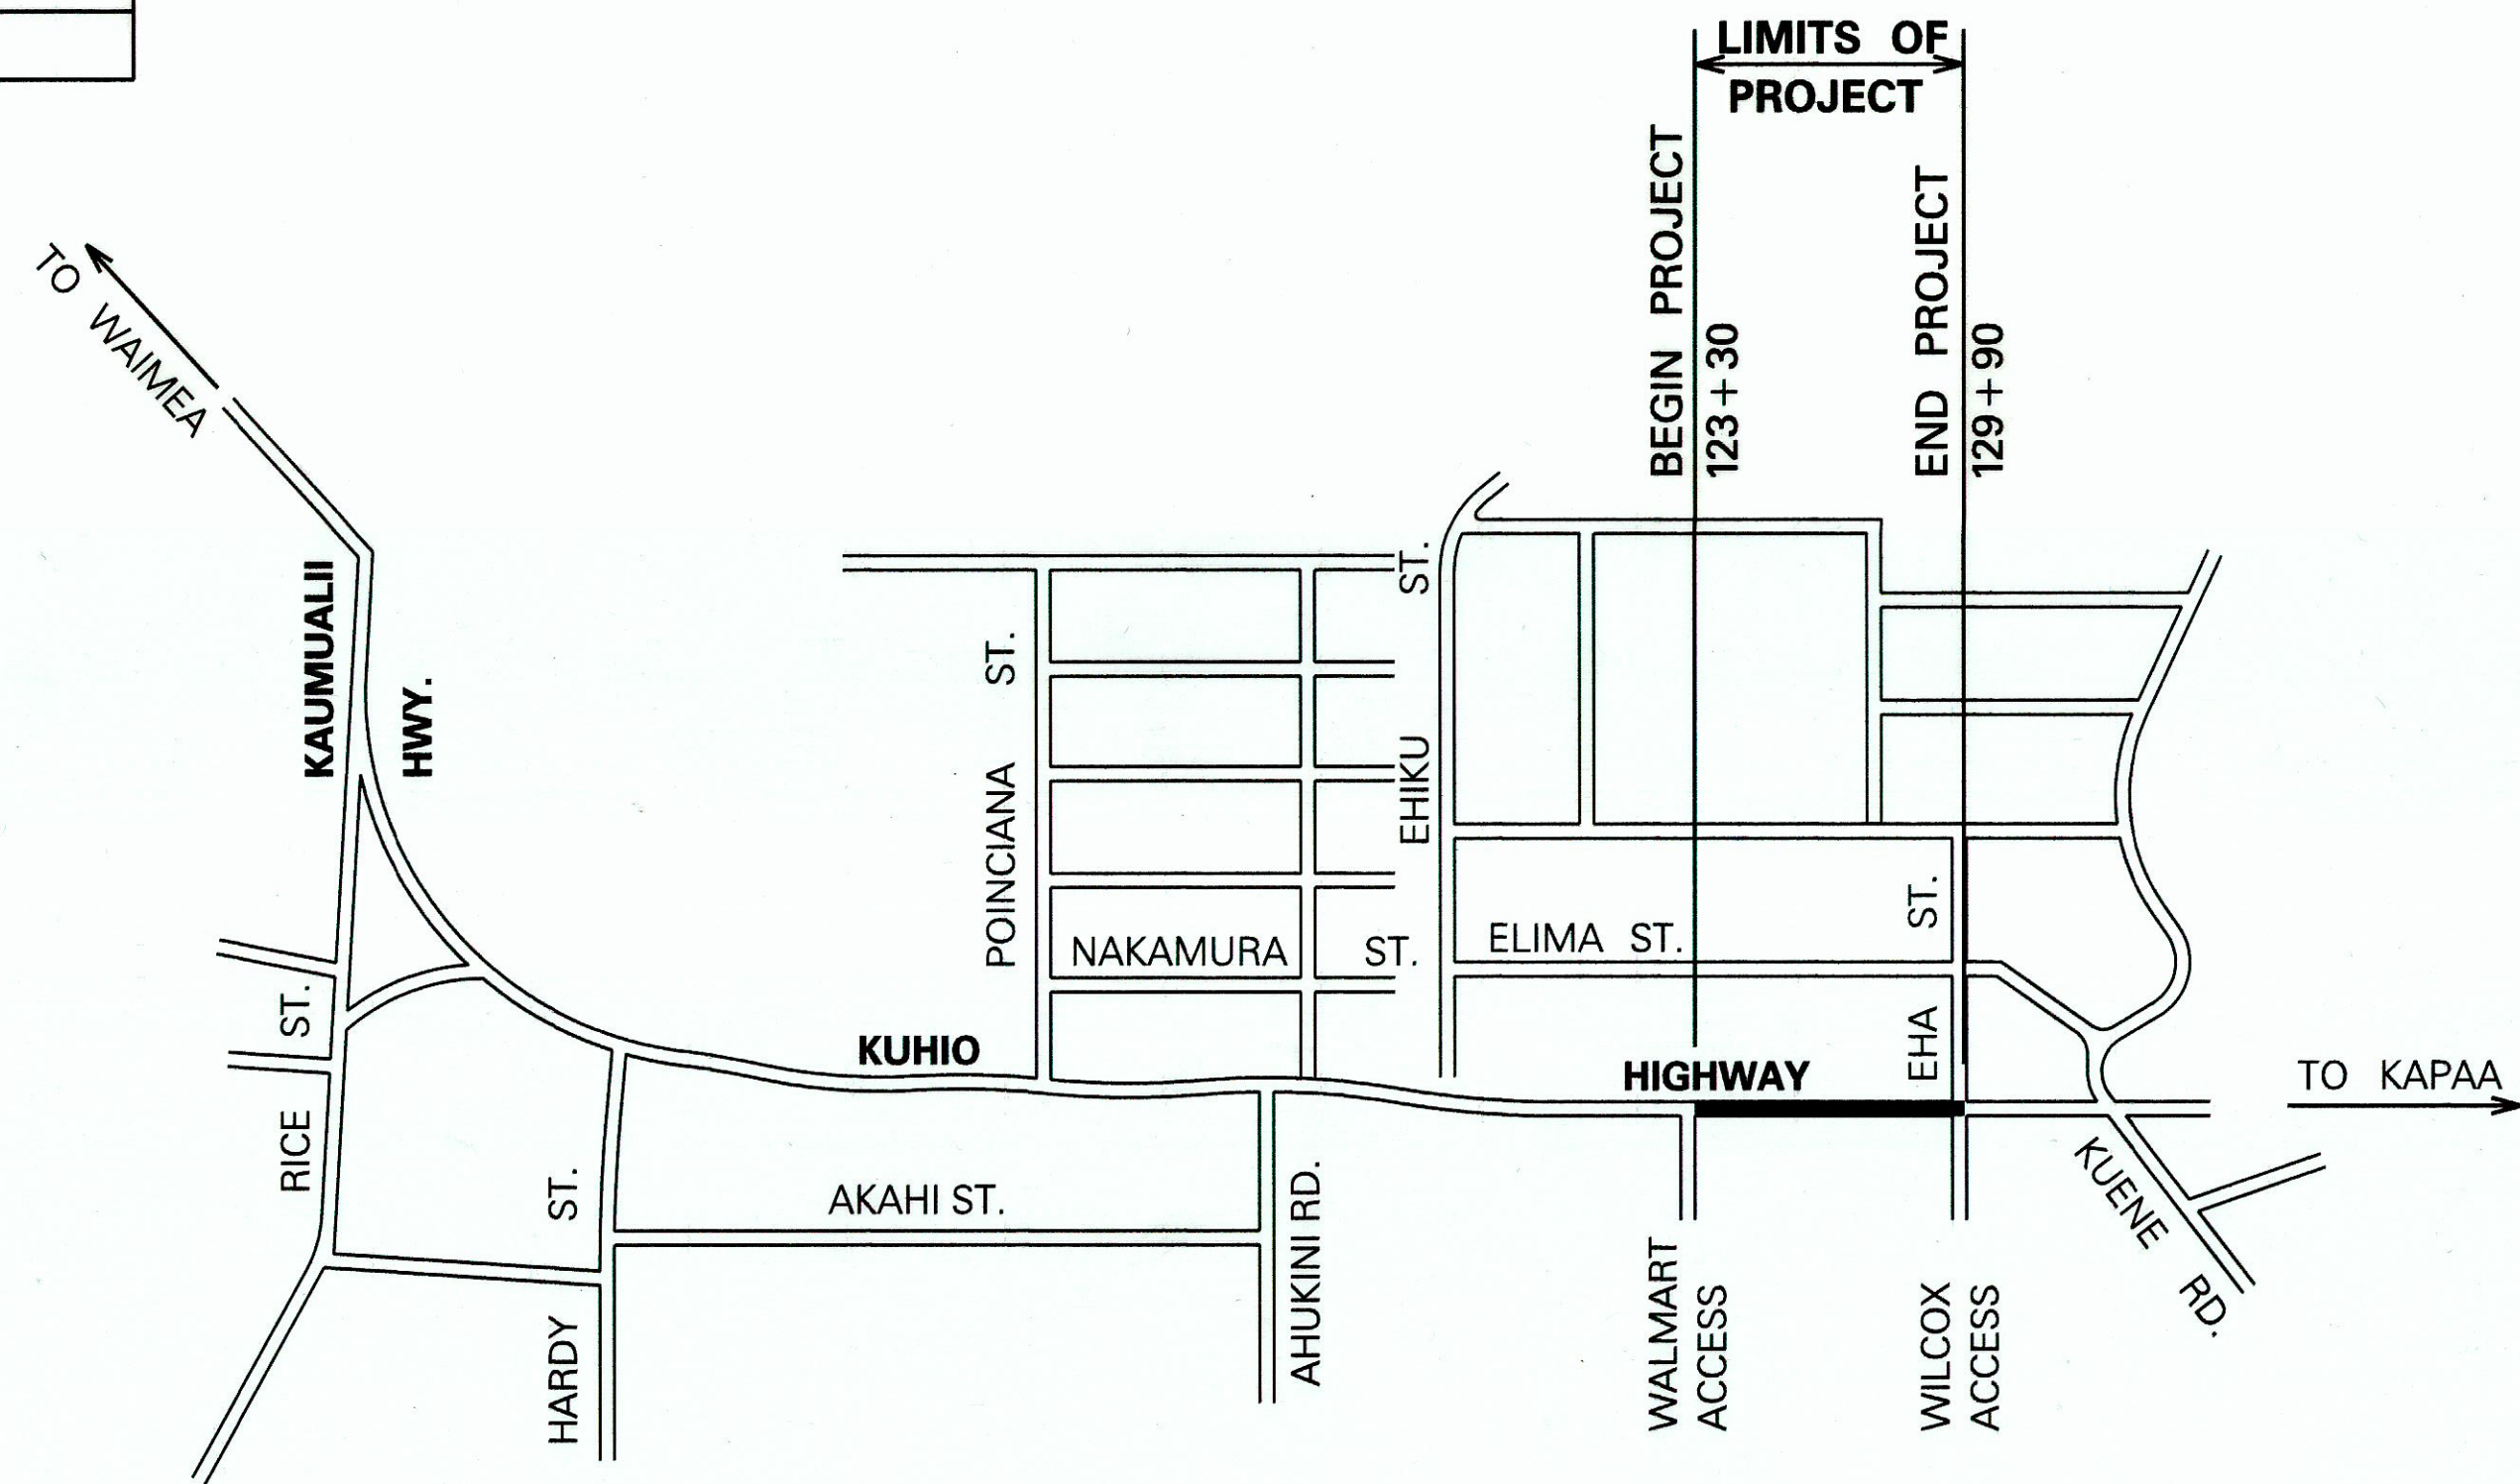


INDEX TO DRAWINGS	
SHEET NO.	DESCRIPTION
1	TITLE SHEET
2	STANDARD PLANS SUMMARY
3-4	GENERAL NOTES AND LEGEND
5-6	WATER POLLUTION & EROSION CONTROL NOTES
7	WATER NOTES
8	WASTEWATER NOTES
9	TYPICAL SECTIONS
10	ROADWAY PLAN
11	CURB RAMP AND SIDEWALK NOTES
12	CURB RAMP MISCELLANEOUS DETAILS
13	MISCELLANEOUS DETAILS
14	CURB RAMP DETAILS
15	WATER SERVICE RELOCATION PLAN
16-17	WATER SERVICE RELOCATION DETAILS
18	PAVEMENT MARKINGS LEGEND, DETAILS & NOTES
19-20	PAVEMENT MARKING AND SIGNING PLAN
21	WORK ZONE SIGNING PLAN, NOTES AND DETAILS
22-25	TRAFFIC CONTROL PLANS
26	TRAFFIC SIGNAL GENERAL NOTES & SYMBOLS
27	TRAFFIC SIGNAL PROJECT LOCATION PLAN
28	TRAFFIC SIGNAL DUCT SECTION DETAILS AND REQUIREMENTS
29	TRAFFIC SIGNAL EXISTING & DEMOLITION WORK
30	TRAFFIC SIGNAL NEW WORK
31	TRAFFIC SIGNAL SYSTEM CONDUIT & CABLE AND HEAD SCHEDULE
32-33	TRAFFIC SIGNAL PULLBOX DETAILS
34-38	TRAFFIC SIGNAL DETAILS
39	TRAFFIC SIGNAL DETECTOR LOOP DETAILS

STATE OF HAWAII
DEPARTMENT OF TRANSPORTATION
HIGHWAYS DIVISION
HONOLULU, HAWAII
"AS-BUILT"
PLANS FOR
KUHIO HIGHWAY
INTERSECTION IMPROVEMENTS AT EHA STREET
PROJECT NO. 56A-02-05
DISTRICT OF LIHUE
ISLAND OF KAUAI

FED. ROAD DIST. NO.	STATE	PROJ. NO.	FISCAL YEAR	SHEET NO.	TOTAL SHEETS
HAWAII	HAW.	56A-02-05	2009	1	39

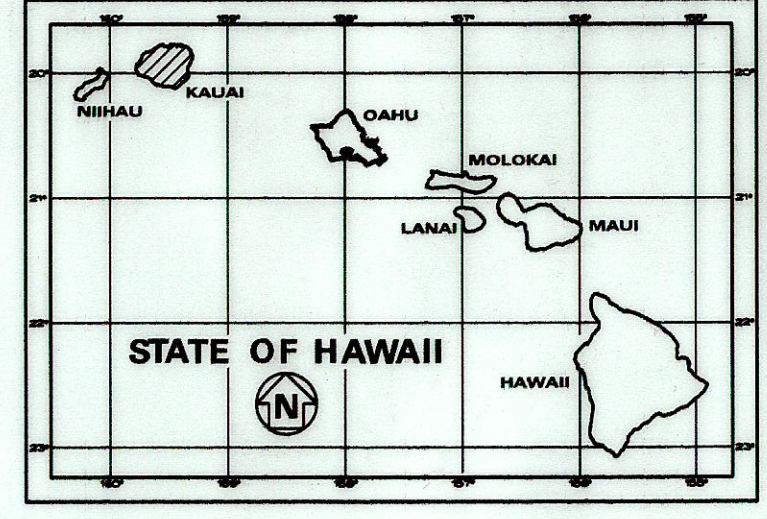

LAYOUT PLAN
LENGTH OF PROJECT: 0.12 MILES
NOT TO SCALE

FEDERAL AID PROJECTS PREVIOUSLY CONSTRUCTED OR UNDER CONSTRUCTION
MILE POST 0.62 TO MILE POST 0.74

REVISIONS MADE DURING CONSTRUCTION HAVE BEEN INCORPORATED ON THESE PLANS EXCEPT CHANGES IN THE ORIGINAL THEORETICAL QUANTITIES. FOR ACTUAL QUANTITIES, REFER TO PROJECT LEDGER AND/OR CONSTRUCTION RECORD.
John A. Hagg 12/12/13
RESIDENT ENGINEER DATE

DEPARTMENT OF TRANSPORTATION
STATE OF HAWAII
APPROVED:
Debra M. Forni 4-8-09
DIR. OF TRANSPORTATION DATE

KODANI & ASSOCIATES DESIGNED BY
HWY-KE MANAGED BY
241-3000 PHONE
APRIL 2009 DATE