


FED. ROAD DIST. NO.	STATE	FED. AID PROJ. NO.	FISCAL YEAR	SHEET NO.	TOTAL SHEETS
HAWAII	HAW.	HSIP-056-1(54)	2010	32	48

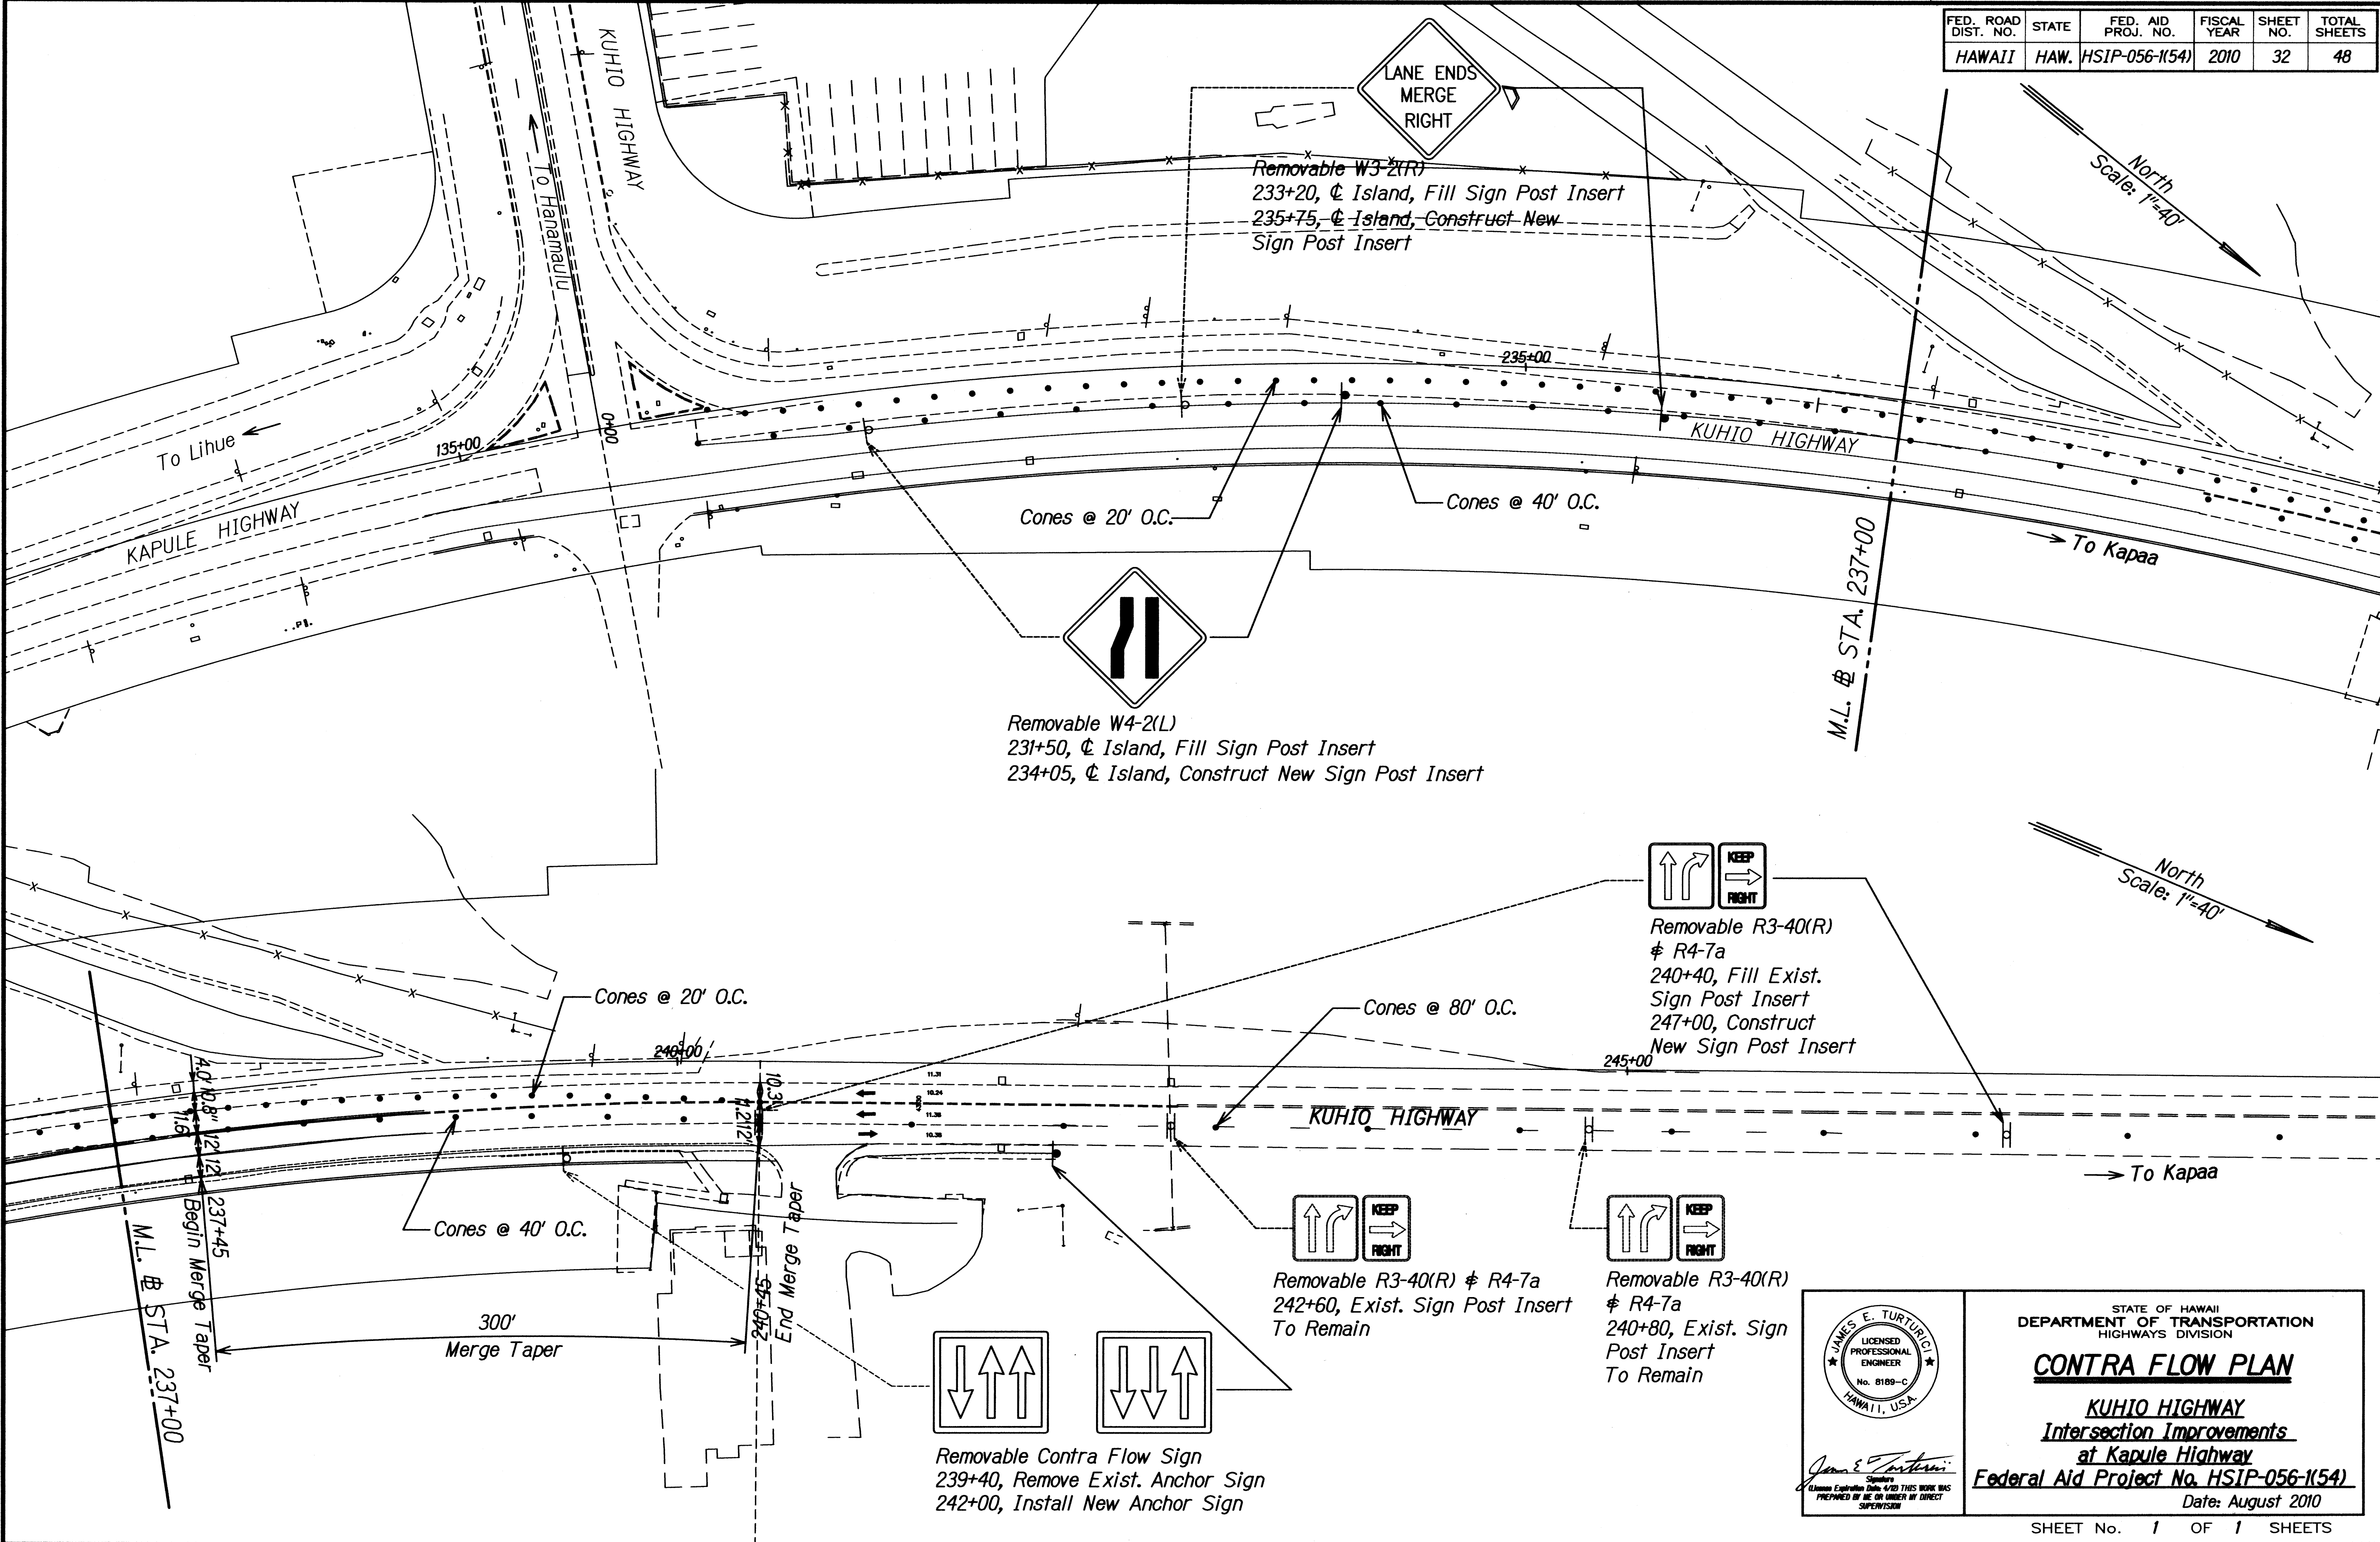

SURVEY PLOTTED BY	DATE
DRAWN BY	
DESIGNED BY	
CHECKED BY	
ORIGINAL PLAN	
NOTE BOOK	

James E. Turturici
Signature
Prepared by me or under my direct supervision

STATE OF HAWAII
 DEPARTMENT OF TRANSPORTATION
 HIGHWAYS DIVISION

CONTRA FLOW PLAN

KUHIO HIGHWAY
Intersection Improvements
at Kapule Highway
Federal Aid Project No. HSIP-056-1(54)

Date: August 2010