	INDEX TO DRAWINGS
SHEET NO.	DESCRIPTION
1	TITLE SHEET
2	STANDARD PLANS SUMMARY
3–4	GENERAL NOTES AND LEGEND
5–6	WATER POLLUTION & EROSION CONTROL NOTES
7–11	TYPICAL SECTION AND DETAILS
12–14	ROADWAY PLANS
15–17	MISCELLANEOUS DETAILS
18–19	STORM DRAIN DETAILS
20	UTILITY TRENCH DETAILS
21	ELECTRIC NOTES
22	STREET LIGHT PLAN
23	STREET LIGHT DETAILS
24–25	REPLACE HAWAIIAN TELCOM BOX
26	CENTER LINE MILLED
	RUMBLE STRIP DETAIL
27	PAVEMENT MARKINGS LEGEND,
	DETAILS & NOTES
28–30	PAVEMENT MARKING & SIGNING PLAN
31	SIGN DETAILS
32	CONTRA FLOW PLAN
33	WORK ZONE SIGNING PLAN,
	NOTES AND DETAILS
34	TRAFFIC CONTROL NOTES & DETAILS
35–41	TRAFFIC CONTROL PLANS
42–45	CROSS SECTIONS
46	TRAFFIC SIGNAL NOTES & LEGEND
47	TRAFFIC SIGNAL PLAN
48 🔨	TRAFFIC SIGNAL DETAILS

STATE OF HAWAII

DEPARTMENT OF TRANSPORTATION


HIGHWAYS DIVISION HONOLULU, HAWAII

PLANS FOR


KUHIO HIGHWAY

INTERSECTION IMPROVEMENTS AT KAPULE HIGHWAY FEDERAL AID PROJECT NO. HSIP-056-1(54)


DISTRICT OF LIHUE ISLAND OF KAUAI

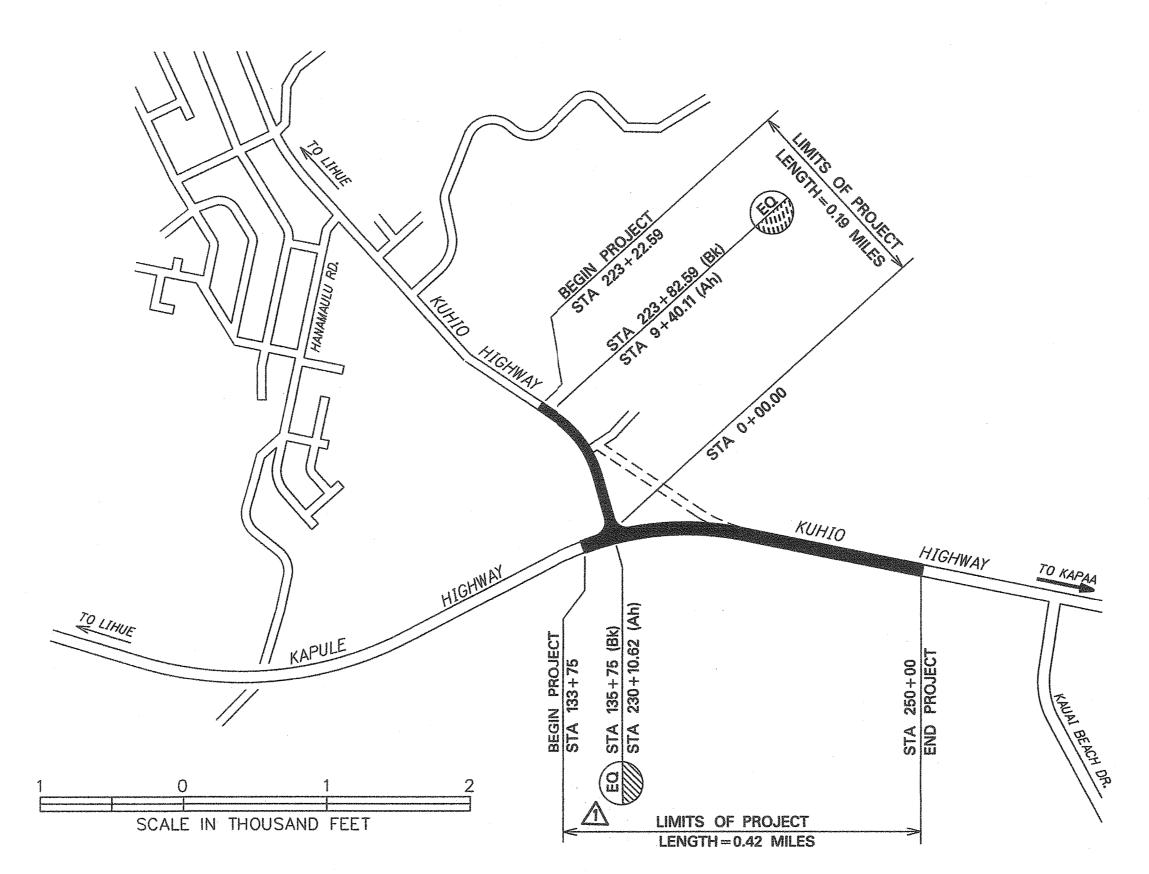




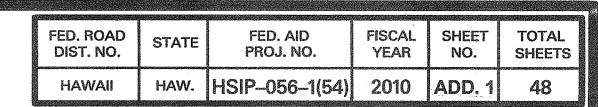



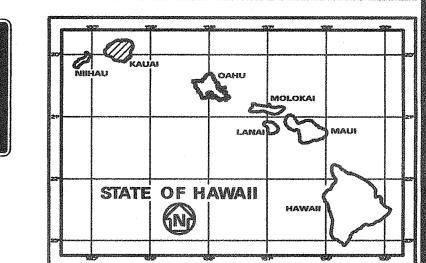

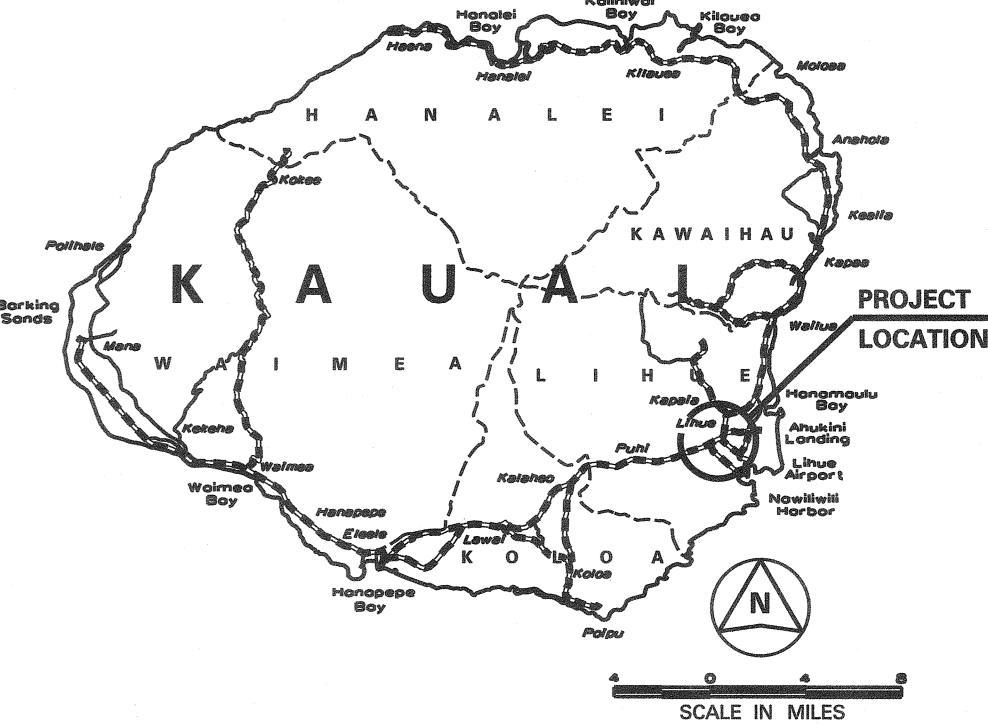

FEDERAL AID INTERSTATE PROJECTS PREVIOUSLY CONSTRUCTED OR UNDER CONSTRUCTION

KUHIO HWY MILE POST $\underline{2.51}$ TO MILE POST $\underline{3.02}$ KAPULE HWY MILE POST $\underline{3.45}$ TO MILE POST $\underline{3.49}$

DESIGN DESIGNATION

		-	_	_	_	_	_	-					-		-		*****		_	-		-				
A	AD	and the same	•	San Parket	2	0	1	C			9	es		ū	a		8	a	s		4	u	e	34,	560	
F	AD'	STATE OF THE PERSON NAMED IN		Section 2	2	0	3			e	a	Ð	9	9	a	8	e	9	8	a	в	ą	6	43,	790	
Secured	DH	V	7		9		•	5		8	2	ū	æ		e		n	R	n	æ	•	r.	a	3,5	00	
SW SW	D	9		a	2					8		æ	ø	s	6	ŧ	œ		*	P	9	ts	ĸ.	60/	40	
es.	and the second					•		•						ъ		e,	u	•					n	3.0	%	
1	V	•	٠				Þ	8	s	s	3	n	3	n	8	e	#	z	g	a	9		n	35	M.P.	

6/13/1	REVISE DRAWING INDEX AND LIMITS OF PROJECT
DATE	REVISION
DE	PARTMENT OF TRANSPORTATION STATE OF HAWAII
APPR	OVED: JUN 13 2011
DIR	OF TRANSPORTATION DATE