

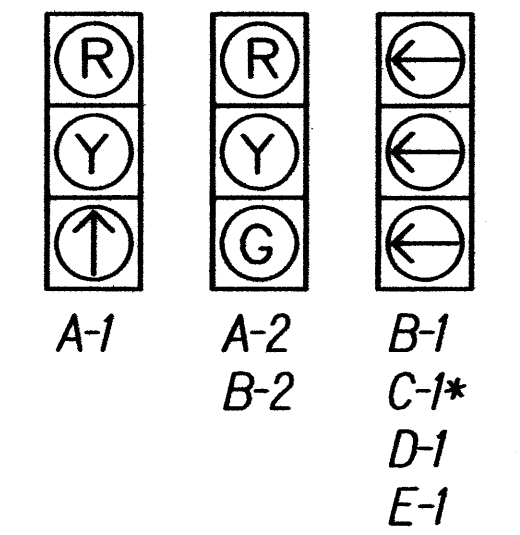


FED. ROAD DIST. NO.	STATE	FED. AID PROJ. NO.	FISCAL YEAR	SHEET NO.	TOTAL SHEETS
HAWAII	HAW.	HSIP-056-1(54)	2010	47	48

CONDUIT AND CABLE SCHEDULE					
Symbol	Cond.	Description	Symbol	Cond.	Description
①	2" Conc.	1-26C*14	⑥	2" Conc.	1-26C*14
	2" Conc.	1-26C*14		2" Conc.	3-2C*14
	2" Conc.	6-2C*14		2" Conc.	1-EVP
	2" Conc.	1-3C*6		2" Conc.	Spare
	2" Conc.	3-EVP	⑦	2" Conc.	1-26C*14
②	2" Conc.	1-3C*6		2" Conc.	1-EVP
	2" Conc.	1-3C*6		2" Conc.	Spare
④	2" Conc.	1-26C*14	⑧	2" Conc.	1-26C*14
	2" Conc.	1-26C*14		2" Conc.	Spare
	2" Conc.	6-2C*14		2" Conc.	Spare
	2" Conc.	3-EVP	⑨	2" Conc.	2-2C*14
	2" Conc.	Spare		2" Conc.	1-2C*14
⑤	2" Conc.	1-26C*14	⑩	2" Conc.	1-2C*14
	2" Conc.	1-26C*14			
	2" Conc.	5-2C*14			
	2" Conc.	3-EVP			
	2" Conc.	Spare			

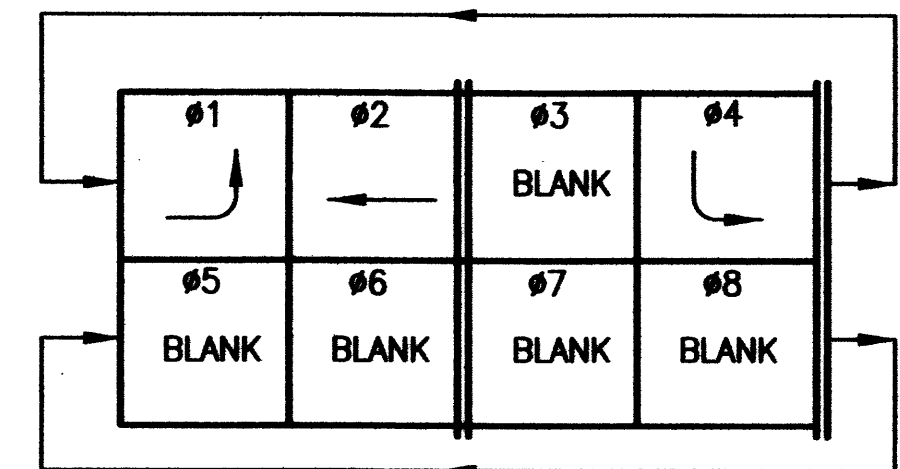


SIGNAL INDICATIONS
 *Indicates programmable visibility head

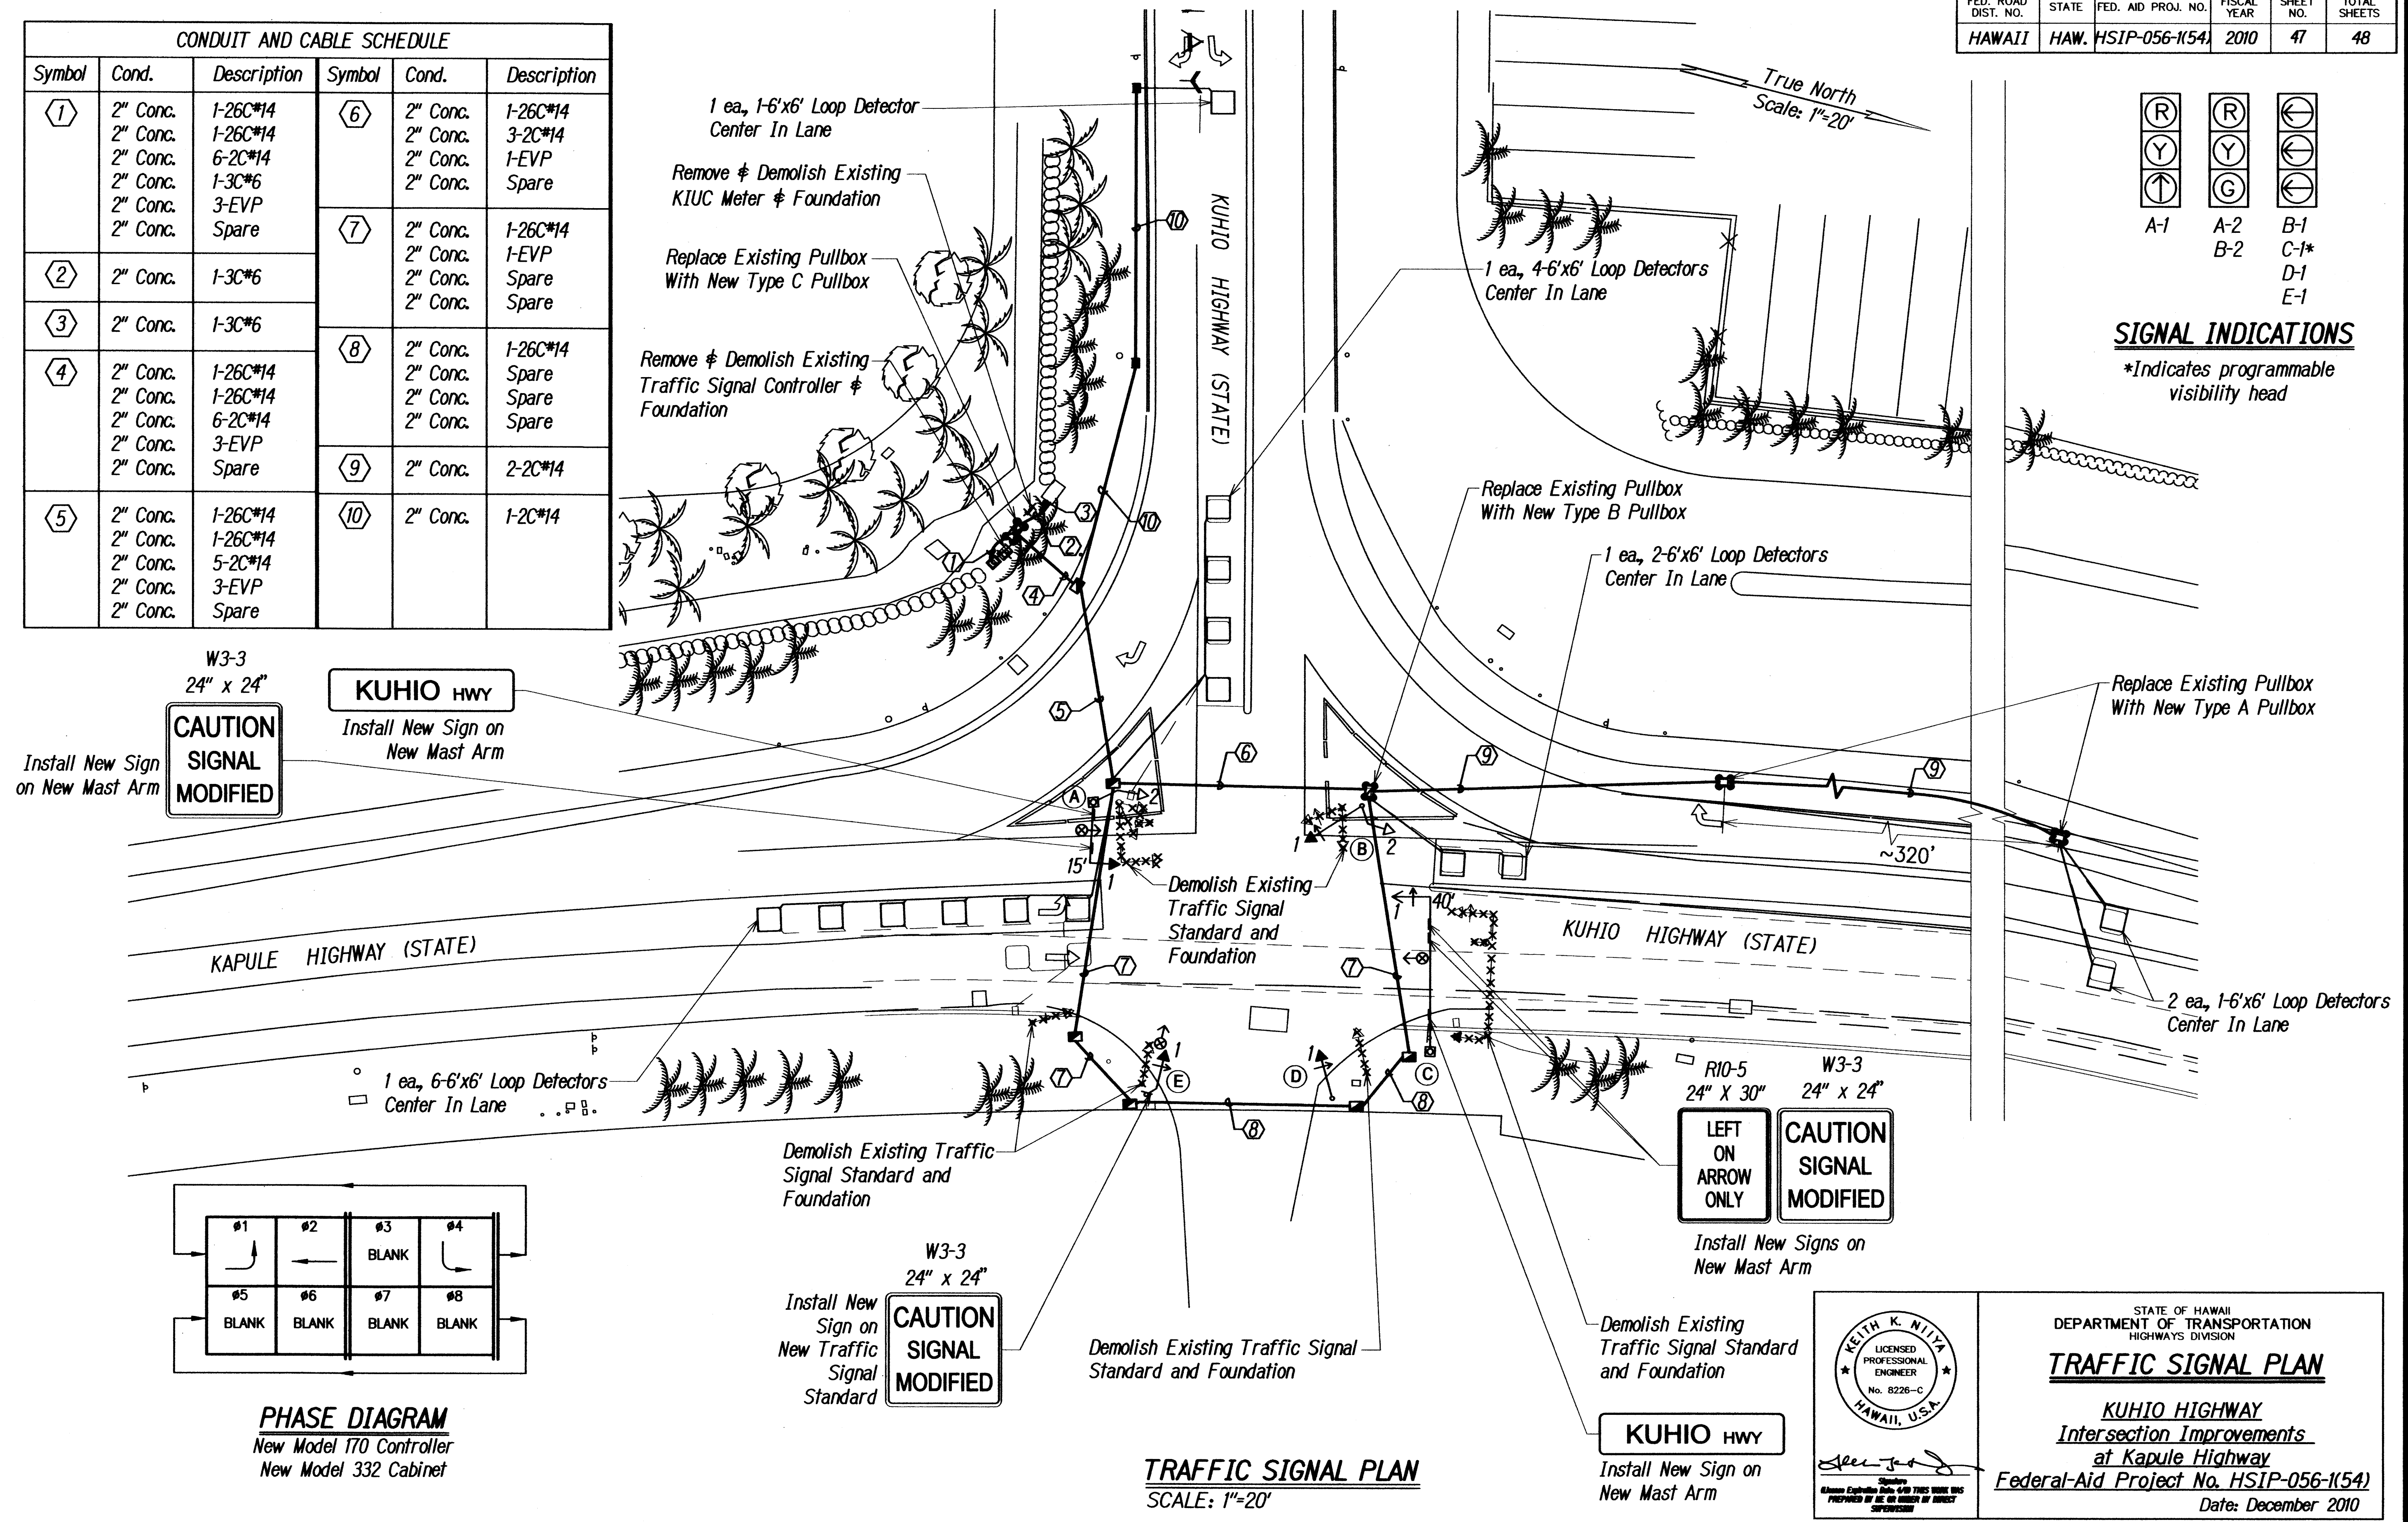

PHASE DIAGRAM
 New Model 170 Controller
 New Model 332 Cabinet

TRAFFIC SIGNAL PLAN
 SCALE: 1"=20'

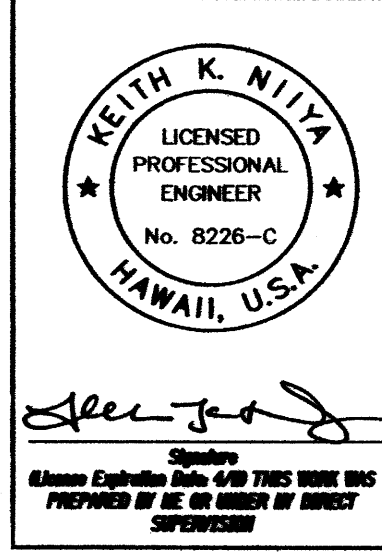

STATE OF HAWAII
 DEPARTMENT OF TRANSPORTATION
 HIGHWAYS DIVISION
TRAFFIC SIGNAL PLAN
KUHIO HIGHWAY
Intersection Improvements
at Kapule Highway
 Federal-Aid Project No. HSIP-056-1(54)
 Date: December 2010