


84732

FED. ROAD DIST. NO.	STATE	PROJ. NO.	FISCAL YEAR	SHEET NO.	TOTAL SHEETS
HAWAII	HAW.	56A-01-91	1992	15	17

FINAL SURVEY	DATE	BY
SURVEYED		
PLOTTED		
TEMPLATE		
NOTE BOOK		
NO.		




ORIGINAL SURVEY	DATE	BY
SURVEYED		
PLOTTED		
TEMPLATE		
NOTE BOOK		
NO.		

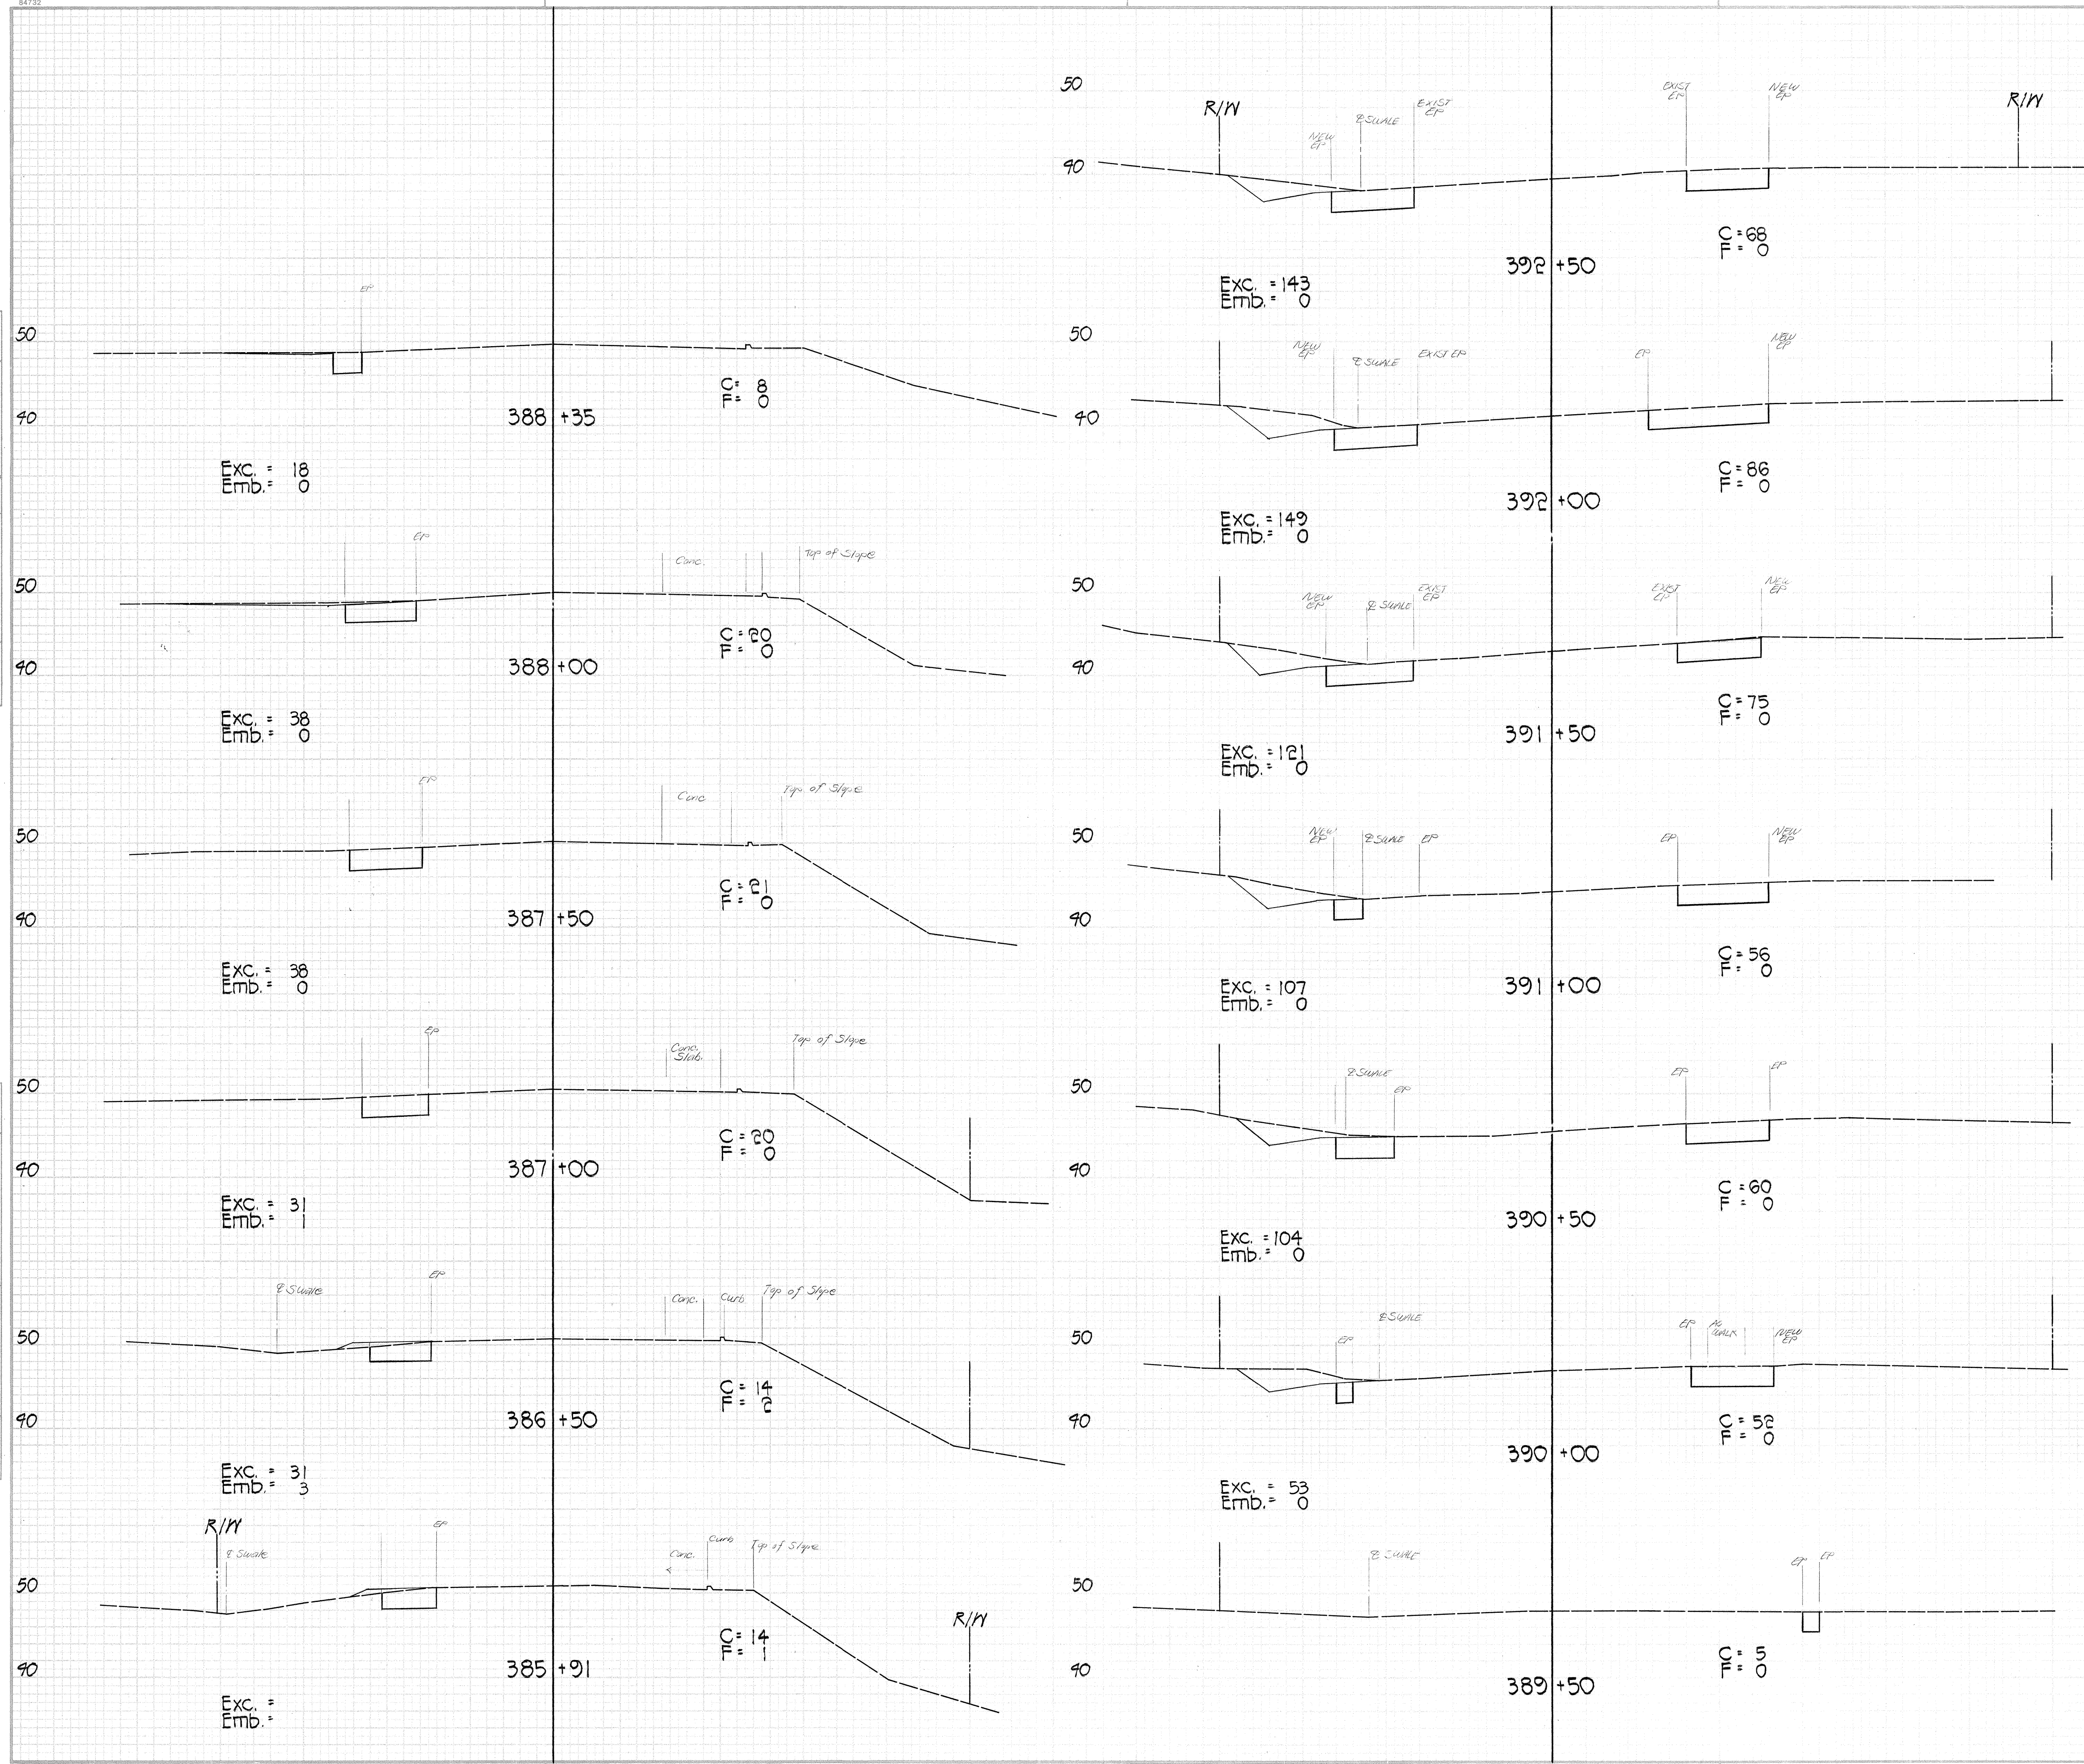

THIS WORK WAS PREPARED BY ME OR UNDER MY SUPERVISION.
Harold I. Yoshizaki
SHIMABUKURO, ENDO & YOSHIZAKI, INC.
1126 12th Avenue
Honolulu, Hawaii 96816

FINAL SURVEY		BY	DATE
NOTED			
PLOTTED			
TEMPLATE			
AREAS			
AREAS CHECKED			
NO			

ORIGINAL			BY	DATE
SURVEY				
PLOTTED				
TEMPLATE				
AREAS				
AREAS CHECKED				
NO				

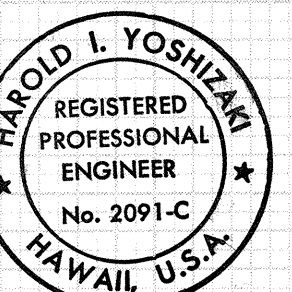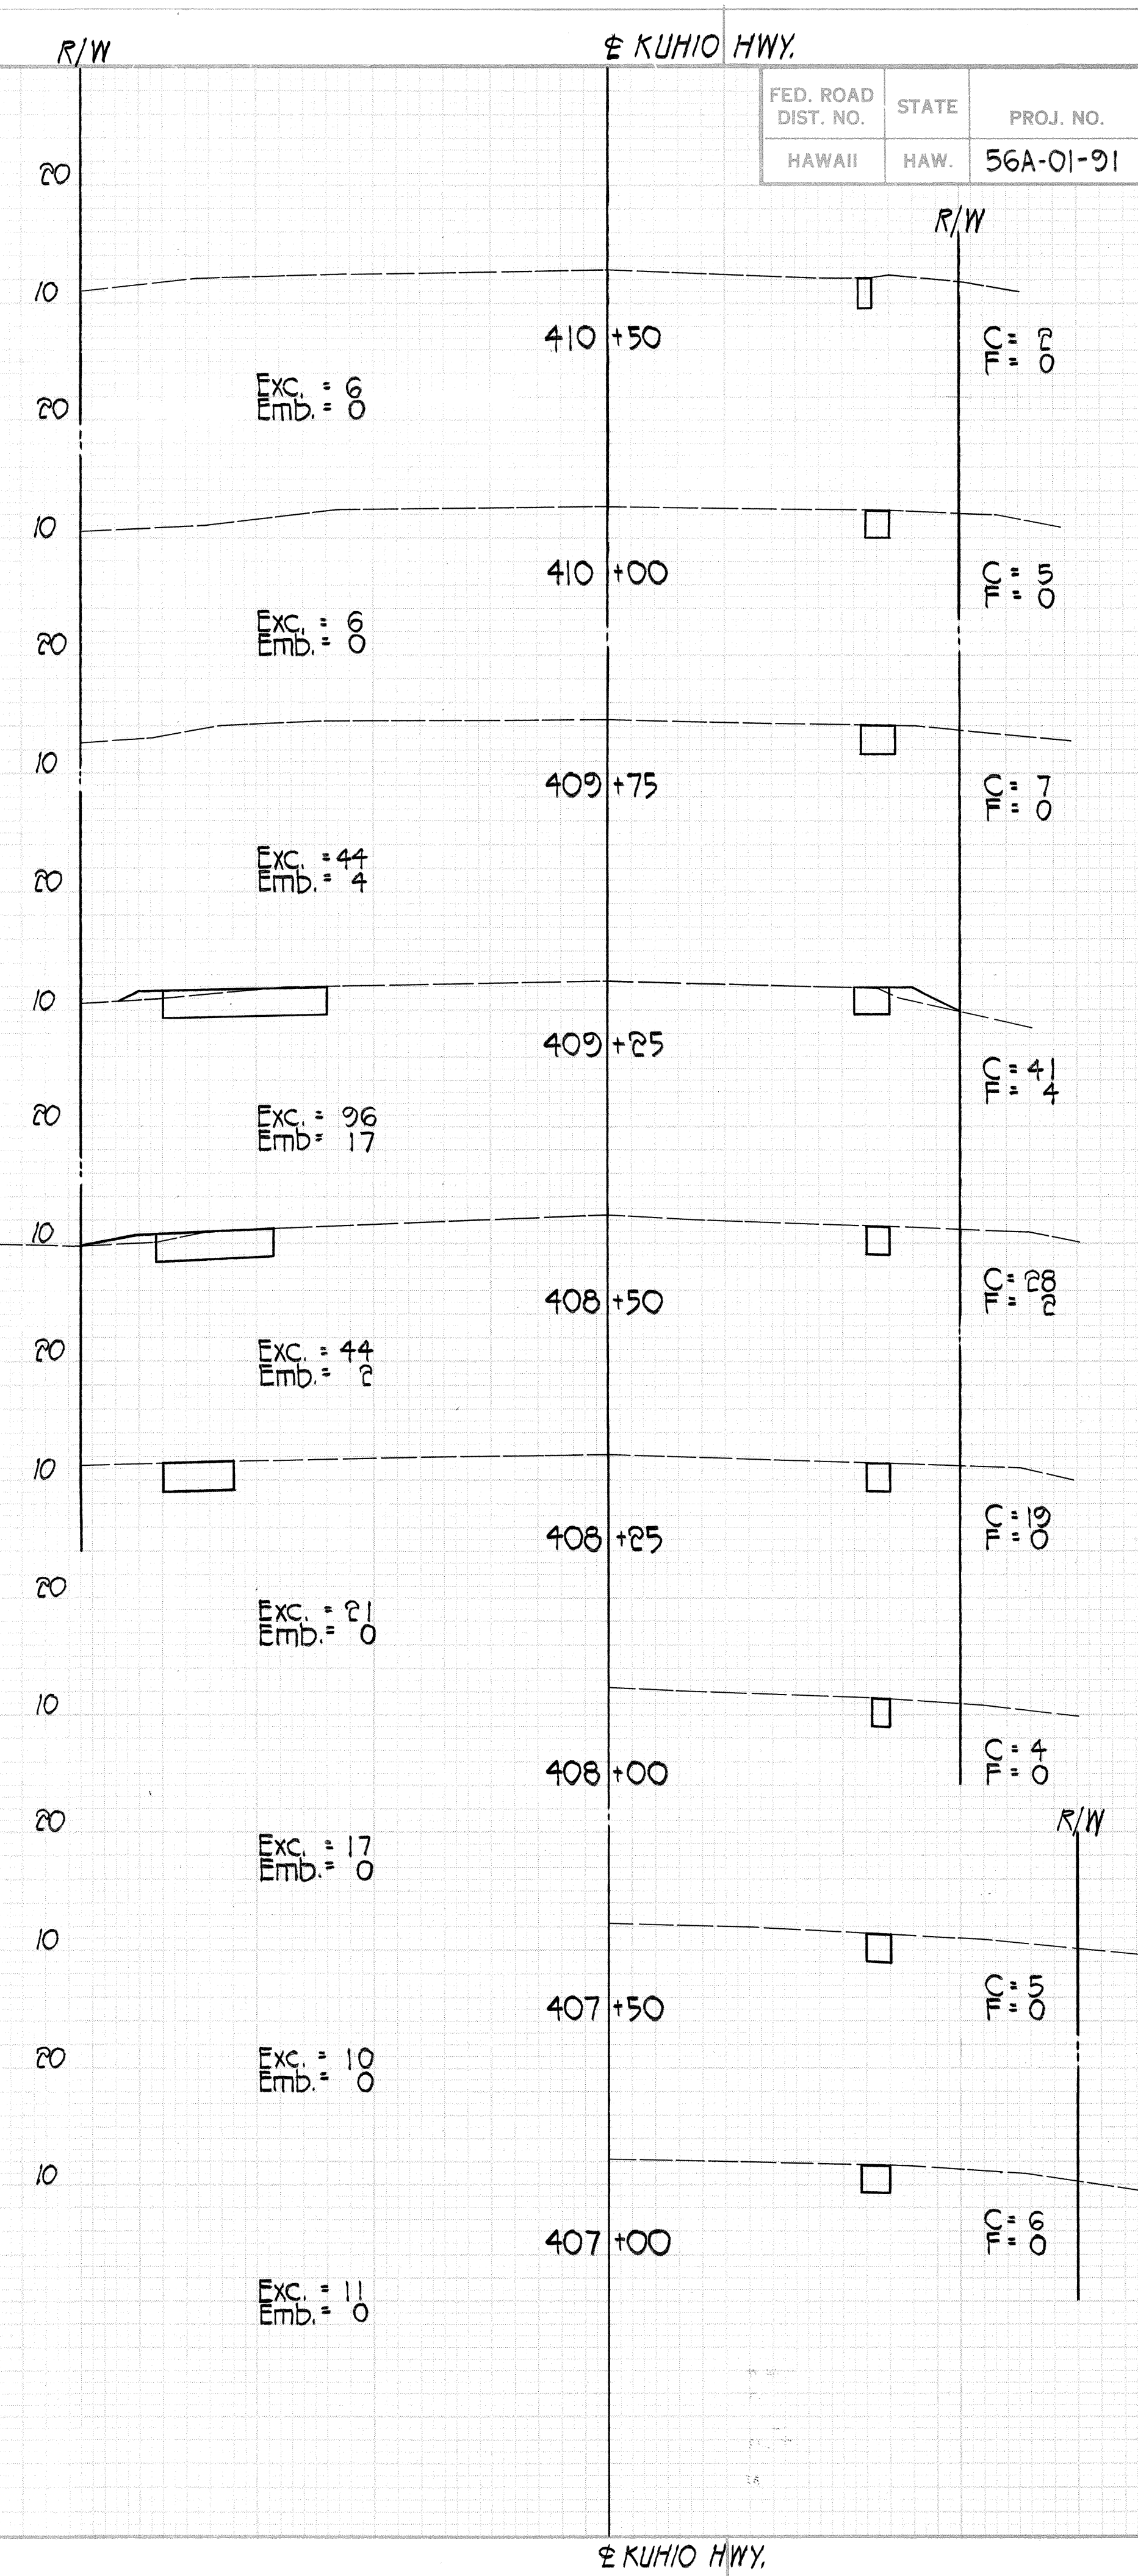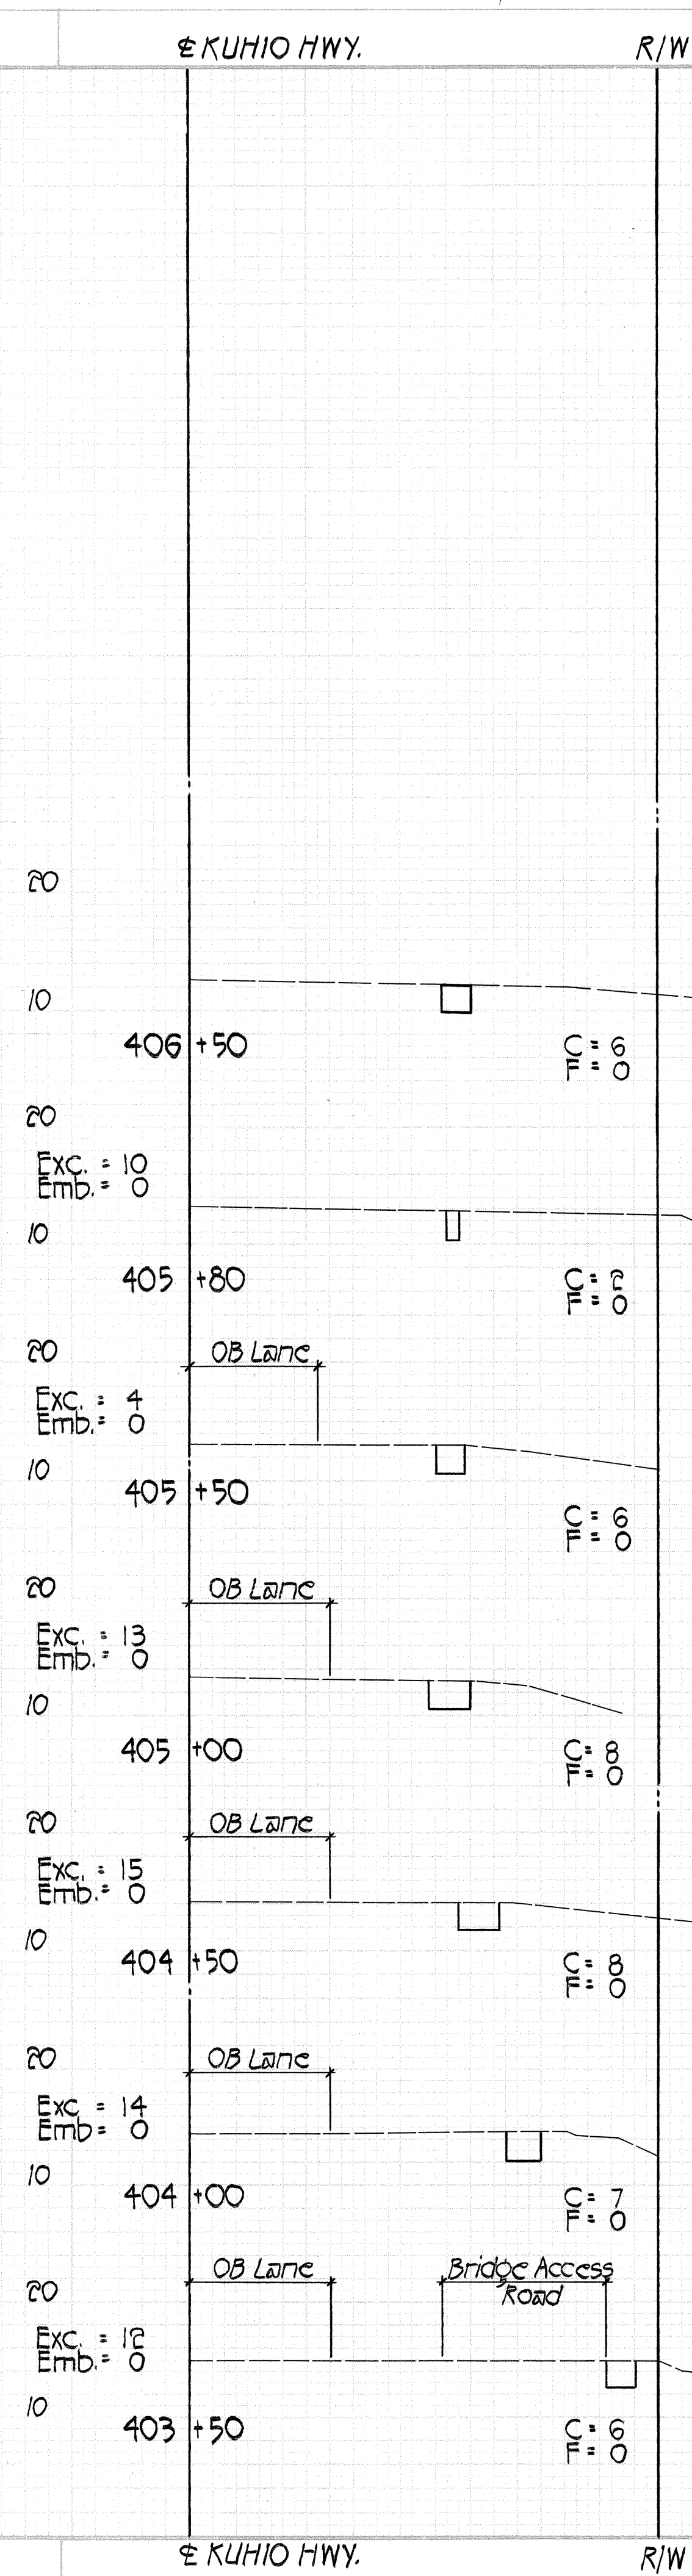





THIS WORK WAS PREPARED BY ME OR
UNDER MY SUPERVISION.
Harold S. Yoshizaki
HIMABUKURO, ENDO & YOSHIKAZI, INC.
1126 12th Avenue
Honolulu, Hawaii 96816

94732

FED. ROAD DIST. NO.	STATE	PROJ. NO.	FISCAL YEAR	SHEET NO.	TOTAL SHEETS
HAWAII	HAW.	56A-01-91	1992	17	17

FINAL SURVEY NO.	DATE	BY	REVISIONS
1			
2			
3			
ORIGINAL SURVEY NO.	DATE	BY	REVISIONS
1			
2			
3			
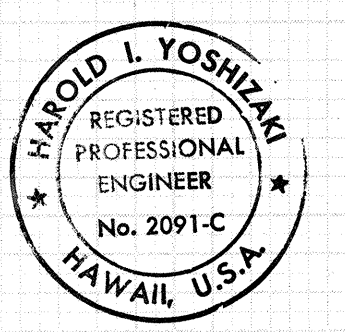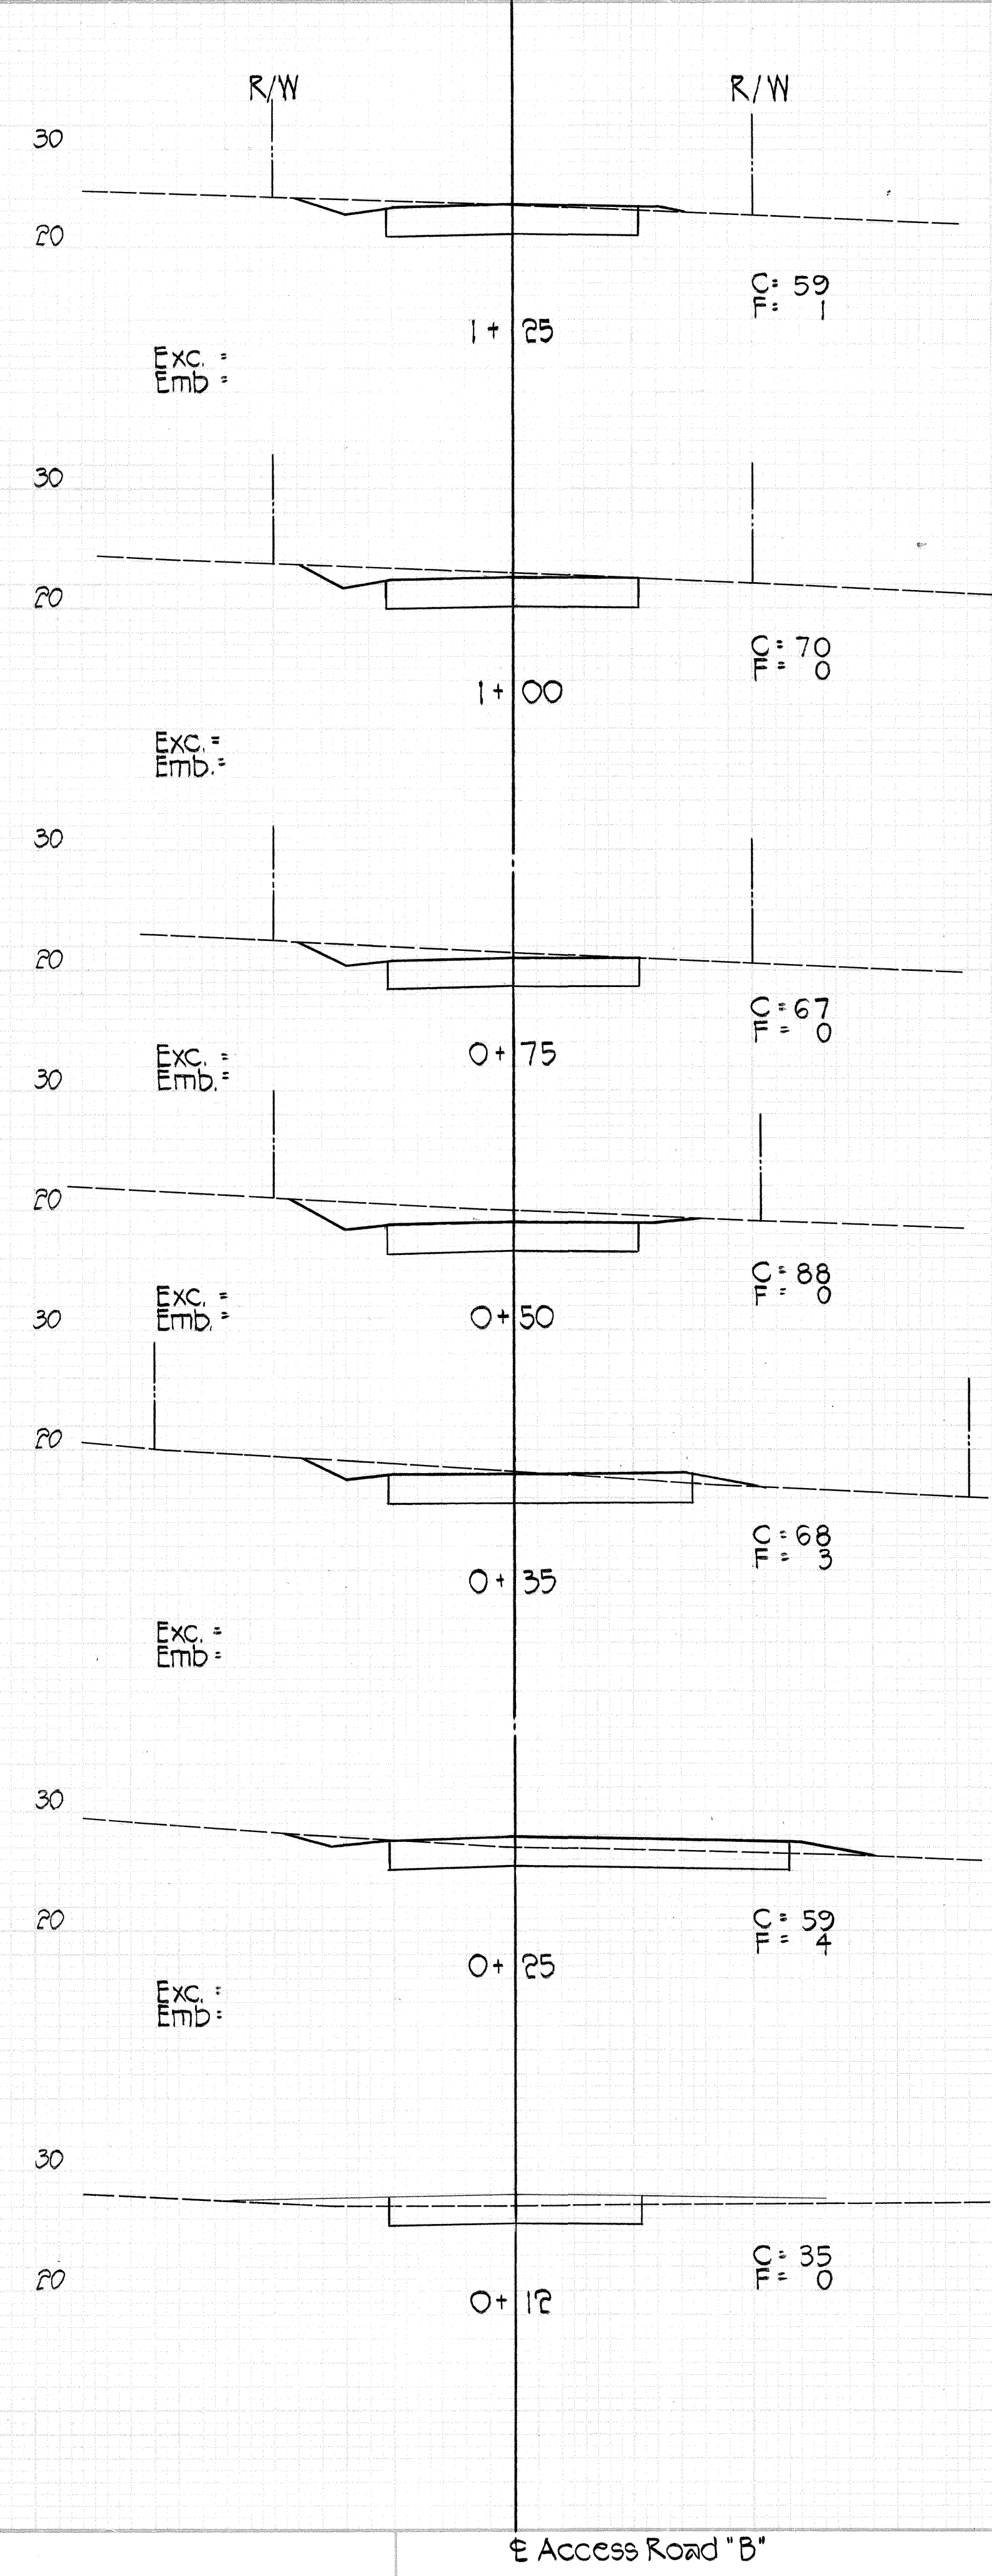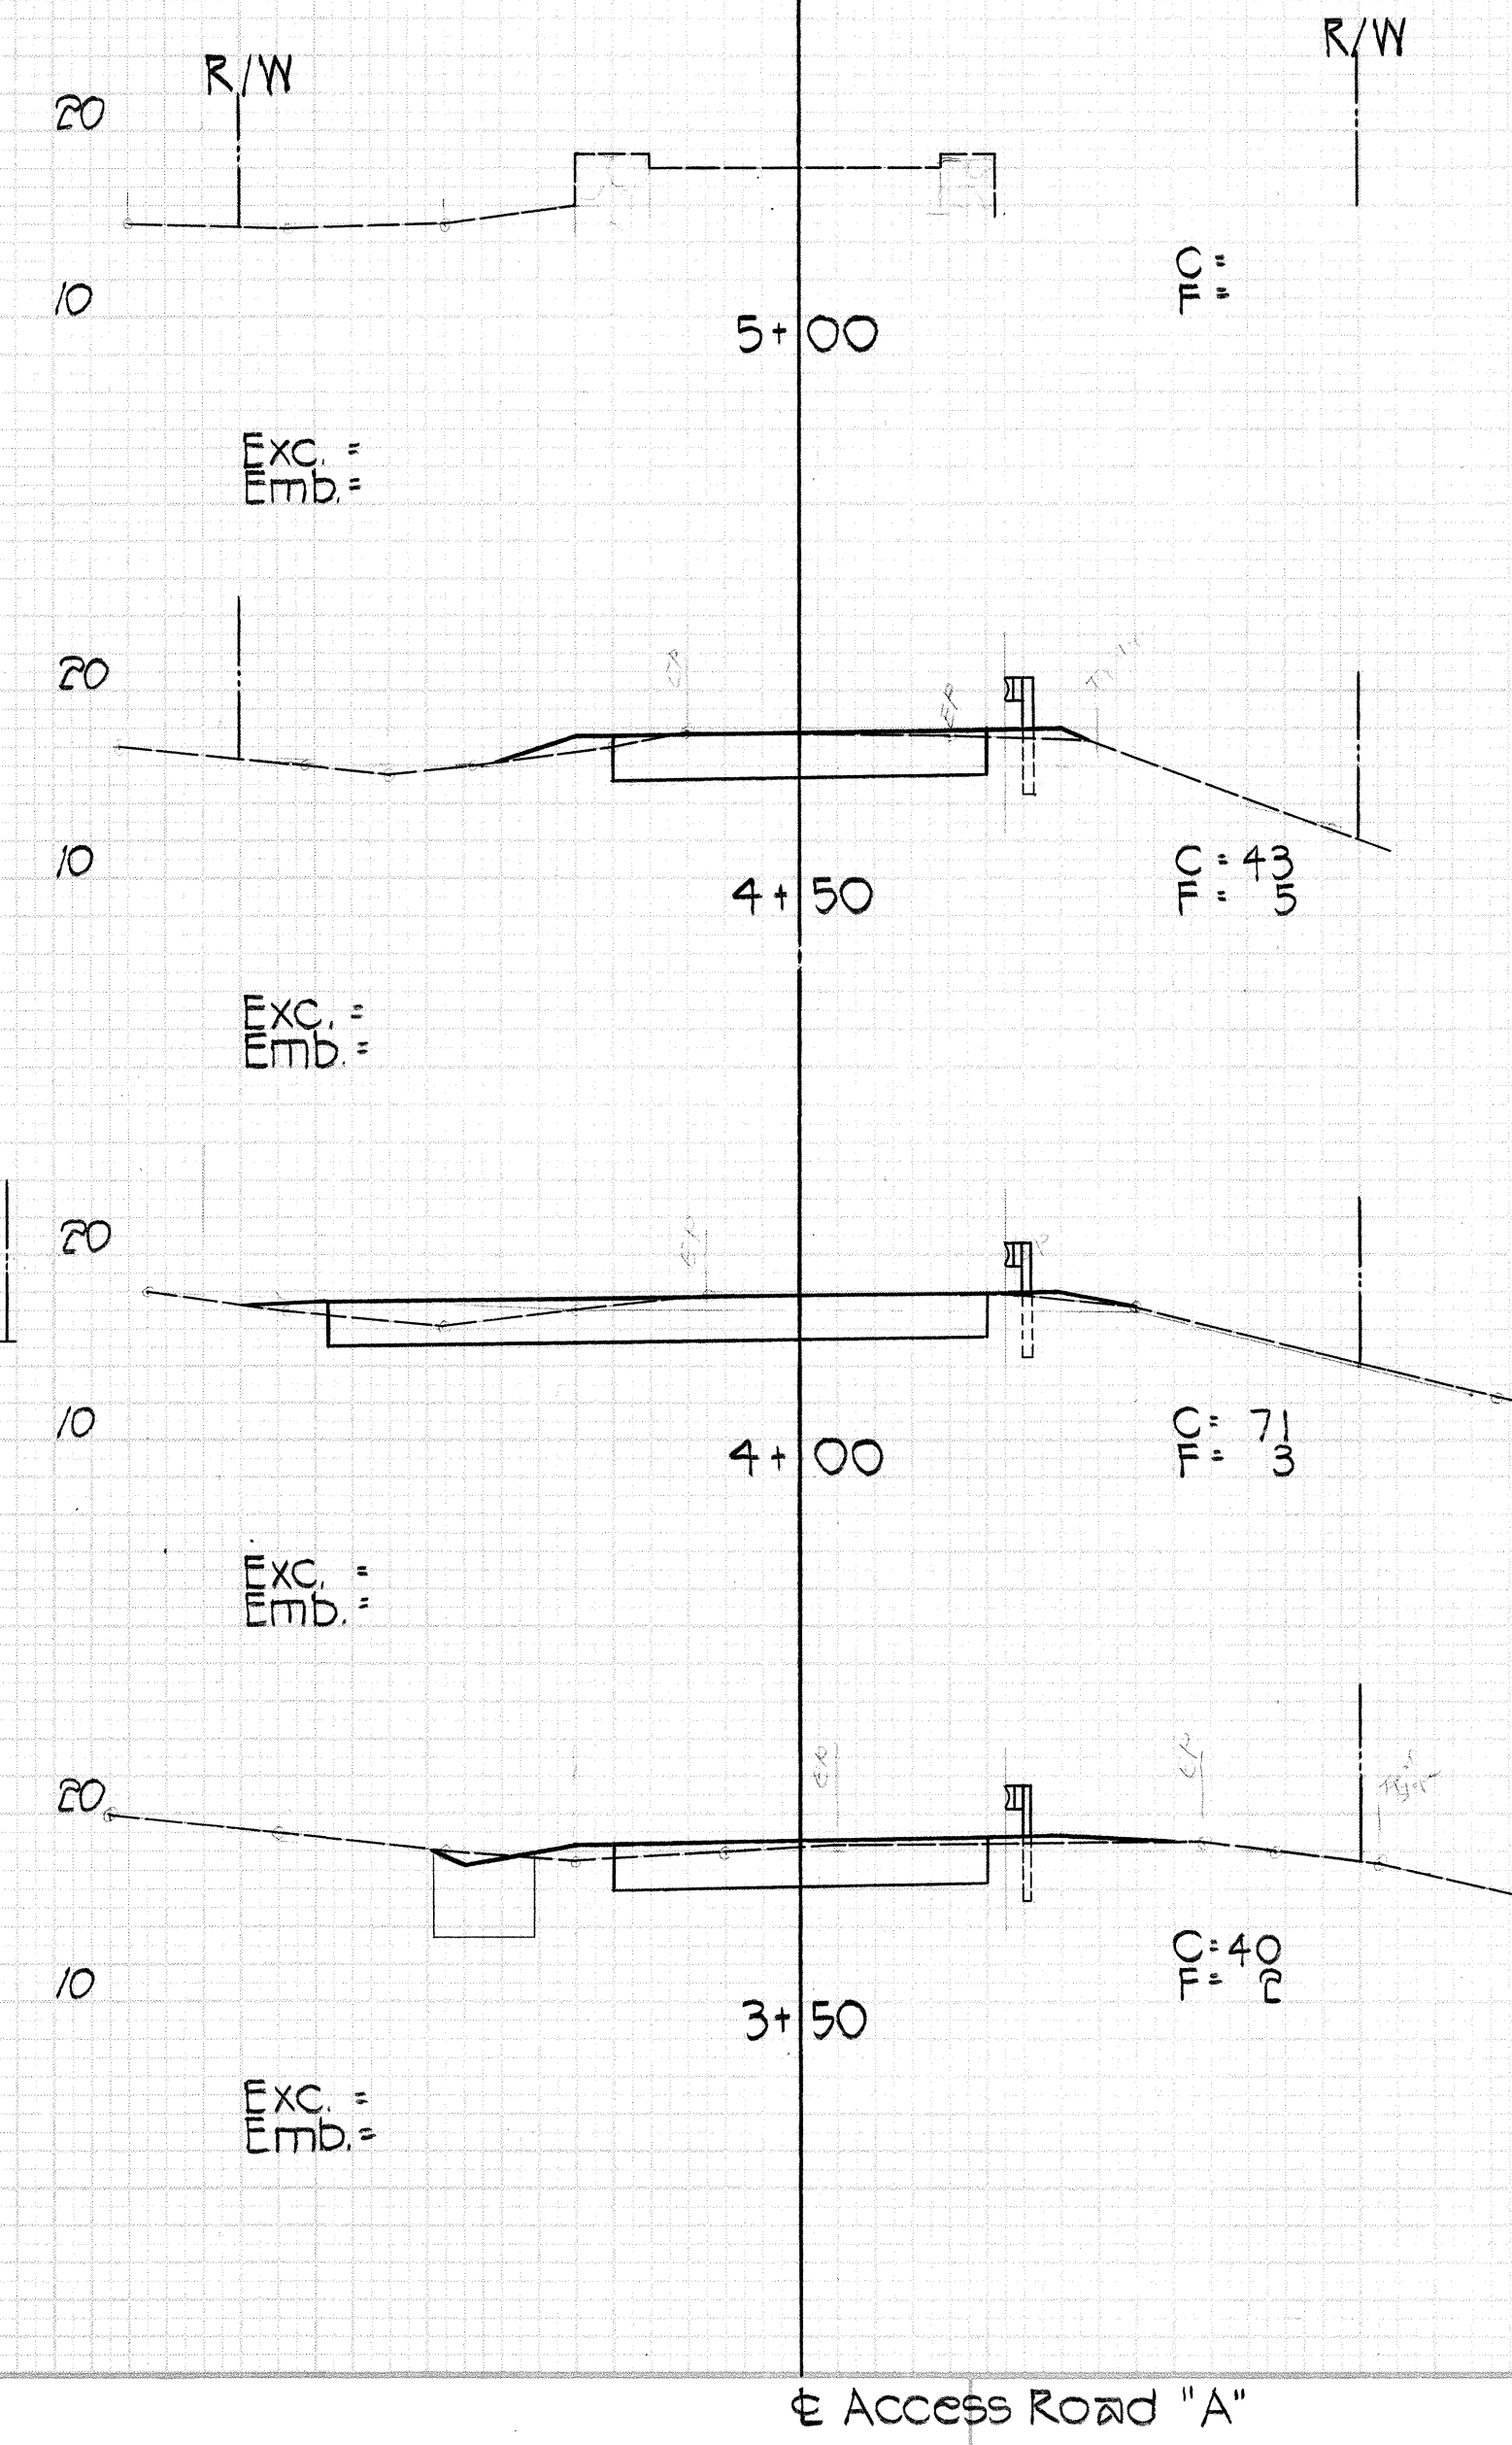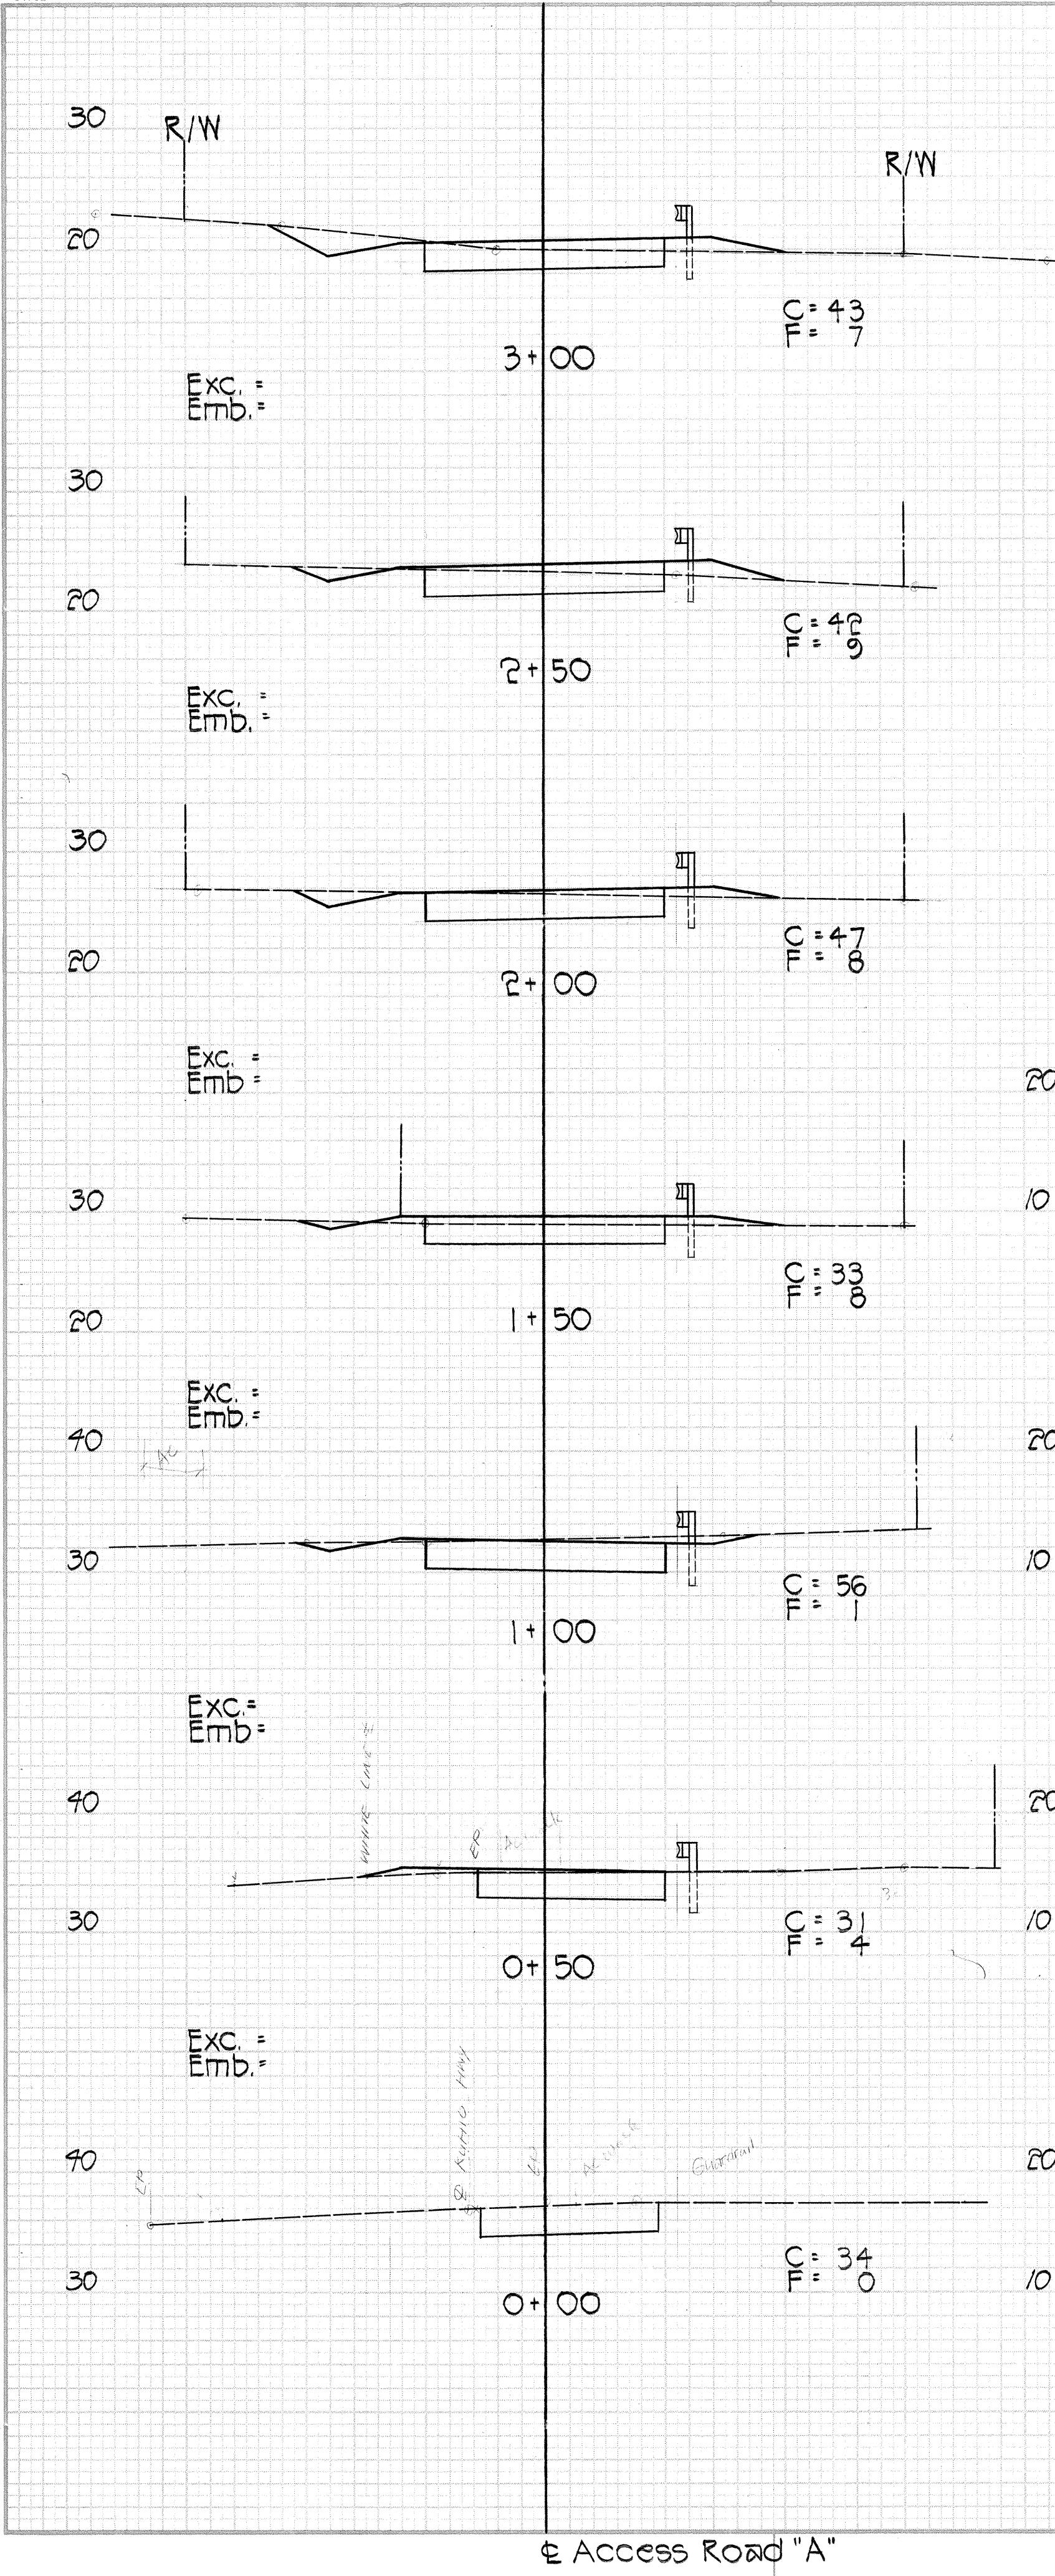

THIS WORK WAS PREPARED BY ME OR UNDER MY SUPERVISION.
Harold I. Yoshizaki
SHIMABUKURO, ENDO & YOSHIKAWA, INC.
1126 12th Avenue
Honolulu, Hawaii 96816