









FED. ROAD DIST. NO.	STATE	PROJ. NO.	FISCAL YEAR	SHEET NO.	TOTAL SHEETS
HAWAII	HAW.	56A-01-91	1992	12	17

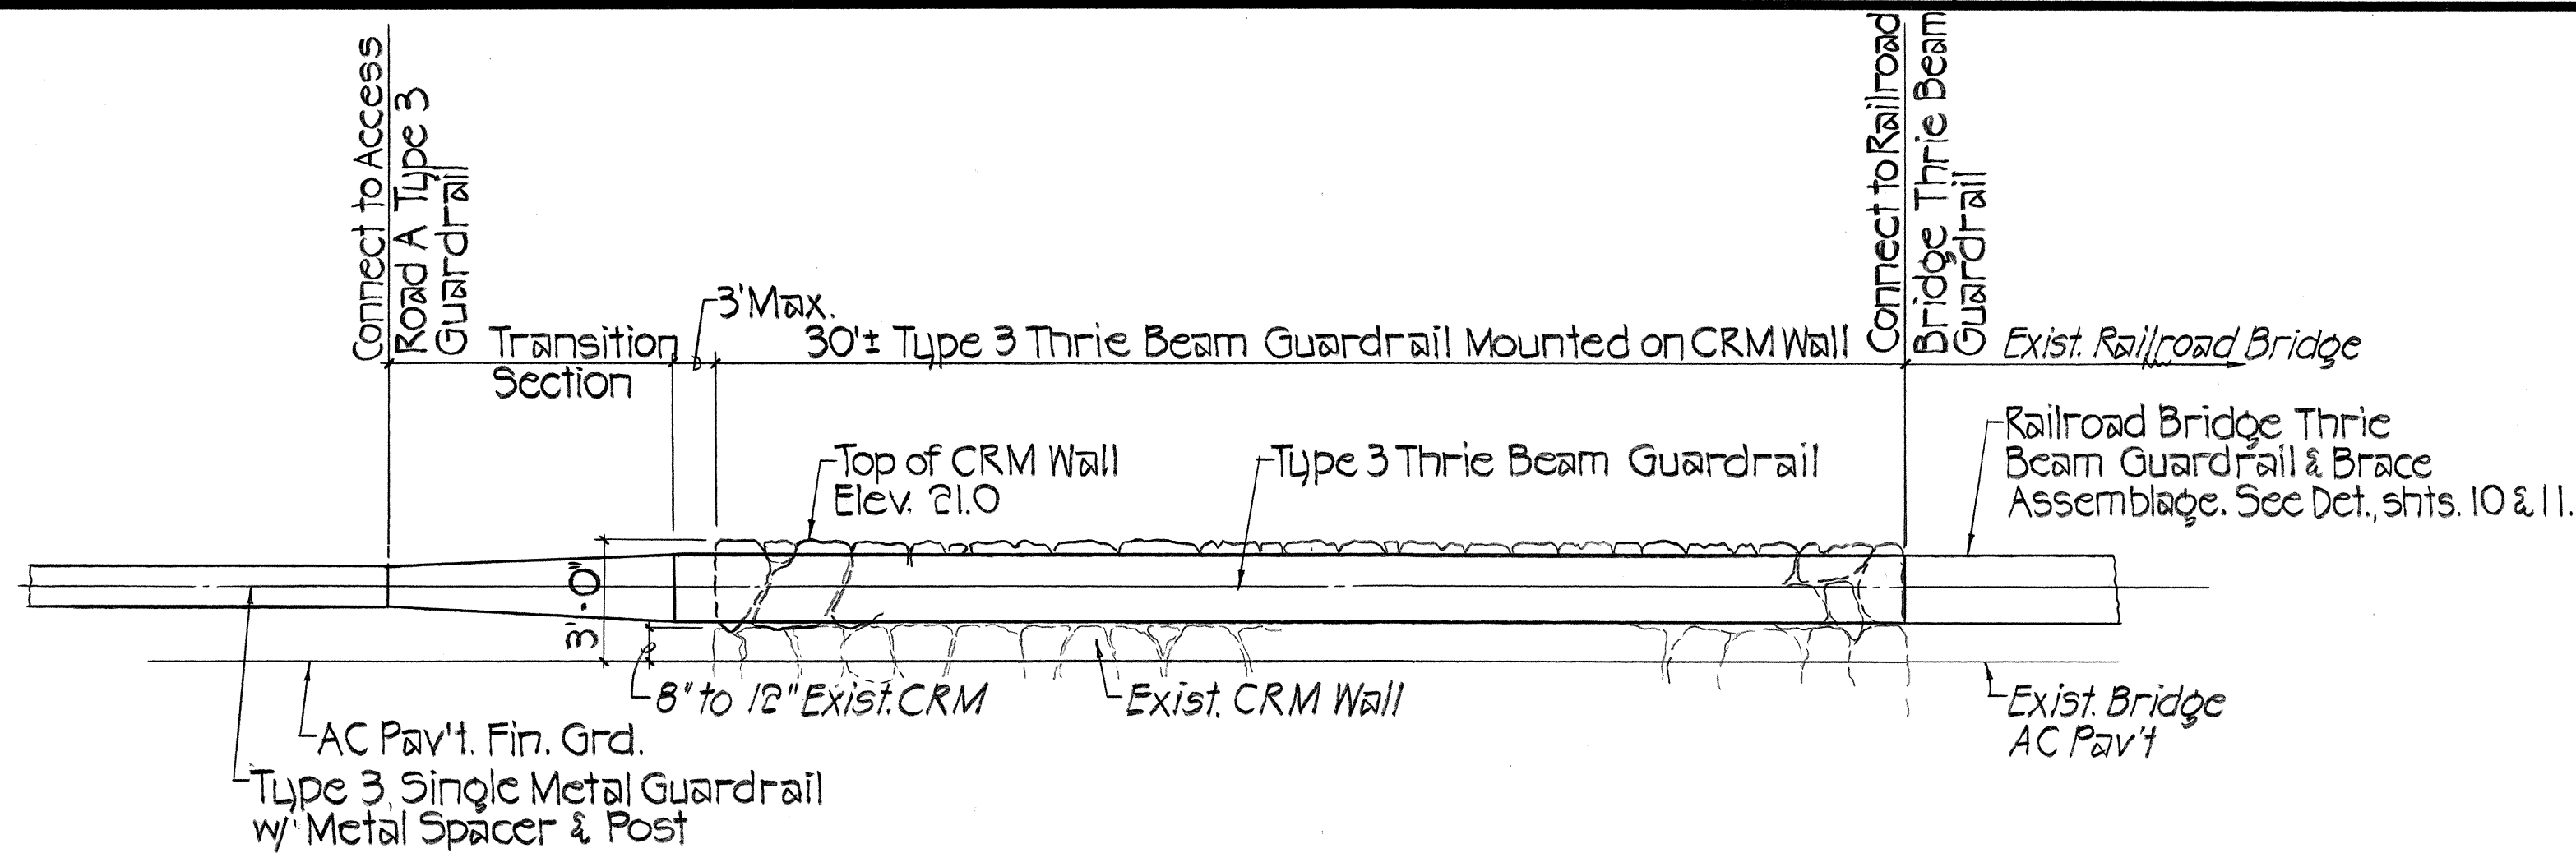

ELEVATION - TYPE 3 GUARDRAIL & CRM WALL
Scale: 1/4" = 1'-0"

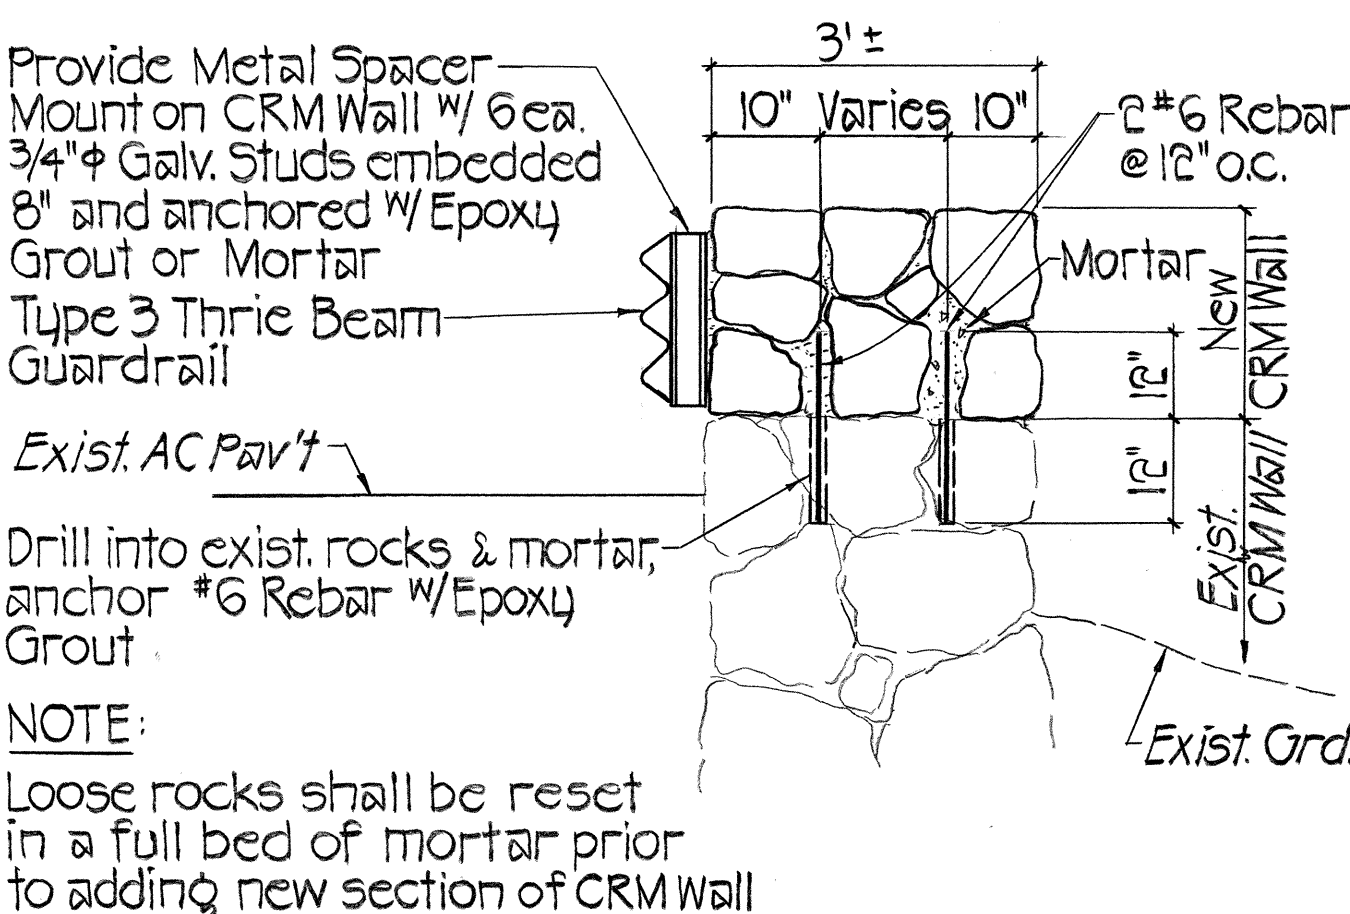

TYPICAL SECTION OF CRM WALL
& TYPE 3 THRIE BEAM GUARDRAIL
Scale: 1/2" = 1'-0"

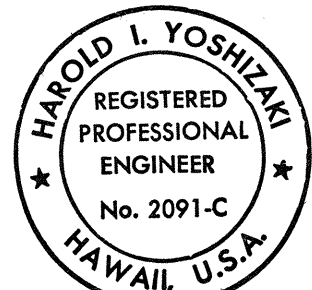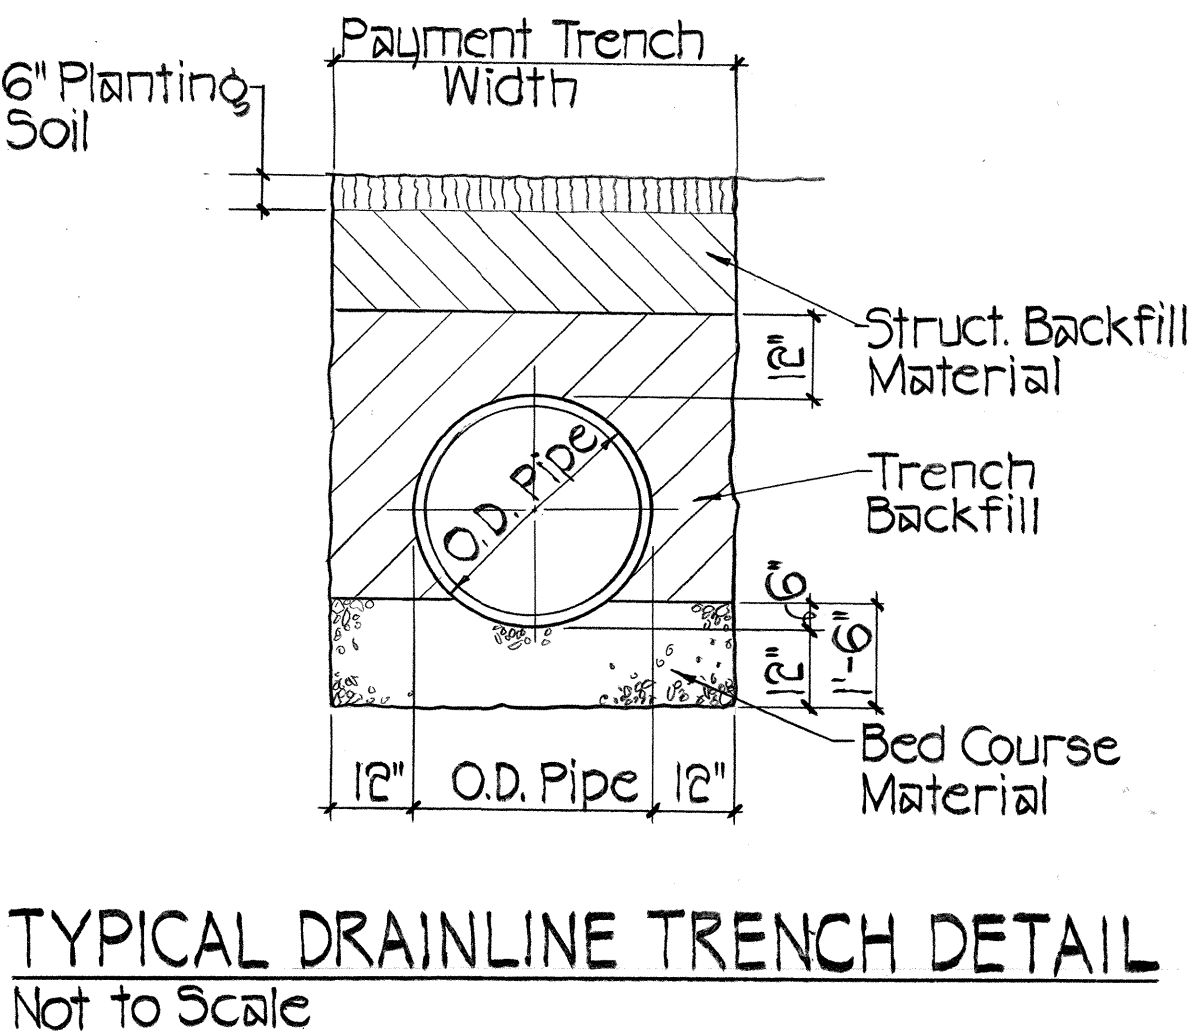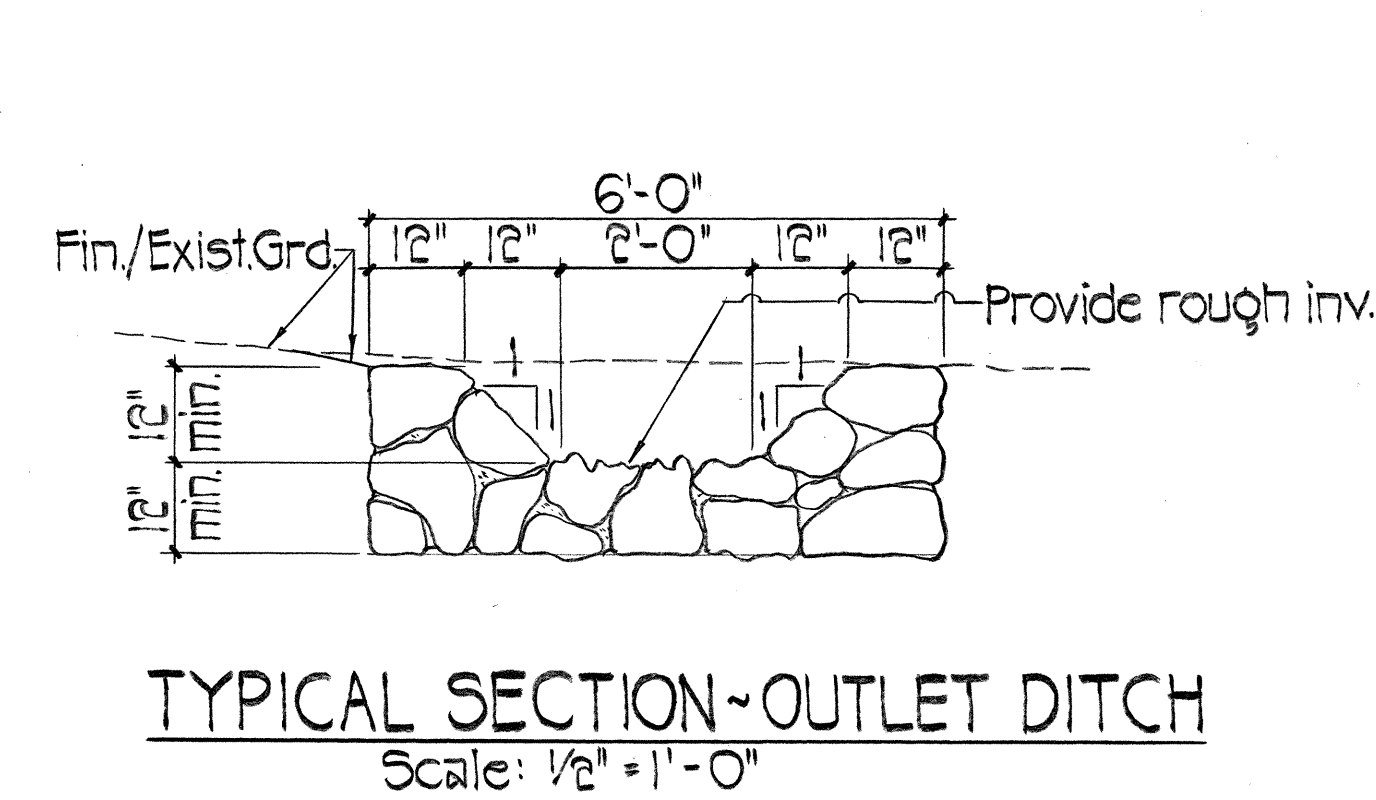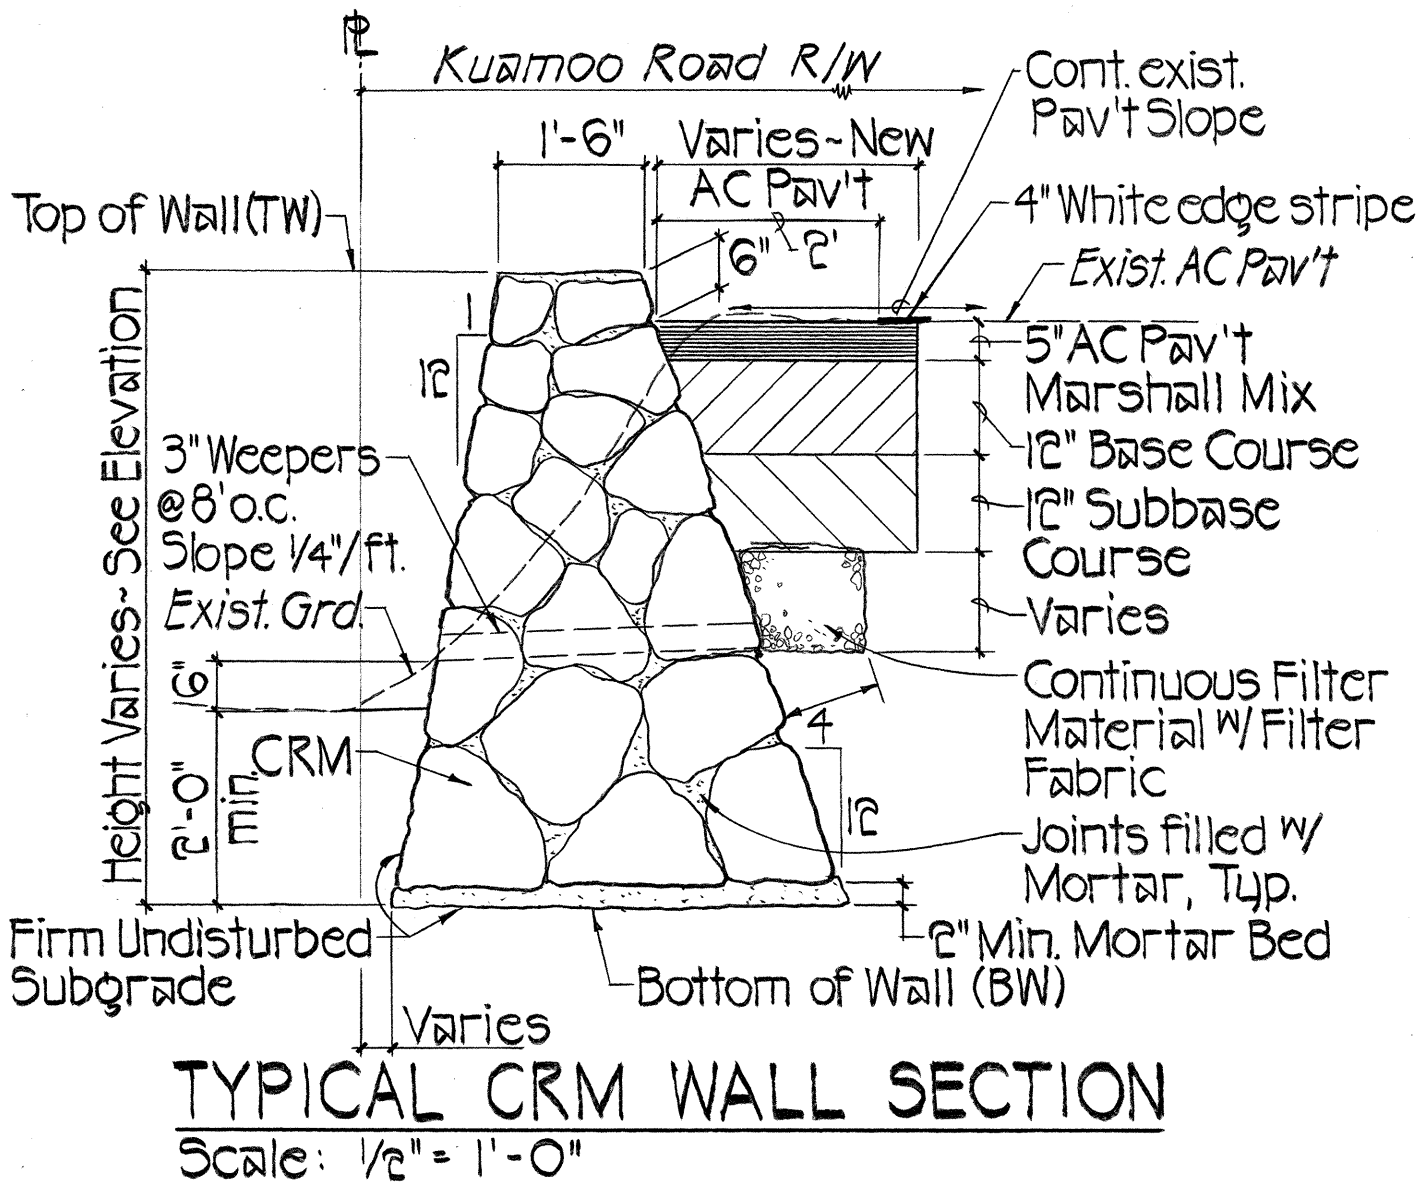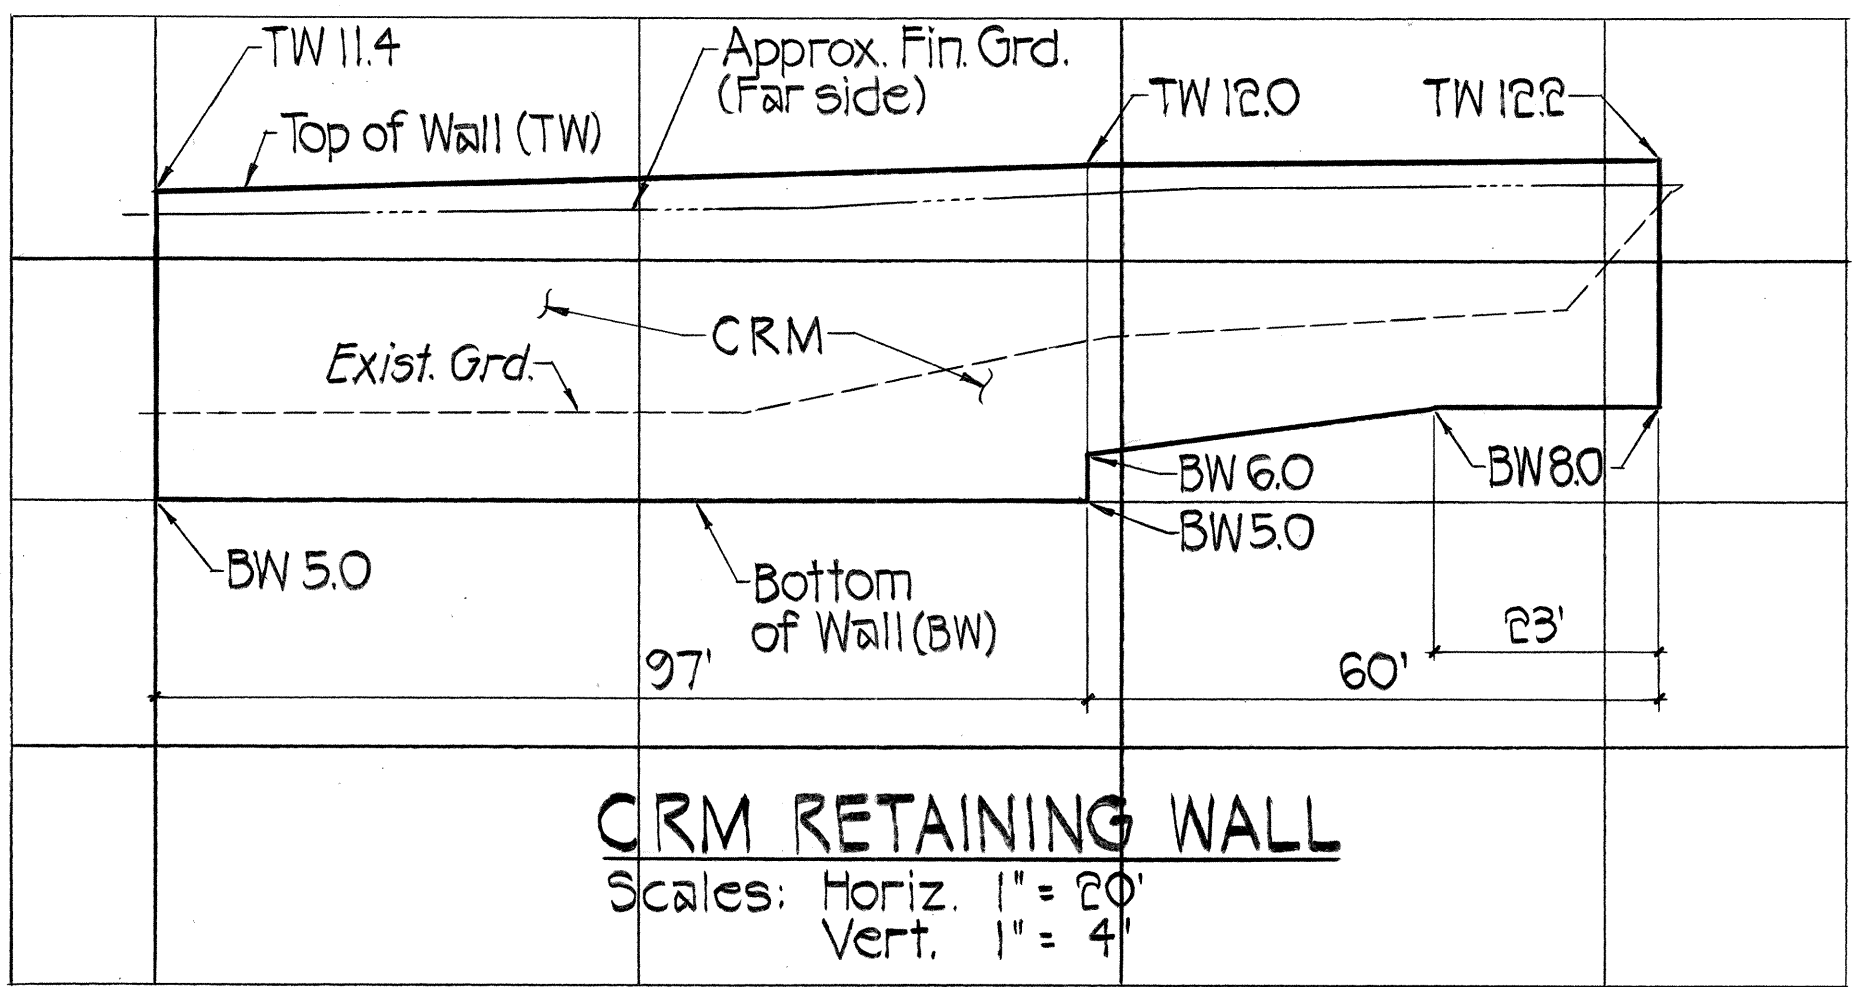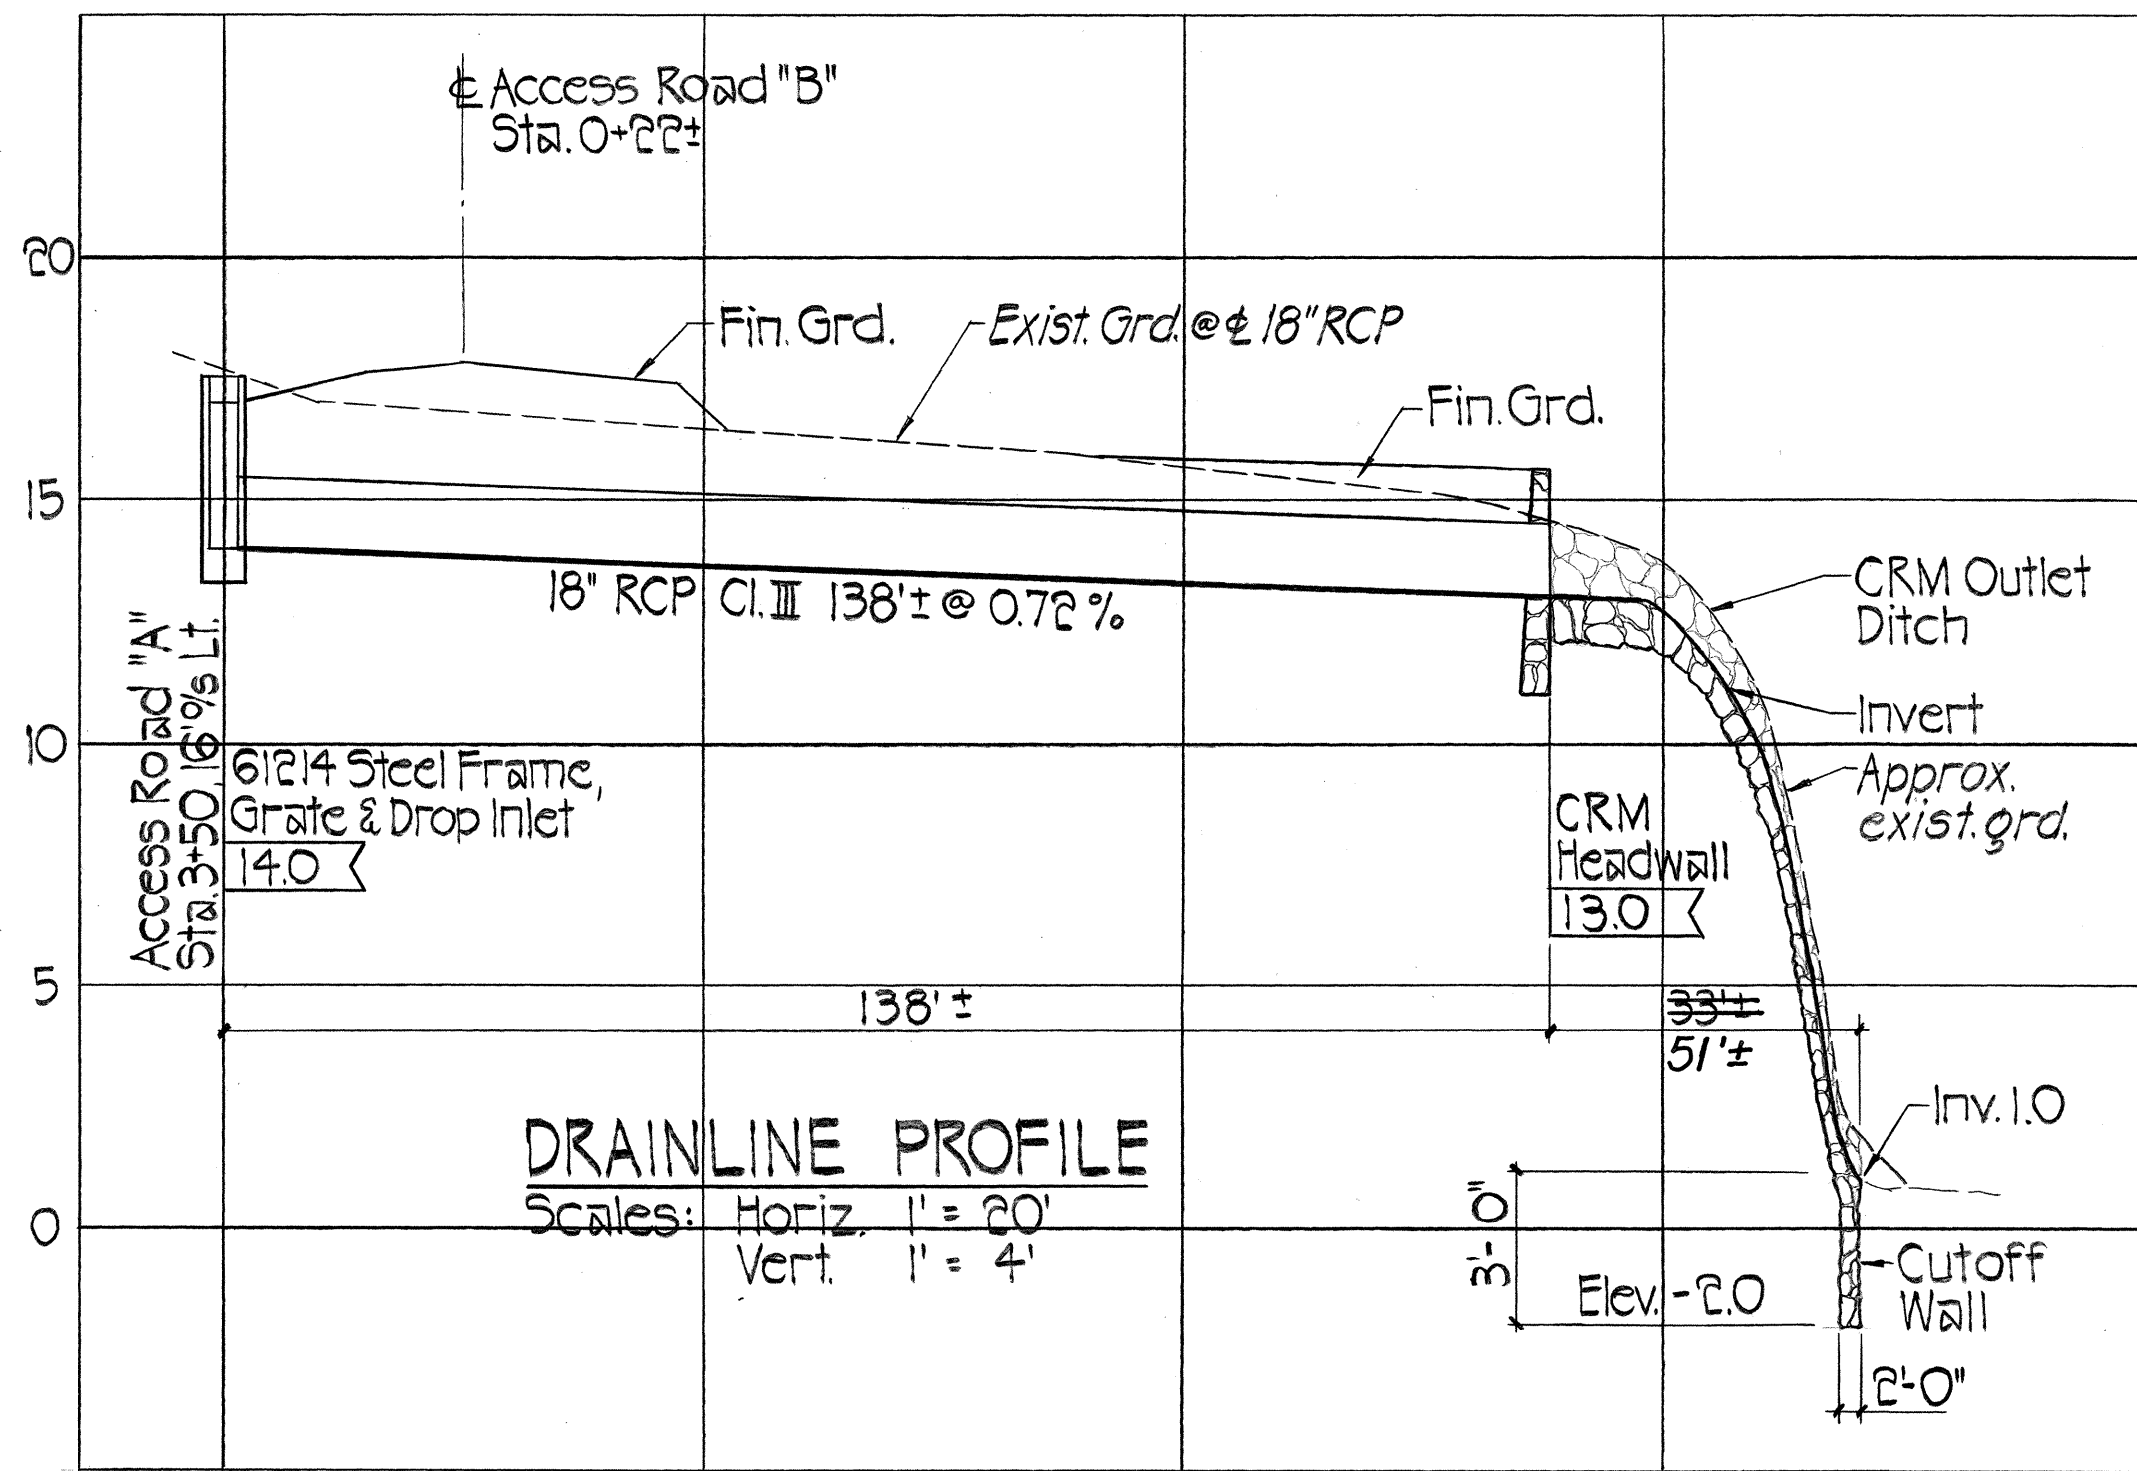

THIS WORK WAS PREPARED BY ME OR UNDER MY SUPERVISION.
Harold I. Yoshizaki
SHIMABUKURO, ENDO & YOSHIZAKI, INC.
1126 12th Avenue
Honolulu, Hawaii 96816

STATE OF HAWAII
DEPARTMENT OF TRANSPORTATION
HIGHWAYS DIVISION

MISCELLANEOUS DETAILS
KUHIO HIGHWAY IMPROVEMENTS
LEHO DRIVE TO HALEILIO ROAD
PROJECT NO. 56A-01-91

SCALE: AS NOTED
DATE: AUG. 6, 1991

SHEET NO. 1 OF 1 SHEETS

DATE	_____
SURVEY PLOTTED BY	_____
DRAWN BY	_____
CHECKED BY	_____
NOTE BOOK	_____
QUANTITIES BY	_____
CHECKED BY	_____
No.	_____