


FED. ROAD DIST. NO.	STATE	PROJ. NO.	FISCAL YEAR	SHEET NO.	TOTAL SHEETS
HAWAII	HAW.	56AC-01-04	2008	5	9

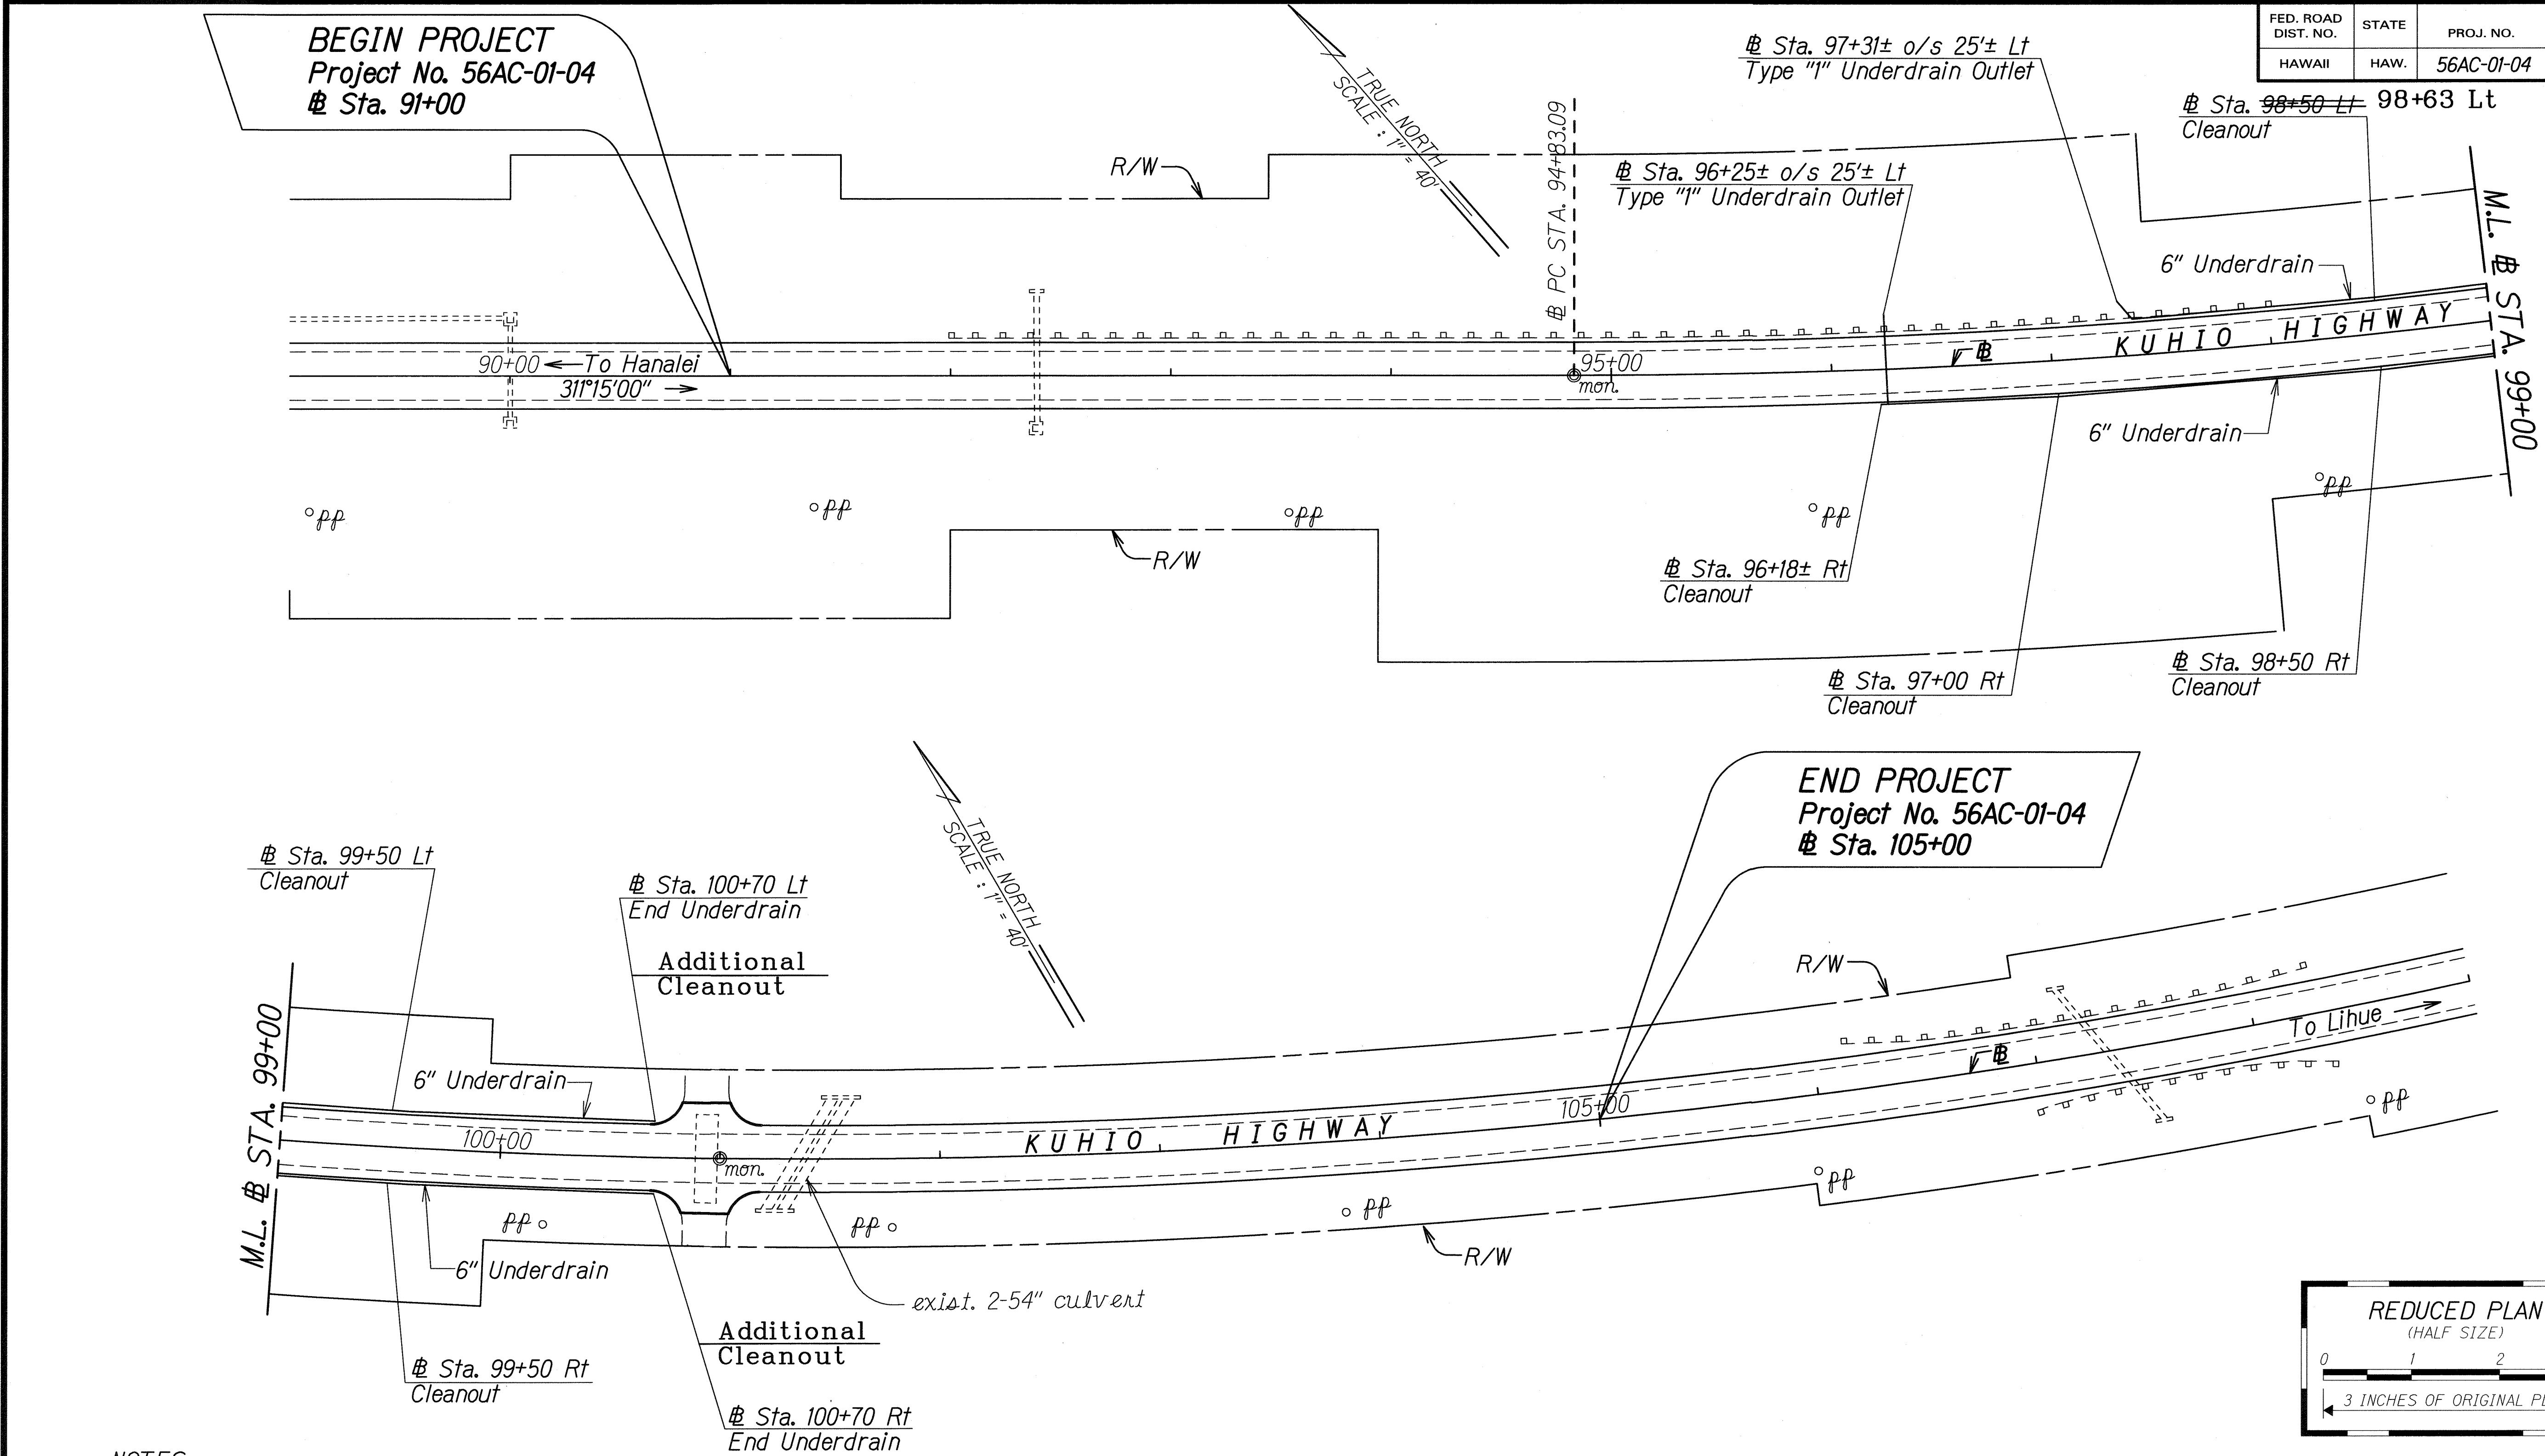

NOTES:

1. Replace pavement striping and markings damaged by the Contractor. The cost shall be incidental to the various contract items.
2. The underdrain shall be located so as to pass between the existing guardrail posts. Removing, and reinstalling the guardrail shall not be paid for separately, but shall be considered incidental to the various contract items.

LEGEND FOR AS-BUILT POSTINGS	
	Squiggly line for as-built deletion
	Double line for as-built deletion
Roadway	Text for as-built posting



STATE OF HAWAII
DEPARTMENT OF TRANSPORTATION
HIGHWAYS DIVISION

ROADWAY PLAN

KUHIO HIGHWAY DRAINAGE IMPROVEMENTS

Vicinity of M.P. 18.3

Proj. No. 56AC-01-04

Scale: 1"=40'

Date: June 2007

SHEET No. *HI* OF 4 SHEETS

ORIGINAL PLAN	SURVEY PLOTTED BY	DATE
NOTE BOOK	DESIGNED BY	6-30-07
QUANTITIES BY	CHECKED BY	
Revised		